

B 1	2308	SEQUENCE NO. (MDE USE ONLY)	STATE OF MARYLAND <b>APPLICATION FOR PERMIT TO DRILL WELL</b> 535997 please type	STATE PERMIT NUMBER <u>40-95-2207</u> 70 79 fill in this form completely
-----	------	--------------------------------	--	---

**OWNER INFORMATION** 12024

Date Received (ARA) 10 07 11  
8 MM DD YY 13

Chapel Rise Ltd  
15 Last Name Owner First Name 34  
11795 Bragdon Wood  
36 Street or RFD 55  
Clarksville Md 21029  
57 Town 70 State 72 Zip 76

**LOCATION OF WELL**

Howard  
8 COUNTY 21  
Chapel Rise  
23 SUBDIVISION 42  
SECTION 44 46 LOT 6 48 50  
Clarksville  
52 NEAREST TOWN 71  
MILES FROM TOWN (enter 0 if in town) 1 M I I  
73 76 77 78

**DRILLER INFORMATION**

George F. Easterday MW D 040  
Driller's Name 76 License No. 81  
L. Franklin Easterday, Inc.  
Firm Name  
9265 Brown Church Rd., MT. Airy, Md. 21771  
Address  
George F. Easterday 10/4/2011  
Signature Date

**DIRECTION OF WELL FROM TOWN (CIRCLE BOX)**

**ON WHICH SIDE OF ROAD (CIRCLE APPROPRIATE BOX)**

11 NEAR WHAT ROAD 30  
Bragdon Wood  
ON WHICH SIDE OF ROAD (CIRCLE APPROPRIATE BOX)  
34 200 37  
DISTANCE FROM ROAD Ft.  
ENTER FT OR MI 38 39  
TAX MAP: \_\_\_\_\_ BLK: \_\_\_\_\_ PARCEL \_\_\_\_\_

**WELL INFORMATION**

APPROX. PUMPING RATE 5  
(GAL. PER MIN.) 8 12  
AVERAGE DAILY QUANTITY NEEDED 500  
(GAL. PER DAY) 14 20

**USE FOR WATER (CIRCLE APPROPRIATE BOX)**

DOMESTIC POTABLE SUPPLY & RESIDENTIAL IRRIGATION  
 FARMING (LIVESTOCK WATERING & AGRICULTURAL IRRIGATION)  
 INDUSTRIAL, COMMERCIAL, DEWATERING  
 PUBLIC WATER SUPPLY WELL  
 TEST, OBSERVATION, MONITORING  
 GEO-THERMAL

**NOT TO BE FILLED IN BY DRILLER HEALTH DEPARTMENT APPROVAL**

Howard (13) A532542  
COUNTY NAME COUNTY NO.  
STATE SIGNATURE \_\_\_\_\_ INSERT S → 41  
DATE ISSUED 10/21/11  
43 MM DD YY 48 CO SIGNATURE 10/21/12 EXP/DATE  
NORTH GRID 000 EAST GRID 000  
50 55 57 63

APPROXIMATE DEPTH OF WELL 300 FEET  
24 28

APPROXIMATE DIAMETER OF WELL 8 INCH  
NEAREST

**METHOD OF DRILLING (circle one)**

BORED (or Augered) JETTED Jetted & DRIVEN  
30 AIR-ROTary AIR-PERcussion ROTARY (Hydraulic Rotary)  
57 CABLE REVerse-ROTary Drive-POINT  
other \_\_\_\_\_

**REPLACEMENT OR DEEPEMED WELLS (CIRCLE APPROPRIATE BOX)**

THIS WELL WILL NOT REPLACE AN EXISTING WELL  
 THIS WELL WILL REPLACE A WELL THAT WILL BE ABANDONED AND SEALED  
39  THIS WELL WILL REPLACE A WELL THAT WILL BE USED AS A STANDBY-CONTACT LOCAL APPROVING AUTHORITY FOR POLICY ON STANDBY WELLS  
 THIS WELL WILL DEEPEM AN EXISTING WELL  
PERMIT NUMBER OF WELL TO BE REPLACED OR DEEPEMED (IF AVAILABLE) 41 \_\_\_\_\_ 52

**Not to be filled in by driller (MDE OR COUNTY USE ONLY)**

APPROX. PERMIT NUMBER \_\_\_\_\_ G \_\_\_\_\_  
PERMIT No. 40-95-2207  
70 71 72 73 74 75 76 77 78 79

**SHOW MAJOR FEATURES OF BOX & LOCATE WELL WITH AN X**

SOURCES OF DRILLING WATER  
1. wells  
2.  
3.

WRITE THE BOX NUMBER FROM THE MAP HERE  
E \_\_\_\_\_ 000  
N \_\_\_\_\_ 000

DRAW A SKETCH BELOW SHOWING LOCATION OF WELL IN RELATION TO NEARBY TOWNS AND ROADS AND GIVE DISTANCE FROM WELL TO NEAREST ROAD JUNCTION 14H3

**SPECIAL CONDITIONS** Must Collect Radium Sample @ Yield test. Variance

PERMIT NO. (MDE USE ONLY)

# STATE OF MARYLAND WELL COMPLETION REPORT

FILL IN THIS FORM COMPLETELY  
PLEASE TYPE

THIS REPORT MUST BE SUBMITTED WITHIN  
45 DAYS AFTER WELL IS COMPLETED.

1 2 3 6  
(THIS NUMBER IS TO BE PUNCHED  
IN COLS. 3-6 ON ALL CARDS)

COUNTY  
NUMBER

ST/CO USE ONLY  
DATE Received  
MM DD YY  
01 04 12

DATE WELL COMPLETED  
MM DD YY  
07 19 11

Depth of Well  
22 300 26  
(TO NEAREST FOOT)

PERMIT NO.  
FROM "PERMIT TO DRILL WELL"  
HO-95-2207

OWNER CHapel Rise LTD  
STREET OR RFD BRADDON WOODS TOWN CLARKSVILLE  
SUBDIVISION CHapel Rise SECTION \_\_\_\_\_ LOT 6

### WELL LOG

Not required for driven wells

STATE THE KIND OF FORMATIONS PENETRATED, THEIR  
COLOR, DEPTH, THICKNESS AND IF WATER BEARING

DESCRIPTION (Use additional sheets if needed)	FEET		check if water bearing
	FROM	TO	
Top Soil	0	1	
Brown Shale	1	15	
Brown Mica	15	25	✓
Gray Mica	25	90	
opening	90	91	✓
Gray Mica	91	300	

### GROUTING RECORD

WELL HAS BEEN GROUTED (Circle Appropriate Box) YES  NO   
TYPE OF GROUTING MATERIAL (Circle one) CEMENT  BENTONITE CLAY   
CEMENT  BENTONITE CLAY   
NO. OF BAGS 28 NO. OF POUNDS 2800  
GALLONS OF WATER 168  
DEPTH OF GROUT SEAL (to nearest foot)  
from 0 ft. to 55 ft.  
(enter 0 if from surface)

### CASING RECORD

main casing TYPE ST Nominal diameter top (main) casing (nearest inch) 6 Total depth of main casing (nearest foot) 60  
OTHER CASING (if used) diameter inch depth (feet) from to

SCREEN RECORD  
screen type or open hole ST BR HO  
insert appropriate code below  
STEEL BRASS OPEN HOLE  
BRONZE  
PLASTIC OT OTHER

### PUMPING TEST

HOURS PUMPED (nearest hour) 3  
PUMPING RATE (gal. per min.) 20  
METHOD USED TO MEASURE PUMPING RATE Bucket  
WATER LEVEL (distance from land surface)  
BEFORE PUMPING 16 ft.  
WHEN PUMPING 26 ft.  
TYPE OF PUMP USED (for test)  
 air  piston  turbine  
 centrifugal  rotary  other (describe below)  
 jet  submersible

NUMBER OF UNSUCCESSFUL WELLS: 0

WELL HYDROFRACTURED YES  NO

CIRCLE APPROPRIATE LETTER  
A A WELL WAS ABANDONED AND SEALED WHEN THIS WELL WAS COMPLETED  
E ELECTRIC LOG OBTAINED  
P TEST WELL CONVERTED TO PRODUCTION WELL

I HEREBY CERTIFY THAT THIS WELL HAS BEEN CONSTRUCTED IN ACCORDANCE WITH COMAR 26.04.04 "WELL CONSTRUCTION" AND IN CONFORMANCE WITH ALL CONDITIONS STATED IN THE ABOVE CAPTIONED PERMIT, AND THAT THE INFORMATION PRESENTED HEREIN IS ACCURATE AND COMPLETE TO THE BEST OF MY KNOWLEDGE.

DRILLERS LIC. NO. MW D 040  
DRILLERS SIGNATURE George F. Esterly  
LIC. NO. JS D 038

SITE SUPERVISOR (sign. of driller or journeyman responsible for sitework if different from permittee)

### DEPTH (nearest ft.)

1	2	3	76
															58																	300																																											

GRAVEL PACK IF WELL DRILLED WAS FLOWING WELL INSERT F IN BOX 68

MDE USE ONLY (NOT TO BE FILLED IN BY DRILLER)  
T (E.R.O.S.) W Q

TELESCOPE CASING LOG INDICATOR OTHER DATA

### PUMP INSTALLED

DRILLER INSTALLED PUMP (CIRCLE) (YES or NO) YES  NO   
IF DRILLER INSTALLS PUMP, THIS SECTION MUST BE COMPLETED FOR ALL WELLS.  
TYPE OF PUMP INSTALLED PLACE (A,C,J,P,R,S,T,O) IN BOX 29 29  
CAPACITY: GALLONS PER MINUTE (to nearest gallon) 31 36  
PUMP HORSE POWER 37 41  
PUMP COLUMN LENGTH (nearest ft.) 43 47  
CASING HEIGHT (circle appropriate box and enter casing height)  
 above } LAND SURFACE  
 below } (nearest foot)

LOCATION OF WELL ON LOT  
SHOW PERMANENT STRUCTURE SUCH AS BUILDING, SEPTIC TANKS, AND /OR LANDMARKS AND INDICATE NOT LESS THAN TWO DISTANCES (MEASUREMENTS TO WELL)

39, 234297  
16, 918935



**HOWARD COUNTY HEALTH DEPARTMENT  
BUREAU OF ENVIRONMENTAL HEALTH  
WELL & SEPTIC PROGRAM  
TEL: (410)313-1771 FAX: (410)313-2648**

**Information Form for the Installation of the Well Pump, Pitless Adapter, and Supply Piping**

**NOTE: The installer is responsible for requesting an inspection prior to 9 am on the day of the desired inspection. No work is to be covered until approved by the Health Department. All installations must comply with the National Standard Plumbing Code (NSPC, as amended locally) and COMAR 26.04.04 (MD Well Construction Regulations). Submission of a complete form is required prior to Use and Occupancy approval.**

Company Name: EASTERDAY WELL & PUMP Telephone #: \_\_\_\_\_  
9205 BROWN CHURCH RD  
 Address: MT. AIRY, MD 21771  
301-831-5179

(Must circle one) Licensed Plumber      Licensed Well Driller      Licensed Well Pump Installer **X**  
 License # and name of individual responsible for the field installation:  
 Name (Print): Jerry A. Miller, III License# WR0074  
 \*A licensed individual must perform the actual installation. Apprentices must be under the supervision of a licensed journeyman or master plumber, pump installer or well driller. Licenses may be subjected to field verification. Unlicensed individuals may be reported to the appropriate licensing agency.

Name of Property Owner: Tim Sosinski Telephone #: 410-730-2300  
 Subdivision: Chapel Rise Lot #: 6 Well Tag #: HO-92-2207  
 Site Address: 1795 Bragdon Road  
Clarksville, MD 21029

<b><u>Submersible Pump Data</u></b>	<b><u>Pitless Adapter</u></b>	<b><u>Well Cap and Electric Conduit</u></b>
Make: <u>Goulds</u>	Make: <u>Martinson</u>	Two piece watertight cap: _____
Model #: <u>106507</u>	Model#: <u>B-10X</u>	Screened, vented well cap: <input checked="" type="checkbox"/>
Pump Capacity _____ GPM	Depth: <u>3 1/2</u> (36" min)	Cap secured to casing: <input checked="" type="checkbox"/>
Well Yield: <u>30</u> GPM	NSF/WSC approved: _____	Conduit min 18" B.G.: <input checked="" type="checkbox"/>
Depth of well encountered at time of pump installation: <u>300</u> (feet)	Conduit secured to well cap: <input checked="" type="checkbox"/>	

If pump capacity exceeds well yield, a low water cut off switch is required by NSPC 1990 Section 17.8.4  
 Torque arrestors, Cable guards, or other acceptable method used— Must circle one  
 Safety rope, if used, attached to brass rope adapter or other acceptable method inside of well casing

<b><u>Piping to house</u></b>	<b><u>House Connection</u></b>
Type: <u>PE</u>	PVC sleeve to undisturbed soil at wall penetration: <u>Yes</u>
PSI: <u>200</u> (160 psi min)	Length of sleeve (5' minimum from foundation): <u>5ft</u>
Depth of supply line: <u>3 1/2</u> (36" min)	Sleeve sealed properly: <u>Yes</u>


The water supply line is required to be at least ten feet from the septic tank, pump chamber, sewage piping, distribution box, drainfields, and sewage reserve area. If this cannot be accomplished, contact this office for approval prior to installation.

Signature of company representative responsible for installation: Jerry A. Miller, III date: 1-20-12

**For Health Department Use Only – Not to be completed by Installer**

Date Insp. Requested: 1/23 Date Insp. Approved: 1/24/12 Inspector: (KW)  
 Inspection Data: Pitless adapter watertight & water supply line at least 36" below grade   
 Two piece cap installed and attached to casing securely   
 Elec. conduit extends at least 18" below grade/attached to cap properly   
 Safety rope not outside of well cap/casing   
 Correct well tag attached properly and casing 8" above finished grade   
 Water supply line sleeved adequately at house connection   
 Adequate grout observed below pitless adapter

#22  
 Not finished  
 R.S.

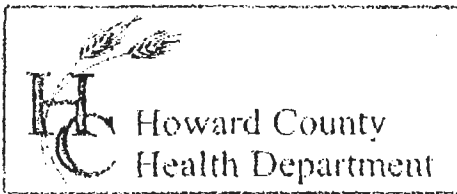

3525 H Ellicott Mills Drive, Ellicott City, MD 21043  
(410) 313-2640 Fax (410) 313-2648  
TDD (410) 313-2323 Toll Free 1-866-313-6300  
website: www.hchealth.org

Penny E. Borenstein, M.D., M.P.H., Health Officer

TO ALL INTERESTED PARTIES

When submitting a well permit application for a proposed well for new construction, please indicate one of the following:

- The well site has been staked by Sill, Adcock & Assoc.  
(professional land surveyor or company employing professional land surveyors)  
on 9/30/11 (date) and does not require a site inspection.
- The well driller, builder or property owner will call the Health Department to schedule a time to meet in the field to verify the proposed well site location.


This sheet, along with two copies of an acceptable well site plan, must be attached to the green well permit application.

Revised 6/10/03

LOT 6 Chapel Rise

Bragdon Wood

\* Plan not to Scale \* See signed P.O.C.  
will be OK

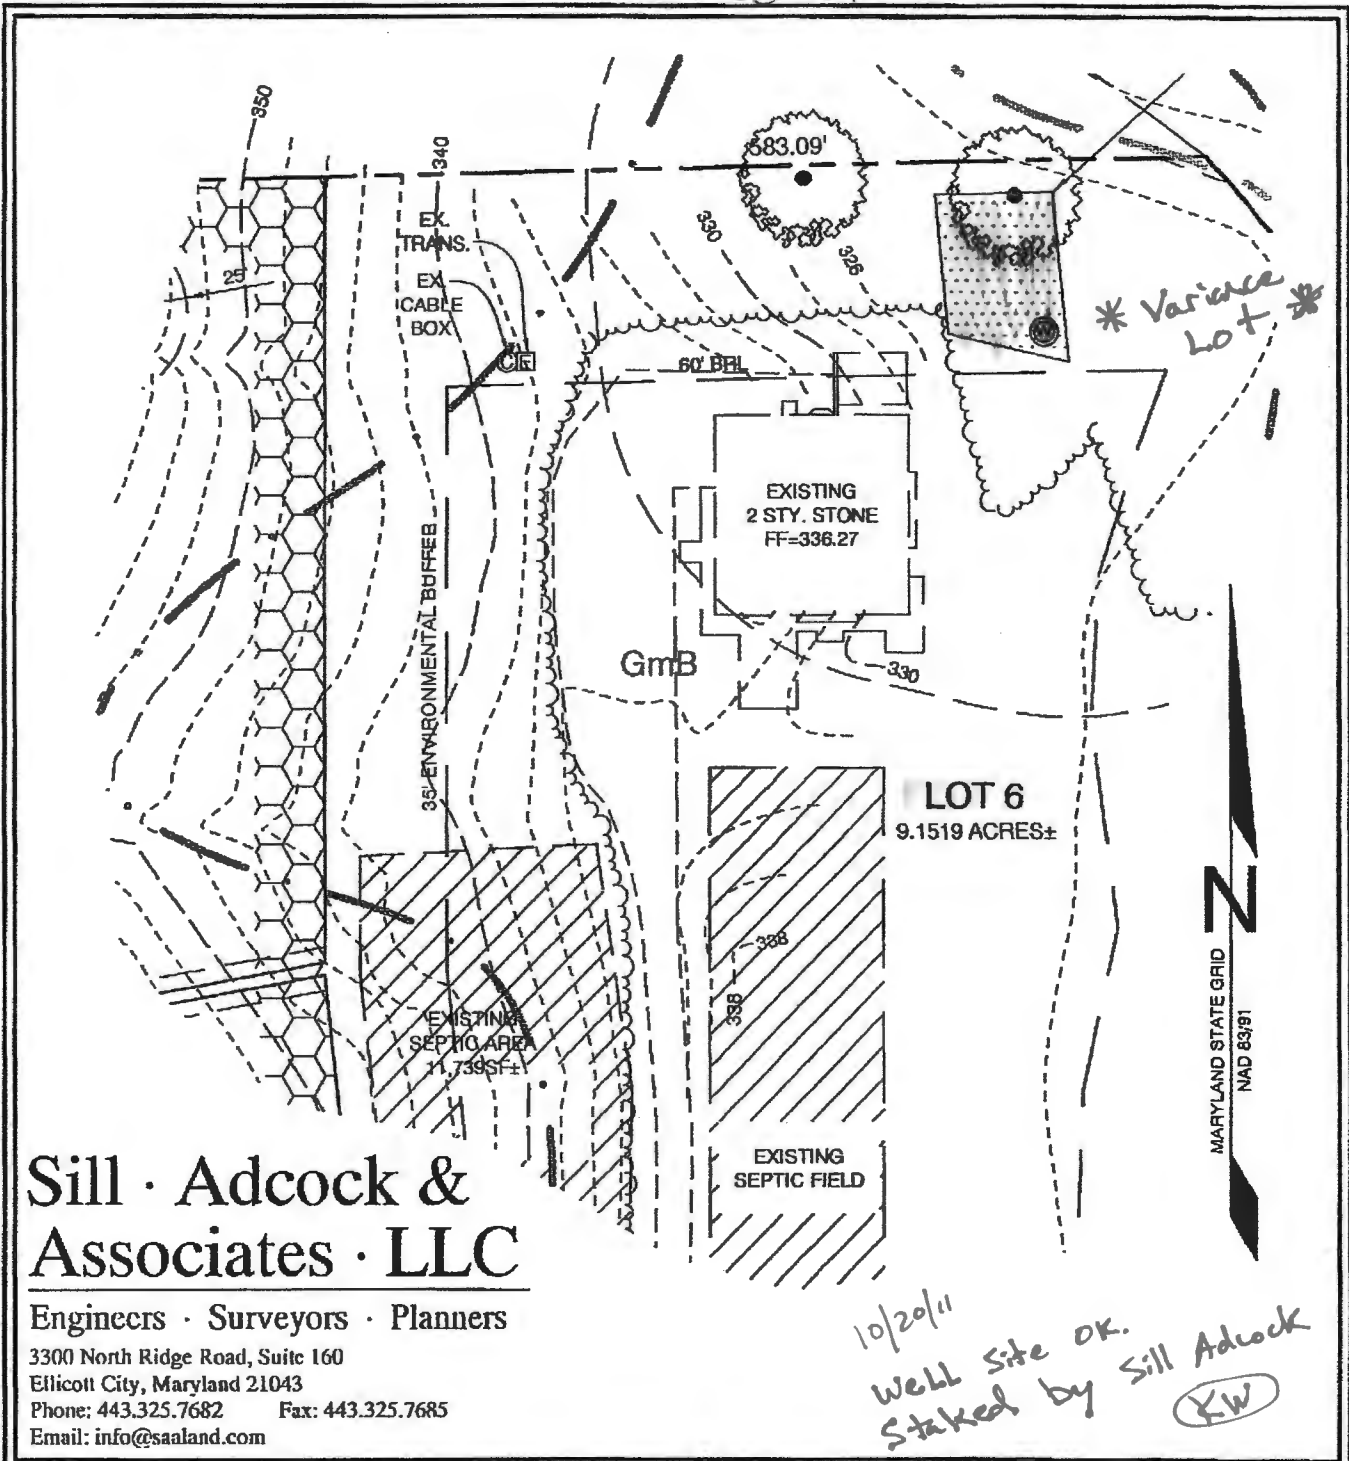

# Sill · Adcock & Associates · LLC

Engineers · Surveyors · Planners

3300 North Ridge Road, Suite 160  
Ellicott City, Maryland 21043  
Phone: 443.325.7682 Fax: 443.325.7685  
Email: info@saaland.com

10/20/11  
Well site OK.  
Staked by Sill Adcock  
(KW)

DESIGN BY: PS  
DRAWN BY: PS  
CHECKED BY: PS  
SCALE: 1"=50'  
DATE: SEPT. 26, 2011  
PROJECT #: 09-073  
SHEET #: 1 OF 1

## WELL PERMIT PLAN

### CHAPEL RISE

LOT 6

TAX MAP 29 GRID 13  
5TH ELECTION DISTRICT

PARCEL 26, 282 & 353  
HOWARD COUNTY, MARYLAND