


A# 00970

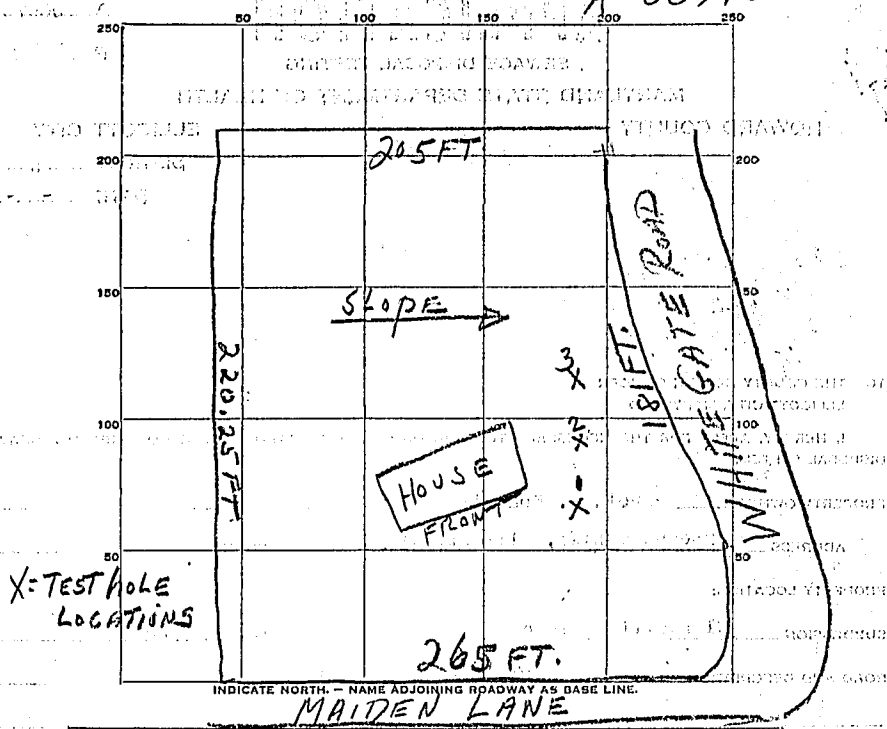

INDICATE NORTH - NAME ADJOINING ROADWAY AS BASE LINE.
MAIDEN LANE

DATE	TEST NO.	DEPTH	PRE-WET		TEST - 1" DROP		TIME
			START	STOP	START	STOP	
5-14-59	1	3FT	1:16	1:17	1:17	1:20	3 minutes
	2		1:20	1:22	1:22	1:26	4 minutes
	3		1:28	1:38	1:38	1:55	17 minutes

SOIL AUGER FINDING

TESTED BY J. H.

REMARKS *See handwritten notes*

ALSO PRESENT *See handwritten notes* LOT NO. 33