

C1 4341

SEQUENCE NO. (MDE USE ONLY)

STATE OF MARYLAND WELL COMPLETION REPORT

THIS REPORT MUST BE SUBMITTED AFTER WELL IS COMPLETED. COUNTY NUMBER A48851

ST/CO USE ONLY DATE RECEIVED

DATE WELL COMPLETED 2 19 99

DEPTH OF WELL 400' (TO NEAREST FOOT)

PERMIT NO. FROM "PERMIT TO DRILL WELL" HO-94-1798

OWNER Dale Thompson Bldrs
STREET OR RFD Whitetail Ln TOWN W. Friendship
SUBDIVISION QUARTERFIELD SECTION LOT 35

WELL LOG table with columns: DESCRIPTION, FEET (FROM, TO), check if water bearing. Includes entries for Sand, Gray Mica, and Rock.

GROUTING RECORD form including: WELL HAS BEEN GROUTED (Y), TYPE OF GROUTING MATERIAL (CM), NO. OF BAGS (50), NO. OF POUNDS (4100), DEPTH OF GROUT SEAL (0 to 79 ft).

CASING RECORD form including: casing types insert appropriate code below (ST), MAIN CASING TYPE (ST), Nominal diameter (6), Total depth of main casing (83).

OTHER CASING (if used) form with columns for diameter and depth.

SCREEN RECORD form including: screen type or open hole (ST), insert appropriate code below (BR, PL, HO, OT).

PUMPING TEST form including: HOURS PUMPED (6), PUMPING RATE (2), METHOD USED TO MEASURE PUMPING RATE (Buck), WATER LEVEL (36 before, 335 when pumping), TYPE OF PUMP USED (S).

PUMP INSTALLED form including: DRILLER INSTALLED PUMP (NO), TYPE OF PUMP INSTALLED (S), CAPACITY: GALLONS PER MINUTE (31-35), PUMP HORSE POWER (37-41), PUMP COLUMN LENGTH (43-47).

NUMBER OF UNSUCCESSFUL WELLS (0), WELL HYDROFRACTURED (Y).

CIRCLE APPROPRIATE LETTER: A (well abandoned), E (electric log obtained), P (test well converted to production well).


I HEREBY CERTIFY THAT THIS WELL HAS BEEN CONSTRUCTED IN ACCORDANCE WITH COMAR 26.04.04 "WELL CONSTRUCTION" AND IN CONFORMANCE WITH ALL CONDITIONS STATED IN THE ABOVE CAPTIONED PERMIT...

DRILLERS LIC. NO. 1 MS 0024, DRILLERS SIGNATURE Joseph L. Maize, LIC. NO. 1 D

DEPTH (nearest ft.) table with columns 1-51 and rows A-C, R-E, N. Includes slot size and diameter of screen information.

GRAVEL PACK IF WELL DRILLED WAS FLOWING WELL INSERT F IN BOX 68

MDE USE ONLY (NOT TO BE FILLED IN BY DRILLER) T (E.R.O.S.) W Q

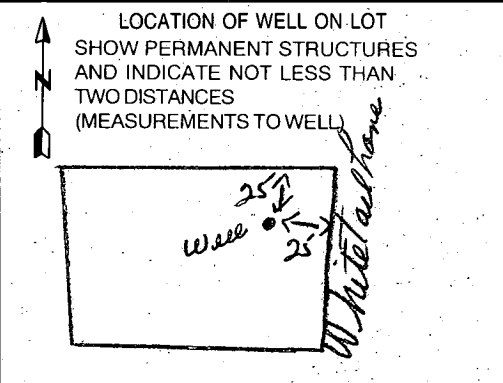

SITE SUPERVISOR (sign. of driller or journeyman responsible for sitework if different from permittee)

TELESCOPE CASING LOG INDICATOR OTHER DATA

B 1	<b>8003</b>	SEQUENCE NO. (MDE USE ONLY)	STATE OF MARYLAND PERMIT TO DRILL WELL please print or type	STATE PERMIT NUMBER <b>HO-94-1798</b> <small>fill in this form completely</small>
-----	-------------	--------------------------------	---	---

**OWNER INFORMATION**

Date Received (APA) 11/18/97

8 Thompson 15 Last Name    Dale 34 Owner First Name

36 10005 Old Columbia Rd. 55 Street or RFD

57 Columbia 70 Md. 72 21046 76 Town State Zip

**LOCATION OF WELL**

B 3 Howard 8 COUNTY

Quarterfield 23 SUBDIVISION

SECTION 44 46    LOT 35 48 50

West Friendship 52 NEAREST TOWN

MILES FROM TOWN (enter 0 if in town) 4 M 73 76 77 78

**DRILLER INFORMATION**

Joseph L. Mayne 76 Driller's Name    M S D O 24 81 License No.

Joseph L. Mayne Well Drilling Firm Name

5512 Ridge Rd. Mt. Airy Md 21771 Address

Joseph L Mayne 11/17/97 Signature Date

**DIRECTION OF WELL FROM TOWN (CIRCLE BOX)**

**NEAR WHAT ROAD** Whitetail Lane

**ON WHICH SIDE OF ROAD (CIRCLE APPROPRIATE BOX)**

34 30 37 DISTANCE FROM ROAD ENTER FT OR MI 38 39

TAX MAP: 23 BLK: 15 PARCEL 101

**WELL INFORMATION**

APPROX. PUMPING RATE (GAL. PER MIN.) 5

AVERAGE DAILY QUANTITY NEEDED (GAL. PER DAY) 500

**USE FOR WATER (CIRCLE APPROPRIATE BOX)**

HOME (SINGLE OR DOUBLE HOUSEHOLD UNIT ONLY)

FARMING (LIVESTOCK WATERING & AGRICULTURAL IRRIGATION)

INDUSTRIAL, COMMERCIAL, STATE AND FEDERAL GOV. OTHER (REQUIRES APPROPRIATION PERMIT)

PUBLIC OR PRIVATE WATER COMPANY (REQUIRES APPROPRIATION PERMIT AND STATE APPROVAL)

TEST, OBSERVATION, MONITORING (MAY REQUIRE APPROPRIATION PERMIT)

**NOT TO BE FILLED IN BY DRILLER: HEALTH DEPARTMENT APPROVAL**

Howard COUNTY NAME    A48851 COUNTY NO.

STATE SIGNATURE \_\_\_\_\_ INSERT S → S

DATE ISSUED 10/23/98 Mark E. Palkin 10/23/99 EXP. DATE

43 521 000 55 NORTH GRID    0826 000 63 EAST GRID

APPROXIMATE DEPTH OF WELL 240 FEET

APPROXIMATE DIAMETER OF WELL 6 INCH

**SHOW MAJOR FEATURES OF BOX & LOCATE WELL WITH AN X**

**SOURCES OF DRILLING WATER**

- Well
- 
- 

WRITE THE BOX NUMBER FROM THE MAP HERE

E 826/6

N 521/1

000  
000

*2/18/99 9:30 Grant 2/19/99 9:30 Canceled*

*Muskel map*

**METHOD OF DRILLING (circle one)**

BORED (or Augered)    JETTED    Jetted & DRIVEN

AIR-ROTARY    AIR-PERCussion    ROTARY (Hydraulic Rotary)

CABLE    REVerse-ROTARY    DRive-POINT

other \_\_\_\_\_

**REPLACEMENT OR DEEPEINED WELLS (CIRCLE APPROPRIATE BOX)**


THIS WELL WILL NOT REPLACE AN EXISTING WELL

THIS WELL WILL REPLACE A WELL THAT WILL BE ABANDONED AND SEALED

THIS WELL WILL REPLACE A WELL THAT WILL BE USED AS A STANDBY-CONTACT LOCAL APPROVING AUTHORITY FOR POLICY ON STANDBY WELLS

THIS WELL WILL DEEPEIN AN EXISTING WELL


PERMIT NUMBER OF WELL TO BE REPLACED OR DEEPEINED (IF AVAILABLE) 41 \_\_\_\_\_ 52

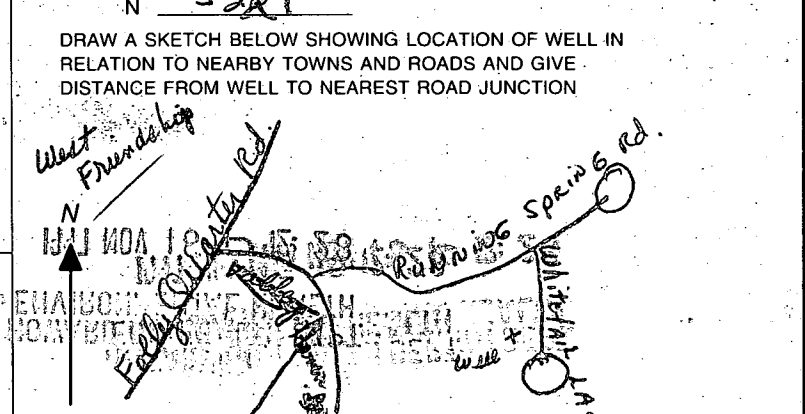

**Not to be filled in by driller (MDE OR COUNTY USE ONLY)**

APPROP. PERMIT NUMBER 54 G A P \_\_\_\_\_ 63

FORCE MR WRITE INITIALS IN BOX PERMIT No. HO-94-1798

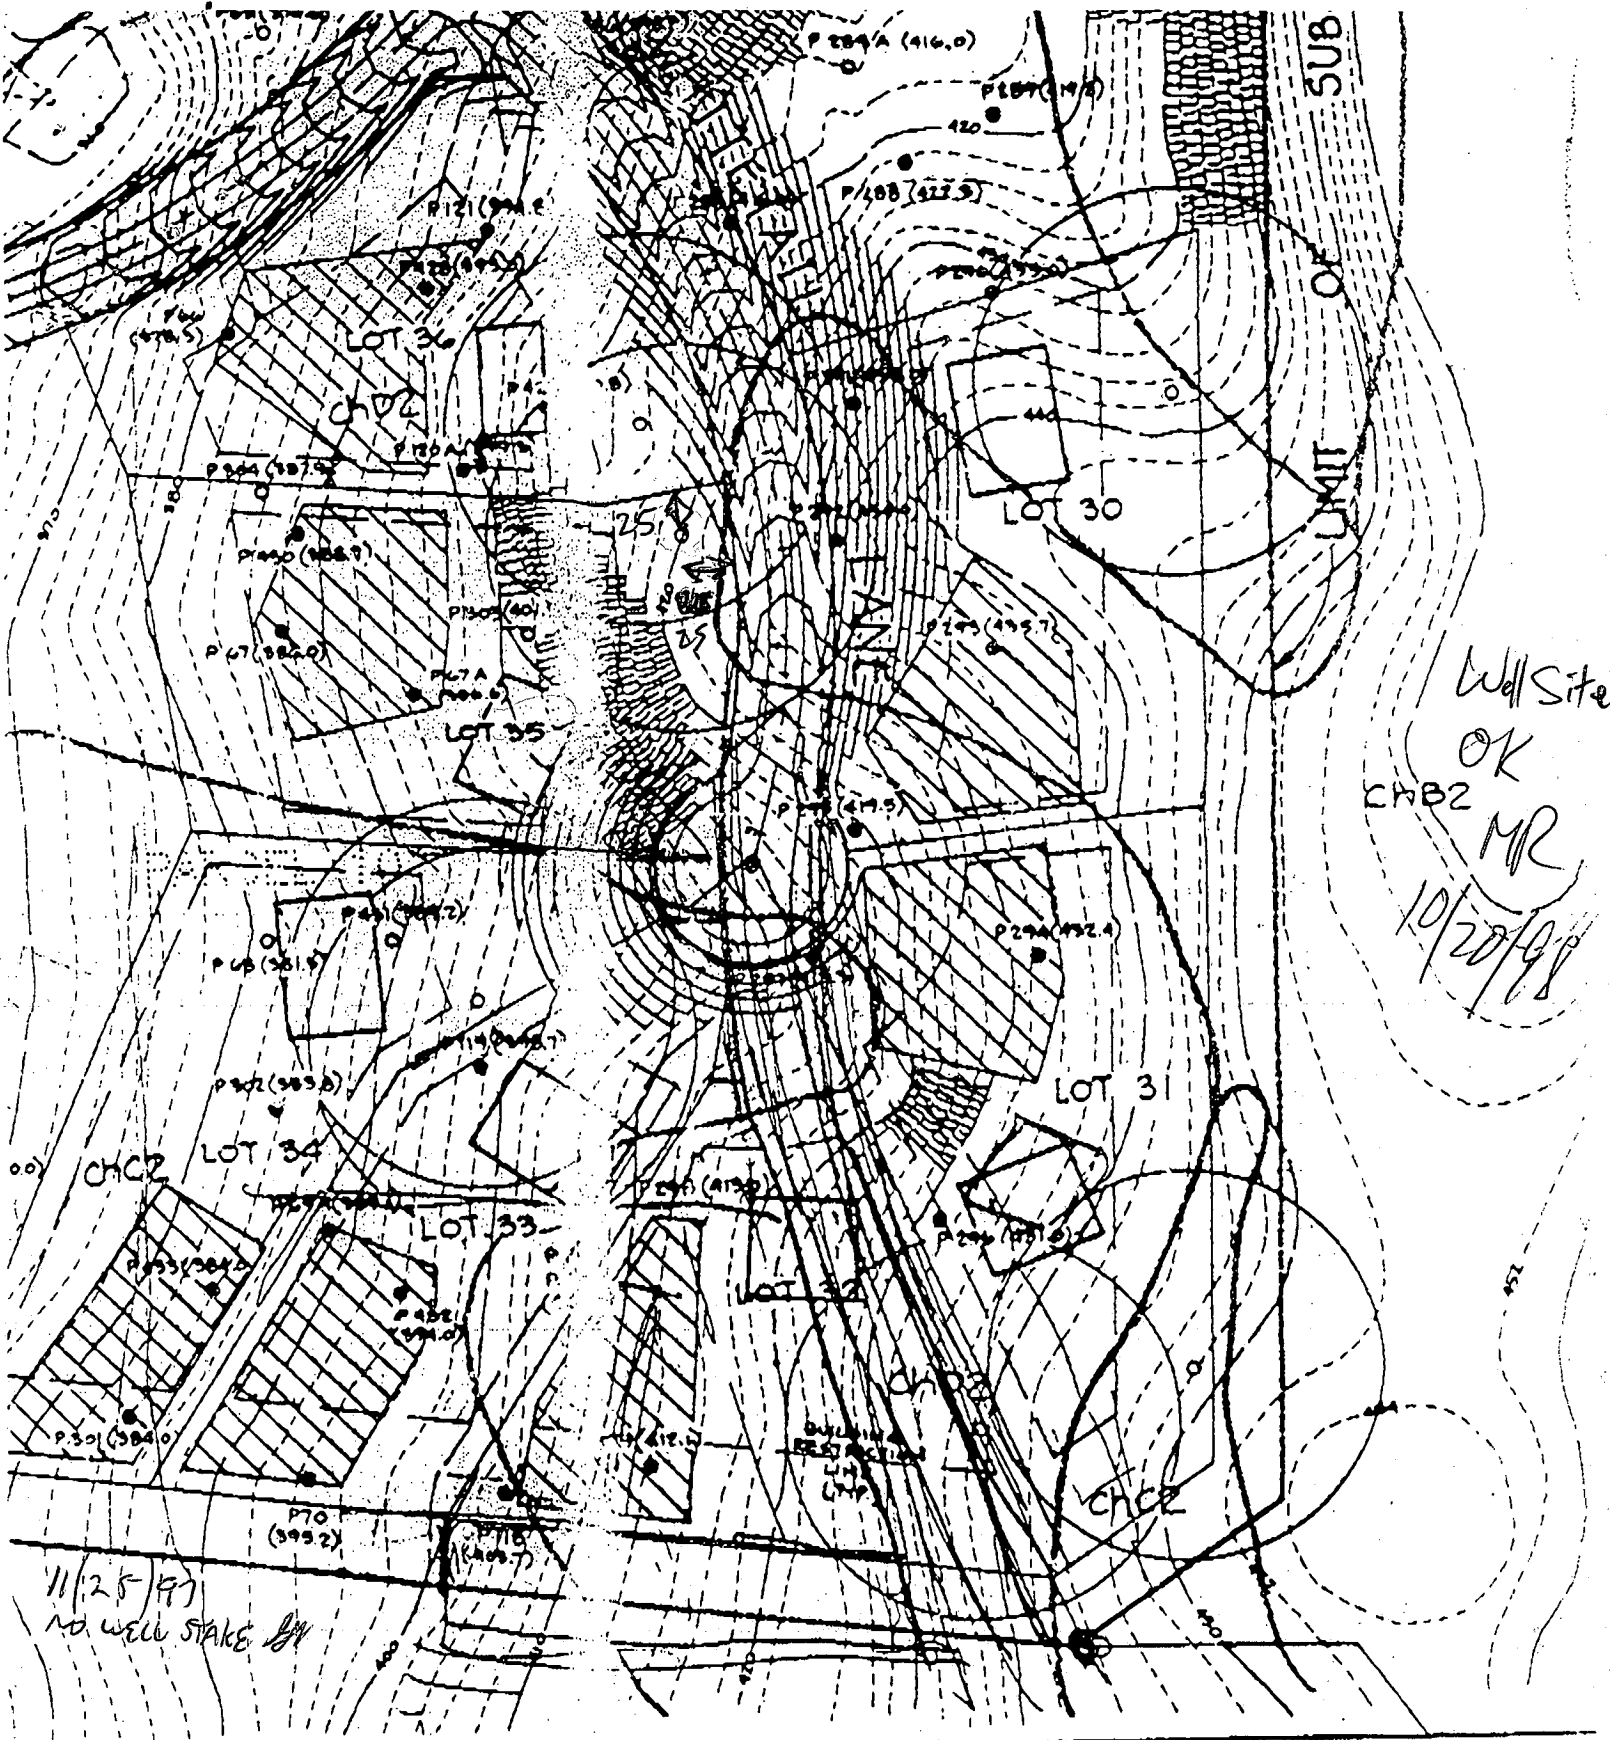

Well Site  
OK  
CHB2  
MR  
10/20/98

11/25/97  
NO. WELL STAKE BY

NO	DATE	REVISION