



HOWARD COUNTY HEALTH DEPARTMENT

67389

DATE
5/7/20

AS

Received From

Fogles Septic Clean PHONE # 410-795-5670

For

11706 Waymeridge Ct
Perc Test / Pumping Septic Tank

CASH

CHECK

NO.

68049 Three Hundred Thirty Dollars


\$

330.00

Received By

M Youmans

A567389
P567389

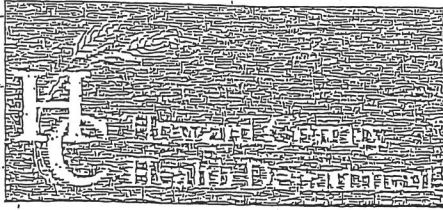

Bureau of Environmental Health

8930 Stanford Boulevard, Columbia, MD 21045
Main: 410-313-2540 | Fax: 410-313-2548
TDD: 410-313-2323 | Toll Free: 1-866-313-6300
www.hchealth.org
Facebook: www.facebook.com/hchealth
Twitter: HowardCoHealthDep

Dr. Maura J. Rossman, M.D., Health Officer

INFORMATION FORM - SEPTIC SYSTEM REPAIR/UPGRADE

Reason for Request:

- Failing System
- System relocation for proposed addition
- System upgrade for proposed addition
- Inadequate treatment zone
- Collapsed septic tank
- Collapsed drywell

Has the septic tank been pumped within the last month?

- Yes Date pumped: 4/3/20
- No

Was a visual inspection of the septic tank and/or drain fields conducted?

- Yes Explain observations: Drywell overflow
- No

Existing system design

- Drywell
- Trench
- Mound
- Unknown
- Other: _____

Was a visual inspection of the sewage line conducted?

- Yes
- Blockage leading to the tank
 - Yes Explain: _____
 - No
- Blockage leading to the field
 - Yes Explain: _____
 - No

Is discharge surfacing on the ground?

- Yes * BACK FLOW FROM DW INTO TANK. NO SURFACE DISCHARGE.
- No

Additional Comments: _____

*For REPAIRS, are the owners proposing, or do they plan to add in the future, any additions or modifications to the property, i.e. pools, living space additions, garages, etc? This information must be disclosed at the time of this application. The Health Department will not be able to accommodate requests in the field for property modifications unrelated to the repair request. Such requests may require an additional fee, testing, and submittal of a Percolation Certification Plan, if the property does not meet current Code and Regulation.

Septic Contractor: Fogle's Septic Clean Contractor's Phone: 410-795-5670
 Contractor's Address: 580 Obrecht Rd, Sykesville 21784
 Property Address: 11706 Wayneridge Ct County file: _____
 Subdivision: Monrestfield Lot: _____ Year Built: 1968
 Owner's Name: Mark Trumbore Owner's Phone: 508-846-0028

Name of previous owners: _____ Existing bedrooms: 4
 Proposed bedrooms: _____

Has this request been previously discussed with a Sanitarian? (Name): _____
 Public Sewer available/nearby: _____

*A Sanitarian will be in contact within three business days, depending upon the urgency of the situation, to coordinate the scheduling/review of the repair or upgrade.

Prior to scheduling inspections, scaled plans should be submitted to clarify the nature of the addition.

Print out a copy of Real Property Data via Dept. of Taxation website _____ Indexed file found _____

If public sewer may be nearby, verify whether sewer is technically "available" through the Bureau of Engineering.

If sewer is available and the property is within the Metropolitan District, connection to sewer is required. If the owner believes reason for exemption exists, the owner should justify the request in writing.

If soil/site conditions are limited and sewer and/or Metro District status is not conducive to connection, the Sanitarian may recommend pursuit of Emergency Sewer Extension or Emergency Metro District Inclusion. The Owner should contact the Bureau of Utilities for details.

No permit is to be issued nor inspection to be scheduled without prior fee collection at the office unless an emergency situation exists. The contractor is to notify office of the emergency situation as soon as possible.



**Howard County
Health Department**

Maura J. Rossman, M.D., Health Officer

Bureau of Environmental Health

8930 Stanford Boulevard, Columbia, MD 21045

Main: 410-313-2640 | Fax: 410-313-2648

TDD 410-313-2323 | Toll Free 1-866-313-6300

www.hchealth.org

Facebook: www.facebook.com/hocohealth

RECEIPT DATE: 5/7//20 **ONSITE SEWAGE DISPOSAL SYSTEM** P 567389

APPROVAL DATE: 05/18/2020 **PERMIT:** **REPAIR** A 567389

PROPERTY ADDRESS: 11706 Wayneridge Court

SUBDIVISION: Mooresfield LOT: 6b TAX ID: 05-342341

CONTRACTOR: Fogles Septic Clean Inc EMAIL: kim@foglesinc.com

CONTRACTOR ADDRESS: 580 Obrecht Road, Sykesville, MD 21784 PHONE: 410-795-5670

PROPERTY OWNER: Mark Trumbore EMAIL: _____

OWNER ADDRESS: 11706 Wayneridge Court, Fulton, MD 20759 PHONE: 508-846-0028

SEPTIC TANK SIZE (GALLONS): EXISTING PUMP CHAMBER CAPACITY (GALLONS): - PUMP SIZE: -

NUMBER OF BEDROOMS: 4 HOUSE SQ. FT. - APPLICATION RATE: 1.2

DISTRIBUTION SYSTEM: GRAVITY FED LOW PRESSURE DOSED

TRENCHES:	LINEAR FEET REQUIRED: <u>72'</u>	INLET DEPTH: <u>4'</u>
	TRENCH WIDTH: <u>3'</u>	MAXIMUM BOTTOM DEPTH: <u>10'</u>
	MINIMUM SPACE BETWEEN TRENCHES: <u>11'</u>	EFFECTIVE AREA BEGINNING DEPTH: <u>6'</u>

LOCATION: **TO BE STAKED BY SANITARIAN DURING PRE-CONSTRUCTION INSPECTION.**

NOTES: 2 x 36' TRENCHES. USING PERC B ON LOWER TRENCH BOUND
BY 25' SETBACK TO SWALE AND 100' SET BACK TO NEIGHBORING
WELL.
ADD TANK RISER. ABSORAL EX DW. REPLACE ALL ORANGE

ISSUED BY: JOSEPH CABALLUS ISSUE DATE: 05/14/2020 EXPIRATION DATE: 05/14/2021

- NOTE: CONTRACTOR MUST SCHEDULE A PRE-CONSTRUCTION INSPECTION PRIOR TO BEGINNING ANY INSTALLATION
- NOTE: CONTRACTOR MUST SCHEDULE AN INSPECTION AND GAIN APPROVAL OF ALL COMPONENTS PRIOR TO COVERING
- NOTE: STONE MUST BE APPROVED BY HEALTH DEPARTMENT AND GRAVEL TICKET MUST BE AVAILABLE FOR REVIEW.
- NOTE: WATERTIGHT SEPTIC TANKS REQUIRED
- NOTE: ALL PARTS OF SEPTIC SYSTEM SHALL BE AT LEAST 100 FEET DOWNGRADE FROM ANY WATER WELL
- NOTE: MANHOLE RISERS REQUIRED ON ALL SEPTIC TANKS AND PUMP CHAMBERS
- NOTE: AN ELECTRICAL PERMIT IS REQUIRED FOR INSTALLATION OF ANY ELECTRICAL COMPONENTS OF THE SYSTEM
 ELECTRICAL PERMIT ISSUED E -
- NOTE: THE HCHD DOES NOT WARRANTY ANY SYSTEM AND CANNOT GUARANTEE THE PERFORMANCE OF THIS SYSTEM AS DESIGNED. BY ACCEPTING THIS PERMIT, THE OWNER AND/OR APPLICANT ACKNOWLEDGE THAT THE SPECIFICATIONS DETAILED IN THIS DESIGN ARE ONE POSSIBLE OPTION AND THAT THE HCHD WILL REVIEW OTHER PROPOSALS. YOU HAVE THE OPTION TO SEEK THE ADVICE OF A QUALIFIED DESIGN CONSULTANT OR PROFESSIONAL ENGINEER FOR FURTHER GUIDANCE.
- NOTE: MDE RECOMMENDS SEPTIC TANKS, BAT, AND OTHER PRETREATMENT UNITS BE PUMPED AT A FREQUENCY ADEQUATE TO ENSURE THAT SOLIDS ARE NOT DISCHARGED TO THE DISPOSAL AREA

NEITHER THE HOWARD COUNTY COUNCIL NOR THE HEALTH DEPARTMENT IS RESPONSIBLE FOR THE SUCCESSFUL OPERATION OF ANY SYSTEM.
PERMITTEE RESPONSIBLE FOR OBTAINING FINAL APPROVAL ON THIS PERMIT.
CALL 410-313-1771 TO SCHEDULE INSPECTIONS.


279489279189

NOT TO SCALE

TRENCH/DRAINFIELD DATA		
WIDTH	INLET	BOTTOM
3'	4'	10'
NUMBER OF TRENCHES	2	
TOTAL LENGTH	40F	
ABSORPTION AREA	120 SF + SIDE WALL	
DISTRIBUTION BOX LEVEL	SPEED	
DISTRIBUTION BOX BAFFLE	YES	
DISTRIBUTION BOX PORT	YES	

PRE-CONSTRUCTION:

SEPTIC TANK DATA	
SEPTIC TANK 1 LEVEL	_____
MANUFACTURER	_____
CAPACITY	_____ GAL
SEAM LOC	_____
TANK LID DEPTH	3'
BAFFLES	OUTLET
BAFFLE FILTER	_____
MANHOLE LOC	INLET
6" PORT LOC	OUTLET
WATERTIGHT TEST	_____
SLOTTED	_____
DATE ON LID	_____
PUMP/SEPTIC TANK LEVEL	_____
MANUFACTURER	_____
CAPACITY	_____ GAL
SEAM LOC	_____
TANK LID DEPTH	_____
BAFFLES	_____
BAFFLE FILTER	_____
MANHOLE LOC	_____
6" PORT LOC	_____
WATERTIGHT TEST	_____
SLOTTED	_____
DATE ON LID	_____

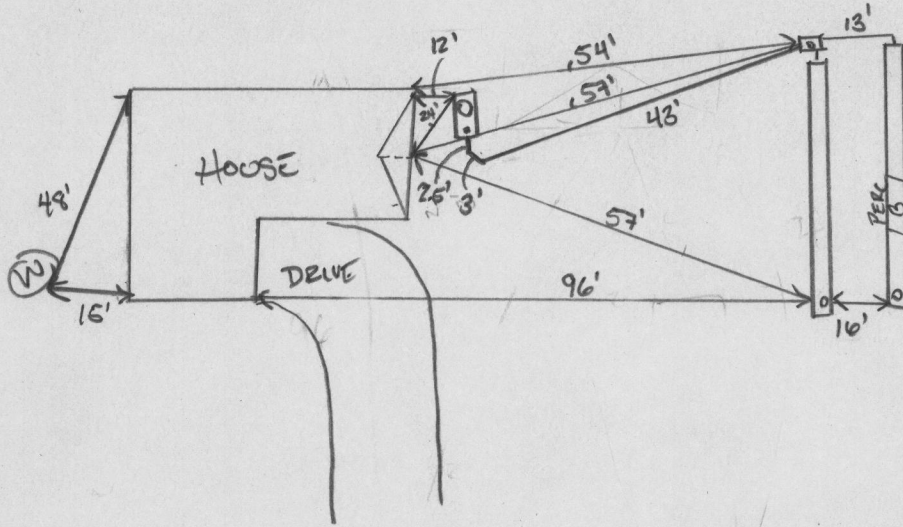

ROAD NAME
WAYNERIDGE COURT

05/14/2020 TRENCHES LAID OUT AFTER PERC. (+)

INSTALLATION:

05/15/2020 NEW D BOX TIED INTO EXISTING TANK. UPPER TRENCH BEING CONSTRUCTED (+) (PM) TRENCHES COMPLETE. D BOX LEVELED WITH SPEED LEVELS. EX DN PUMPED. NEW RISER INSTALLED ON EX TANK. (+)

05/18/2020 DWS FILLED; OUTLET BAFFLE INSTALLED. (+)

FINAL INSPECTOR

DATE OF APPROVAL

05/18/2020