

PERMIT

SEWAGE DISPOSAL SYSTEM

DEPARTMENT OF HEALTH AND MENTAL HYGIENE

HOWARD COUNTY HEALTH DEPARTMENT

BUREAU OF ENVIRONMENTAL HEALTH

~~XXXXXX~~

410-313-2640

INDEXED

P 512766

A REPAIR

DISTRICT

DATE 10-15-1999

DATE SYSTEM APPROVED 10/19/99

INSPECTOR Am

Hatfield's Equipment & Dedication Service

IS PERMITTED TO INSTALL ALTER X

ADDRESS 13785 Burntwoods Road, Glenelg, Maryland 21737 PHONE 410-854-6172

SUBDIVISION LOT ROAD 6421 William Street

PROPERTY OWNER Wayne Pennell
6421 William Street

ADDRESS Hanover, Maryland 21076

SEPTIC TANK CAPACITY 1000 GALLONS TOP SEAMED

NUMBER OF BEDROOMS

 SQUARE FEET PER BEDROOM

LINEAR FEET OF TRENCH REQUIRED

REPAIR - Metal Septic Tank Has Collapsed.

Metal Tank Was Replaced With A 1000 Gallon Top Seamed Concrete Tank. On 10-08-1999.

BUILDING PERMIT SIGNED AND RETURNED

7/24/2002 B00137657 SUNROOM

PLANS APPROVED BY Amy McMillen

DATE 10-15-1999

COVER NO WORK UNTIL INSPECTED AND APPROVED

NEITHER THE HOWARD COUNTY COUNCIL NOR THE HEALTH DEPARTMENT IS RESPONSIBLE FOR THE SUCCESSFUL OPERATION OF ANY SYSTEM

NOTE: CLEANOUT REQUIRED EVERY 70 FEET OF SEWER LINE AND/OR AT 90° SWEEPS IN LINES FROM HOUSE TO DRAIN FIELDS. 90° ELBOWS NOT ACCEPTABLE.

NOTE: ALL PARTS OF SEPTIC SYSTEMS (I.E. TANK, DISTRIBUTION BOX TRENCHES) TO BE 100 FEET FROM WELL (UNLESS OTHERWISE SPECIFICALLY AUTHORIZED)

NOTE: IF DEEP TRENCH(ES) ARE USED CALL FOR INSPECTION BEFORE AND AFTER PLACING GRAVEL IN TRENCH(ES)

NOTE: NO DRY WELL SHALL EXCEED 15 FOOT IN DIAMETER NO ABSORPTION TRENCH TO EXCEED 100 FEET IN LENGTH

NOTE: ALL PIPE FROM HOUSE TO SEPTIC TANK MUST BE CAST IRON OR SCHEDULE 35/40 PVC OR ABS

PERMIT VOID AFTER TWO YEARS

NOTE: INSTALL STAND PIPE ON SEPTIC TANK AND DRY WELL STAND PIPES MUST BE 6 INCHES IN DIAMETER CAST IRON, CONCRETE OR TERRA COTTA OR PVA OR ABS ACCEPTED. IF TOP OF SEPTIC TANK IS DEEPER THAN 3 FEET, MANHOLE TO GRADE REQUIRED.

NOTE: DISTRIBUTION BOXES MUST HAVE Baffles

*INSTALLER IS RESPONSIBLE FOR OBTAINING FINAL APPROVAL ON THIS PERMIT

512766

	50	100	150	200	250
250					
200					
150					
100					
50					

See attached
for contractor's
drawing -
tank collapsed during a
3 day weekend - emergency
replacement w/o
permit or inspection *A*

INDICATE NORTH - NAME ADJOINING ROADWAY AS BASE LINE

BUILDING PERMIT SIGNED
AND RETURNED

SEPTIC TANK LEVEL _____

CLEANOUTS _____

DISTRIBUTION BOX LEVEL _____

DRAIN FIELD/TITLE DEPTH _____ FT.

TRENCH WIDTH _____ FT.

INLET DEPTH _____ FT.

EFFECTIVE GRAVEL DEPTH _____ FT.

TOTAL LENGTH _____ FT.

NUMBER OF TRENCHES _____

ONE SIDEWALL/BOTTOM AREA _____ SQ. FT.

DRYWALL INSIDE DIAMETER _____ FT.

EFFECTIVE DEPTH BELOW INLET _____ FT.

ABSORBENT AREA _____ SQ. FT.

REMARKS: _____

DATE SYSTEM APPROVED

10/19/99


INSPECTOR

Amy McMill

Paid - Receipt # P512766 ✓
Do you know where file is?
mlb
10-15-99,

Howard County Health Department
Environmental Health
Attn Amy

Emergency Septic Repair
Metal Tank Failure 10/11/99
Installed a new 1,000 Gal Top Seam
Owner: Wayne Pennell
6421 William St.
Hanover MO. 21076

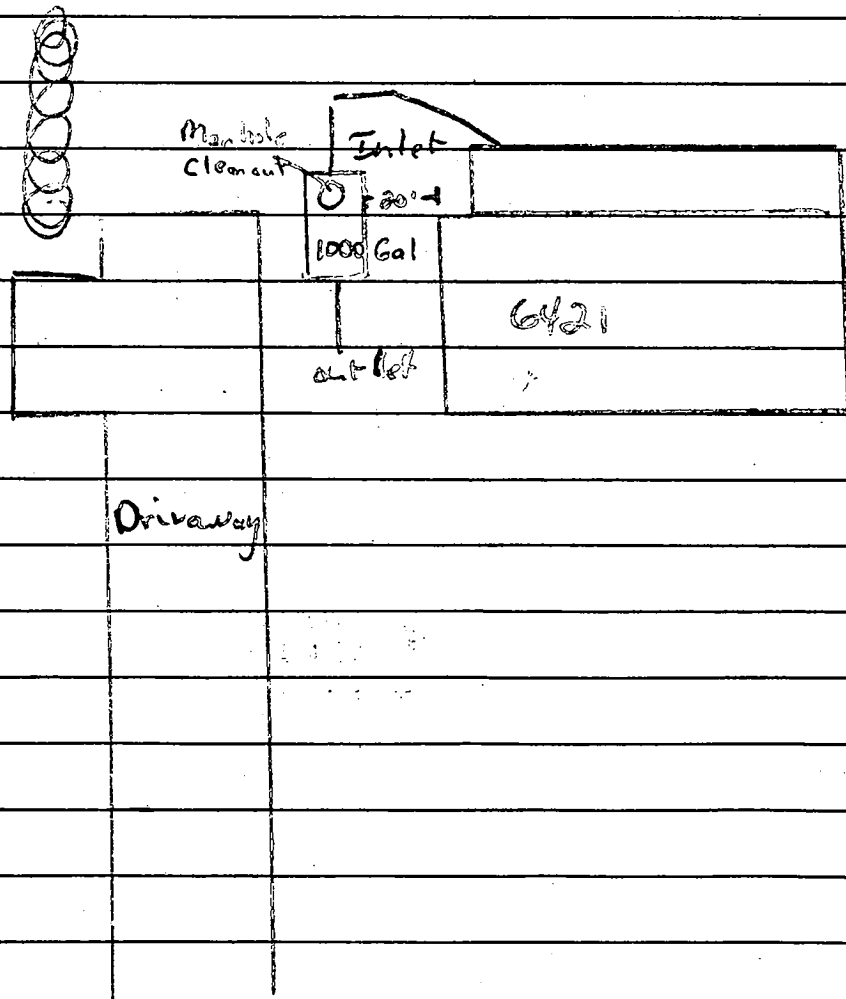

6280 William St.

