

APPLICATION

A 21383

P _____

SEWAGE DISPOSAL TESTING

STATE OF MARYLAND - DEPARTMENT OF HEALTH AND MENTAL HYGIENE

HOWARD COUNTY HEALTH DEPARTMENT
ENVIRONMENTAL HEALTH SERVICESDISTRICT 3P. O. BOX 476, ELLICOTT CITY, MARYLAND 21043
TELEPHONE: 465-5000, EXT. 356DATE 4/21/75

4-12' Leases on 10,000 ft. Preliminary

3 B.R. 1000 gal. septic tank | 4 B.R. 1250 gal. septic tank

Drywell to have 125 sq. ft effective sidewall absorption area per bedroom to begin below the first 5 ft. of non-porous soil. Maximum depth permitted for drywell is 11 ft below original grade, with drywell inlet at 3 ft below original grade. Place the drywell 150 ft from the left side line and 20 ft from the rear lot line, as seen when facing the property from Williamfield Drive.

TO: THE COUNTY HEALTH OFFICER
ELLICOTT CITY, MARYLAND

I, HEREBY, APPLY FOR THE NECESSARY TEST IN ORDER TO CONSTRUCT (OR RECONSTRUCT) A SEWAGE DISPOSAL SYSTEM.

PROPERTY OWNER John Mikalasko & A. A. KrometisADDRESS 2205 Foxley Road, Timonium, Md. 21093 PHONE Work 765-2930
(Westinghouse)

PROPERTY LOCATION:

SUBDIVISION Rosemary Estates LOT NO. 25 DROAD AND DESCRIPTION r/w off Williamfield DriveSIZE OF LOT 1.253 acres TYPE BLDG. 3 or 4

NUMBER OF BEDROOMS

IF NOT SINGLE RESIDENCE DESCRIBE (Single Fmly. Dwllg.)

THE SYSTEM INSTALLED UNDER THIS APPLICATION IS ACCEPTABLE ONLY UNTIL PUBLIC FACILITIES BECOME AVAILABLE.

SIGNATURE OF APPLICANT /s/ John MikalaskoAPPROVED BY Frank Skene FOR Drywell DATE 1/21/76
(KIND OF SYSTEM)REJECTED BY _____ FOR _____ DATE _____
(KIND OF SYSTEM)


HOLD PENDING FURTHER TESTS _____ DATE _____

REASONS FOR REJECTION OR HOLDING _____

THIS IS NOT A PERMIT

CIRCLE

all holes
0' clayey
5' silty loam
12' some rotten shale

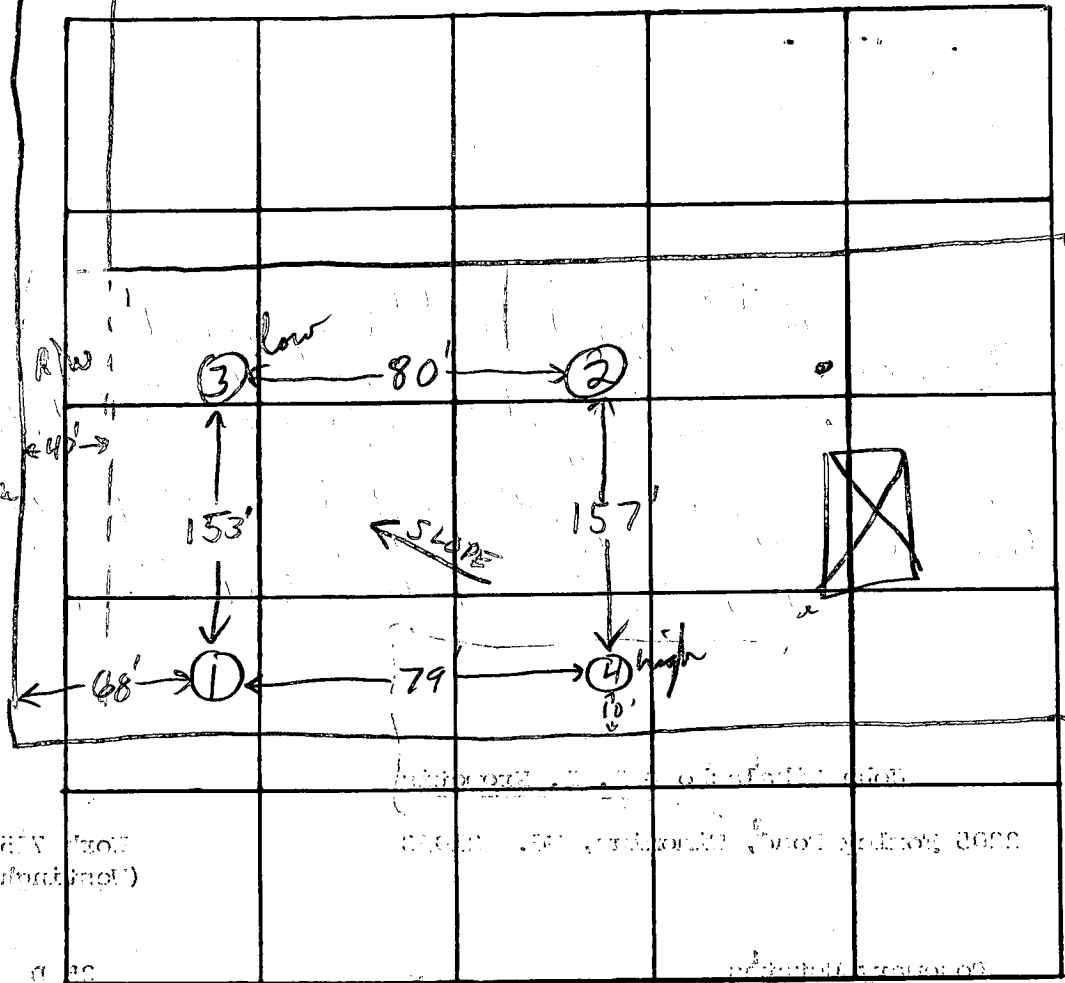

INDICATE NORTH. - NAME ADJOINING ROADWAY AS BASE LINE.

Triadelphia Rd

DATE	TEST NO.	DEPTH	PRE-WET		TEST - 1" DROP		TIME
			START	STOP	START	STOP	
4/22/75	1	5 1/2'	2:02	2:04	2:04	2:07	3 min
	1A	12 1/2'	2:02	2:05	2:05	2:09	4 min
	2	5 1/2'	2:07	2:09	2:09	2:12	3 min
	2A	12 1/2'	2:07	2:09	2:09	2:13	4 min
	3 low	5'	2:09	2:11	2:11	2:13	2 min
	3A	12'	2:09	2:11	2:11	2:14	3 min
	4 high	11'	Visual top 5' clayey, silty loam below				

4 primary
Soils 5'

REMARKS

TYPE OF SOIL

clayey to ~5', silty loam to some rotten shale below

TESTED BY

F.S.

ALSO PRESENT:

Fyock & Co.

Date _____

20

21A

22 A

N 11° 22' 55" W

15 D

25 A.

25 B

25C

24 A

50' R/W

586° 44' 53" W - 10.10

N 11° 22' 55" W

40' R/W

618.84'

798.33

● DENOTES FIELD LOCATION OF PERCOLATION TEST HOLE


LOT 25 D
PROPERTY OF
ROSE MARY ESTATES

3RD ELECTION DISTRICT
HOWARD COUNTY, MD.
JAN. 31, 1975. Revised Sept. 1, 1975
SCALE: 1" = 100'

PURDOM & JESCHKE
ENGINEERS &
LAND SURVEYORS
3697 PARK AVE.
ELLICOTT CITY, MD.

WILLIAMFIELD
DRIVE

Wykres 5

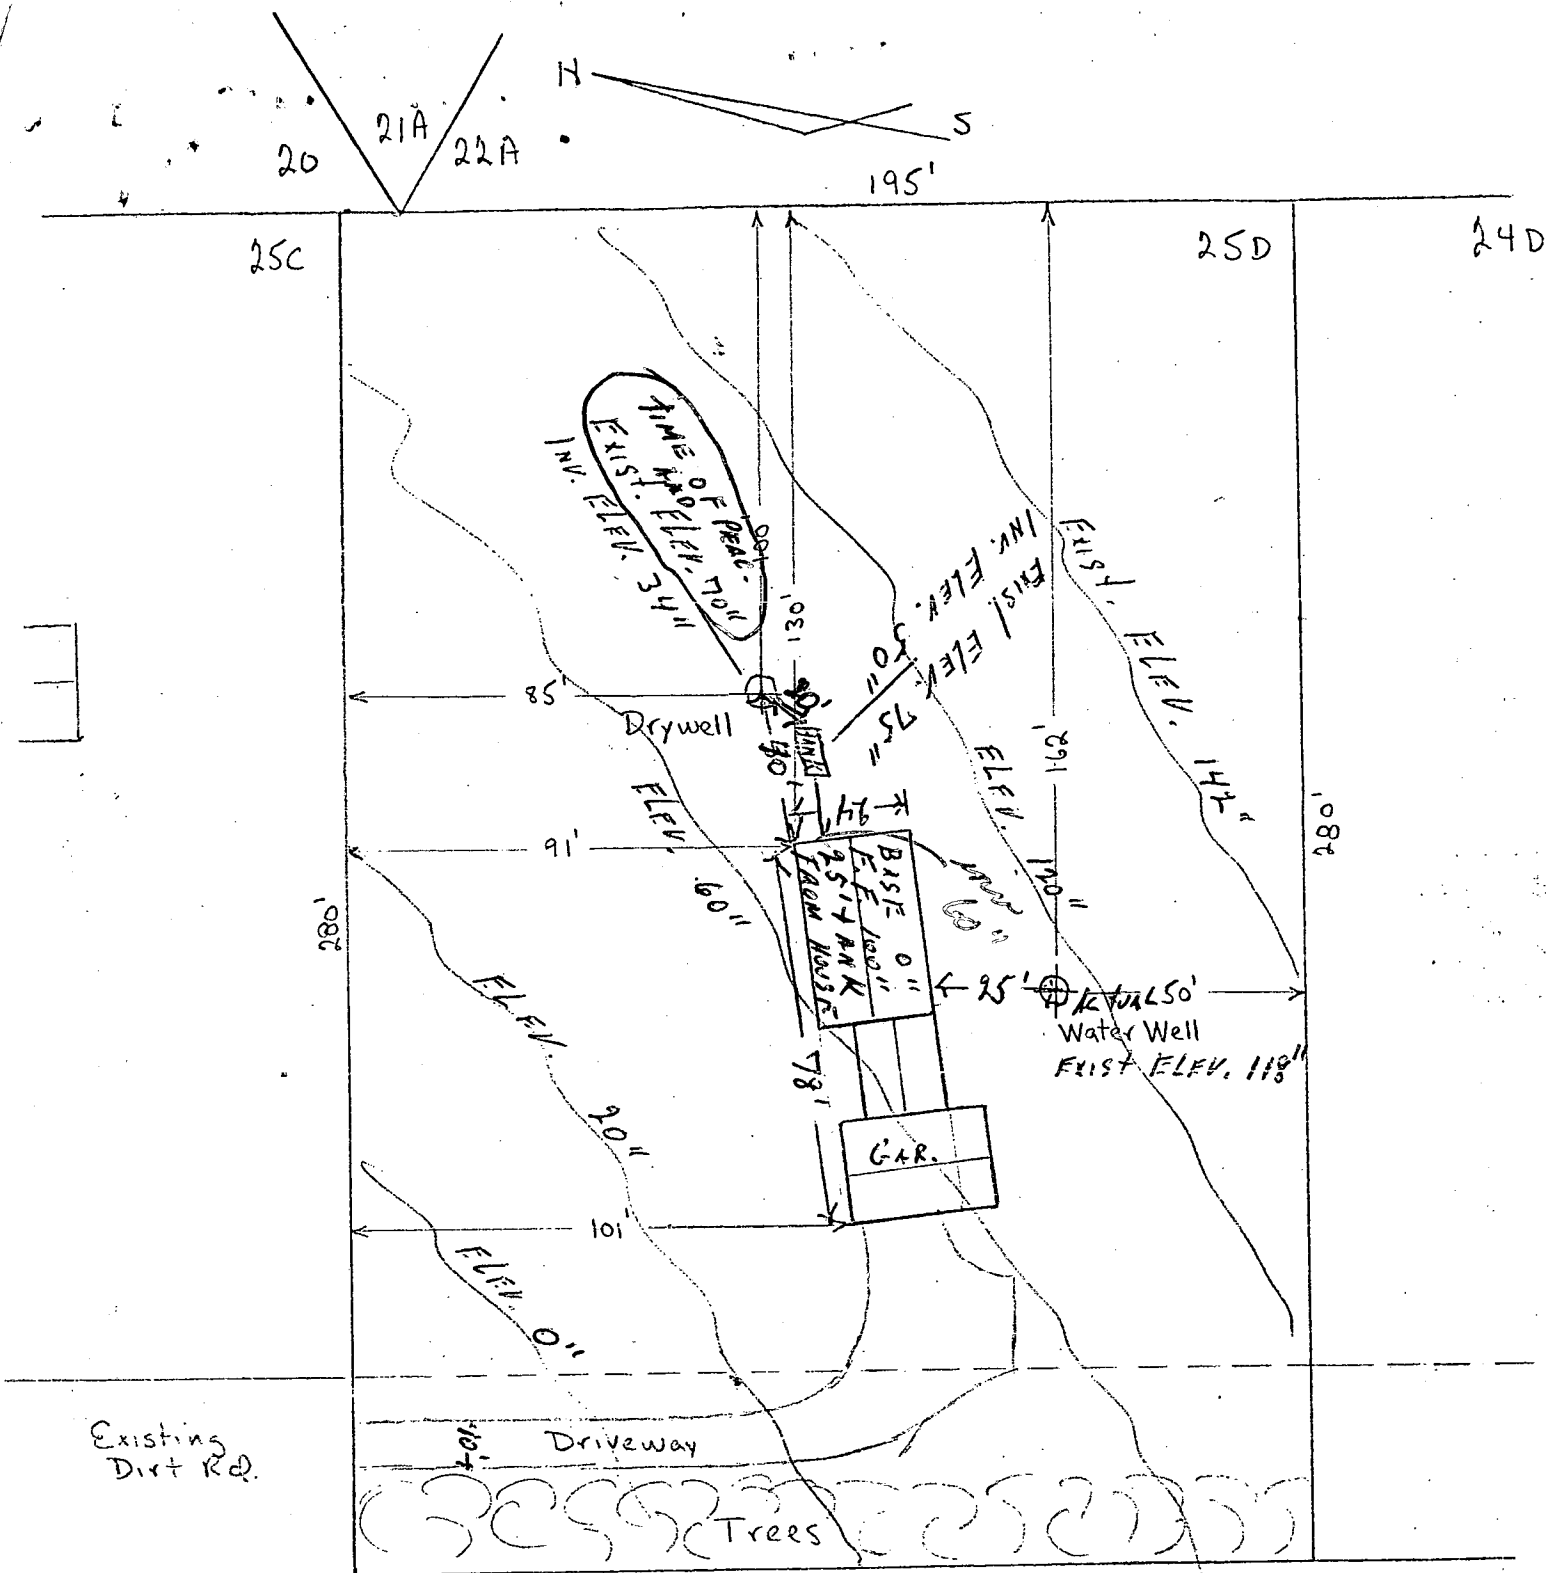

← Williamfield Dr.

SCALE 1/4" = 20'

I CERTIFY THESE MEASUREMENTS AND
 ELEVATIONS ARE CORRECT FOR THIS
 PROPERTY
 Rosemary Estates
 Lot 25D
 Christian Miller
 MILLER CONTRACTORS INC.