

A 26192

P\_\_\_\_\_

## SEWAGE DISPOSAL TESTING

STATE OF MARYLAND - DEPARTMENT OF HEALTH AND MENTAL HYGIENE

HOWARD COUNTY HEALTH DEPARTMENT  
ENVIRONMENTAL HEALTH SERVICES

DISTRICT 3rd

P. O. BOX 476, ELLICOTT CITY, MARYLAND 21043  
TELEPHONE: 465-5000, EXT. 356

DATE 6/24/77

TELEPHONE: 465-5000, EXT. 356

HOWARD COUNTY HEALTH DEPARTMENT  
ENVIRONMENTAL HEALTH SERVICES  
P. O. BOX 476, ELLICOTT CITY, MARYLAND 21043  
TELEPHONE: 465-5000, EXT. 356

3 BR 1000 gal Tank  
4 BR 1250 gal Tank

DISTRICT 3rd  
DATE 6/24/77

DRY WELL - 3 BR - 360 SPF 7 SIDEWALL AREA BELOW 1st FLOOR  
4 BR 480 11 11 11 11 11 11

DRY WELL INLET TO BE 3 FT BELOW ORIGINAL GRADE  
Bottom 11 11 11 11 11 11

Place the Dry Well 100 ft from the lotline  
which separates this lot from Lot 25C  
TO THE COUNTY HEALTH OFFICER  
ELLCOTT CITY, MARYLAND and 100 ft from the left side  
of the lot as seen when facing  
I, HEREBY, APPLY FOR THE NECESSARY TEST IN ORDER TO CONSTRUCT (OR RECONSTRUCT) A SEWAGE  
DISPOSAL SYSTEM. this lot from Williamfield Dr

I, HEREBY, APPLY FOR THE NECESSARY TEST IN ORDER TO CONSTRUCT (OR RECONSTRUCT) A SEWAGE DISPOSAL SYSTEM. *this lot from Williamfield Rd*

PROPERTY OWNER Dennis Heinke Appt 3 P. to 12 M. — 70 M. pencil — 9 M. Stone

ADDRESS 5776 Stevens Forest Road, Columbia, Md. PHONE 997-0762

PROPERTY LOCATION:

SUBDIVISION (Rosemary Estates) LOT NO. 25D

ROAD AND DESCRIPTION r/w off Williamfield Drive

SIZE OF LOT 1.253 acres TYPE BLDG. 3 or (4)  
NUMBER OF BEDROOMS

IF NOT SINGLE RESIDENCE DESCRIBE

THE SYSTEM INSTALLED UNDER THIS APPLICATION IS ACCEPTABLE ONLY UNTIL PUBLIC FACILITIES BECOME AVAILABLE. BLDG. PERMIT SIGNED

SIGNATURE OF APPLICANT /s/ Dennis Heinke

BLDG. PERMIT SIGNED  
AND RETURNED 8/23/77

SIGNATURE OF APPLICANT /s/ Dennis Heinke Serial No. 33089  
APPROVED BY Raymond Hodge FOR Ray Wal DATE 6/30/77  
(KIND OF SYSTEM)


REJECTED BY \_\_\_\_\_ FOR \_\_\_\_\_ DATE \_\_\_\_\_  
(KIND OF SYSTEM)

HOLD PENDING FURTHER TESTS \_\_\_\_\_ DATE \_\_\_\_\_

REASONS FOR REJECTION OR HOLDING \_\_\_\_\_

# THIS IS NOT A PERMIT

180

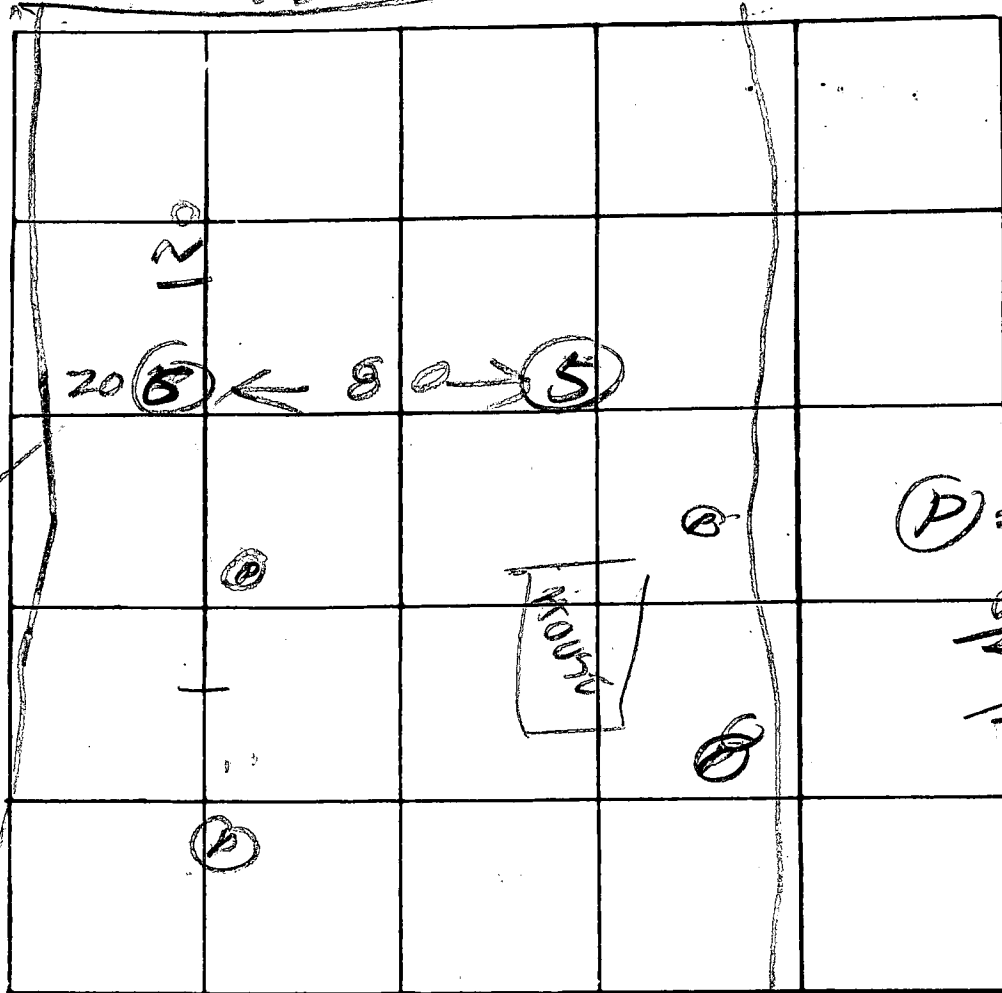

INDICATE NORTH - NAME ADJOINING ROADWAY AS BASE LINE

798

DATE	TEST NO.	DEPTH	PRE-WET		TEST - 1" DROP		TIME
			START	STOP	START	STOP	
6/30/77	55	3 1/2	132	133	133	135	2
L	5D	13	132	133	133	134	1
L	6V	12	ALL	SAND			

USE  
FOR  
DW

REMARKS

TYPE OF SOIL

TESTED BY

R.H.

ALSO PRESENT:

Fyock