

PERMIT

Final

P 27101

A 26192

SEWAGE DISPOSAL SYSTEM

MARYLAND STATE DEPARTMENT OF HEALTH

HOWARD COUNTY

ELLICOTT CITY

DISTRICT 3rd

INDEXED

DATE 10/24/77

Jack Fyock

IS PERMITTED TO INSTALL ALTER

ADDRESS 13775 Triadelphia Road, Glenelg, Md.

PHONE

A SEWAGE DISPOSAL SYSTEM LOCATED AT

SUBDIVISION (Rose Mary Estates)

ROAD

13091

Williamfield Drive

LOT

25=D

PROPERTY OWNER Dennis Heinke

ADDRESS 5776 Stevens Forest Road, Columbia, Md.

Phone: 997-0762

SPECIFICATIONS 4 bedrooms

DRAIN FIELD _____ DEPTH _____ FEET, BOTTOM AREA _____ SQ. FT.

SEEPAGE PITS _____ ABSORBENT SIDE-WALL AREA _____ SQ. FT.

SEPTIC TANK CAPACITY 1250 GALLONS

FOR GARBAGE GRINDER, INCREASE DISPOSAL AREA 22% & TANK CAPACITY 50%.

OTHER DRY WELL - 480 sq. ft. sidewall area below inlet. Dry well inlet to be 3 ft. below original grade. Dry well bottom to be 13 ft. below original grade. Place the dry well 100 ft. from the lot line which separates this lot from Lot 25-C and 100 ft. from the left side of the lot as seen when facing this lot from Williamfield Drive.

depth 3-12' 70 ft trench 9 ft stone

NOTE: NO DRY WELL IS TO EXCEED 15 FOOT IN DIAMETER.

NOTE: ALL PIPE FROM HOUSE TO DISPOSAL AREA MUST BE CAST IRON.

PERMIT VOID AFTER THREE YEARS.

NOTE: INSTALL STAND PIPE ON SEPTIC TANK AND DRY WELL. STAND PIPES MUST BE 6 INCHES IN DIAMETER. CAST IRON, CONCRETE OR TERRA COTTA ACCEPTED.


PLANS APPROVED BY Raymond Hodges

DATE 6/39/77

FILL SEPTIC TANK AND DISTRIBUTION BOX WITH WATER BEFORE CALLING FOR AN INSPECTION. COVER NO WORK UNTIL INSPECTED AND APPROVED.

NEITHER THE HOWARD COUNTY COMMISSIONERS NOR THE HEALTH DEPARTMENT IS RESPONSIBLE FOR THE SUCCESSFUL OPERATION OF ANY SYSTEM.

A
26192

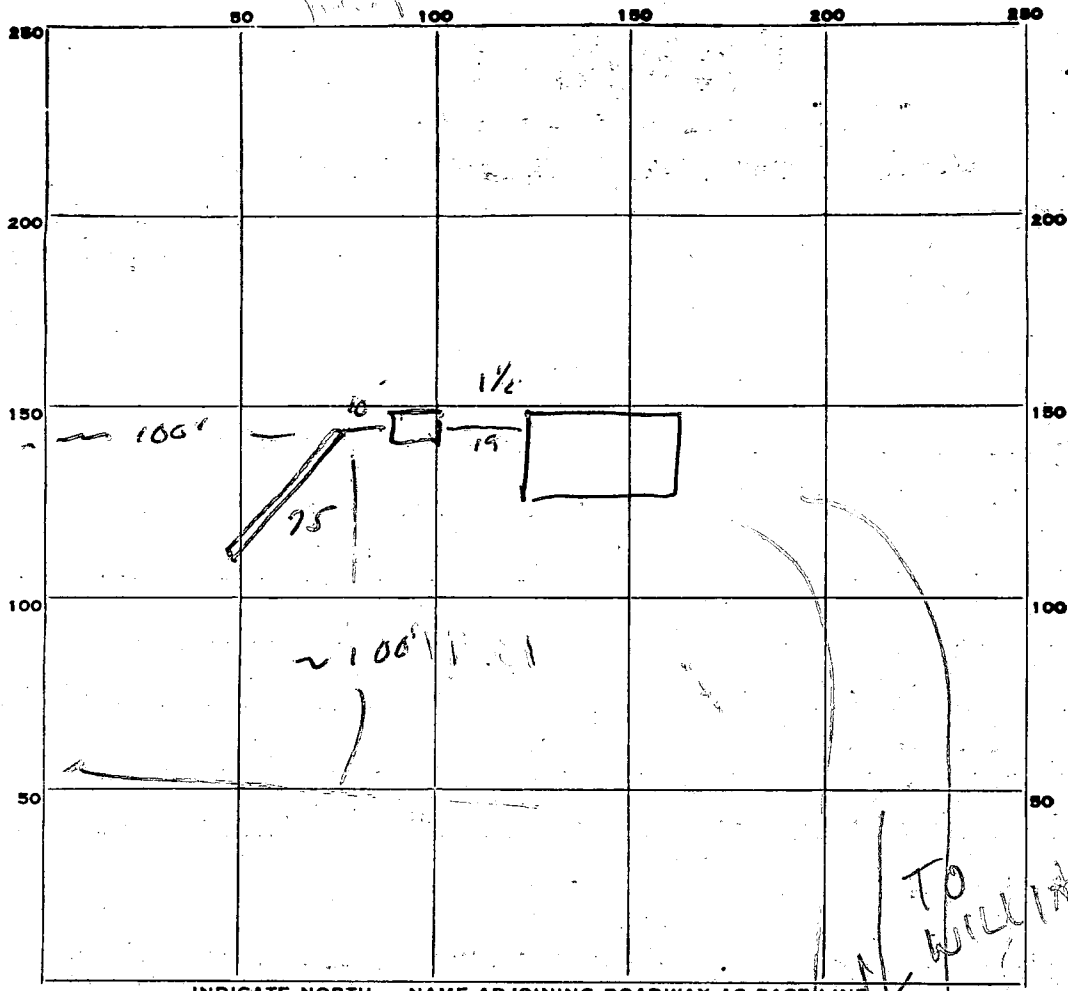

INDICATE NORTH. - NAME ADJOINING ROADWAY AS BASE LINE

PERMIT CARD Fm4

ST

SEPTIC TANK, LEVEL

CLEANOUTS

DISTRIBUTION BOX, LEVEL N/A

TILE FIELD, DEPTH 12 FT. TRENCH WIDTH 2' FT.

GRAVEL DEPTH 9' IN. TOTAL LENGTH 75 FT.

NUMBER OF TRENCHES 1 TOTAL ^{side} BOTTOM AREA 695

SEEPAGE PITS, INSIDE DIAMETER _____ FT. DEPTH BELOW INLET _____ FT.

ABSORBENT AREA 695 SQ. FT.

REMARKS _____

DATE SYSTEM APPROVED 11/3/09

INSPECTOR [Signature]