


*** SEE DECK CODE COMPLIANCE GUIDELINES
FOR MINIMUM SPECIFICATIONS

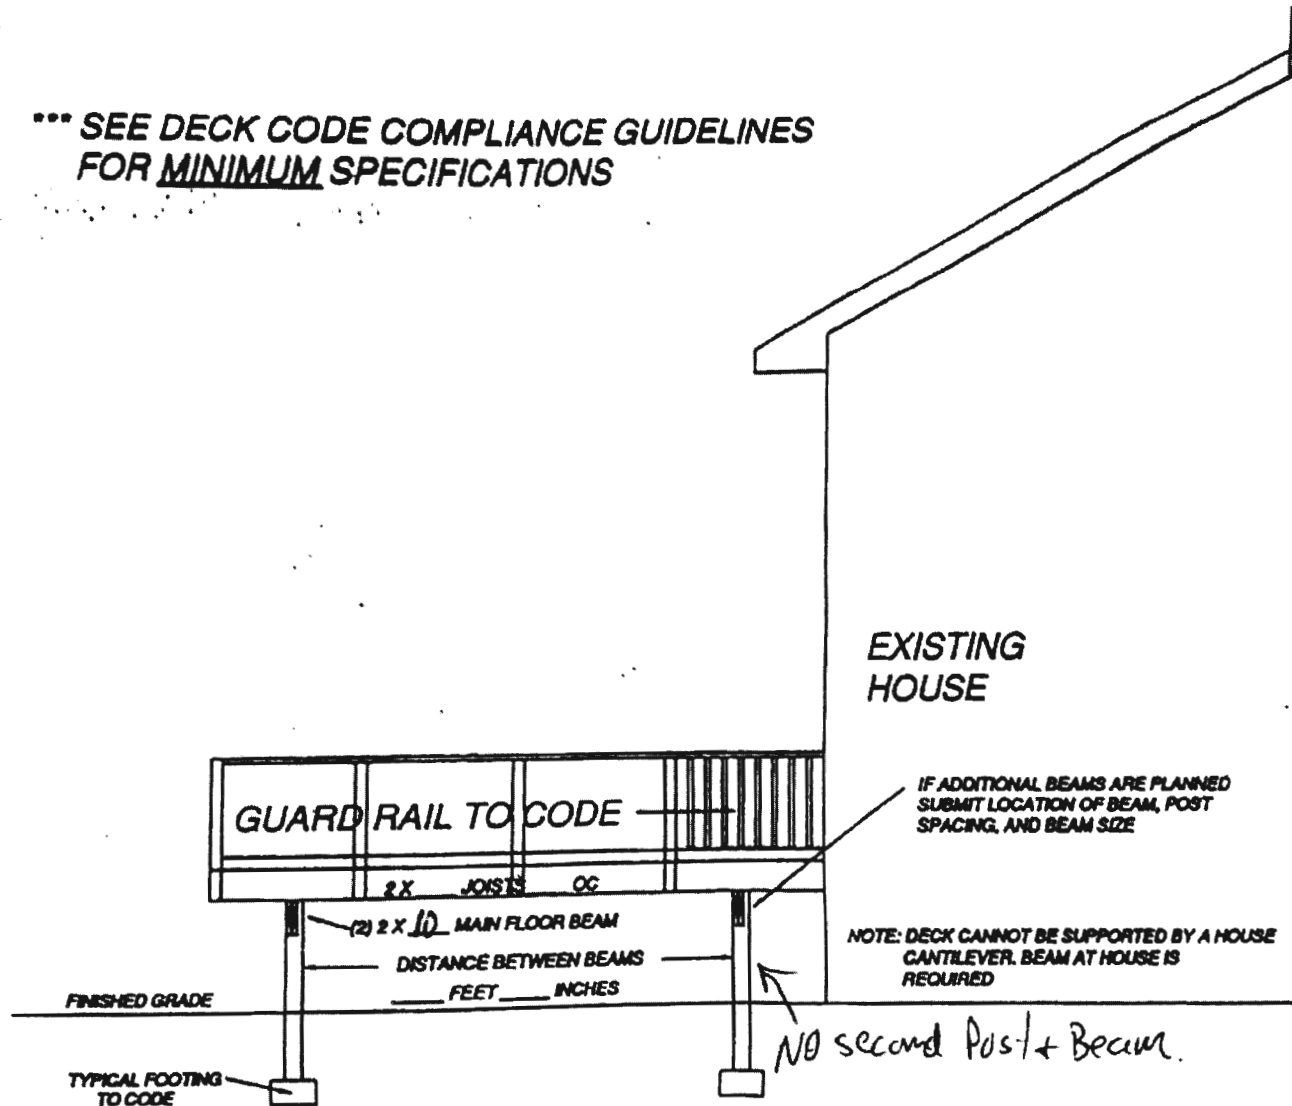


DECK CROSS SECTION

2 OF 2

*** SEE DECK CODE COMPLIANCE GUIDELINES FOR MINIMUM SPECIFICATIONS

hercules
selucrah

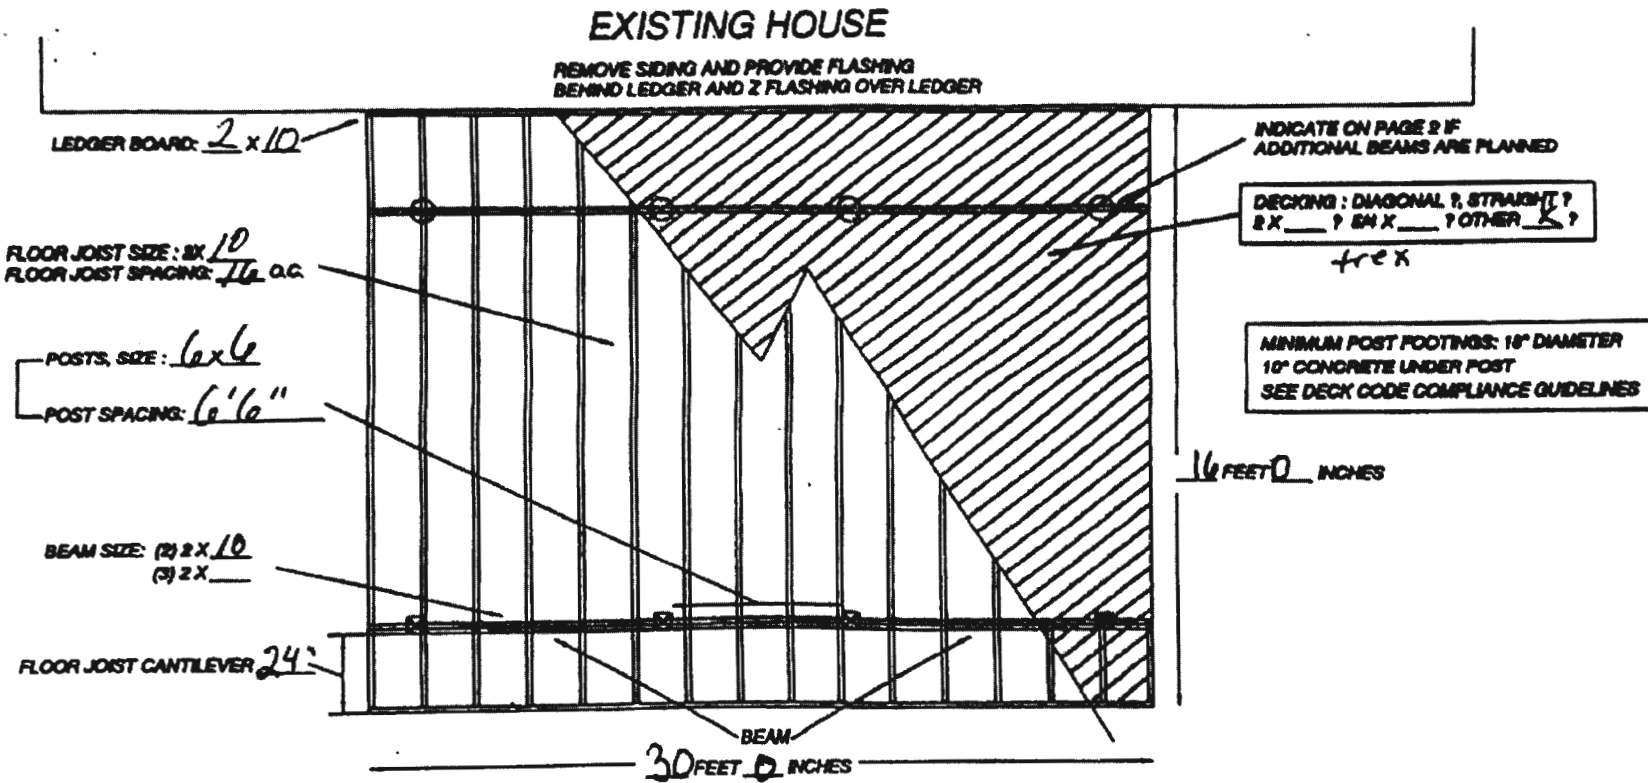


Sample ① DECK FLOOR FRAMING PLAN EXAMPLE

1 OF 2

OPEN DECK

Shea Bennett

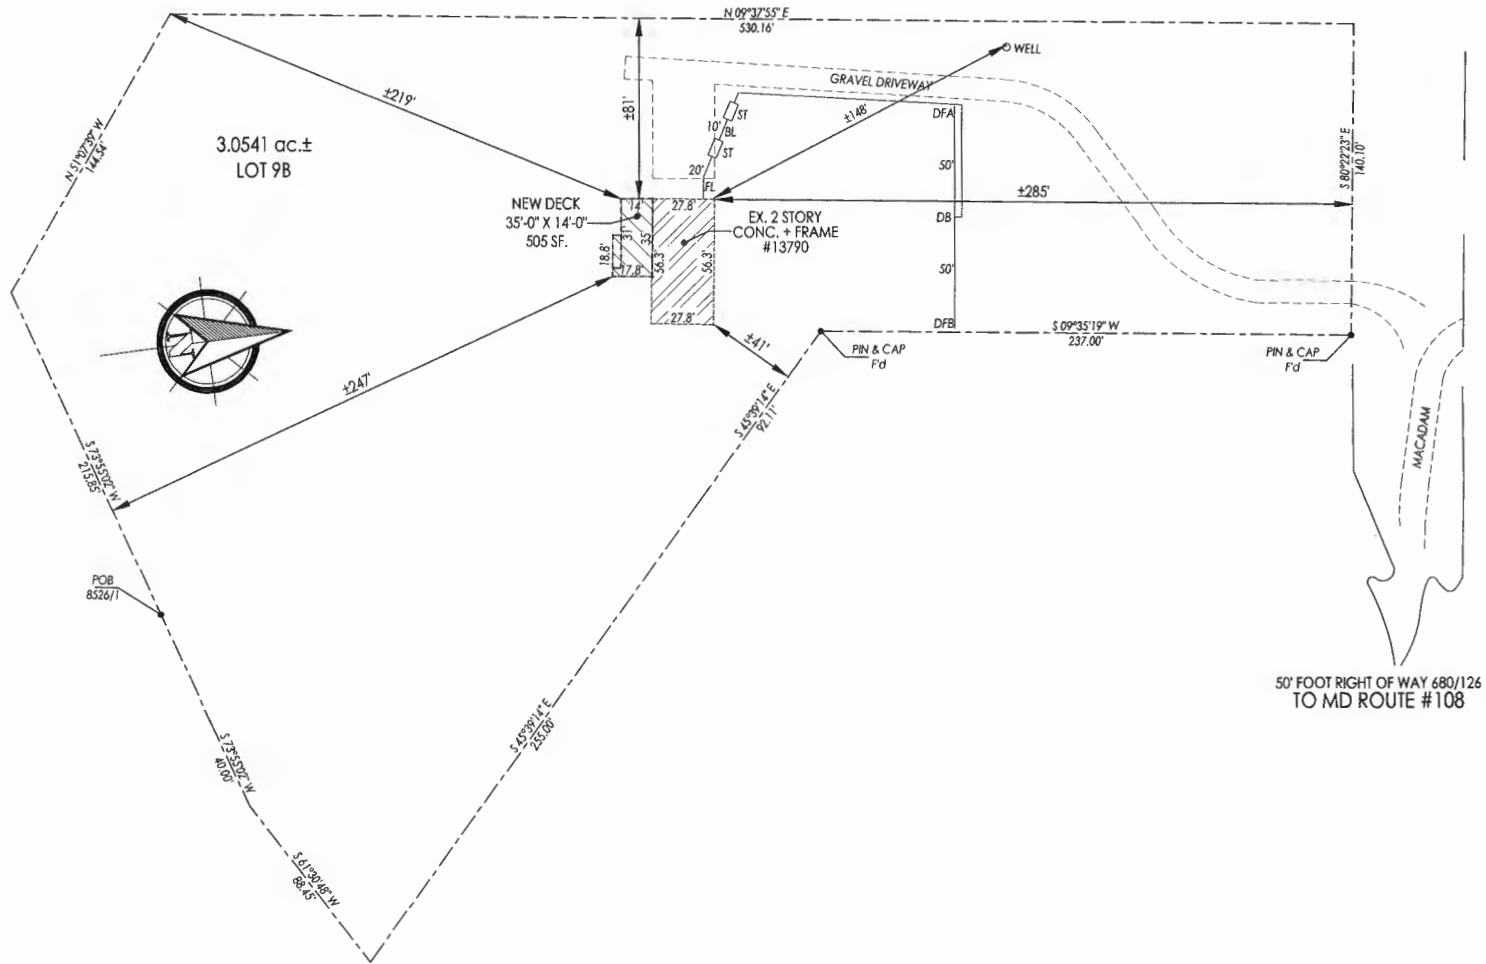

SITE PLAN
ESC.: 1:500

LEGEND

	DIVISION LAND
	BOUNDARIES
	EXISTING BUILDING / DEMO
	PROPOSED BUILDING

ST= SEPTIC TANK; BD=DISTRIBUTION BOX; DF= DRAINFIELD;
 DW= DRYWELL; FL=FRONT LINE; BL= BLACK LINE

GENERAL NOTE
 CONTRACTORS SHALL VERIFY ALL DIMENSION, GRADES, ANY OTHER SITE CONDITIONS WITH THE PROPOSED PLANS. SCHEDULE PRIOR TO COMMENCING WITH THE WORK. ALL DIMENSIONS NOTED ± ARE TO BE ADJUSTED AS REQUIRED PER FIELD CONDITION.

DRAWINGS PROVIDED BY:
Vican
 Design & Construction, LLC
 107 Stonehedge Dr. Gaithersburg, MD 20878
 www.vicanpa.com
 (301) 854-8999

NO.	DESCRIPTION	BY	DATE
A.	DESIGN PERMIT SET		03/31/2022

SHEET TITLE:
SITE PLAN

PROJECT DESCRIPTION:
 13790 CLARKSVILLE PIKE,
 HIGHLAND, MD 20777

DATE:	03/31/2022
SCALE:	1:500
SHEET:	CS-002