

DEPT. OF INSPECTIONS, LICENSES AND PERMITS 3430 COURT HOUSE DRIVE ELLICOTT CITY, MD 21043 PERMITS (410) 313-2455 INSPECTIONS (410) 313-1810 AUTOMATED INFORMATION (410) 313-3800		HOWARD COUNTY PERMIT APPLICATION		PERMIT NUMBER <u>B10002524</u>																									
Building Address <u>11151 WILLOW GREEN WAY</u> <u>MARRIOTTSVILLE MD 21104</u>			Property Owner's Name <u>IQBAL & SHEEBA DAR</u> Address <u>11151 WILLOW GREEN WAY</u> City <u>MARRIOTTSVILLE</u> State <u>MD</u> Zip Code <u>21104</u> Home Phone <u>410 926-6952</u> Work Phone _____ Applicant's Name & Mailing Address, (if other than stated herein): _____ _____ _____ _____ _____ _____ _____ Phone _____ Fax _____																										
Suite/Apt. #: _____ SDP/WP/Petition #: _____																													
Census Tract _____ Subdivision <u>WOODFORDS GRANT III</u>																													
Section _____ Area _____ Lot <u>14</u>																													
Tax Map <u>10</u> Parcel <u>326</u> Grid <u>16</u>																													
Zoning _____ Map Coordinates _____ Lot Size <u>43,420</u>																													
Existing Use <u>SFD</u> Proposed Use <u>SFD & ADDITION</u> Estimated Construction Cost \$ <u>25,000</u>			Contractor Company <u>PATIO ENCLOSURES, INC.</u> Contact Person <u>224 8th AVENUE, N.W.</u> Address <u>GLEN BURNIE, MD 21061</u> City _____ State <u>443-797-0351</u> Zip Code _____ License No. <u>MHI # 12744</u> Phone _____ Fax _____																										
Description of Work <u>14'x14' SUNROOM W/LANDSCAPING & STEPS TO GRADE.</u>			Engineer or Architect Company _____ Contact Person _____ Address _____ City _____ State _____ Zip Code _____ Phone _____ Fax _____																										
Occupant or Tenant <u>OWNER</u>																													
Contact Name _____																													
Address _____																													
City _____ State _____ Zip Code _____																													
Phone _____ Fax _____																													
BUILDING DESCRIPTION - COMMERCIAL			BUILDING DESCRIPTION - RESIDENTIAL																										
<table><tr><td>Building Characteristics</td><td>Utilities</td></tr><tr><td>Height: _____</td><td>Water Supply: _____ Public _____ Private _____</td></tr><tr><td>No. of stories: _____</td><td>Sewage Disposal: _____ Public _____ Private _____</td></tr><tr><td>Gross area, sq. ft. per floor: _____</td><td>Electric Yes <input type="checkbox"/> No <input type="checkbox"/> Gas Yes <input type="checkbox"/> No <input type="checkbox"/></td></tr><tr><td>Use group: _____</td><td>Heating System: _____ Electric <input type="checkbox"/> Oil <input type="checkbox"/> Natural Gas <input type="checkbox"/> Propane Gas <input type="checkbox"/></td></tr><tr><td>Construction type: _____ Reinforced Concrete _____ Structural Steel _____ Masonry _____ Wood Frame _____ State Certified Modular _____</td><td>Sprinkler system: N/A <input type="checkbox"/> Full _____ Partial _____ Other Suppression _____ # of Heads _____</td></tr></table>			Building Characteristics	Utilities	Height: _____	Water Supply: _____ Public _____ Private _____	No. of stories: _____	Sewage Disposal: _____ Public _____ Private _____	Gross area, sq. ft. per floor: _____	Electric Yes <input type="checkbox"/> No <input type="checkbox"/> Gas Yes <input type="checkbox"/> No <input type="checkbox"/>	Use group: _____	Heating System: _____ Electric <input type="checkbox"/> Oil <input type="checkbox"/> Natural Gas <input type="checkbox"/> Propane Gas <input type="checkbox"/>	Construction type: _____ Reinforced Concrete _____ Structural Steel _____ Masonry _____ Wood Frame _____ State Certified Modular _____	Sprinkler system: N/A <input type="checkbox"/> Full _____ Partial _____ Other Suppression _____ # of Heads _____	<table><tr><td>Building Characteristics</td><td>Utilities</td></tr><tr><td>SF Dwelling <input checked="" type="checkbox"/> SF Townhouse <input type="checkbox"/> Depth _____ Width _____ 1st floor: <u>14'x14' = 196 #</u> 2nd floor: _____ Basement: _____</td><td>Water Supply: _____ Public <input checked="" type="checkbox"/> Private _____</td></tr><tr><td>Finished Basement <input type="checkbox"/> Unfinished Basement <input type="checkbox"/> Crawl space <input type="checkbox"/> Slab on Grade <input type="checkbox"/> No. of Bedrooms _____</td><td>Sewage Disposal: _____ Public <input checked="" type="checkbox"/> Private _____</td></tr><tr><td>Multi-family dwellings: _____ No. of efficiency units: _____ No. of 1 BR units: _____ No. of 2 BR units: _____ No. of 3 BR units: _____</td><td>Electric Yes <input checked="" type="checkbox"/> No <input type="checkbox"/> Gas Yes <input type="checkbox"/> No <input checked="" type="checkbox"/></td></tr><tr><td>Other Structure: _____ Dimensions: _____ Footings: _____ Roof: <u>GABLE</u></td><td>Heating System: <u>N/A</u> Electric <input type="checkbox"/> Oil <input type="checkbox"/> Natural Gas <input type="checkbox"/> Propane Gas <input type="checkbox"/></td></tr><tr><td>State Certified Modular _____ Manufactured Home <u>196 #</u></td><td>Sprinkler system: N/A <input type="checkbox"/> NFPA #13D _____ NFPA #13R _____ Other: _____</td></tr></table>			Building Characteristics	Utilities	SF Dwelling <input checked="" type="checkbox"/> SF Townhouse <input type="checkbox"/> Depth _____ Width _____ 1 st floor: <u>14'x14' = 196 #</u> 2 nd floor: _____ Basement: _____	Water Supply: _____ Public <input checked="" type="checkbox"/> Private _____	Finished Basement <input type="checkbox"/> Unfinished Basement <input type="checkbox"/> Crawl space <input type="checkbox"/> Slab on Grade <input type="checkbox"/> No. of Bedrooms _____	Sewage Disposal: _____ Public <input checked="" type="checkbox"/> Private _____	Multi-family dwellings: _____ No. of efficiency units: _____ No. of 1 BR units: _____ No. of 2 BR units: _____ No. of 3 BR units: _____	Electric Yes <input checked="" type="checkbox"/> No <input type="checkbox"/> Gas Yes <input type="checkbox"/> No <input checked="" type="checkbox"/>	Other Structure: _____ Dimensions: _____ Footings: _____ Roof: <u>GABLE</u>	Heating System: <u>N/A</u> Electric <input type="checkbox"/> Oil <input type="checkbox"/> Natural Gas <input type="checkbox"/> Propane Gas <input type="checkbox"/>	State Certified Modular _____ Manufactured Home <u>196 #</u>	Sprinkler system: N/A <input type="checkbox"/> NFPA #13D _____ NFPA #13R _____ Other: _____
Building Characteristics	Utilities																												
Height: _____	Water Supply: _____ Public _____ Private _____																												
No. of stories: _____	Sewage Disposal: _____ Public _____ Private _____																												
Gross area, sq. ft. per floor: _____	Electric Yes <input type="checkbox"/> No <input type="checkbox"/> Gas Yes <input type="checkbox"/> No <input type="checkbox"/>																												
Use group: _____	Heating System: _____ Electric <input type="checkbox"/> Oil <input type="checkbox"/> Natural Gas <input type="checkbox"/> Propane Gas <input type="checkbox"/>																												
Construction type: _____ Reinforced Concrete _____ Structural Steel _____ Masonry _____ Wood Frame _____ State Certified Modular _____	Sprinkler system: N/A <input type="checkbox"/> Full _____ Partial _____ Other Suppression _____ # of Heads _____																												
Building Characteristics	Utilities																												
SF Dwelling <input checked="" type="checkbox"/> SF Townhouse <input type="checkbox"/> Depth _____ Width _____ 1 st floor: <u>14'x14' = 196 #</u> 2 nd floor: _____ Basement: _____	Water Supply: _____ Public <input checked="" type="checkbox"/> Private _____																												
Finished Basement <input type="checkbox"/> Unfinished Basement <input type="checkbox"/> Crawl space <input type="checkbox"/> Slab on Grade <input type="checkbox"/> No. of Bedrooms _____	Sewage Disposal: _____ Public <input checked="" type="checkbox"/> Private _____																												
Multi-family dwellings: _____ No. of efficiency units: _____ No. of 1 BR units: _____ No. of 2 BR units: _____ No. of 3 BR units: _____	Electric Yes <input checked="" type="checkbox"/> No <input type="checkbox"/> Gas Yes <input type="checkbox"/> No <input checked="" type="checkbox"/>																												
Other Structure: _____ Dimensions: _____ Footings: _____ Roof: <u>GABLE</u>	Heating System: <u>N/A</u> Electric <input type="checkbox"/> Oil <input type="checkbox"/> Natural Gas <input type="checkbox"/> Propane Gas <input type="checkbox"/>																												
State Certified Modular _____ Manufactured Home <u>196 #</u>	Sprinkler system: N/A <input type="checkbox"/> NFPA #13D _____ NFPA #13R _____ Other: _____																												

THE UNDERSIGNED HEREBY CERTIFIES AND AGREES AS FOLLOWS: (1) THAT HE/SHE IS AUTHORIZED TO MAKE THIS APPLICATION; (2) THAT THE INFORMATION IS CORRECT; (3) THAT HE/SHE WILL COMPLY WITH ALL REGULATIONS OF HOWARD COUNTY WHICH ARE APPLICABLE THERETO; (4) THAT HE/SHE WILL PERFORM NO WORK ON THE ABOVE REFERENCED PROPERTY NOT SPECIFICALLY DESCRIBED IN THIS APPLICATION; (5) THAT HE/SHE GRANTS COUNTY OFFICIALS THE RIGHT TO ENTER ONTO THIS PROPERTY FOR THE PURPOSE OF INSPECTING THE WORK PERMITTED AND POSTING NOTICES.

Gregory A. Falter (agent)
Applicant's Signature
Title/Company _____

GREGORY A. FALTER.
Print Name
8-12-2010
Date

Checks payable to: DIRECTOR OF FINANCE OF HOWARD COUNTY **PLEASE WRITE NEATLY AND LEGIBLY.** - FOR OFFICE USE ONLY -				
AGENCY <u>Land Development, DPZ</u>	DATE <u>8/12/2010</u>	SIGNATURE APPROVAL <u>R. Buckner</u>	DPZ SETBACK INFORMATION Front: _____ Rear: _____ Side: _____ Side St.: _____ All minimum setbacks met? YES <input type="checkbox"/> NO <input type="checkbox"/>	PROPERTY ID # Filing fee \$ _____ Permit fee \$ _____ Excise tax \$ _____ Add'l per fee \$ _____ TOTAL FEES \$ _____ Sub-total paid \$ _____ Balance due \$ _____ Check # _____ Validation # _____
State Highways			Is Entrance Permit Required? YES <input type="checkbox"/> NO <input type="checkbox"/>	
Building Officials			Historic District? YES <input type="checkbox"/> NO <input type="checkbox"/>	
Dev. Engineering, DPZ			Lot Coverage for New Town Zone _____	
Health			SDP/Red-line approval date _____	Accepted by _____
Fire Protection				
Is Sediment Control approval required prior to issuance? YES <input type="checkbox"/> NO <input type="checkbox"/>				
CONTINGENCY CONSTRUCTION START: <input type="checkbox"/> ONE STOP SHOP: <input type="checkbox"/>				
Distribution of Copies - White: Building Officials Green: LDD, DPZ Yellow: DED, DPZ Pink: Health Gold: SHA T:\Operations\Updated forms				


11151 WILLOW GREEN WAY
MARRIOTSVILLE MD 21104

map 10
GRID 16
Lot 14

"WOODFORDS GRANT III"

LAND AREA 43,420^{SF}

SCALE 1:60

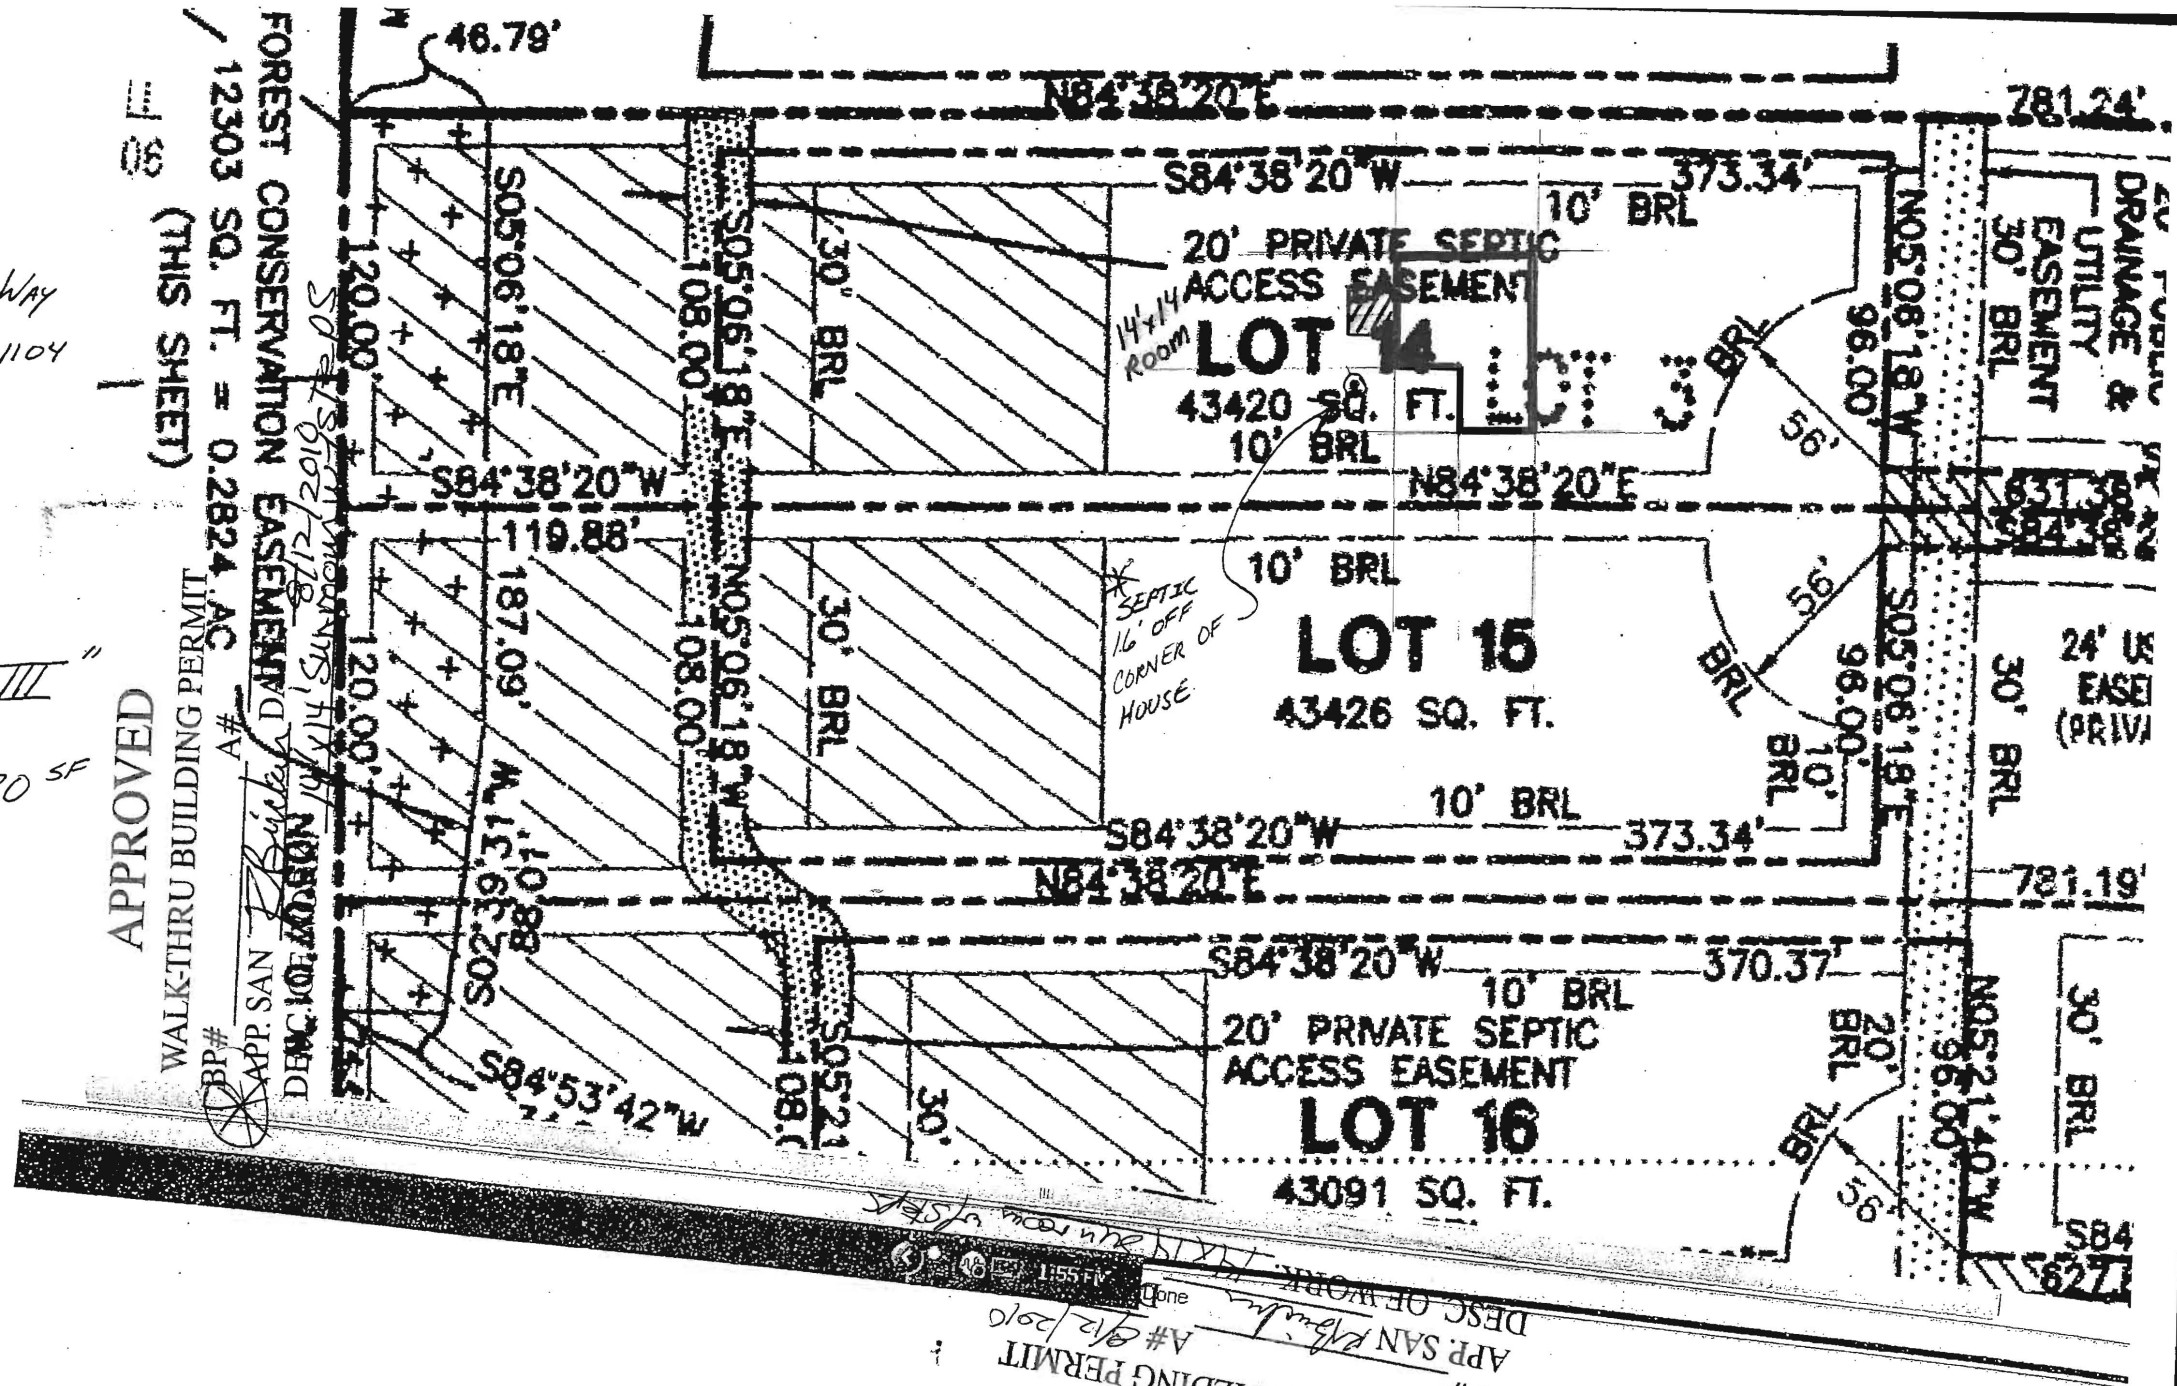

APPROVED

APPROVED
WALK-THRU BUILDING PERMIT
BP#
APP. SAN 212, 17
A# 212, 17

APPROXIMATE DATE OF WORK: 9/12/2010

01/02/2010