

DEPARTMENT OF INSPECTIONS, LICENSES AND PERMITS 3430 COURT HOUSE DRIVE ELICOTT CITY, MD 21043 PERMITS (410) 313-2455 INSPECTIONS (410) 313-1810 AUTOMATED INFORMATION (410) 313-3800		HOWARD COUNTY PERMIT APPLICATION		PERMIT NUMBER 300158085	
Building Address 1709 Willow Springs Dr. Sykesville, Md 21784			Property Owner's Name Mignon McAleer		
Suite/Apt. #: _____ SDP/WP/Petition #: _____			Address 1709 Willow Springs Drive		
Census Tract _____ Subdivision _____			City Sykesville State MD Zip Code 21784		
Section _____ Area _____ Lot 2			Home Phone 4104892295 Work Phone _____		
Tax Map _____ Parcel _____ Grid _____			Applicant's Name & Mailing Address, (if other than stated hereon): _____		
Zoning _____ Map Coordinates _____ Lot size 3 Acres			Phone _____ Fax _____		
Existing Use STOOP + SIDEWALK			Contractor Company Renovation & Remodeling		
Proposed Use STOOP PORCH SIDEWALK			Contact Person Jim Busick		
Estimated Construction Cost \$420,000			Address 1108 Hoods Mill Rd		
Description of Work Remove existing concrete stoop + walk + BUILD NEW WITH ROOF + BEICH SIDEWALKS 10' X 22'			City Wardline State MD Zip Code 21797		
Occupant or Tenant Mignon McAleer			License No. 120810		
Contact Name Mignon McAleer			Phone 4105497703 Fax 4105490924		
Address 1709 Willow Springs Dr			Engineer or Architect Company _____		
City Sykesville State MD Zip Code 21784			Contact Person _____		
Phone 4104892295 Fax _____			Address _____		
			City _____ State _____ Zip Code _____		
			Phone _____ Fax _____		

BUILDING DESCRIPTION - COMMERCIAL		BUILDING DESCRIPTION - RESIDENTIAL	
Building Characteristics	Utilities	Building Characteristics	Utilities
Height: 8'	Water Supply: ☐ Public ☒ Private	SF Dwelling ☒ SF Townhouse ☐ Depth Width	Water Supply: ☐ Public ☒ Private
No. of stories: 1	Sewage Disposal: ☐ Public ☒ Private	1st floor: _____	Sewage Disposal: ☐ Public ☒ Private
Gross area, sq. ft. per floor: 200	Electric Yes ☐ No ☐ Gas Yes ☐ No ☐	2nd floor: _____	Electric Yes ☒ No ☐ Gas Yes ☐ No ☐
Use group: _____	Heating System: ☐ Electric ☐ Oil ☐ ☐ Natural Gas ☐ Propane Gas ☐	Basement: _____	Heating System: ☐ Electric ☐ Oil ☐ ☐ Natural Gas ☐ Propane Gas ☐
Construction type: ☐ Reinforced Concrete ☒ Structural Steel ☐ Masonry ☐ Wood Frame	Sprinkler system: ☐ Full ☐ Partial ☐ Other Suppression ☐ # of Heads _____	Finished Basement ☐ Unfinished Basement ☐ Crawl space ☐ Slab on Grade ☐ No. of Bedrooms _____ Height: _____ Multi-family dwellings: No. of efficiency units: _____ No. of 1 BR units: _____ No. of 2 BR units: _____ No. of 3 BR units: _____	Other Structure: _____ Dimensions: 22x10 Footings: 10x8x16 Roof Height: 10' ☐ State Certified Modular ☐ Manufactured Home
☐ State Certified Modular			Sprinkler system: ☐ N/A ☐ ☐ NFPA #13D ☐ NFPA #13R ☐ Other: _____


THE UNDERSIGNED HEREBY CERTIFIES AND AGREES AS FOLLOWS: (1) THAT HE/SHE IS AUTHORIZED TO MAKE THIS APPLICATION; (2) THAT THE INFORMATION IS CORRECT; (3) THAT HE/SHE WILL COMPLY WITH ALL REGULATIONS OF HOWARD COUNTY WHICH ARE APPLICABLE THERETO; (4) THAT HE/SHE WILL PERFORM NO WORK ON THE ABOVE REFERENCED PROPERTY NOT SPECIFICALLY DESCRIBED IN THIS APPLICATION; (5) THAT HE/SHE GRANTS COUNTY OFFICIALS THE RIGHT TO ENTER ONTO THIS PROPERTY FOR THE PURPOSE OF INSPECTING THE WORK PERMITTED AND POSTING NOTICES.

Applicant's Signature <i>Jim Busick</i>	Print Name Jim Busick
Title/Company Renovation + Remodeling, Inc	Date 02/08/06

Checks payable to: **DIRECTOR OF FINANCE OF HOWARD COUNTY**
** PLEASE WRITE NEATLY AND LEGIBLY. **
- FOR OFFICE USE ONLY -

AGENCY	DATE	SIGNATURE APPROVAL	DPZ SETBACK INFORMATION	PROPERTY ID#
Land Development, DPZ			Front: _____	Filing fee \$ _____
State Highways			Rear: _____	Permit fee \$ _____
Building Official			Side: _____	Excise tax \$ _____
Dev. Engineering, DPZ	2/8/06	<i>John Doe</i>	Side St.: _____	Add'l per. fee \$ _____
Health			All minimum setbacks met?	TOTAL FEES \$ _____
Fire Protection			YES ☐ NO ☐	Sub-total paid \$ _____
Is Sediment Control approval required prior to issuance?			Is Entrance Permit required?	Balance due \$ _____
YES ☐ NO ☐			YES ☐ NO ☐	Check # _____
CONTINGENCY CONSTRUCTION START: ☐			Historic District?	Validation # _____
ONE STOP SHOP: ☐			YES ☐ NO ☐	
Distribution of Copies: _____	White: Building Official	Green: LDD, DPZ	Lot Coverage for NewTown Zone _____	Accepted by _____
T:\forms\PERMIT.FRM			SDP/Red-line approval date _____	
			Yellow: DED, DPZ	Pink: Health
				Gold: SHA

ELECTION (3rd.) DISTRICT
HOWARD COUNTY, MARYLAND

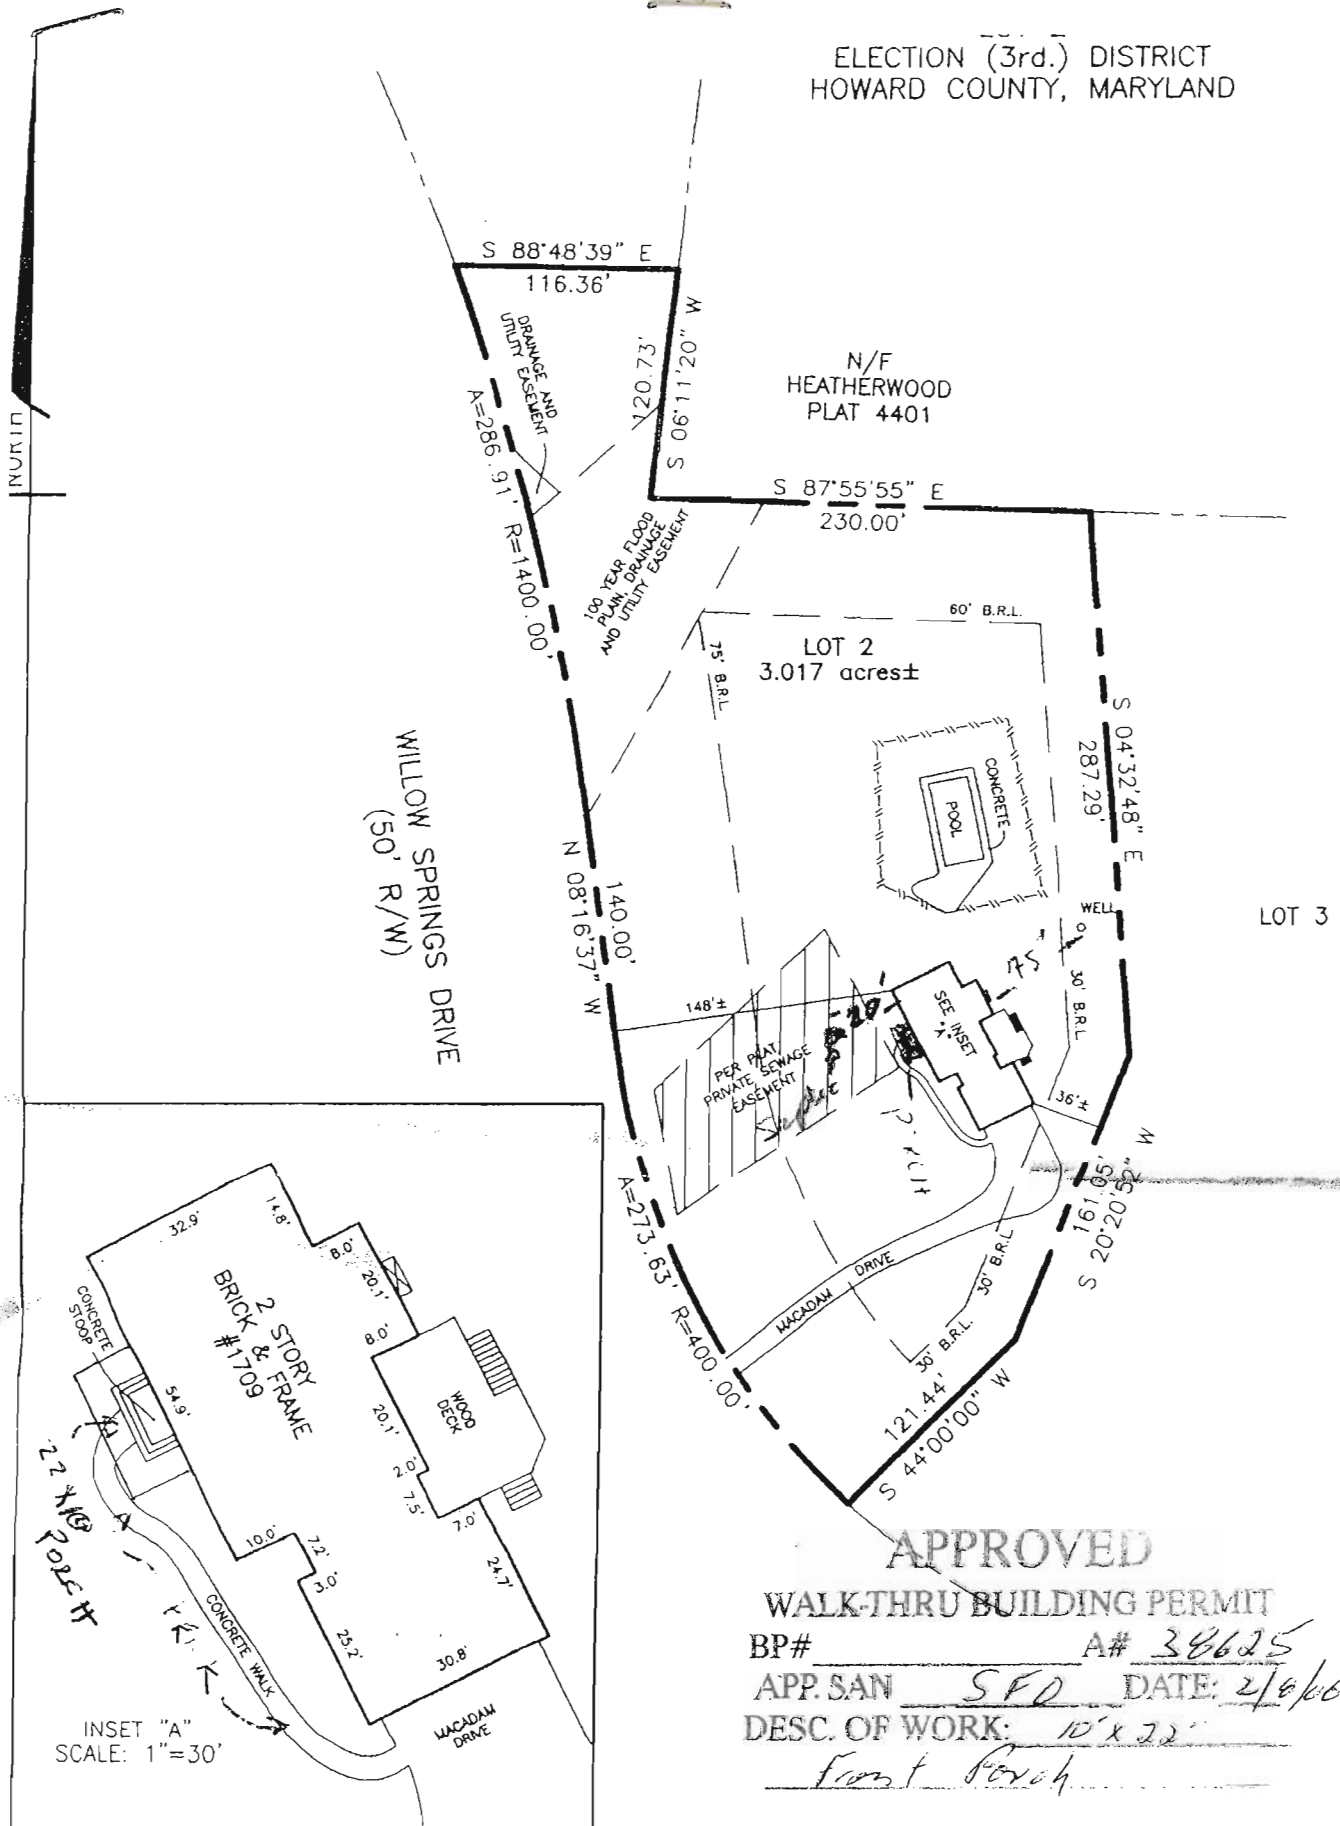

APPROVED
WALK-THRU BUILDING PERMIT
BP# _____ A# 38625
APP. SAN SFD DATE: 2/6/06
DESC. OF WORK: 10' x 72'
Front Porch

PROPERTY ADDRESS: 1709 WILLOW SPRINGS DRIVE

THE PROPERTY SHOWN HEREON IS LOCATED IN ZONE C (AREA OF MINIMAL FLOODING) ACCORDING TO NATIONAL FLOOD INSURANCE PROGRAM F.I.R.M. MAP COMMUNITY PANEL NO. 240044 0009 B AS REVISED 04/02/97

CERTIFICATE
I HEREBY DECLARE THAT THE POSITION OF ALL THE VISIBLE EXISTING IMPROVEMENTS SHOWN ON THE ABOVE DESCRIBED PROPERTY HAVE BEEN ESTABLISHED BY PROPER FIELD METHODS. NO TITLE RECORD HAS BEEN CHECKED. SUBJECT TO ANY AND ALL

REFERENCES
PLAT BK.
PLAT NO. CMP 7918

**ALL COUNTY
LOCATION SURVEYS, INC**
2813 PATUXENT RIVER ROAD, DAVIDSONVILLE, MD. 21035

NO REPRODUCTION WITHOUT EXPRESSED WRITTEN PERMISSION BY ACLS, INC.