



SETBACKS:
 REAR PL. 10'
 SIDE PL. 10'
 HOUSE 0'
 SEPTIC 10'/20'
 WELL 20'

PRIVATE WELL & SEPTIC

CONTACT:
 JON COAKLEY
 (443) 604-4029
 JONCOAKLEY55@GMAIL.COM

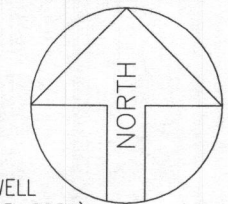

NOTES

1. ALL EXISTING WELLS ON THE SUBJECT PROPERTY AND WITHIN 100 FEET OF SUBJECT PROPERTY BOUNDARIES ARE REPRESENTED TO THE BEST OF MY KNOWLEDGE AND BELIEF.
 2. THE EXISTING WELL ON THE SUBJECT PROPERTY (HO-95-2083) HAS BEEN FIELD LOCATED AND IS ACCURATELY SHOWN.
 3. TOPOGRAPHY ON THIS PLAN IS FROM HOWARD COUNTY AND IS VERIFIED TO ACCURATELY REPRESENT THE RELATIVE ELEVATION CHANGES ON AND NEAR THE SUBJECT PROPERTY.
 4. THE LOT SHOWN HEREON COMPLIES WITH THE MINIMUM OWNERSHIP WIDTH AND LOT AREA AS REQUIRED BY THE MARYLAND DEPARTMENT OF ENVIRONMENT.
 5. ANY CHANGES TO A PRIVATE SEWAGE EASEMENT SHALL REQUIRE A REVISED PERCOLATION CERTIFICATION PLAN.
- 
6. THIS AREA DESIGNATES A PRIVATE SEWAGE EASEMENT OF AT LEAST 10,000 SQ. FT. AS REQUIRED BY THE MARYLAND DEPARTMENT OF ENVIRONMENT FOR INDIVIDUAL SEWAGE DISPOSAL IMPROVEMENTS OF ANY NATURE IN THIS EASEMENT ARE RESTRICTED. THIS EASEMENT SHALL BECOME NULL AND VOID UPON CONNECTION TO A PUBLIC SEWERAGE SYSTEM. THE COUNTY HEALTH OFFICER SHALL HAVE AUTHORITY TO GRANT ADJUSTMENTS TO THE PRIVATE SEWAGE EASEMENT. RECORDATION OF A REVISED SEWAGE EASEMENT SHALL NOT BE NECESSARY.
 7. THE PURPOSE FOR THIS PERCOLATION CERTIFICATION PLAN IS TO ADJUST THE EXISTING SEWAGE DISPOSAL EASEMENT TO ACCOMMODATE CONSTRUCTION OF AN INGROUND POOL.
 8. ENTIRE PROPERTY IN SOIL MAP UNIT CgB

I CERTIFY THAT THE INFORMATION SHOWN HEREON IS BASED ON WORK PERFORMED IN MY PRESENCE OR BY MY DIRECTION, AND IS CORRECT TO THE BEST OF MY KNOWLEDGE AND BELIEF.




Stephen M. Casey (SIGNATURE) 5-1-2015 (DATE)


APPROVED FOR PRIVATE WATER AND PRIVATE SEWERAGE SYSTEMS
 HOWARD COUNTY HEALTH DEPARTMENT

Mauro Rossman (SIGNATURE) 5/19/2015 (DATE)

TITLE: PERCOLATION CERTIFICATION PLAN, "14939 VICTORY LANE"
 OWNER: STEPHEN M. CASEY

LEGEND

-  PERC TEST PASS 926
-  PERC TEST PASS 927
-  PERC TEST PASS 928

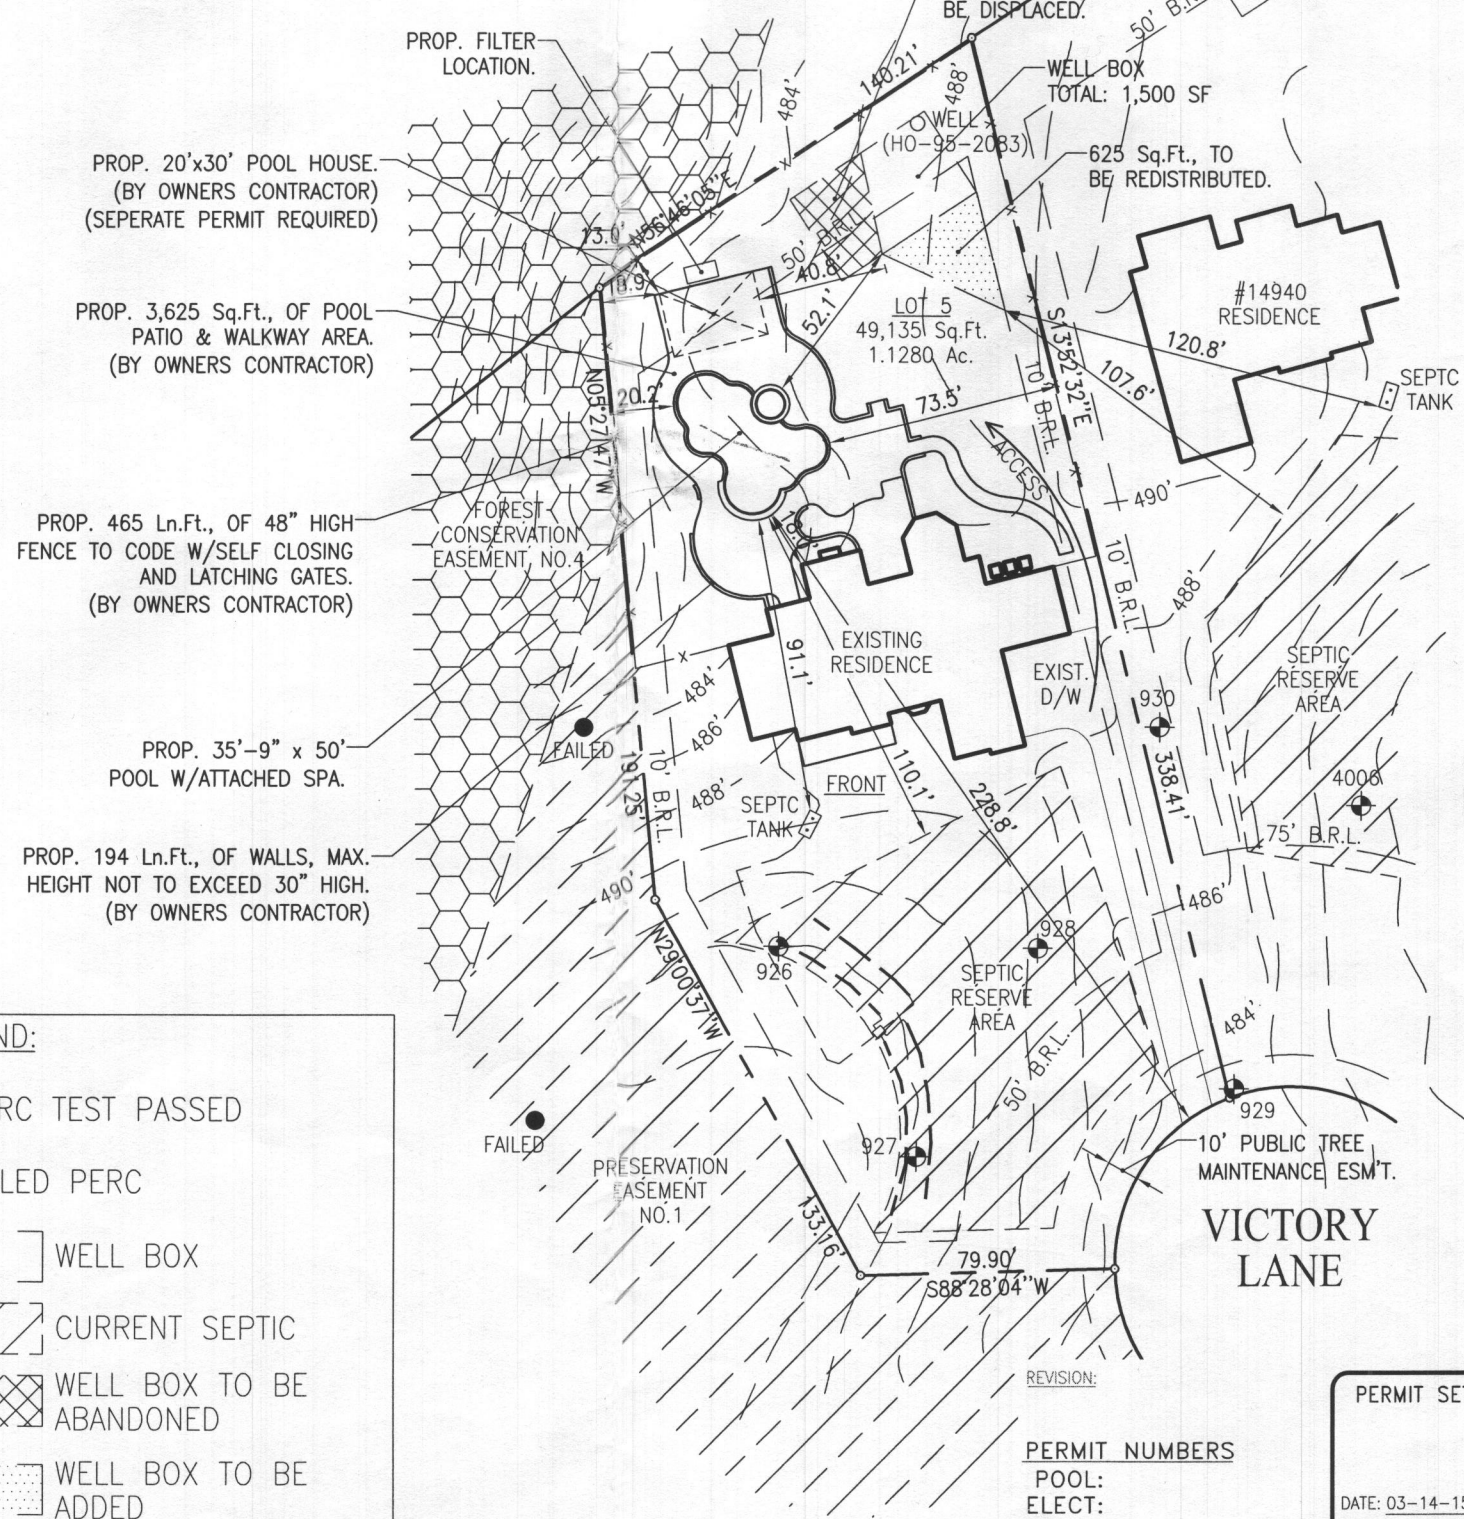

POOL STATISTICS	
SIZE/SHAPE: 35'-9" x 50' - CUSTOM	
POOL AREA: 1,075	SPA: 64 OTHER:
TOTAL AREA: 1,139	
PERIMETER: 148	SPA: 29
GALLONAGE: 47,360	DEPTH: 3'-0" TO 8'-6"

DIRECTIONS TO SITE	
MAP #	00
GRID	X0

Stephen M. Casey
 14939 Victory Lane
 Glenelg, Maryland 21737
 Howard County

HOME PHONE:
 OFFICE PHONE 1:
 CELL PHONE 1:
 CELL PHONE 2:







LOT: 5	SUBDIVISION NAME: MERIWETHER FARM	DISTRICT: 04	PIN #: 593614
SITE PLAN			ZONE: ONE
SCALE: 1"=60'	BY: *	DATE: 03/14/15	JOB NUMBER: JC15
			SHEET #: 1.0

SITE PLAN

 1"=60'
 LOT # 5

MERIWETHER FARM
 TAX ACCOUNT # 593614
 MAP 0021, GRID 0016, PARCEL 0028
 ELECTION DISTRICT: 04
 HOWARD COUNTY, MARYLAND

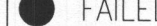LEGEND:


-  PERC TEST PASSED
-  FAILED PERC
-  WELL BOX
-  CURRENT SEPTIC
-  WELL BOX TO BE ABANDONED
-  WELL BOX TO BE ADDED

PERMIT SET
 DATE: 03-14-15

PERMIT NUMBERS
 POOL:
 ELECT:
 OTHER:

SETBACKS:
 REAR, PL. 10'
 SIDE PL. 10'
 HOUSE 0'
 SEPTIC 10'/20'
 WELL 20'

PRIVATE WELL & SEPTIC

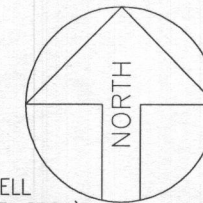

CONTACT:
 JON COAKLEY
 (443) 604-4029
 JONCOAKLEY55@GMAIL.COM

NOTES

- ALL EXISTING WELLS ON THE SUBJECT PROPERTY AND WITHIN 100 FEET OF SUBJECT PROPERTY BOUNDARIES ARE REPRESENTED TO THE BEST OF MY KNOWLEDGE AND BELIEF.
- THE EXISTING WELL ON THE SUBJECT PROPERTY (HO-95-2083) HAS BEEN FIELD LOCATED AND IS ACCURATELY SHOWN.
- TOPOGRAPHY ON THIS PLAN IS FROM HOWARD COUNTY AND IS VERIFIED TO ACCURATELY REPRESENT THE RELATIVE ELEVATION CHANGES ON AND NEAR THE SUBJECT PROPERTY.
- THE LOT SHOWN HEREON COMPLIES WITH THE MINIMUM OWNERSHIP WIDTH AND LOT AREA AS REQUIRED BY THE MARYLAND DEPARTMENT OF ENVIRONMENT.
- ANY CHANGES TO A PRIVATE SEWAGE EASEMENT SHALL REQUIRE A REVISED PERCOLATION CERTIFICATION PLAN.
- THIS AREA DESIGNATES A PRIVATE SEWAGE EASEMENT OF AT LEAST 10,000 SQ. FT. AS REQUIRED BY THE MARYLAND DEPARTMENT OF ENVIRONMENT FOR INDIVIDUAL SEWAGE DISPOSAL. IMPROVEMENTS OF ANY NATURE IN THIS EASEMENT ARE RESTRICTED. THIS EASEMENT SHALL BECOME NULL AND VOID UPON CONNECTION TO A PUBLIC SEWAGE SYSTEM. THE COUNTY HEALTH OFFICER SHALL HAVE AUTHORITY TO GRANT ADJUSTMENTS TO THE PRIVATE SEWAGE EASEMENT. RECORDATION OF A REVISED SEWAGE EASEMENT SHALL NOT BE NECESSARY.
- THE PURPOSE FOR THIS PERCOLATION CERTIFICATION PLAN IS TO ADJUST THE EXISTING SEWAGE DISPOSAL EASEMENT TO ACCOMMODATE CONSTRUCTION OF AN INGROUND POOL.
- ENTIRE PROPERTY IN SOIL MAP UNIT GgB


I CERTIFY THAT THE INFORMATION SHOWN HEREON IS BASED ON WORK PERFORMED IN MY PRESENCE OR BY MY DIRECTION, AND IS CORRECT TO THE BEST OF MY KNOWLEDGE AND BELIEF.

Stephen M. Casey
 (SIGNATURE) 5-1-2015
 (DATE)

APPROVED FOR PRIVATE WATER AND PRIVATE SEWERAGE SYSTEMS
 HOWARD COUNTY HEALTH DEPARTMENT
Maureen Roseman
 (SIGNATURE) 5/19/2015
 (DATE)

TITLE: PERCOLATION CERTIFICATION PLAN, "14939 VICTORY LANE"
 OWNER: STEPHEN M. CASEY

- LEGEND**
- PERC TEST PASS 926
 - PERC TEST PASS 927
 - PERC TEST PASS 928

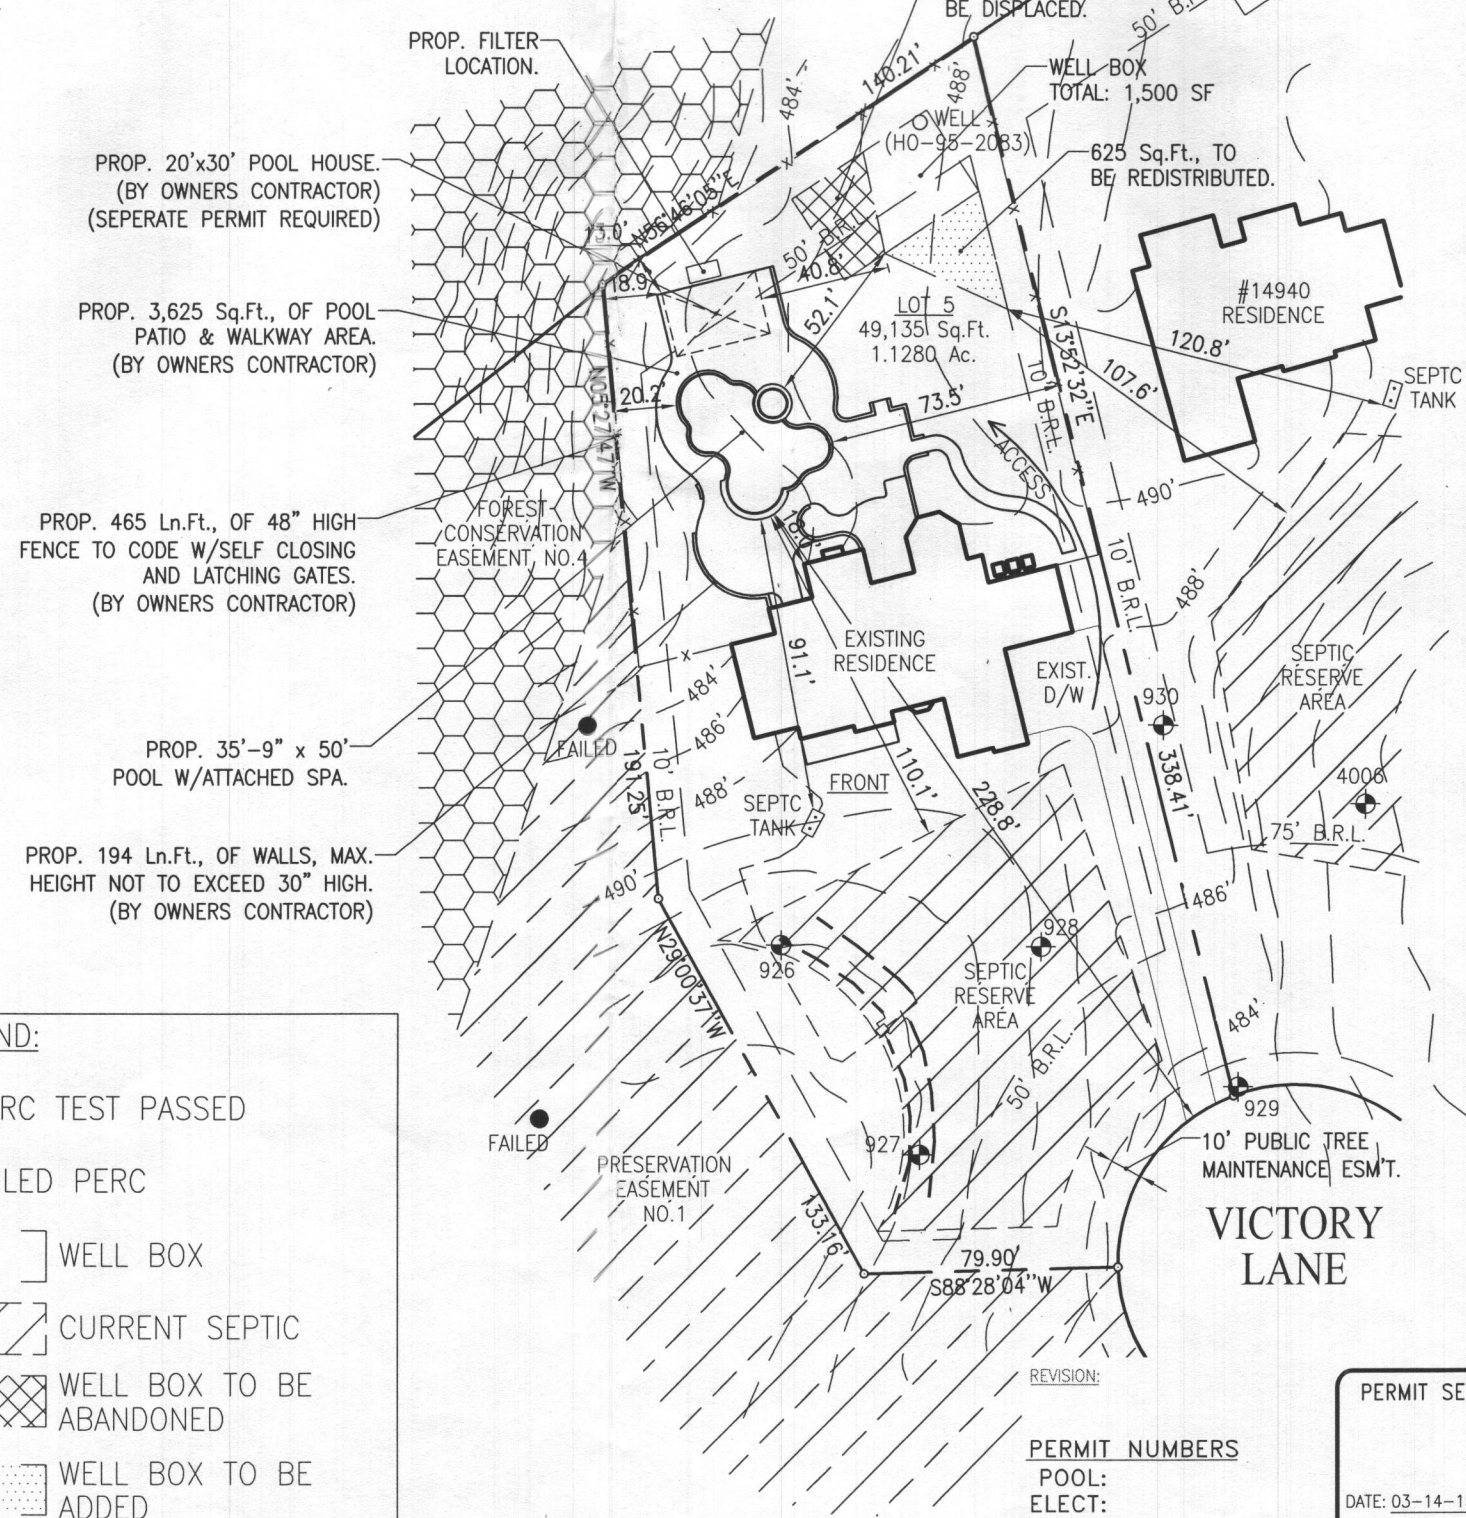

- LEGEND:**
- PERC TEST PASSED
 - FAILED PERC
 - WELL BOX
 - ▨ CURRENT SEPTIC
 - ▩ WELL BOX TO BE ABANDONED
 - ▤ WELL BOX TO BE ADDED

SITE PLAN

1"=60'
 LOT # 5

MERIWETHER FARM
 TAX ACCOUNT # 593614
 MAP 0021, GRID 0016, PARCEL 0028
 ELECTION DISTRICT: 04
 HOWARD COUNTY, MARYLAND

POOL STATISTICS

SIZE/SHAPE: 35'-9" x 50' - CUSTOM	SPA: 64	OTHER:
POOL AREA: 1,075	TOTAL AREA: 1,139	
PERIMETER: 148	SPA: 29	
GALLONAGE: 47,360	DEPTH: 3'-0" TO 8'-6"	

DIRECTIONS TO SITE

MAP #	00
GRID	X0

Stephen M. Casey
 14939 Victory Lane
 Glenelg, Maryland 21737
 Howard County

HOME PHONE:
 OFFICE PHONE 1:
 CELL PHONE 1:
 CELL PHONE 2:

LOT: 5	SUBDIVISION NAME: MERIWETHER FARM	DISTRICT: 04	PIN #: 593614
SITE PLAN			ZONE: ONE
SCALE: 1"=60'	BY: *	DATE: 03/14/15	JOB NUMBER: JC15
DATE: 03-14-15			SHEET #: 1.0

PERMIT SET
 PERMIT NUMBERS
 POOL:
 ELECT:
 OTHER: