

HOWARD COUNTY
PERMIT APPLICATION

PERMIT NUMBER

Building Address 11525 E. WINCHESTER LN
ELLICOTT CITY, MD 21043
Suite/Apt. #: _____ SDP/WP/Petition #: _____
Census Tract _____ Subdivision Kings Bluff
Section _____ Area _____ Lot 32
Tax Map 16 Parcel 349 Grid 8
Zoning _____ Map Coordinates _____ Lot size 5.68 AC

Existing Use _____
Proposed Use _____
Estimated Construction Cost \$ 40,000.00
Description of Work Addition a deck,
Deck size (25'x11'-4" & 20'x19') 9' high
A gazebo, 8 sides, 18' diameter,
A hot top 8' diameter, A water
fountain 20' diameter
Occupant or Tenant an 30' diameter
Contact Name Joseph Nguyen
Address 6255 WILLS ST
City Alexandria State VA Zip Code 22310
Phone 703-622-2245 Fax 703-922-9324

Property Owner's Name CHRISTOPHER LONG
Address 4724 AVATAR LANE
City Owings Mill State MD Zip Code 21117
Home Phone 410-977-6790 Work Phone _____
Applicant's Name & Mailing Address, (if other than stated hereon):
Joseph Nguyen
Phone _____ Fax _____

Contractor Company By owner
Contact Person _____
Address _____
City _____ State _____ Zip Code _____
License No. _____
Phone _____ Fax _____
Engineer or Architect Company N/A
Contact Person Joseph Nguyen
Address 6255 WILLS ST
City ALEXANDRIA State VA Zip Code 22310
Phone 703-922-8815 Fax 703-922-9324

BUILDING DESCRIPTION - COMMERCIAL

Building Characteristics	Utilities
Height: _____	Water Supply: _____ Public _____ Private _____
No. of stories: _____	Sewage Disposal: _____ Public _____ Private _____
Gross area, sq. ft. per floor: _____	Electric Yes ☐ No ☐ Gas Yes ☐ No ☐
Use group: _____	Heating System: _____ Electric ☐ Oil ☐ Natural Gas ☐ Propane Gas ☐
Construction type: _____ Reinforced Concrete _____ Structural Steel _____ Masonry _____ Wood Frame _____	Sprinkler system: <u>N/A</u> ☐ Full _____ Partial _____ Other Suppression _____ # of Heads _____
State Certified Modular _____	

BUILDING DESCRIPTION - RESIDENTIAL

Building Characteristics	Utilities
SF Dwelling ☒ SF Townhouse ☐ Depth _____ Width _____	Water Supply: _____ Public ☒ Private _____
1st floor: _____	Sewage Disposal: _____ Public _____ Private ☒
2nd floor: _____	Electric Yes ☐ No ☐ Gas Yes ☐ No ☐
Basement: _____	Heating System: _____ Electric ☐ Oil ☐ Natural Gas ☐ Propane Gas ☐
Finished Basement ☐ Unfinished Basement ☐ Crawl space ☐ Slab on Grade ☐ No. of Bedrooms _____	Sprinkler system: <u>N/A</u> ☐ NFPA #13D _____ NFPA #13R _____ Other: _____
Height: _____	
Multi-family dwellings: _____ No. of efficiency units: _____ No. of 1 BR units: _____ No. of 2 BR units: _____ No. of 3 BR units: _____	
Other Structure: _____ Dimensions: _____ Footings: _____ Roof Height: _____	
State Certified Modular _____ Manufactured Home _____	

THE UNDERSIGNED HEREBY CERTIFIES AND AGREES AS FOLLOWS: (1) THAT HE/SHE IS AUTHORIZED TO MAKE THIS APPLICATION; (2) THAT THE INFORMATION IS CORRECT; (3) THAT HE/SHE WILL COMPLY WITH ALL REGULATIONS OF HOWARD COUNTY WHICH ARE APPLICABLE THERETO; (4) THAT HE/SHE WILL PERFORM NO WORK ON THE ABOVE REFERENCED PROPERTY NOT SPECIFICALLY DESCRIBED IN THIS APPLICATION; (5) THAT HE/SHE GRANTS COUNTY OFFICIALS THE RIGHT TO ENTER ONTO THIS PROPERTY FOR THE PURPOSE OF INSPECTING THE WORK PERMITTED AND POSTING NOTICES.

Applicant's Signature

Title/Company

Print Name

Date

Checks payable to: DIRECTOR OF FINANCE OF HOWARD COUNTY

** PLEASE WRITE NEATLY AND LEGIBLY **

- FOR OFFICE USE ONLY -

AGENCY	DATE	SIGNATURE APPROVAL
Land Development, DPZ		
State Highways		
Building Official		
Dev. Engineering, DPZ		
Health	<u>4/11/2007</u>	<u>John A. C.</u>
Fire Protection		

Is Sediment Control approval required prior to issuance?

YES ☐ NO ☐

CONTINGENCY CONSTRUCTION START: ☐

ONE STOP SHOP: ☐

Distribution of Copies-

White: Building Official

Green: LDD, DPZ

Yellow: DED, DPZ

Pink: Health

Gold: SHA

T:\forms\PERMIT.FRM

DPZ SETBACK INFORMATION

Front: _____	Filing fee	\$ _____
Rear: _____	Permit fee	\$ _____
Side: _____	Excise tax	\$ _____
Side St.: _____	Add'l per. fee	\$ _____
All minimum setbacks met?	TOTAL FEES	\$ _____
YES ☐ NO ☐	Sub-total paid	\$ _____
Is Entrance Permit required?	Balance due	\$ _____
YES ☐ NO ☐	Check	# _____
Historic District?	Validation	# _____
YES ☐ NO ☐		

Lot Coverage for NewTown Zone _____

SDP/Red-line approval date _____

Accepted by _____

Grass Swale

Grading per
GP-05-75

Stilling Pool
Per GP-05-75

Clearing & grading
per this grading plan

APPROVED

WALK-THRU BUILDING PERMIT
BP# _____ A# 514366/PS24478
APP. SAN GAC DATE: 4/11/2007
DESC. OF WORK: DECK, POOL, GAZEBO,
HOT TUB, AND WATERFALL w/ Pool

Grading and
construction
per GP-05

PROPOSED CONC.

HOUSE
F.F. = 526.9
B.F. = 515.9

GAR.
525.9

CONC.

Appex
+ 2' x 2'

MACADAM DR

EXISTING PAVING

Easement for
gress & Egress
126/F.104

Water & Utility
#12472

LOT 32
5.682 AC.±

(EAST WINCHESTER LANE)

12/07
CAD
in
G.S.

CABLE TV

GATE CONTROL
BOX

WATER
METER

EXISTING PAVING

BRICK
COLUMNS

WATER (CONTRACT 44-3479)

HOWARD COUNTY
PERMIT APPLICATION

PERMIT NUMBER

~~20061010130~~

Building Address 11525 E. WINCHESTER LN
ELLICOTT CITY, MD 21043
Suite/Apt. #: _____ SDPWP/Petition #: _____
Census Tract _____ Subdivision Kings Gift
Section _____ Area _____ Lot 32
Tax Map 16 Parcel 349 Grid B
Zoning _____ Map Coordinates _____ Lot size 5.68 AC

Property Owner's Name CHRISTOPHER LAC LONG
Address 4724 Aratan Lane
City Owings Mill State MD Zip Code 21117
Home Phone 410-977-6770 Work Phone 410-977-6790
Applicant's Name & Mailing Address, (if other than stated hereon):
Joseph NGUYEN
Phone 703-622-2245 Fax _____

Existing Use _____
Proposed Use _____
Estimated Construction Cost \$ 35,000.00
Description of Work Addition a deck
and a Gazebo
Deck: 25'x11'-4" + 20'x19' - 9' High
Gazebo: 10'x10' sides, 18' Dia, 10' High
Occupant or Tenant CHRISTOPHER LAC LONG
Contact Name Joseph Nguyen, P.E.
Address 6255 WILLS ST
City Alexandria State VA Zip Code 22310
Phone 703-622-2245 Fax 703-922-9324

Contractor Company BP OWNER
Contact Person _____
Address _____
City _____ State _____ Zip Code _____
License No. _____
Phone _____ Fax _____
Engineer or Architect Company NA
Contact Person Joseph Nguyen
Address 6255 WILLS ST
City ALEXANDRIA State VA Zip Code 22310
Phone 703 622 2245 Fax _____

BUILDING DESCRIPTION - COMMERCIAL

Building Characteristics	Utilities
Height: _____	Water Supply: _____ Public _____ Private _____
No. of stories: _____	Sewage Disposal: _____ Public _____ Private _____
Gross area, sq. ft. per floor: _____	Electric Yes ☐ No ☐ Gas Yes ☐ No ☐
Use group: _____	Heating System: _____ Electric ☐ Oil ☐ Natural Gas ☐ Propane Gas ☐
Construction type: _____ Reinforced Concrete _____ Structural Steel _____ Masonry _____ Wood Frame _____	Sprinkler system: <u>N/A</u> ☐ Full _____ Partial _____ Other Suppression _____ # of Heads _____
State Certified Modular _____	

BUILDING DESCRIPTION - RESIDENTIAL

Building Characteristics	Utilities
SF Dwelling ☒ SF Townhouse ☐ Depth _____ Width _____	Water Supply: _____ Public ☒ Private _____
1st floor: _____	Sewage Disposal: _____ Public _____ Private ☒
2nd floor: _____	Electric Yes ☐ No ☐ Gas Yes ☐ No ☐
Basement: _____	Heating System: _____ Electric ☐ Oil ☐ Natural Gas ☐ Propane Gas ☐
Finished Basement ☐ Unfinished Basement ☐ Crawl space ☐ Slab on Grade ☐ No. of Bedrooms: _____	Sprinkler system: <u>N/A</u> ☐ NFPA #13D _____ NFPA #13R _____ Other: _____
Height: _____	
Multi-family dwellings: _____	
No. of efficiency units: _____	
No. of 1 BR units: _____	
No. of 2 BR units: _____	
No. of 3 BR units: _____	
Other Structure: _____	
Dimensions: _____	
Footings: _____	
Roof Height: _____	
State Certified Modular _____	
Manufactured Home _____	

THE UNDERSIGNED HEREBY CERTIFIES AND AGREES AS FOLLOWS: (1) THAT HE/SHE IS AUTHORIZED TO MAKE THIS APPLICATION; (2) THAT THE INFORMATION IS CORRECT; (3) THAT HE/SHE WILL COMPLY WITH ALL REGULATIONS OF HOWARD COUNTY WHICH ARE APPLICABLE THERETO; (4) THAT HE/SHE WILL PERFORM NO WORK ON THE ABOVE REFERENCED PROPERTY NOT SPECIFICALLY DESCRIBED IN THIS APPLICATION; (5) THAT HE/SHE GRANTS COUNTY OFFICIALS THE RIGHT TO ENTER ONTO THIS PROPERTY FOR THE PURPOSE OF INSPECTING THE WORK PERMITTED AND POSTING NOTICES.

Applicant's Signature Joseph Nguyen
Title/Company AGENT

Print Name JOSEPH NGUYEN
Date April 6, 2007

Checks payable to: **DIRECTOR OF FINANCE OF HOWARD COUNTY**
** PLEASE WRITE NEATLY AND LEGIBLY. **
- FOR OFFICE USE ONLY -

AGENCY	DATE	SIGNATURE APPROVAL
Land Development, DPZ		
State Highway		
Building Official		
Dev. Engineering, DPZ		
Health	<u>4/5/07</u>	<u>Collyer</u>
Fire Protection		

Is Sediment Control approval required prior to issuance?
YES ☐ NO ☐

CONTINGENCY CONSTRUCTION START: ☐
ONE STOP SHOP: ☐


Distribution of Copies: _____
White: Building Official _____
Green: LDD, DPZ _____

DPZ SETBACK INFORMATION	PROPERTY ID#
Front: _____	Filing fee \$ _____
Rear: _____	Permit fee \$ _____
Side: _____	Excise tax \$ _____
Side St: _____	Add'l per. fee \$ _____
All minimum setbacks met? YES ☐ NO ☐	TOTAL FEES \$ _____
Is Entrance Permit required? YES ☐ NO ☐	Sub-total paid \$ _____
Historic District? YES ☐ NO ☐	Balance due \$ _____
Lot Coverage for New Town Zone _____	Check \$ <u>384</u>
SDP/Red-line approval date _____	Validation \$ _____

Accepted by _____


Distribution of Copies: _____
Yellow: DED, DPZ _____
Pink: Health _____
Gold: SHA _____

U.S. ROUTE 40
(R/W WIDTH VARIES)

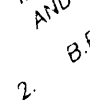-  DESIGNATES BUILDING
 B.R.L. DESIGNATES BUILDING
 SF DESIGNATES STABILIZED
 RL DESIGNATES SLOPE
 SF DESIGNATES SPOT ELEVATION
 RL DESIGNATES SILT FENCE
 SF DESIGNATES EXISTING
 RL DESIGNATES EXISTING

APPROVED
 WALKTHRU BUILDING PERMIT
 A# 514340
 BP#
 APP. SAN AT
 DATE: 4/5/07
 DESC. OF WORK: Deck + Gr. 2600

- NOTES:
 1. THE TOPOGRAPHY
 IN APRIL OF
 AND DRIVE
 2. B.R.L.
 3.

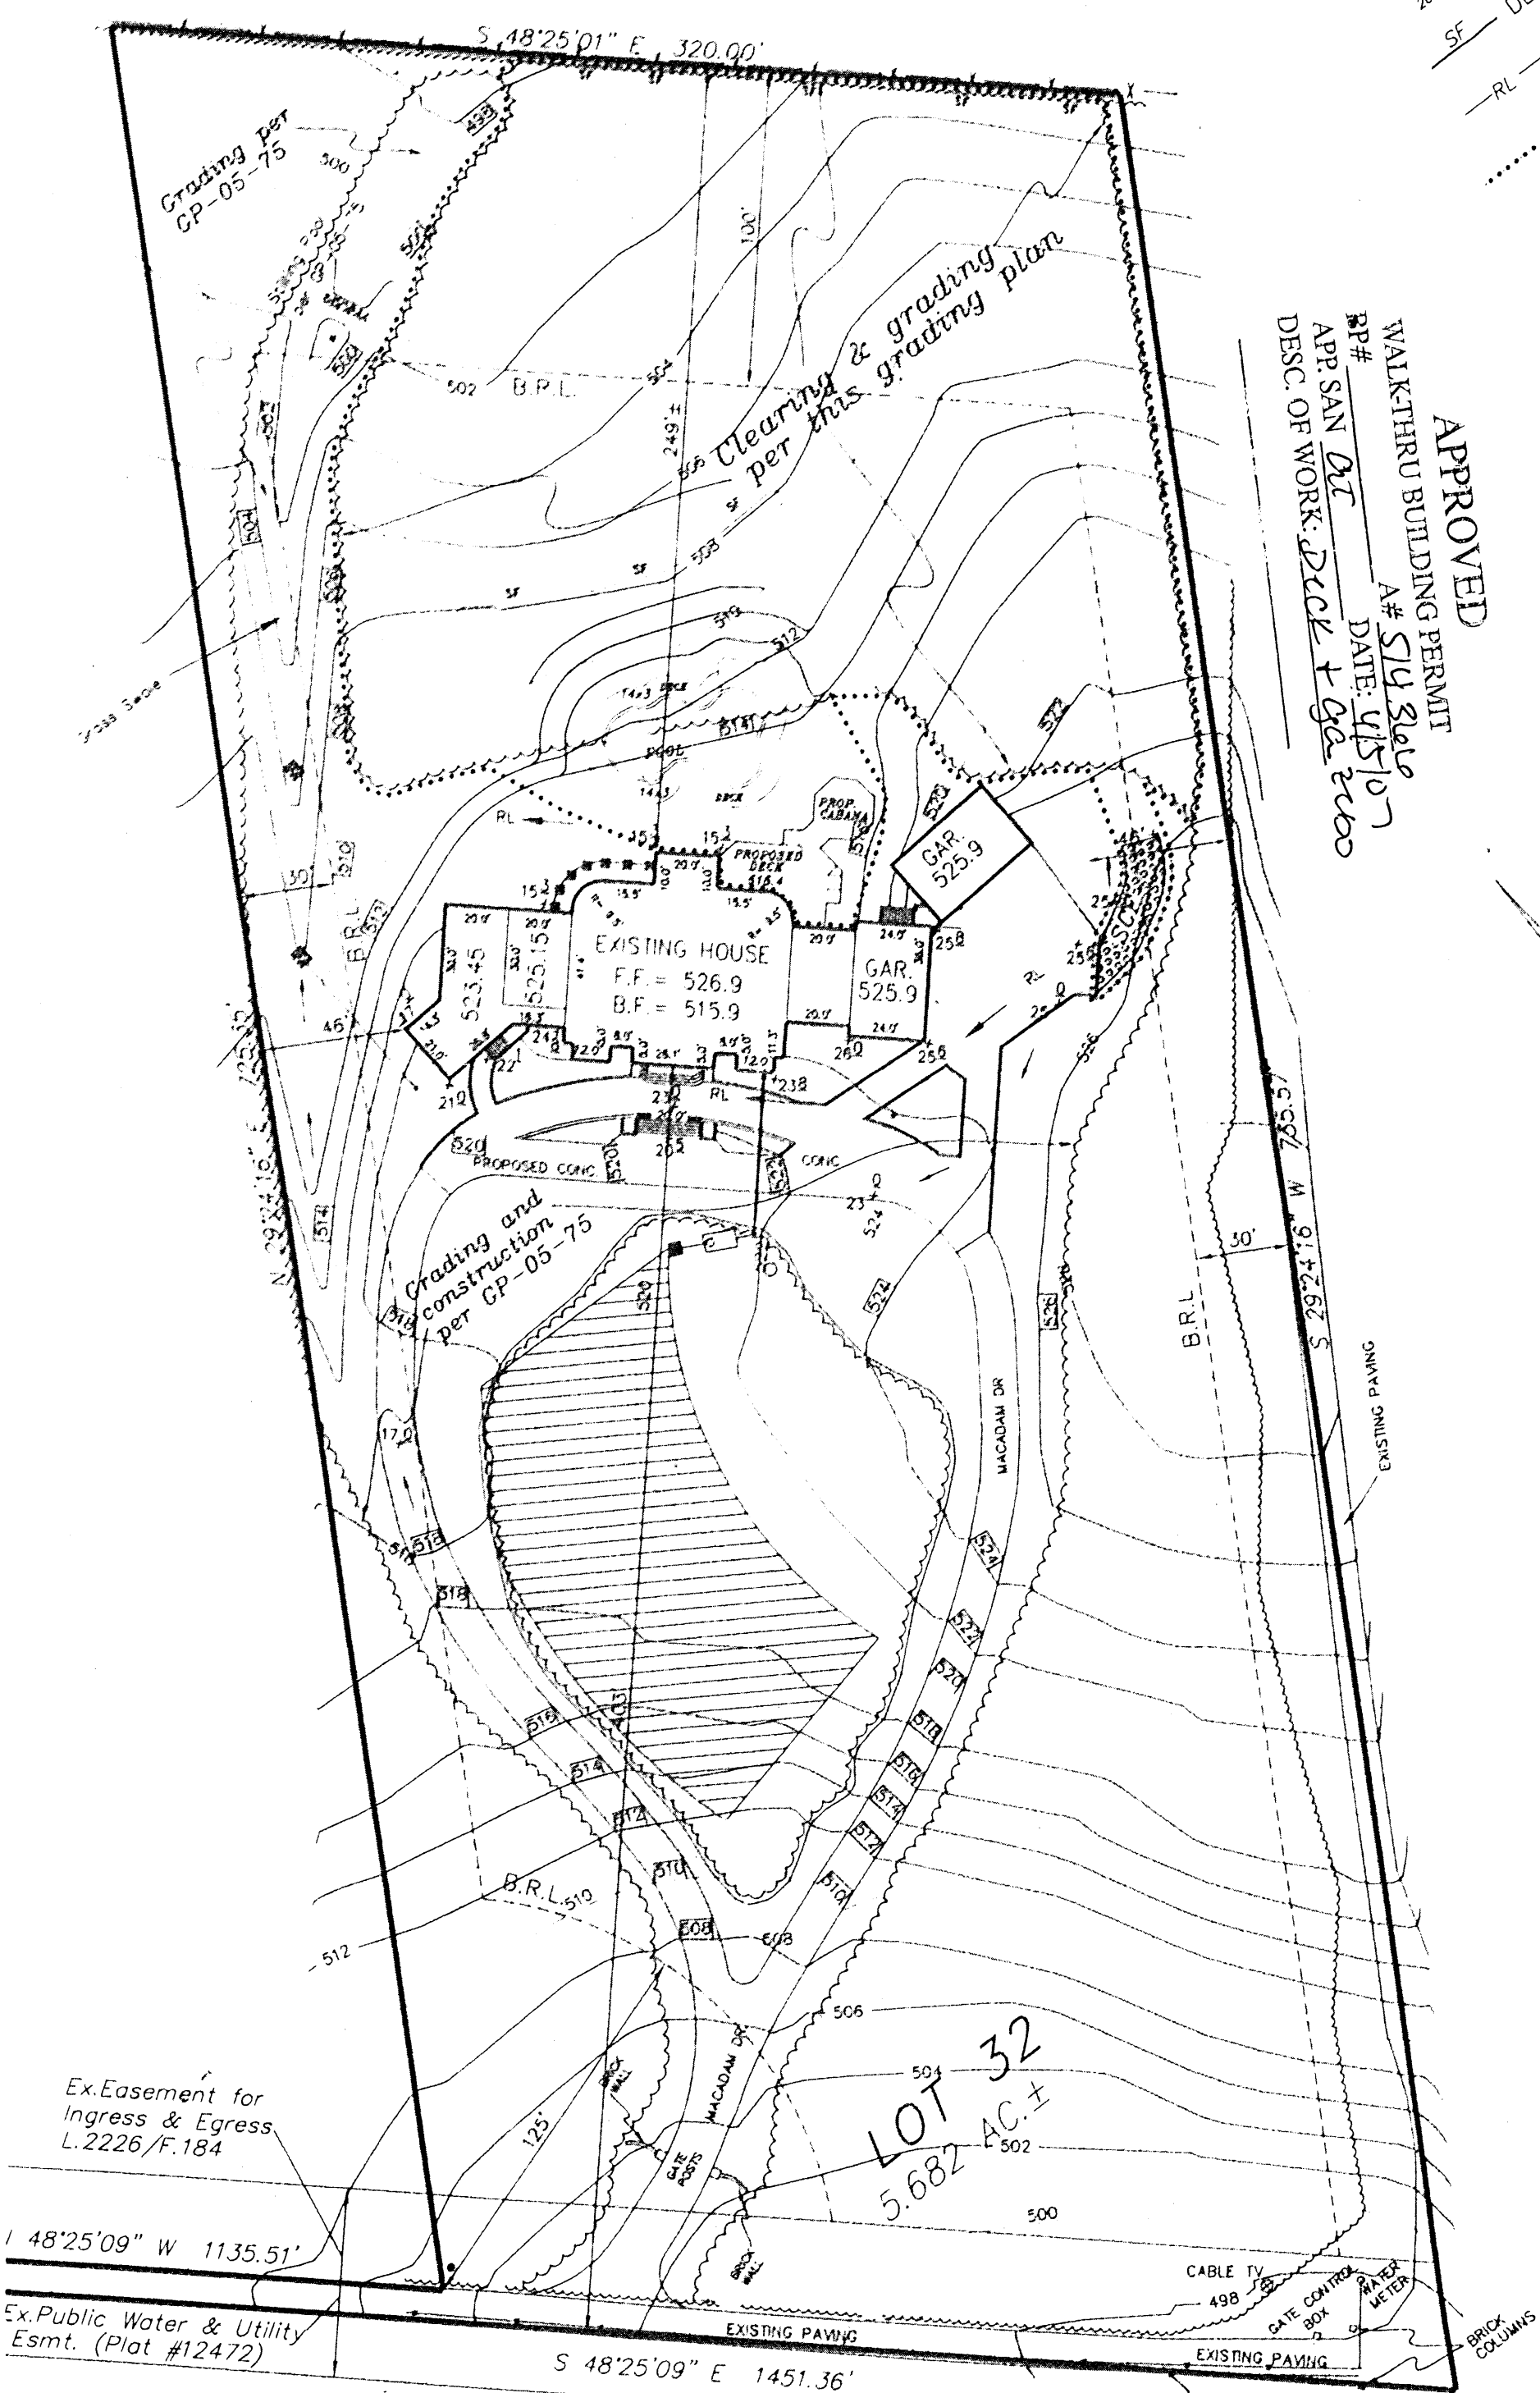



DEPARTMENT OF INSPECTIONS, LICENSES AND PERMITS 3430 COURT HOUSE DRIVE ELICOTT CITY, MD 21043 PERMITS (410) 313-2455 INSPECTIONS (410) 313-1810 AUTOMATED INFORMATION (410) 313-3800		HOWARD COUNTY PERMIT APPLICATION		PERMIT NUMBER B07000499	
Building Address <u>11525 East Winchester Lane</u> <u>ELLICOTT CITY, MD 21042</u>			Property Owner's Name <u>Christopher Lane</u> <u>Thu Nguyen</u>		
Suite/Apt. #: _____ SDP/WP/Petition #: <u>44-3479</u>			Address <u>4724 Avalon Lane</u>		
Census Tract <u>6030</u> Subdivision <u>Kings Gift</u>			City <u>Owings Mills</u> State <u>MD</u> Zip Code <u>21117</u>		
Section _____ Area _____ Lot <u>32</u>			Home Phone <u>410-977-6790</u> Work Phone _____		
Tax Map <u>16</u> Parcel <u>349</u> Grid _____			Applicant's Name & Mailing Address, (if other than stated hereon): <u>William Ingram</u> <u>901 Driven Rd, Marriottsville, MD 21047</u>		
Zoning _____ Map Coordinates <u>10J4</u> Lot size _____			Phone <u>410-442-2139</u> Fax <u>410-442-3280</u>		
Existing Use <u>New Single Family Dwelling</u>			Contractor Company <u>Homeowner</u>		
Proposed Use _____			Contact Person _____		
Estimated Construction Cost <u>\$ 10,000.00</u>			Address _____		
Description of Work <u>Install retaining wall</u> <u>at rear of house - Using Allan</u> <u>Block 9 Ft. High x 30 Ft. Long Approx.</u> <u>9' High tapered down to 13' High</u>			City _____ State _____ Zip Code _____		
Occupant or Tenant <u>B00154078</u>			License No. _____		
Contact Name _____			Phone _____ Fax _____		
Address _____			Engineer or Architect Company <u>Phoenix Engineering</u>		
City _____ State _____ Zip Code _____			Contact Person _____		
Phone _____ Fax _____			Address <u>1420-A Job Ave.</u>		
			City <u>Baltimore</u> State <u>MD</u> Zip Code <u>21202</u>		
			Phone <u>410-247-8233</u> Fax <u>410-247-9377</u>		

BUILDING DESCRIPTION - COMMERCIAL		BUILDING DESCRIPTION - RESIDENTIAL	
Building Characteristics	Utilities	Building Characteristics	Utilities
Height: _____	Water Supply: _____ Public _____ Private _____	SF Dwelling ☐ SF Townhouse ☐ Depth _____ Width _____	Water Supply: _____ ☒ Public _____ Private _____
No. of stories: _____	Sewage Disposal: _____ Public _____ Private _____	1st floor: _____	Sewage Disposal: _____ ☒ Public _____ Private _____
Gross area, sq. ft. per floor: _____	Electric Yes ☐ No ☐ Gas Yes ☐ No ☐	2nd floor: _____	Electric Yes ☒ No ☐ Gas Yes ☒ No ☐
Use group: _____	Heating System: _____ Electric ☐ Oil ☐ Natural Gas ☐ Propane Gas ☐	Basement: _____	Heating System: _____ Electric ☐ Oil ☐ Natural Gas ☒ Propane Gas ☐
Construction type: _____ Reinforced Concrete _____ Structural Steel _____ Masonry _____ Wood Frame _____	Sprinkler system: N/A ☐ Full _____ Partial _____ Other Suppression _____ # of Heads _____	Finished Basement ☐ Unfinished Basement ☐ Crawl space ☐ Slab on Grade ☐ No. of Bedrooms _____ Height: _____ Multi-family dwellings: No. of efficiency units: _____ No. of 1 BR units: _____ No. of 2 BR units: _____ No. of 3 BR units: _____	Sprinkler system: N/A ☐ NFPA #13D _____ NFPA #13R _____ Other: _____
_____ State Certified Modular		Other Structure: _____ Dimensions: _____ Footings: _____ Roof Height: _____ _____ State Certified Modular _____ Manufactured Home	

THE UNDERSIGNED HEREBY CERTIFIES AND AGREES AS FOLLOWS: (1) THAT HE/SHE IS AUTHORIZED TO MAKE THIS APPLICATION; (2) THAT THE INFORMATION IS CORRECT; (3) THAT HE/SHE WILL COMPLY WITH ALL REGULATIONS OF HOWARD COUNTY WHICH ARE APPLICABLE THERETO; (4) THAT HE/SHE WILL PERFORM NO WORK ON THE ABOVE REFERENCED PROPERTY NOT SPECIFICALLY DESCRIBED IN THIS APPLICATION; (5) THAT HE/SHE GRANTS COUNTY OFFICIALS THE RIGHT TO ENTER ONTO THIS PROPERTY FOR THE PURPOSE OF INSPECTING THE WORK PERMITTED AND POSTING NOTICES.

[Signature]

Applicant's Signature

Title/Company

William Ingram

Print Name

2/15/07

Date

Checks payable to: DIRECTOR OF FINANCE OF HOWARD COUNTY

** PLEASE WRITE NEATLY AND LEGIBLY. **


FOR OFFICE USE ONLY

AGENCY	DATE	SIGNATURE APPROVAL	DPZ SETBACK INFORMATION	PROPERTY ID#
Land Development, DPZ			Front: _____	Filing fee: \$ _____
State Highways			Rear: _____	Permit fee: \$ _____
Building Official			Side: _____	Excise tax: \$ _____
Dev. Engineering, DPZ			Side St: _____	Add'l per. fee: \$ _____
Health	<u>2/15/07</u>	<u>[Signature]</u>	All minimum setbacks met? YES ☐ NO ☐	TOTAL FEES: \$ _____
Fire Protection			Is Entrance Permit required? YES ☐ NO ☐	Sub-total paid: \$ _____
Is Sediment Control approval required prior to issuance? YES ☐ NO ☐			Historic District? YES ☐ NO ☐	Balance due: \$ _____
CONTINGENCY CONSTRUCTION START: ☐			Lot Coverage for NewTown Zone _____	Check: # <u>10314</u>
ONE STOP SHQP: ☐			SUP/Red-line approval date _____	Validation: <u>1/</u>
Distribution of Copies: _____	Write: Building Official	Green: LUD, DPZ	Accepted by _____	
T:\forms\PERMIT.FRM			Yellow: DED, DPZ	
			Pink: Health	
			Gold: SH/	

NOTES:

1. THIS PLAT IS OF BENEFIT TO A CONSUMER ONLY INsofar AS IT IS REQUIRED BY A LENDER OR TITLE INSURANCE COMPANY OR ITS AGENT IN CONNECTION WITH CONTEMPLATED TRANSFER, FINANCING, OR REFINANCING.
2. THIS PLAT IS NOT TO BE RELIED UPON FOR THE ESTABLISHMENT OR LOCATION OF FENCES, GARAGES, BUILDINGS, POOLS, BUILDING ADDITIONS OR OTHER EXISTING OR FUTURE IMPROVEMENTS.
3. THIS PLAT DOES NOT PROVIDE FOR THE ACCURATE IDENTIFICATION OF PROPERTY BOUNDARY LINES, BUT SUCH IDENTIFICATION MAY NOT BE REQUIRED FOR THE TRANSFER OF TITLE OR SECURING FINANCING OR REFINANCING.
4. ACCURACY OF BUILDING MEASUREMENTS: 0.1'
5. ACCURACY OF SETBACK DIMENSIONS: 1.0'

THE PROPERTY SHOWN HEREON
LIES IN ZONE C AS SHOWN ON
FLOOD INSURANCE RATE MAP
NO: 2400440016 B
DATED: DEC. 4, 1986

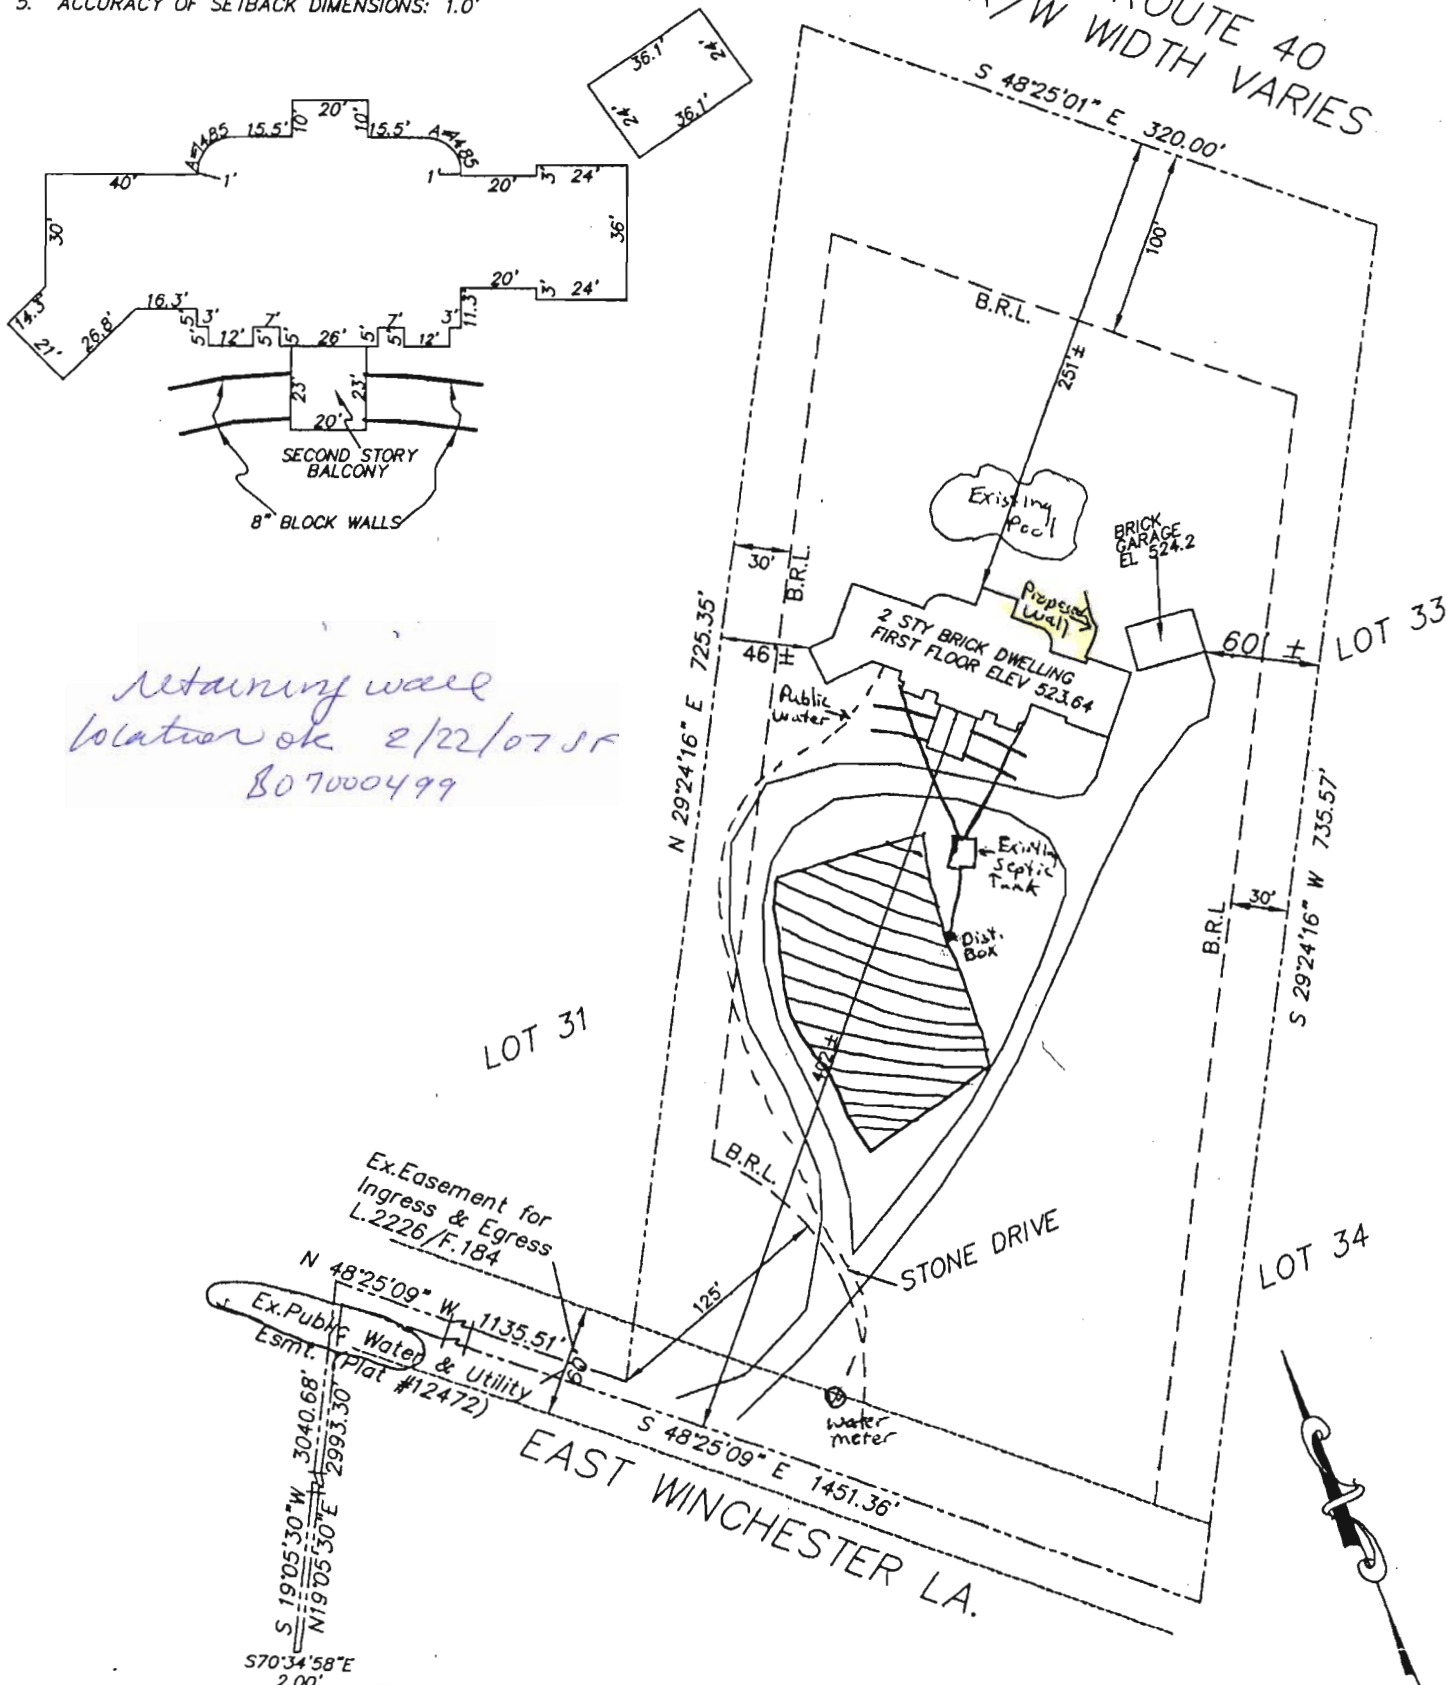

MD. STATE OF MARYLAND
ROUTE 144

I HEREBY CERTIFY THAT I HAVE LOCATED THE IMPROVEMENTS AS SHOWN. THIS PLAT DOES NOT REPRESENT A BOUNDARY SURVEY AND CANNOT BE USED TO ESTABLISH PROPERTY LINES OR CORNERS.

SHANABERGER & LANE

8726 TOWN AND COUNTRY BLVD.
SUITE 201
ELLCOTT CITY, MD. 21043
(410)461-9563 FAX: 461-9693

FOUNDATION LOCATION DRAWING
KING'S GIFT LOT 32


DEED REF: LIBER 8100 FOLIO 130
TAX MAP 16 GRID 8 PARCEL 349

ELECTION DISTRICT: 3RD
COUNTY: HOWARD
SCALE: 1"=100'

DATE: JANUARY 22, 2007
DATE OF LATEST FIELD WORK: 01/18/07


SETBACKS:	
REAR PL.	50'
SIDE PL.	30'
HOUSE	0'
SEPTIC	20'
WELL	30'

PUBLIC WATER & PRIVATE SEPTIC

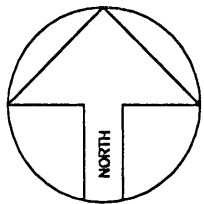

ZONE ONE

NOTE: HOUSE IS UNDER
CONSTRUCTION
PERMIT NO: B00154078

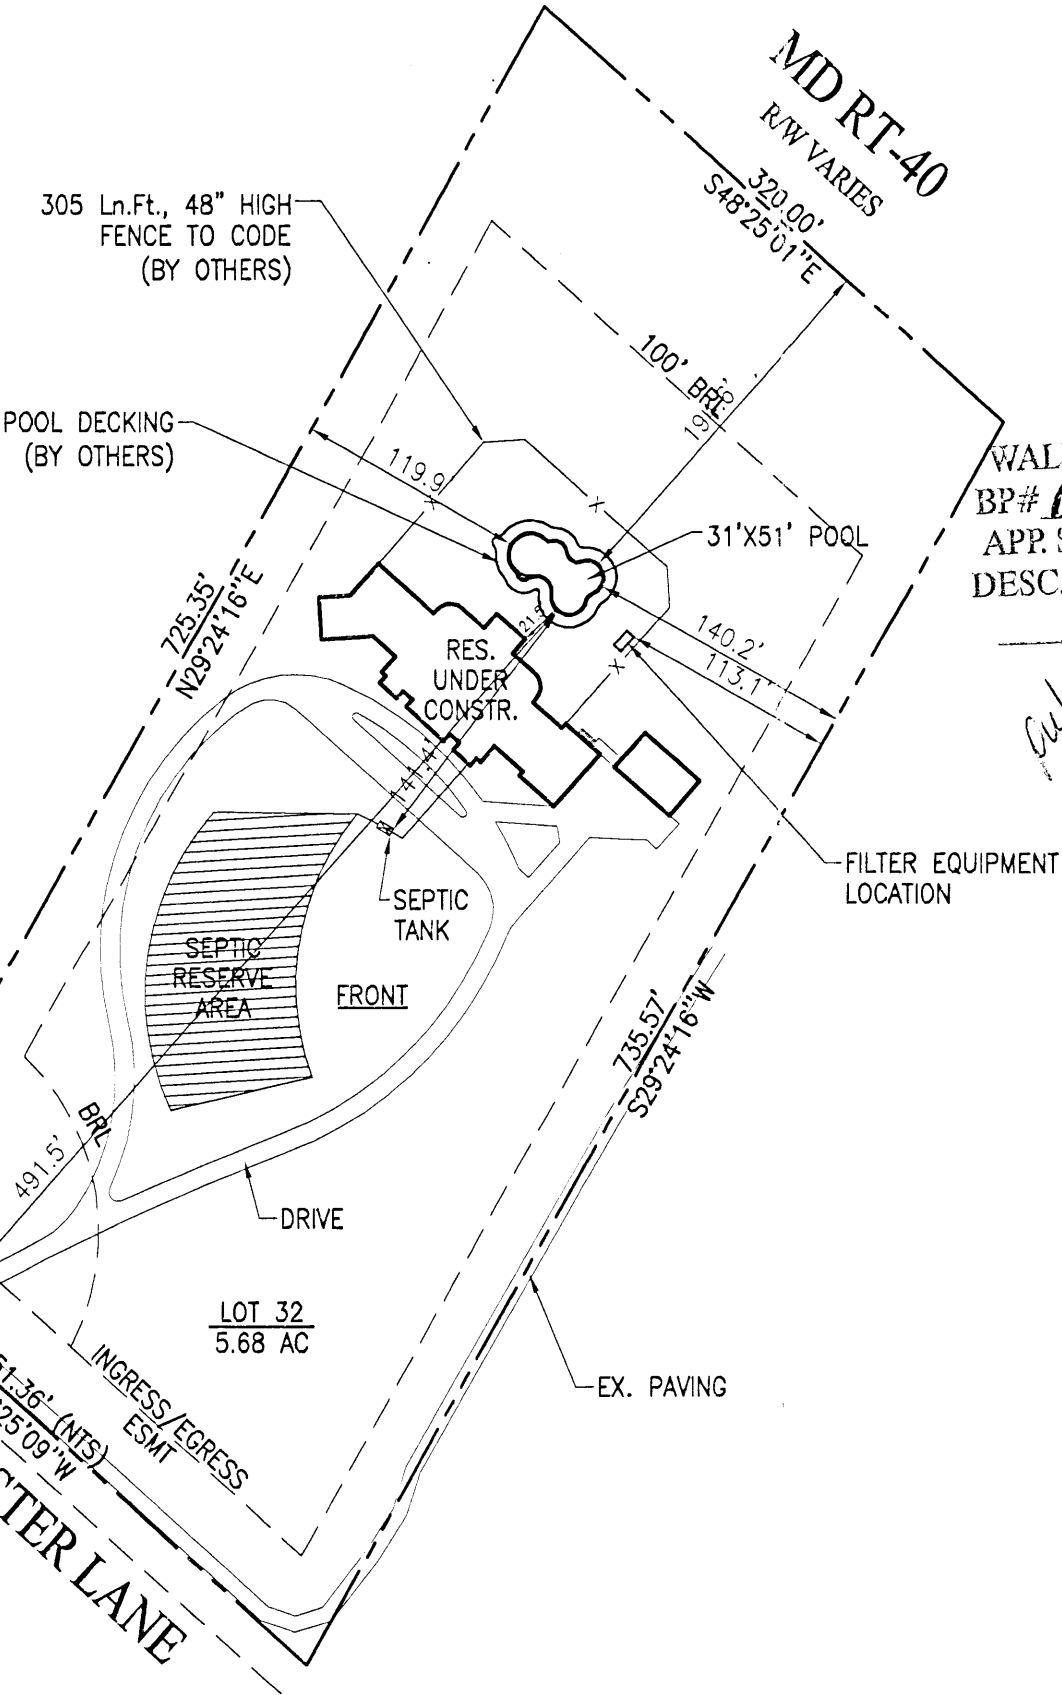

APPROVED
WALK-THRU BUILDING PERMIT
BP# B00158812 A# 51436
APP. SAN face Norman DATE: 3-30-06
DESC. OF WORK: wrap pool

Public
H₂O

SITE PLAN

1"=100'

LOT 32

KINGS GIFT

TAX ACCOUNT #283445
MAP 16, GRID 8, PARCEL 349
3RD ELECTION DISTRICT
HOWARD COUNTY, MARYLAND

MAILING ADDRESS:
JOE NGUYEN - AGENT/ARCH.
6255 WILLS STREET
ALEXANDRIA, VA 22310

PERMIT NUMBERS
POOL:
ELECT:
OTHER:

PERMIT SET

DATE: 03-30-06

Maryland POOLS

9515 GERWIG LANE 11166 MAIN STREET
SUITE 121 SUITE 402
COLUMBIA, MD 21046 FAIRFAX, VA 22030
410-993-6600 703-359-7192
800-252-SWIM
WWW.MARYLANDPOOLS.COM

EQUIPMENT LIST

DIRT/GRADING: HAUL - 1 HOUR (IN CONTRACT)
SPA: NONE
RAISED BEAM: NONE
TILE: TBD
COPING: PA FULL RANGE FLAGSTONE - CUT
PLASTER: TBD
FILTER SYS: C&C 420 SF CART. W/2 HP PUMP
CLEANING SYS: PCC 2000
TREATMENT SYS: (2) MINERAL SPRINGS
CONTROL SYS: INTELLITOUCH i7+3
HEATER: AC-125 HEAT PUMP
LIGHTS: TWO WATTS: 500 VOLTS: 120
LOVESEAT: (1) @ 4' INSIDE & (1) 6' OUTSIDE
AQUA BENCH: (1) @ 6'
RAIL GOODS: NONE
DECKING: BY OTHERS
FENCE: BY OTHERS
POOL COVER: NONE TYPE: N/A
CHEMICALS: \$50 CHEMICAL ALLOWANCE
OTHER ITEMS: 10' DIVING BOARD & STAND
INITIAL WATER FILL
WATERFALL PREP & HEAVY UP
WATERFALL (BY HERITAGE)
ELECTRIC: 200 FT. (TRISTAR)

POOL DATA

SIZE/SHAPE: 31' x 51' - CUSTOM
POOL AREA: 1020 SPA: OTHER: 12
TOTAL AREA: 1032
PERIMETER: 135 SPA:
GALLONAGE: 44,000 DEPTH: 3'-0" TO 9'-0"

DIRECTIONS TO SITE

RT-29 NORTH TO I-70 WEST. CONTINUE TO EXIT 83,
MARIOTTVILLE RD. GO SOUTH, CROSS RT-40 TO R/T ON
RT-144, FREDERICK ROAD. GO TO R/T ON KINGS GIFT. STAY
ON KINGS GIFT TO R/T AT END ON EAST WINCHESTER LANE.
GO TO SITE ON LEFT - UNDER CONSTRUCTION

MAP #

10

GRID

J3

Christopher Lac Long
11525 E. Winchester Lane
Ellicott City, Maryland 21043
Howard County

HOME PHONE: 703-922-8315 (JOE)
CELL PHONE 1: 703-622-8315 (JOE)
CELL PHONE 2:
OFFICE PHONE:

LOT: 32	SUBDIVISION NAME: KINGS GIFT	DISTRICT: 3	PIN # 283445
SITE PLAN			ZONE: ONE
SCALE: 1"=100'	BY: JEK	DATE: 03/30/06	JOB NUMBER: JK06-8814
			SHEET #: S-1

HOWARD COUNTY
PERMIT APPLICATION

PERMIT NUMBER
30054078

ding Address 11525 EAST WINCHESTER LA
ELLICOTT CITY, MD 21043
Suits/Apts AYED 03-283445 SDP/WP/Petition #: _____
Census Tract 6030 Subdivision KINGS GIFT
Section _____ Area _____ Lot 32
Tax Map 03-283445 Parcel 349 Grid 8
Zoning RCDP Map Coordinates 1054 Lot size 5.680 ACRES

Property Owner's Name CHRISTOPHER LAC LONG
AND THU HA NGUYEN
Address 4724 AVATAR LANE
City OWINGS MILLS State MD Zip Code 21117
Home Phone 410 972-6790 Work Phone _____
Applicant's Name & Mailing Address, (if other than stated hereon):
JOSEPH NGUYEN
6255 WILLS ST. ALEXANDRIA, VA 22310
Phone 703 922 8315 Fax 703 922-9324

Existing Use VACANT LOT
Proposed Use NEW SINGLE FAMILY HOME
Estimated Construction Cost \$ 1,500,000.00
Description of Work Building new house
5 Bedrooms, 5 Full baths + 3 Half Baths
2-3 car garages, 2 Kitchens, Front porch
Partial Basement (Portion)
Occupant or Tenant Resident
Contact Name JOSEPH NGUYEN
Address 6255 WILLS ST
City ALEXANDRIA State VA Zip Code 22310
Phone 703-922-8315 Fax 703-922-9324

Contractor Company TBD
Contact Person _____
Address _____
City _____ State _____ Zip Code _____
License No. _____ Phone _____ Fax _____
Engineer or Architect Company N-SQUARE ENGINEERS, INC
Contact Person JOSEPH NGUYEN
Address 6255 WILLS ST
City ALEXANDRIA State VA Zip Code 22310
Phone 703 922-8315 Fax 703-922-9324

BUILDING DESCRIPTION - COMMERCIAL

BUILDING DESCRIPTION - RESIDENTIAL

Building Characteristics	Utilities
Height: _____	Water Supply: _____ Public _____ Private _____
No. of stories: _____	Sewage Disposal: _____ Public _____ Private _____
Gross area, sq. ft. per floor: _____	Electric Yes ☐ No ☐ Gas Yes ☐ No ☐
Use group: _____	Heating System: _____ Electric ☐ Oil ☐ Natural Gas ☐ Propane Gas ☐
Construction type: _____ Reinforced Concrete _____ Structural Steel _____ Masonry _____ Wood Frame _____ State Certified Modular _____	Sprinkler system: N/A ☐ Full _____ Partial _____ Other Suppression _____ # of Heads _____

Building Characteristics	Utilities
SF Dwelling ☒ SF Townhouse ☐ Depth _____ Width _____ 1st floor: <u>67'</u> <u>200 feet</u> 2nd floor: <u>67'</u> <u>110 feet</u> Basement: <u>67'</u> <u>70 feet</u> Finished Basement ☐ Unfinished Basement ☐ Crawl space ☒ Slab on Grade ☒ No. of Bedrooms <u>5</u> Height: <u>4.5 ft</u> Multi-family dwellings: _____ No. of efficiency units: _____ No. of 1 BR units: _____ No. of 2 BR units: _____ No. of 3 BR units: _____ Other Structure: _____ Dimensions: _____ Footings: _____ Roof Height: _____ State Certified Modular _____ Manufactured Home _____	Water Supply: _____ Public _____ Private _____ Sewage Disposal: _____ Public _____ Private ☒ Electric Yes ☒ No ☐ Gas Yes ☐ No ☐ Heating System: _____ Electric ☒ Oil ☐ Natural Gas ☐ Propane Gas ☐ Sprinkler system: N/A ☐ NFPA #13D _____ NFPA #13R _____ Other: _____

THE UNDERSIGNED HEREBY CERTIFIES AND AGREES AS FOLLOWS: (1) THAT HE/SHE IS AUTHORIZED TO MAKE THIS APPLICATION; (2) THAT THE INFORMATION IS CORRECT; (3) THAT HE/SHE WILL COMPLY WITH ALL REGULATIONS OF HOWARD COUNTY WHICH ARE APPLICABLE THERETO; (4) THAT HE/SHE WILL PERFORM NO WORK ON THE ABOVE REFERENCED PROPERTY NOT SPECIFICALLY DESCRIBED IN THIS APPLICATION; (5) THAT HE/SHE GRANTS COUNTY OFFICIALS THE RIGHT TO ENTER ONTO THIS PROPERTY FOR THE PURPOSE OF INSPECTING THE WORK PERMITTED AND POSTING NOTICES.

Applicant's Signature

Owner

Title/Company

CHRISTOPHER L. LONG

Print Name

4/01/05 5:27:05

Date

Checks payable to: DIRECTOR OF FINANCE OF HOWARD COUNTY

** PLEASE WRITE NEATLY AND LEGIBLY. **

- FOR OFFICE USE ONLY -

AGENCY	DATE	SIGNATURE APPROVAL
Land Development, DPZ		
State Highways		
Building Official		
Dev. Engineering, DPZ		
Health	<u>4/14/05</u>	<u>[Signature]</u>
Fire Protection		
Is Sediment Control approval required prior to issuance?		
YES ☒ NO ☐		

CONTINGENCY CONSTRUCTION START: ☐

ONE STOP SHOP: ☐

DPZ SETBACK INFORMATION

Front	Filing fee	PROPERTY ID#
Rear	Permit fee	<u>65820</u>
Side	Excise tax	<u>100</u>
Side St.	Add'l per. fee	
All minimum setbacks met?	TOTAL FEES	
YES ☐ NO ☐	Sub-total paid	
Is Entrance Permit required?	Balance due	
YES ☐ NO ☐	Check	<u>294</u>
Historic District?	Validation	<u>41529</u>
YES ☐ NO ☐		
Lot Coverage for NewTown Zone		
SDP/Red-line approval date		

Distribution of Copies-
T: Forms \ PERMIT.FRM

White: Building Official

Green: LDD, DPZ

Yellow: DED, DPZ

Pink: Health

Gold: SHA

Accepted by [Signature]