

PRELIMINARY

APPLICATION

A 31274

SEWAGE DISPOSAL TESTING

STATE OF MARYLAND - DEPARTMENT OF HEALTH AND MENTAL HYGIENE

P _____

HOWARD COUNTY HEALTH DEPARTMENT
ENVIRONMENTAL HEALTH SERVICES

P. O. BOX 473 ELLICOTT CITY, MARYLAND 21043
TELEPHONE: 992-2330

DISTRICT 4th

DATE 3/27/81

TO: THE COUNTY HEALTH OFFICER
ELLICOTT CITY, MARYLAND

I, HEREBY, APPLY FOR THE NECESSARY TEST IN ORDER TO CONSTRUCT (OR RECONSTRUCT) A SEWAGE DISPOSAL SYSTEM.

PROPERTY OWNER ~~Georgia Avenue Properties, Inc.~~ STEPHEN FORNEY

Jack Boender

ADDRESS 13638 Georgia Avenue, Wheaton, Md. 20906 PHONE 465-7777

PROPERTY LOCATION: PATAPSCO OVERLOOK III

~~NEW LOT 12~~ **NEW LOT 43**
~~NO~~ **FINAL PLAT**

SUBDIVISION Georgia Avenue LOT NO. _____

ROAD AND DESCRIPTION ~~Route 94 and Old Frederick Road~~ 757 Weller Dr.

SIZE OF LOT 3 acres m/l TYPE BLDG. 3 or 4 bedrooms
(NUMBER OF BEDROOMS)

THE SYSTEM INSTALLED UNDER THIS APPLICATION IS ACCEPTABLE ONLY UNTIL PUBLIC FACILITIES BECOME AVAILABLE. I FULLY UNDERSTAND THE FEE CONNECTED WITH THE FILING OF THIS PERC TEST APPLICATION IS NON-REFUNDABLE UNDER ANY CIRCUMSTANCES. I ALSO AGREE TO COMPLY

WITH ALL M.O.S.H.A. REQUIREMENTS IN TESTING THIS LOT. /s/ Jack Boender for E. Brooke Lee, III
(SIGNATURE OF APPLICANT)

APPROVED BY S. M. FOR Shallow trenches DATE 11-5-87

REJECTED BY _____ FOR _____ DATE _____

HOLD PENDING FURTHER TESTS _____ DATE _____

REASONS FOR REJECTION OR HOLDING _____

BLDG. PERMIT SIGNED
AND RETURNED 11-5-87


61 15434
SM

THIS IS NOT A PERMIT

LOT 40

VIEW 12

360'

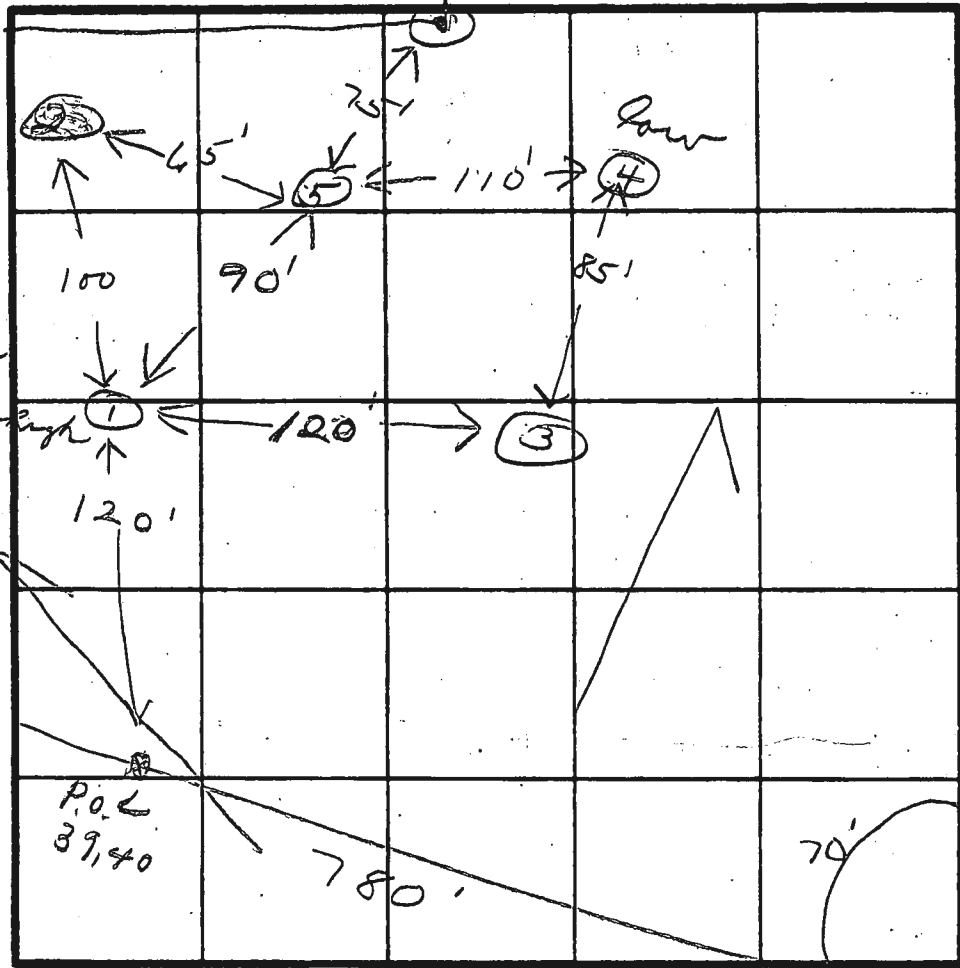

INDICATE NORTH - NAME ADJOINING ROADWAY AS BASE LINE.


- ① SOIL PROFILE
- clay 2'
 - sandy clay little mixed shale 14'
 - ⑤ clay 2'
 - sandy loam 11'
 - ws shale 12'
 - ④ clay 10'
 - clay sand 4'
 - Heavy mixed shale 13'

DATE	TEST NO.	DEPTH	PRE-WET		TEST - 1" DROP		TIME
			START	STOP	START	STOP	
4/13/81	15	3 1/2	1:35	1:39	1:39	1:45	6
	1M	7 1/2	1:35	1:39	1:39	1:45	6
	2	10 Heavy shale - at 5 ft					
	3 ✓	11 same as #1					
	45	3 1/2	2:15	2:18	2:18	2:23	5
	4M	7 1/2	2:15	2:18	2:18	2:24	6
	55	3	2:42	2:46	2:46	2:53	6
	5M	7	2:42	2:45	2:45	2:48	5

3'-mud
8'-mud

REMARKS _____
 TYPE OF SOIL _____
 TESTED BY *[Signature]* ALSO PRESENT *Richard Lee*

EH-12-1079

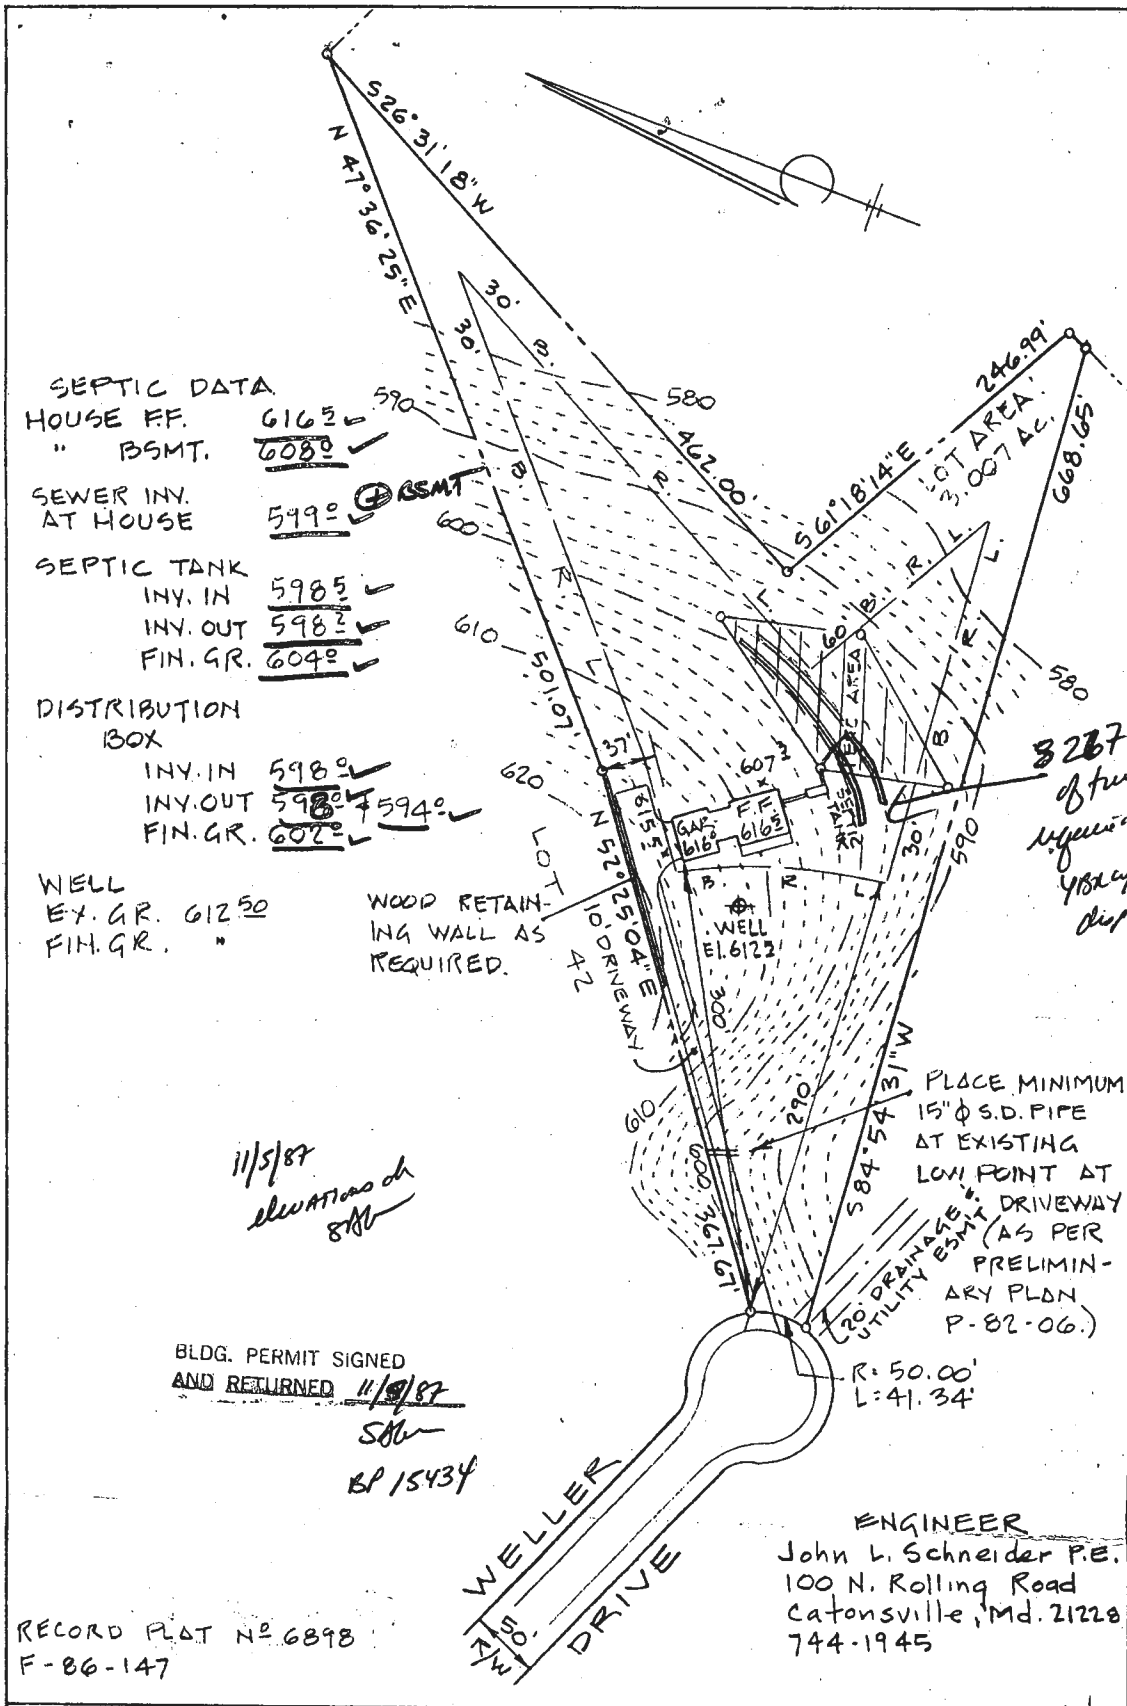

SEPTIC DATA
 HOUSE F.F. 616.5 ✓
 " BSMT. 608.0 ✓
 SEWER INV. AT HOUSE 599.0 ✓
 SEPTIC TANK
 INV. IN 598.5 ✓
 INV. OUT 598.2 ✓
 FIN. GR. 604.0 ✓
 DISTRIBUTION BOX
 INV. IN 598.0 ✓
 INV. OUT 598.0 ✓ 594.0 ✓
 FIN. GR. 602.0 ✓
 WELL
 EX. GR. 612.50
 FIN. GR. "

WOOD RETAINING WALL AS REQUIRED.

3287 LF of trench required for 48" x 60" disposal

11/5/87 elevations ok SDB

BLDG. PERMIT SIGNED AND RETURNED 11/9/87 SDB BP 15434

PLACE MINIMUM 15" Ø S.D. PIPE AT EXISTING LOW POINT AT DRIVEWAY (AS PER PRELIMINARY PLAN P-82-06.)

ENGINEER
 John L. Schneider P.E.
 100 N. Rolling Road
 Catonsville, Md. 21228
 744-1945

RECORD PLAT NO. 6898
 F-86-147

GRADING STUDY

LOT 43 SECTION 3
 "PATAPSCO OVERLOOK"
 4th ELECTION DISTRICT
 HOWARD COUNTY - MD.

Scale: 1" = 100'

SEPT. 30, 1987

