

MARYLAND DEPARTMENT OF THE ENVIRONMENT
 WATER AND SCIENCE SERVICES
 1800 Washington Boulevard, Baltimore, MD 21230 410-537-3784
 WATER WELL ABANDONMENT-SEALING REPORT FORM

017
 MS 8/23/25

SUBMIT COPIES OF COMPLETED FORM TO:


- County Environmental Agency (contact MDE, WSA if address needed)
- Well Owner
- MDE, Water and Science Services Administration, Well Program

Date Well Abandoned: July 2, 2025
 Permit Number of Abandoned Well (if any): HO-81-2240
 Permit Number of Replacement Well:
 Person Abandoning Well: Jerry Miller III
 Owner's Name: Development Partners

Well Driller's License#: WRO074
 Check: MWD MSD MGD

Well Location:
 County: Howard
 Nearest Town: Clarksville
 Tax Map (Block & Parcel):
 Subdivision:
 Section & Lot:
 Street Address: 5942 Trotter Road
 Latitude: 3 9.208388
 Longitude: 7 6.920712

Site Location Map: (Please include as attachment or image file)

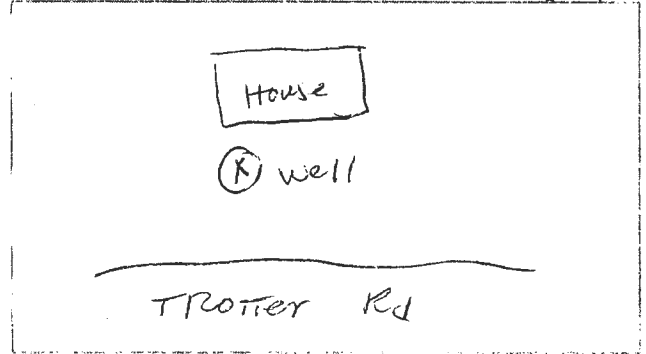

Type of Well Being Abandoned:

Drilled Jetted
 Bored Hand Dug
 Other (specify)

Use Code:

Domestic Municipal/Public
 Irrigation Industrial
 Test/Observ. Geothermal

Type of Casing:

Steel Plastic
 Concrete Other (specify)

Size of Casing: 6 Inches in diameter

Depth of Well: 200 Feet deep

Was any casing removed? Yes No

If yes, length removed, in feet: 1

Was casing ripped or perforated? Yes No

Log of Sealing Material

Material	Feet	
	From	To
Bentonite	200	0

Volume of Material Used

650 Lbs mixed for slurry

Pursuant to § 10-624 of the State Govt. Article of the Maryland Code, personal info requested on this form is used in processing this form pursuant to COMAR 26.04.04. Failure to provide the info may result in this form not being processed. You have the right to inspect, amend, or correct this form. The Maryland Department of the Environment is subject to the Maryland Public Information Act. This form may be made available on the Internet via MDE's website and is subject to inspection or copying, in whole or in part, by the public and other governmental agencies, if not protected by federal or State Law.

George F. Easterday License#
 Signature-Master Well Driller or Supervising Sanitarian

MWD 040

Check One
 MWD MSD MGS

07/09/2025
 Date

County