

APPLICATION

A 12857

P _____

SEWAGE DISPOSAL TESTING

MARYLAND STATE DEPARTMENT OF HEALTH

HOWARD COUNTY

ELLCOTT CITY

*Septic Tank - 750 gal.*DISTRICT 4

*Dry Well - 3.75' of ft absorbent sidewall area to begin
about inlet pipe. Inlet pipe 4' below original grade. Max depth
permitted for Dry Well is 12' below original grade*

DATE 7/21/67

*Place Dry Well about 195' ft from front lot line and about
45' ft from left sidewalk as seen when facing from Florence Rd.*

TO: THE COUNTY HEALTH OFFICER
ELLCOTT CITY, MARYLAND

I, HEREBY, APPLY FOR THE NECESSARY TESTS IN ORDER TO CONSTRUCT (OR RECONSTRUCT) A SEWAGE DISPOSAL SYSTEM.

PROPERTY OWNER Charles R. BlaneyADDRESS 2216 Pleasant View Ave., Catonsville 28 PHONE HO 5-3634

PROPERTY LOCATION:

SUBDIVISION _____ LOT NO. 1ROAD AND DESCRIPTION Florence Rd. - about 3/10 mile from Rt. 144 at Iishon

OCCUPANT _____ PHONE _____

PERSON TO CONSTRUCT SYSTEM _____

ADDRESS _____ PHONE _____

SIZE OF LOT 1.6175 acres TYPE BLDG. 3

NUMBER OF BEDROOMS

IF NOT SINGLE RESIDENCE DESCRIBE _____
(Single Fmly. Dwlg.)SIGNATURE OF APPLICANT Charles R. Blaney✓ APPROVED BY Leo Murray FOR Dry Well DATE 7-27-67

(KIND OF SYSTEM)


REJECTED BY _____ FOR _____ DATE _____

(KIND OF SYSTEM)

HOLD PENDING FURTHER TESTS _____ DATE _____

REASONS FOR REJECTION OR HOLDING _____

THIS IS NOT A PERMIT

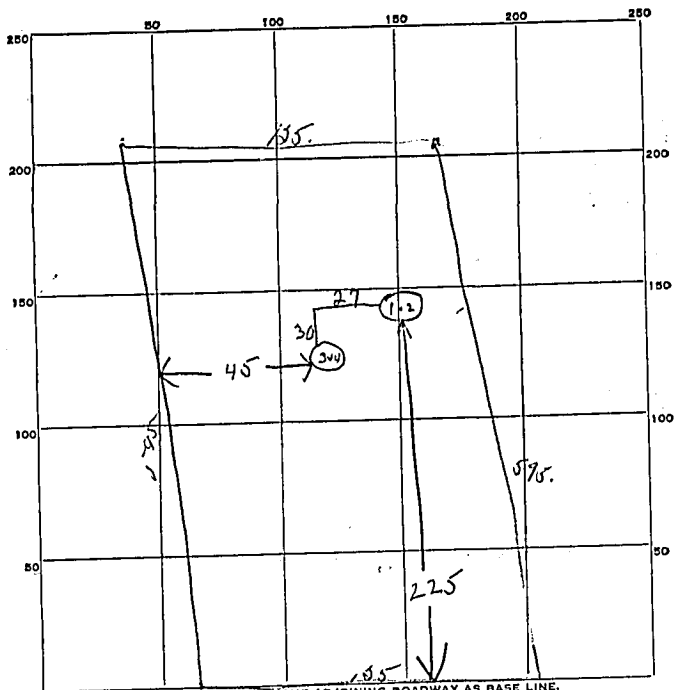

INDICATE NORTH. - NAME ADJOINING ROADWAY AS BASE LINE.

RT 94 - Florence Road

DATE	TEST NO.	DEPTH	PRE-WET		TEST - 1" DROP		TIME
			START	STOP	START	STOP	
7/27/77	1	4' 0"	10 08	10 10	10 10	10 20	10 min
	2	9' 6"	10 08	10 09	10 09	10 13	4 min
	3	9' 1/2"	10 14	10 19	10 19	10 31	12 min
	4	4' 6"	10 15	10 21	10 21	10 30	9 min

SOIL AUGER FINDING _____

TESTED BY DUM

REMARKS

7/27/77 - also present - Charles R. Blaney Set #1