

12/5/68  
*[Handwritten signature]*

off 10-5-69  
*[Handwritten initials]*

# PERMIT

SEWAGE DISPOSAL SYSTEM

MARYLAND STATE DEPARTMENT OF HEALTH

HOWARD COUNTY

ELLICOTT CITY

DISTRICT 4

DATE 12/2/68

P 14156

A 12857

**INDEXED**

Herman Sirk IS PERMITTED TO INSTALL X ALTER

ADDRESS Annapolis Rock Road, Woodbine, Md. PHONE 489-4724

A SEWAGE DISPOSAL SYSTEM LOCATED AT \_\_\_\_\_

SUBDIVISION \_\_\_\_\_ ROAD 1660 Rt. 94  
Florence Rd. - about 1

PROPERTY OWNER Charles R. Blaney Harry Schaub  
3/10 mi. from Rt. 144 at Lisbon

ADDRESS \_\_\_\_\_

SPECIFICATIONS - 3 bedrooms

DRAIN FIELD \_\_\_\_\_ DEPTH \_\_\_\_\_ FEET, BOTTOM AREA \_\_\_\_\_ SQ. FT.

SEEPAGE PITS \_\_\_\_\_ ABSORBENT SIDE-WALL AREA \_\_\_\_\_ SQ. FT.

SEPTIC TANK CAPACITY 750 GALLONS

FOR GARBAGE GRINDER, INCREASE DISPOSAL AREA 22% & TANK CAPACITY 50%.

OTHER Dry well - 375 sq. ft. absorbent sidewall area to begin below inlet  
pipe. Inlet pipe 4 ft. below original grade. Max. depth permitted for dry well  
is 12 ft. below original grade. Place dry well about 195 ft. from front lot  
line and about 45 ft. from left side line as seen when facing from Florence Rd.

PERMIT VOID AFTER THREE YEARS.

PLANS APPROVED BY D. W. Monaghan DATE 7/27/67

FILL SEPTIC TANK AND DISTRIBUTION BOX WITH WATER BEFORE CALLING FOR AN INSPECTION. COVER NO WORK UNTIL INSPECTED AND APPROVED.


NEITHER THE HOWARD COUNTY COMMISSIONERS NOR THE HEALTH DEPARTMENT IS RESPONSIBLE FOR THE SUCCESSFUL OPERATION OF ANY SYSTEM.

BLDG. PERMIT SIGNED  
AND RETURNED 10/20/68  
Smith #38905 - room addition

**NOTIFY THE HEALTH DEPARTMENT 48 HOURS  
BEFORE EXCAVATIONS ARE TO BE BACK FILLED.**

*[Handwritten number]*  
12857

$$\begin{array}{r} 3.14 \\ \times 15 \\ \hline 47.10 \\ + 31.40 \\ \hline 78.50 \end{array}$$

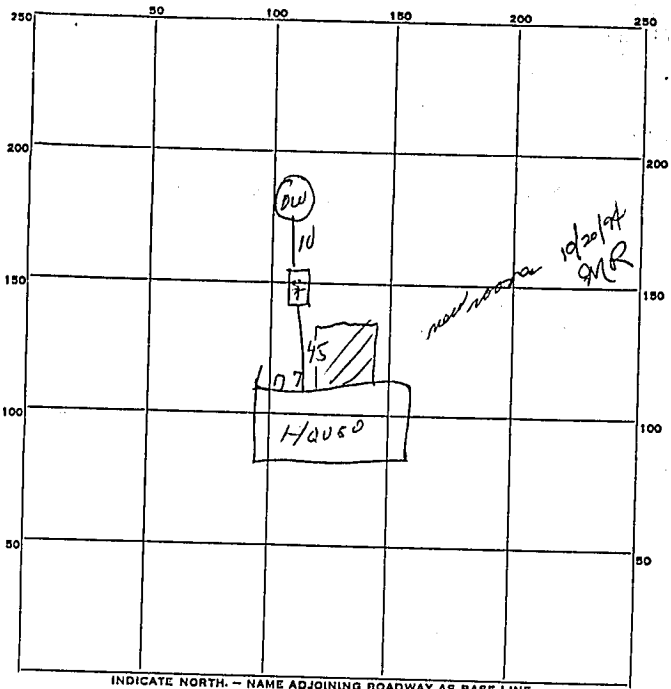

PERMIT CARD OK  
 SEPTIC TANK, LEVEL OK CLEANOUTS OK  
 DISTRIBUTION BOX, LEVEL \_\_\_\_\_  
 TILE FIELD, DEPTH \_\_\_\_\_ FT. TRENCH WIDTH \_\_\_\_\_ FT.  
 GRAVEL DEPTH \_\_\_\_\_ IN. TOTAL LENGTH \_\_\_\_\_ FT.  
 NUMBER OF TRENCHES \_\_\_\_\_ TOTAL BOTTOM AREA \_\_\_\_\_  
 SEEPAGE PITS, <sup>outside</sup> INSIDE DIAMETER 14 FT. DEPTH BELOW INLET 8 FT.  
 ABSORBENT AREA 376.8 SQ. FT.

REMARKS \_\_\_\_\_

\_\_\_\_\_

\_\_\_\_\_

\_\_\_\_\_

\_\_\_\_\_

DATE SYSTEM APPROVED 13/5/68 INSPECTOR Dee Mangal