

APPLICATION

SEWAGE DISPOSAL TESTING

03410
A ~~03277~~
P 03573

MARYLAND STATE DEPARTMENT OF HEALTH

HOWARD COUNTY 750 gallon septic tank for 3 ELLICOTT CITY

bedrooms or less.

DISTRICT 4th

Tile field to be a minimum of
435 sq. ft., installed within the
area tested.

DATE ~~4/3/61~~
3/3/61

*As not paid
to be included in.*

TO: THE COUNTY HEALTH OFFICER
ELLICOTT CITY, MARYLAND

I, HEREBY, APPLY FOR THE NECESSARY TESTS IN ORDER TO CONSTRUCT (OR RECONSTRUCT) A SEWAGE DISPOSAL SYSTEM.

PROPERTY OWNER Albert F. Zlaris

ADDRESS Rt. 2 # Woodbine, Md. PHONE None

PROPERTY LOCATION:

SUBDIVISION _____ LOT NO. _____

ROAD AND DESCRIPTION Rt 94# - 9/10 mi. below decision - on Florence Rd -
right hand side.

OCCUPANT same PHONE _____

PERSON TO CONSTRUCT SYSTEM _____

ADDRESS _____ PHONE _____

SIZE OF LOT 100 acre farm TYPE BLDG. res. 3
NUMBER OF BEDROOMS

IF NOT SINGLE RESIDENCE DESCRIBE _____

✓ SIGNATURE OF APPLICANT Albert F. Zlaris

APPROVED BY Walter T. Chewy FOR TILE FIELD DATE 3/9/61
(KIND OF SYSTEM)

REJECTED BY _____ FOR _____ DATE _____
(KIND OF SYSTEM)


HOLD PENDING FURTHER TESTS 3-1-61 DATE _____

REASONS FOR REJECTION OR HOLDING 1-1-61 in return.

THIS IS NOT A PERMIT

00150

HOUSE

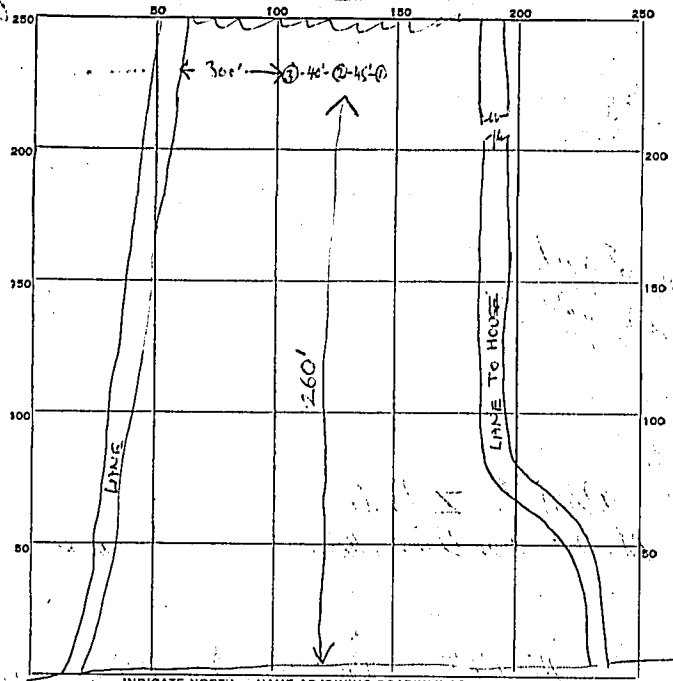

INDICATE NORTH. - NAME ADJOINING ROADWAY AS BASE LINE.

Rte # 614

DATE	TEST NO.	DEPTH	PRE-WET		TEST - 1" DROP		TIME
			START	STOP	START	STOP	
3/9/61	1	3	1:13	1:17	1:17	1:26	9 min
3/9/61	2	3	1:14	NO TEST			(40)
3/9/61	3	3	1:15	1:30	1:30	1:46	16 min

} 22 min. average

SOIL AUGER FINDING _____

TESTED BY Walter T. Jewry

REMARKS _____

ALSO PRESENT Paul Roussin LOT NO. _____