

Ok out  
8/16/61

# PERMIT

P 03573  
03410  
A 03410

SEWAGE DISPOSAL SYSTEM

MARYLAND STATE DEPARTMENT OF HEALTH

HOWARD COUNTY

ELLCOTT CITY

DISTRICT 4

INDEXED

DATE 4-41-61

Albert F. Zdanis IS PERMITTED TO INSTALL  ALTER

ADDRESS Rt. 2, Woodbine PHONE None

A SEWAGE DISPOSAL SYSTEM LOCATED AT Rt. 94 - 9/10 mi. below Lisbon on Florence Rd.  
right hand side.

SUBDIVISION ROAD LOT

PROPERTY OWNER Zdanis, Albert F.

ADDRESS Rt. 2, Woodbine

### SPECIFICATIONS

DRAIN FIELD  DEPTH 3 FEET, BOTTOM AREA 435 SQ. FT. installed in area tested.

SEEPAGE PITS ABSORBENT SIDE-WALL AREA SQ. FT.

SEPTIC TANK CAPACITY 750 GALLONS

FOR GARBAGE GRINDER, INCREASE DISPOSAL AREA 22% & TANK CAPACITY 50%.


OTHER Septic tank cannot be installed more than 3 ft. below original grade.

PLANS APPROVED BY Walton T. Loevy DATE 3/9/61

FILL SEPTIC TANK AND DISTRIBUTION BOX WITH WATER BEFORE CALLING FOR AN INSPECTION. COVER NO WORK UNTIL INSPECTED AND APPROVED.

NEITHER THE HOWARD COUNTY COMMISSIONERS NOR THE HEALTH DEPARTMENT IS RESPONSIBLE FOR THE SUCCESSFUL OPERATION OF ANY SYSTEM.

A 03410

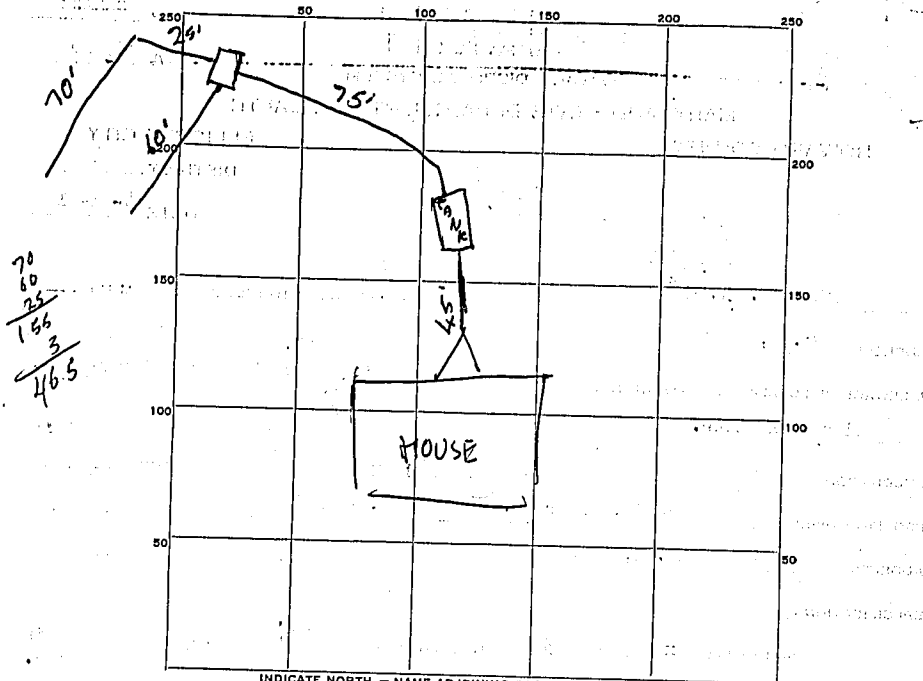

INDICATE NORTH. - NAME ADJOINING ROADWAY AS BASE LINE.  
RTE 94

PERMIT CARD

SEPTIC TANK, LEVEL 1000 concrete CLEANOUTS NO

DISTRIBUTION BOX, LEVEL  concrete

TILE FIELD, DEPTH 2-3 FT. TRENCH WIDTH 3 FT.

GRAVEL DEPTH 12 IN. TOTAL LENGTH 155 FT.

NUMBER OF TRENCHES 3 TOTAL BOTTOM AREA 465 S.F.

SEEPAGE PITS, INSIDE DIAMETER \_\_\_\_\_ FT. DEPTH BELOW INLET \_\_\_\_\_ FT.

ABSORBENT AREA \_\_\_\_\_ SQ. FT.

REMARKS \_\_\_\_\_  
 \_\_\_\_\_  
 \_\_\_\_\_  
 \_\_\_\_\_  
 \_\_\_\_\_

DATE SYSTEM APPROVED 8/16/61 INSPECTOR Jewy