

12/18/72

APP. 12-18-72  
SW 2

# PERMIT

P. 17586  
A. 17475

SEWAGE DISPOSAL SYSTEM

MARYLAND STATE DEPARTMENT OF HEALTH

HOWARD COUNTY

ELLICOTT CITY

DISTRICT 4th

## INDEXED

DATE 10/27/72

William Hopkins IS PERMITTED TO INSTALL 3 ALTER

ADDRESS Jennings Chapel Road, Woodbine, Md. PHONE 489-4711

A SEWAGE DISPOSAL SYSTEM LOCATED AT

SUBDIVISION ROAD Route 94 - see applica-  
tion for directions.

PROPERTY OWNER Courtney Burdette

ADDRESS Route 94, Woodbine, Maryland

SPECIFICATIONS 3 bedrooms

DRAIN FIELD DEPTH FEET, BOTTOM AREA SQ. FT.

SEEPAGE PITS ABSORBENT SIDE-WALL AREA SQ. FT.

SEPTIC TANK CAPACITY 1000 GALLONS

FOR GARBAGE GRINDER, INCREASE DISPOSAL AREA 22% & TANK CAPACITY 50%

OTHER DRY WELL - To have 162 square ft. absorbent sidewall area per bedroom below inlet. Inlet to come in at 3/2 ft. and maximum depth 12 feet. Location 135 ft. from edge of road (Route 94) and 150 ft. from right property line as staked at time of test when viewing lot from road.

NOTE: ALL PIPE FROM HOUSE TO SEPTIC TANK MUST BE CAST IRON.  
PERMIT VOID AFTER THREE YEARS.

NOTE: INSTALL STAND PIPE ON SEPTIC TANK AND DRY WELL.


PLANS APPROVED BY Charles B. Streaker DATE 10/5/72

FILL SEPTIC TANK AND DISTRIBUTION BOX WITH WATER BEFORE CALLING FOR AN INSPECTION. COVER NO WORK UNTIL INSPECTED AND APPROVED.

NEITHER THE HOWARD COUNTY COMMISSIONERS NOR THE HEALTH DEPARTMENT IS RESPONSIBLE FOR THE SUCCESSFUL OPERATION OF ANY SYSTEM.

A 17475

DATE SYSTEM APPROVED

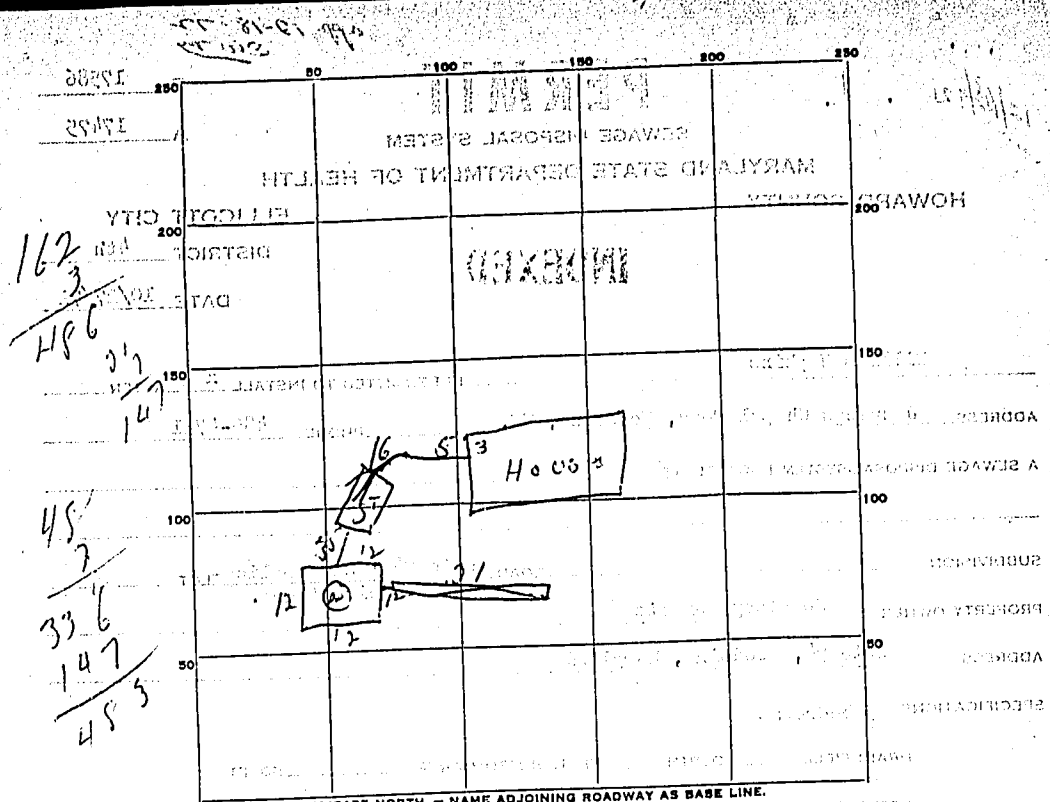

PERMIT CARD OK

SEPTIC TANK, LEVEL OK CLEANOUTS OK

DISTRIBUTION BOX, LEVEL \_\_\_\_\_

TILE FIELD, DEPTH \_\_\_\_\_ FT. TRENCH WIDTH \_\_\_\_\_ FT.

GRAVEL DEPTH \_\_\_\_\_ IN. TOTAL LENGTH \_\_\_\_\_ FT.

NUMBER OF TRENCHES \_\_\_\_\_ TOTAL BOTTOM AREA \_\_\_\_\_

SEEPAGE PITS, INSIDE DIAMETER Permit 12 FT. DEPTH BELOW INLET 71 FT.

ABSORBENT AREA 336 SQ. FT. 147 x 2 = 294 45 x 3 = 135

REMARKS credit given for 1 side of trench

DATE SYSTEM APPROVED 12/18/77 INSPECTOR NW M