

# APPLICATION

PERCOLATION TESTING

A 45650

P \_\_\_\_\_

HOWARD COUNTY HEALTH DEPARTMENT  
BUREAU OF ENVIRONMENTAL HEALTH  
P.O. BOX 476 ELLICOTT CITY, MARYLAND 21043  
TELEPHONE 461-9933

DISTRICT 4

DATE 2-9-90

TO: THE COUNTY HEALTH OFFICER  
ELLICOTT CITY, MARYLAND

I, HEREBY, APPLY FOR THE NECESSARY TEST IN ORDER TO CONSTRUCT (OR RECONSTRUCT) A SEWAGE DISPOSAL SYSTEM.

PROPERTY OWNER MICHAEL & DEBRA MULCANEY

ADDRESS 2910 ROUTE 94 PHONE \_\_\_\_\_

PROSPECTIVE BUYER MICHAEL & STEVEN MANTUA

ADDRESS 13002 TWELVE TREES COURT PHONE 301-531-3068  
CLARKSVILLE MD 21029

PROPERTY LOCATION: MANTUA

SUBDIVISION MULCANEY PROPERTY LOT NO. 4

ROAD AND DESCRIPTION ROUTE 94 - STATE ROAD

TAX MAP 13 PARCEL # 18

SIZE OF LOT 1.2 ACRES TYPE BLDG. SINGLE FAMILY  
(SINGLE FAMILY DWELLING OR COMMERCIAL)

THE SYSTEM INSTALLED UNDER THIS APPLICATION IS ACCEPTABLE ONLY UNTIL PUBLIC FACILITIES BECOME AVAILABLE. I FULLY UNDERSTAND THE FEE CONNECTED WITH THE FILING OF THIS PERC TEST APPLICATION IS NON-REFUNDABLE UNDER ANY CIRCUMSTANCES. I ALSO AGREE TO COMPLY WITH ALL M.O.S.H.A. REQUIREMENTS IN TESTING THIS LOT.

*[Handwritten Signature]*

(SIGNATURE OF APPLICANT)

APPROVED BY \_\_\_\_\_ FOR \_\_\_\_\_ DATE \_\_\_\_\_

REJECTED BY \_\_\_\_\_ FOR \_\_\_\_\_ DATE \_\_\_\_\_


HOLD PENDING FURTHER TESTS \_\_\_\_\_ DATE \_\_\_\_\_

REASONS FOR REJECTION OR HOLDING 4/17/90 Perc OK Hold For Plat R/H

HD-216

# THIS IS NOT A PERMIT

SEE PLAT

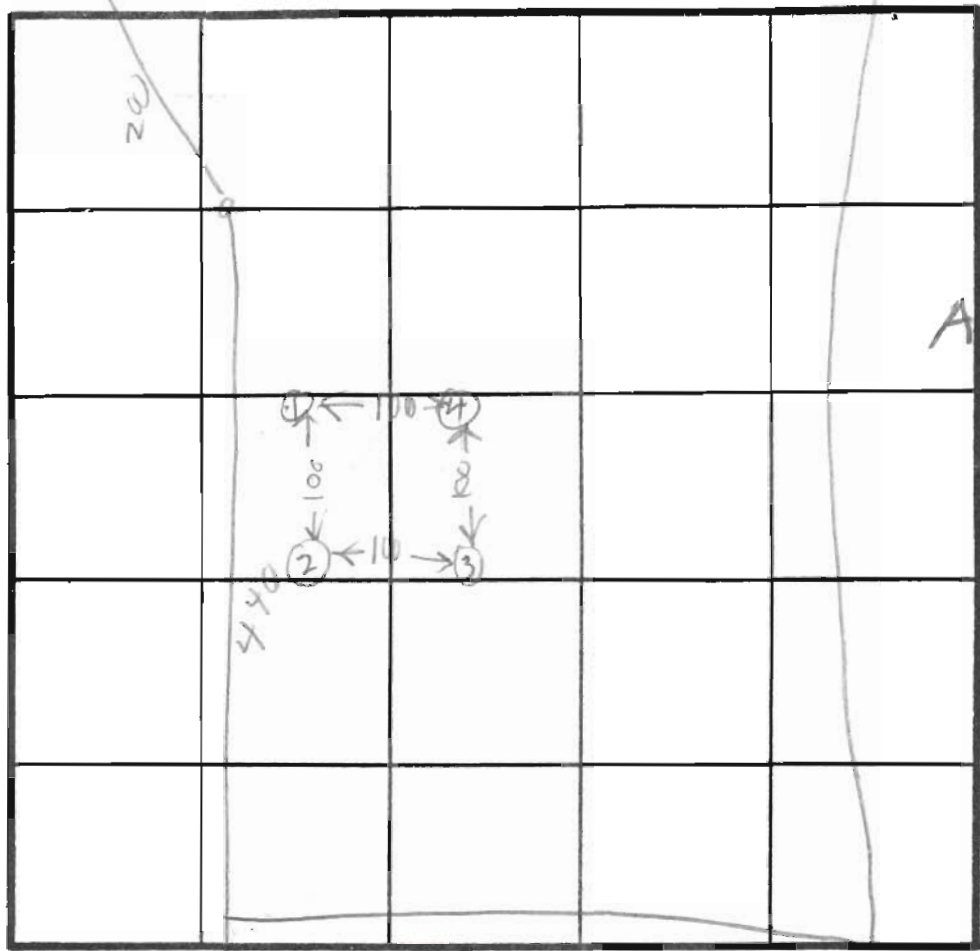

A 45650  
LOT 4

22 M  
210 BR

INDICATE NORTH - NAME ADJOINING ROADWAY AS BASE LINE.

ROUTE 94

SOIL PROFILE  
1  
CLAY  
BROWN SAND LOAM  
5% SHALE

CLAY  
PINK BROWN SAND LOAM  
100% SHALE

CLAY  
PINK BROWN SAND LOAM  
10% SHALE

DATE	TEST NO.	DEPTH	PRE-WET		TEST - 1" DROP		TIME
			START	STOP	START	STOP	
4/17/90	1 S	2	1231	1237	1237	100	23
	1 D	2	1234	1235	1235	1245	10
	1 V	12	OK				
	2 S	3	1242	1244	1244	1249	3
	2 D	5	1240	1246	1246	1254	8
	2 V	12	OK				
	3 S	3.5	1250	1255	1255	103	009
	3 D	5	1252	1253	1255	113	
	3 V	12	OK				
	4 D	5	106	110	100	115	5
	4 S	3	107	111	101	117	6
4/17/90	4 V	11.5	OK				

REMARKS: Holes (1)(2)(3)(4) dug per test Plat

TYPE OF SOIL \_\_\_\_\_  
TESTED BY B. HODGES  
ALSO PRESENT MANTUA BUYER JEFF & STEVE BACKHUS

A G. WARFIELD  
916/468  
ZONED: R

GLC2

LOT 4  
AC.

GLB2

SEWER  
EASEMENT  
2-21-78

GLC3

USE IN COMMON  
ENT FOR INGRESS

MtD2

ROUTE 94

PERC CERT - GRADIN  
SIGNED 10/11/91

AND ROUTE 94  
(BLIC ROAD)

TITLE	PERCOLA
PROJECT	GR