

Record Detail \* (This section is required.)

<b>Permit Type</b> Building/Residential/Misc/Tanks	<b>Permit Number</b> B25004975	<b>Opened Date</b> 11/06/2025
<b>Description of Work</b> SFD// INSTALL (1) 500GAL UNDERGROUND PROPANE TANK		

[check spelling](#)

Address \* (This section is required.)

Search Reset Clear Get Parcel & Owner

<b>Street #</b> 3264	<b>Street Name</b> STARTING GATE	<b>Street Type</b> CT
<b>Unit Type</b> --Select--	<b>Unit #</b>	<b>X Coordinate</b> -77.11342
		<b>Y Coordinate</b> 39.28749
<b>City</b> WOODBINE	<b>State</b> MD	<b>Zip Code</b> 21797
		<b>Primary</b> Yes

Approved 11/13/25  
AA

Parcel \* (This section is required.)

Search Reset Clear Get Address & Owner

<b>GIS ID *</b> 902483	<b>Parcel</b> 42	<b>Parcel Area</b> 3.1	<b>Land Value</b> 316500	<b>Improved Value</b> 759300	<b>Exemption Value</b> 442800	<b>Plan Area</b> RURAL
---------------------------	---------------------	---------------------------	-----------------------------	---------------------------------	----------------------------------	---------------------------

**Legal Description**  
IMPSLOT 14 3.1051 A[ ]3264 STARTING GATE CT[ ]CABIN BRANCH FARM

[check spelling](#)

<b>Block</b>	<b>Lot</b> 14	<b>Census Tract</b> 605601	<b>Council Dist</b> 5	<b>Inspection Dist</b>	<b>Supervisor Dist</b>	<b>Map #</b>	<b>DAP Zone</b>
<b>Plan Area</b>	<b>State Tax Id</b> 1404353838	<b>Subdivision Name</b> CABIN BRANCH FARM					
<b>Section</b>	<b>Area</b>	<b>Tax Map</b> 13					
<b>Grid</b> 13-20	<b>Zoning District</b> RC-DEO	<b>ADC Map</b> 4811-B5					
<b>SDP No.</b>	<b>Final Plan No.</b>	<b>WP File No.</b>					
<b>Record Plat No.</b> 10477	<b>WS Contract No.</b>	<b>FDP No.</b>					
<b>Owner Occupied</b> <input type="radio"/> Yes <input type="radio"/> No	<b>Year Built</b> 1994	<b>Historic District</b> <input type="radio"/> Yes <input checked="" type="radio"/> No					
<b>Historic District Registry No.</b>	<b>Stat Area</b> 4-07	<b>Flood Plain</b> <input type="radio"/> Yes <input checked="" type="radio"/> No					
<b>Building No</b>							

Owner \* (This section is required.)

Search Reset Clear

**Name \***  
DODGI

**Address Line 1**  
3264 STARTING GATE CT

**Address Line 2**

**Address Line 3**

**Mail City**  
 WOODBINE  
**Mail State**  
 MD  
**Mail Zip Code**  
 21797  
**Phone**  
 301-725-3232  
**Primary**  
 Yes  
**E-mail**  
  
**Cell Number**      **Fax Number**

**Professionals** (This section is not required.)

**License # \*** 68408      **Business Name** HJ POIST  
**License Type \*** Propane Gs      **First Name** JEFF      **Middle Name**      **Last Name** WISEMAN  
**Primary** Yes      **Address Line 1** 360 MAIN ST  
**Address Line 2**  
**City** LAUREN      **State** MD      **ZIP Code** 20707  
**Phone 1** 3017253232      **Phone 2**      **Fax**  
**E-mail** JEFF@HJPOIST.COM

**Applicant** (This section is not required.)

Search    As Owner    As Lic. Prof    As Contact

**Type \*** Applicant      **First Name** MICHELLE      **MI**      **Last Name** CLANCY  
**Relationship** Applicant      **Full Name** MICHELLE CLANCY  
**Primary** Yes      **Organization Name** APPLIED & APPROVED PERMITS LLC  
**Street Address** P.O. BOX 310  
**Address Line 2**  
**City** PERRY HALL      **State** MD      **Zip Code** 21128  
**Phone** 443-340-1229      **Cell**      **Fax**  
**E-mail \*** MICHELLE@APPLIEDANDAPPROVED.COM

**Addtl Info**


**Est Construction Cost \*** 500      **Housing Units \*** 0      **Number of Buildings \*** 0      **Public Owned** No  
**Construction Type** 649 - All Other Buildings and Structures

**TANK INFORMATION**

**RESIDENTIAL TANK INFORMATION**

**Capital Project-No Fee \***  Yes  No      **Capital Project Number** (Text)      **Fee Exempt \***  Yes  No      **Roadside Tree Project Permit \***  Yes  No      **Roadside Tree Permit #** (Text)  
**Existing Use \*** SFD      **Number of Tanks Installed \*** 1 (Number)      **Number of Tanks Removed \*** 0 (Number)

3264 STAI  
WOOL  
LOT 14 C/1  
HOV  
TYTC

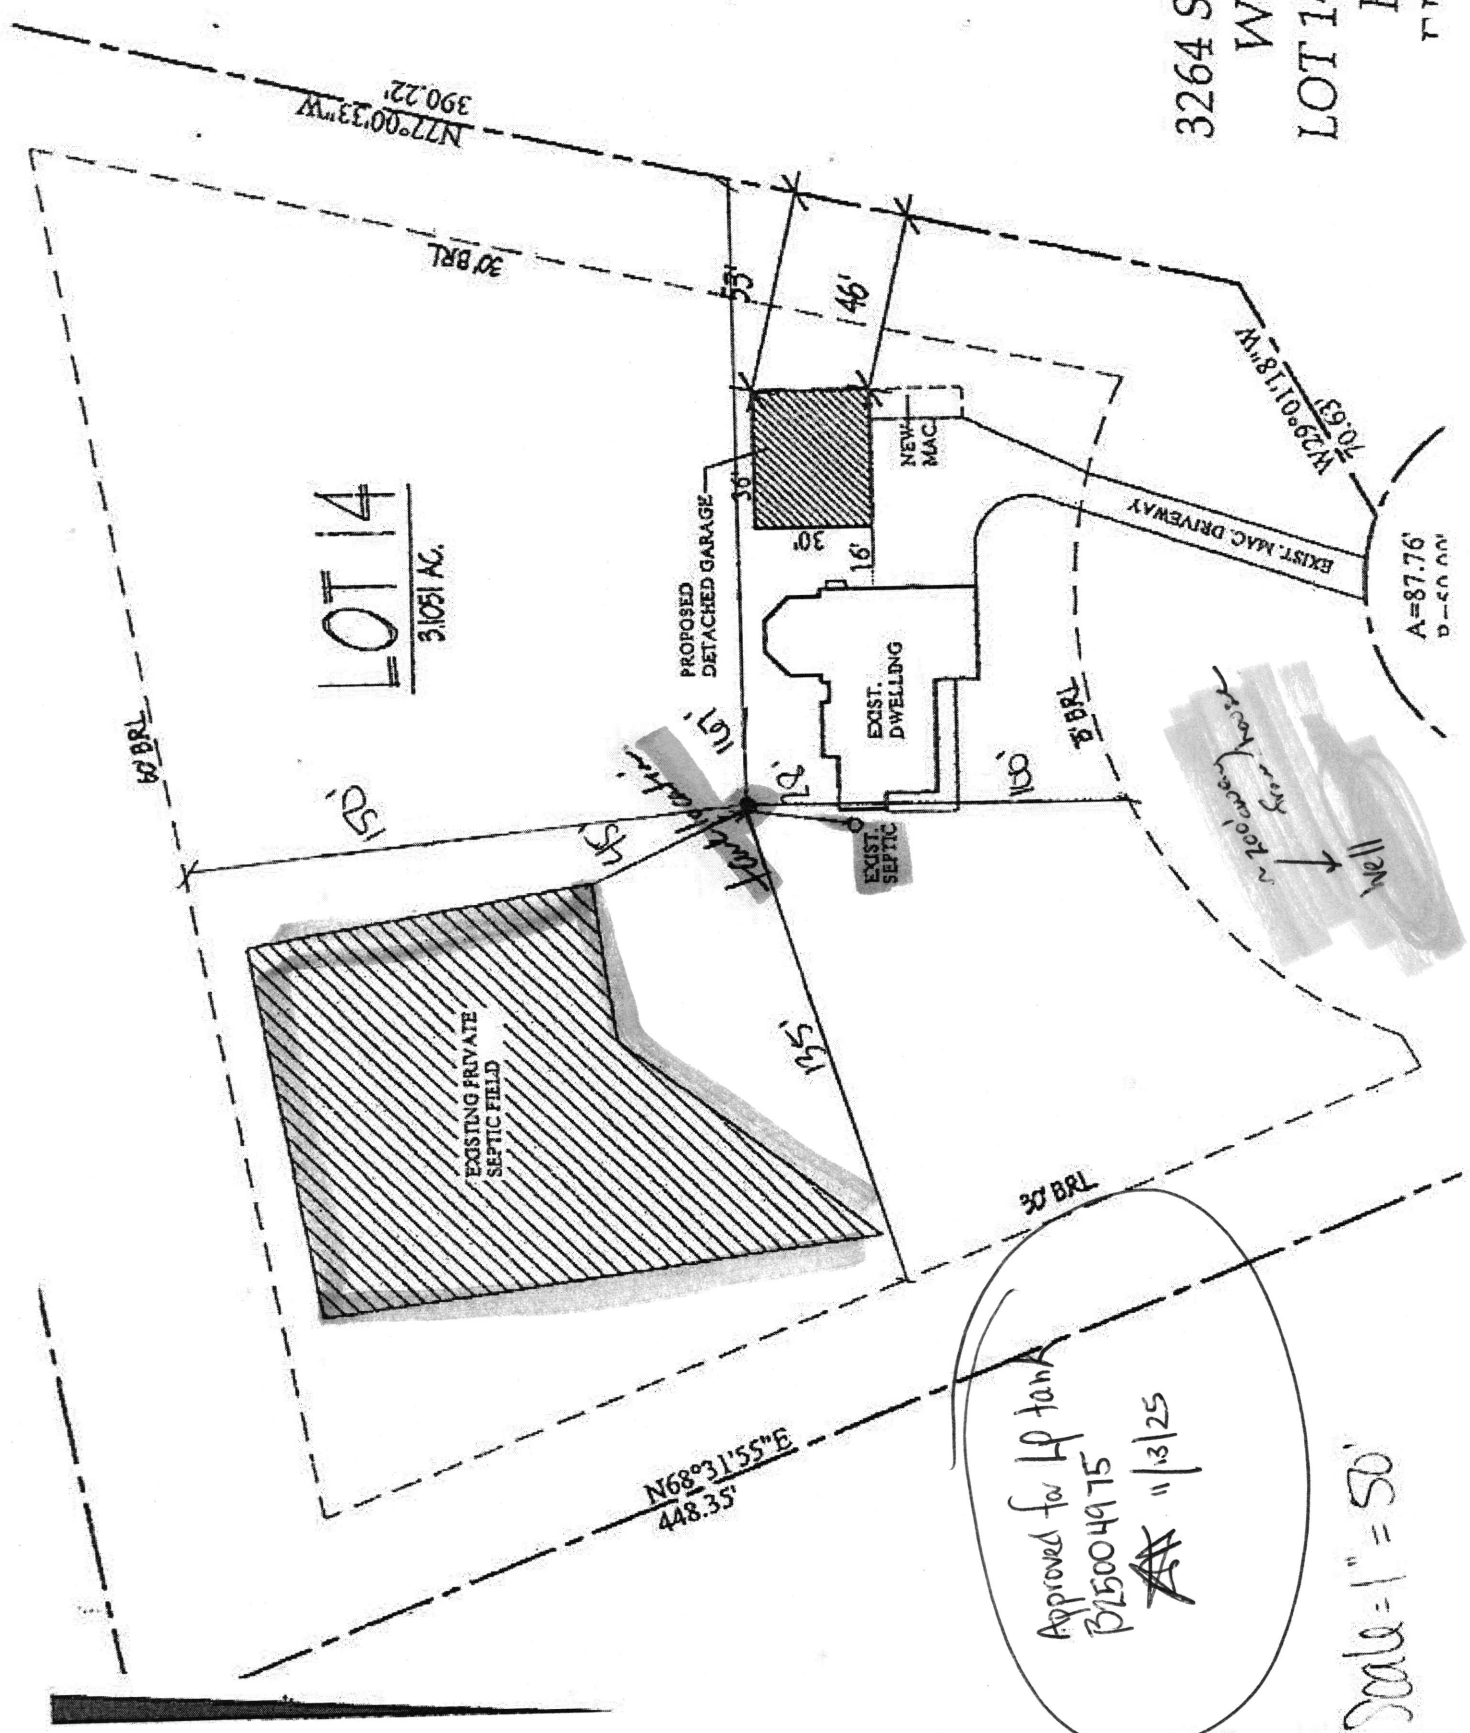


LOT 14  
31051 AC.

Approved for HP tank  
B25004915  
11/3/25

Scale = 1" = 50'



## UNDERGROUND PROPANE STORAGE TANKS 120 - 1000 Gallons

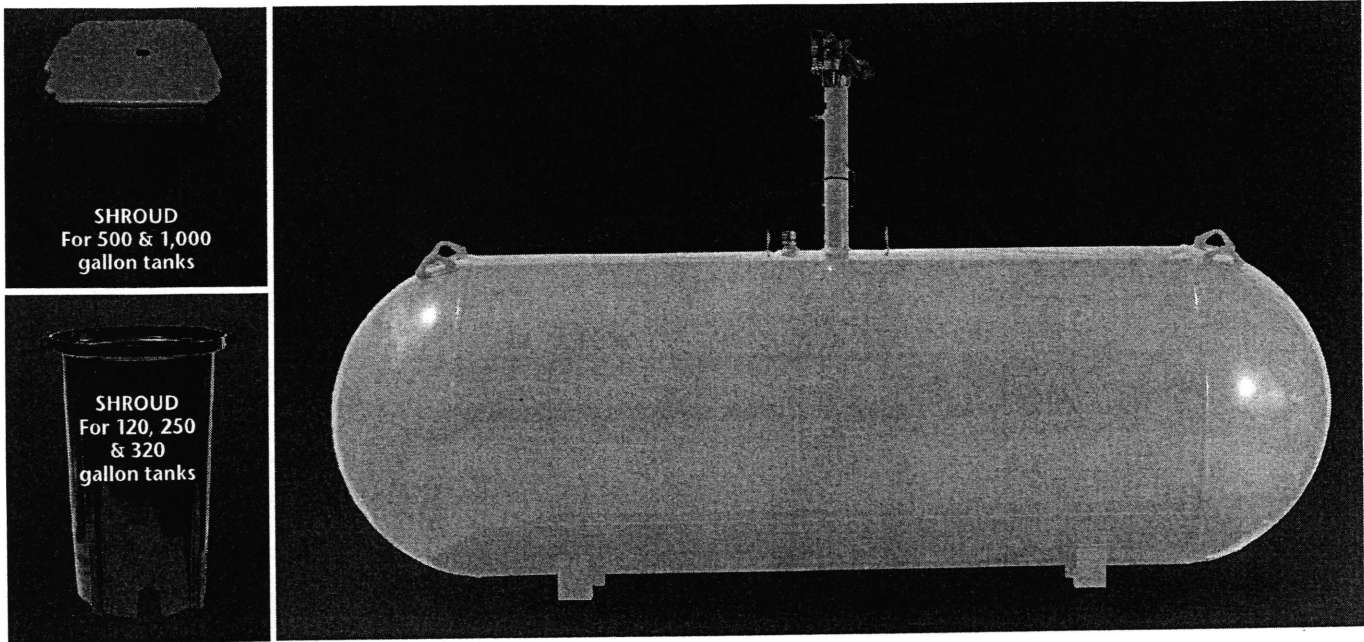

SHROUD  
For 500 & 1,000  
gallon tanks

SHROUD  
For 120, 250  
& 320  
gallon tanks

### PRESSURE VESSEL CODES & REGISTRATION

- Designed and constructed in accordance with the ASME Section VIII, Division 1 Code
- Registered with the National Board of Boiler & Pressure Vessels Inspectors
- Complies with NFPA 58
- Conforms to specifications set forth by the Railroad Commission of Texas

### PAINT SPECIFICATIONS

- Epoxy powder paint for maximum rust protection
- Tanks painted gray
- Ready to bury durable epoxy powder coating†

### SHROUD FEATURES (500 & 1,000 gallon)

- Durable construction
- Large opening for easy filling and maintenance
- Recessed markers to indicate proper burial depth
- Permanent hole for mounting location flag
- Access on sides for flexible riser connection
- New shroud available for 500 gallon and 1,000 gallon UG tanks, shroud dimensions:
  - \* Shroud for long riser 32 3/16" X 26 5/16"
  - \* Shroud for short riser 19 3/8" X 26 5/16"

### VESSEL FEATURES

- Tanks fully fitted with RegO valves and Rochester liquid level gauges
- Container pressure rated at 250 PSI @ 400°F
- Vacuum purged
- Duplicate data plate is zip tied on the riser pipe below the anode bolt connection for convenience
- Product is offered with 14" short or 28" tall risers
- Anode bolt connection located under the dome
- Short or tall plastic shroud assemblies (w/lid) supplied accordingly
- #54 liquid level outage valve orifice


### PROCESS CONTROL

All welded products are x-rayed and pressure tested @ 325 PSI per ASME Sec VIII, Div 1 requirements, followed by rigorous leak test inspections, both pre and post valving

### STORAGE & DISTRIBUTION

Contact Propane Education & Research Council for additional resources and information at [propane.com](http://propane.com)

Made With Pride

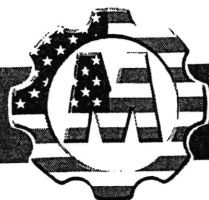

Made In the U.S.A.






## UNDERGROUND PROPANE STORAGE TANKS 120 - 1000 Gallons


### UNDERGROUND VESSEL DIMENSIONS & SPECIFICATIONS

(All Vessel Dimensions are Approximate)

Part Number	Description	Water Capacity Gal/l	Outside Diameter In/mm	Head Type	Overall Length In/mm	Overall Riser Height In/mm		Leg Width In/mm	Leg Spacing In/mm	Weight Lbs/kg	Quantity	
						18" Riser	28" Riser				Full Load	Per Stack
68289	120 Gallon Underground LR Storage Tank	120 454.2	24" 609.6	Ellip	5' 8" 1727.2	-	4' 7 13/16" 1417.6	10 1/8" 257.2	3' 0" 914.4	342 155.4	63	9
68269	120 Gallon Underground SR Storage Tank	120 454.2	24" 609.6	Ellip	5' 8" 1727.2	3' 9 1/4" 1149.4	-	10 1/8" 257.2	3' 6" 914.4	329 149.2	72	9
68288	250 Gallon Underground LR Storage Tank	250 946.3	30" 762	Hemi	7' 10" 2387.6	-	5' 1 9/16" 1563.7	12 3/4" 323.9	3' 6" 1066.8	494 224.1	42	7
68271	250 Gallon Underground SR Storage Tank	250 946.3	30" 762	Hemi	7' 10" 2387.6	4' 3" 1295.4	-	12 3/4" 323.9	3' 6" 1066.8	480 217.7	42	7
68273	320 Gallon Underground LR Storage Tank	320 1211.3	30" 762	Hemi	9' 7" 2921	-	5' 1 9/16" 1563.7	12 3/4" 323.9	4' 0 1/4" 1225.6	597 270.8	35	7
68285	320 Gallon Underground SR Storage Tank	320 1211.3	30" 762	Hemi	9' 7" 2921	4' 3" 1295.4	-	12 3/4" 323.9	4' 0 1/4" 1225.6	593 269	35	7
68275	500 Gallon Underground LR Storage Tank	500 1892.7	37.5" 952.5	Hemi	9' 10" 2997.2	-	5' 9 3/8" 1762.1	15" 381	5' 0" 1524	953 432.3	25	5
68286	500 Gallon Underground SR Storage Tank	500 1892.7	37.5" 952.5	Hemi	9' 10" 2997.2	4' 8 1/2" 1435.1	-	15" 381	5' 0" 1524	949 430.5	25	5
68277	1000 Gallon Underground LR Storage Tank	1000 3785.4	41" 1041.4	Hemi	15' 11" 4851.4	-	6' 3/16" 1849.4	16 1/4" 412.8	9' 0" 2743.2	1812 821.9	12	4
68287	1000 Gallon Underground SR Storage Tank	1000 3785.4	41" 1041.4	Hemi	15' 11" 4851.4	5' 0" 1524	-	16 1/4" 412.8	9' 0" 2743.2	1793 813.3	12	4

† Federal, state or local regulations may contain specific applicable requirements for protective coatings and cathodic protection. The purchaser and installer are responsible for compliance with such federal, state, local and NFPA industry regulations, including, but not limited to, proper purging prior to putting into service. Cathodic protection is required. Coating(s) must be continuous, uninterrupted and must comply with local, state or national codes or regulations.

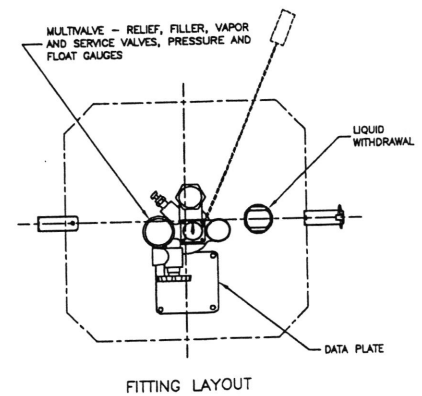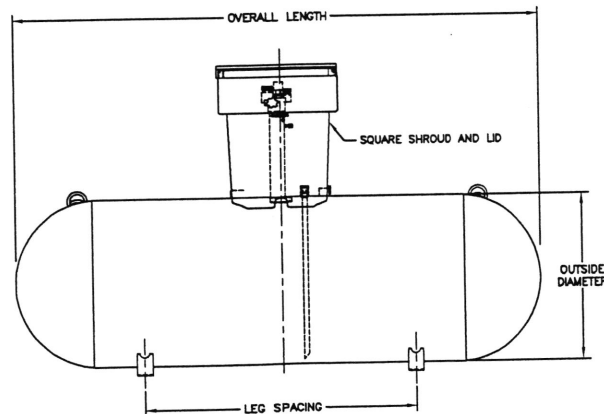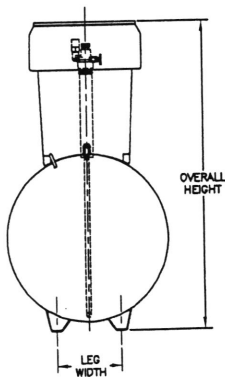

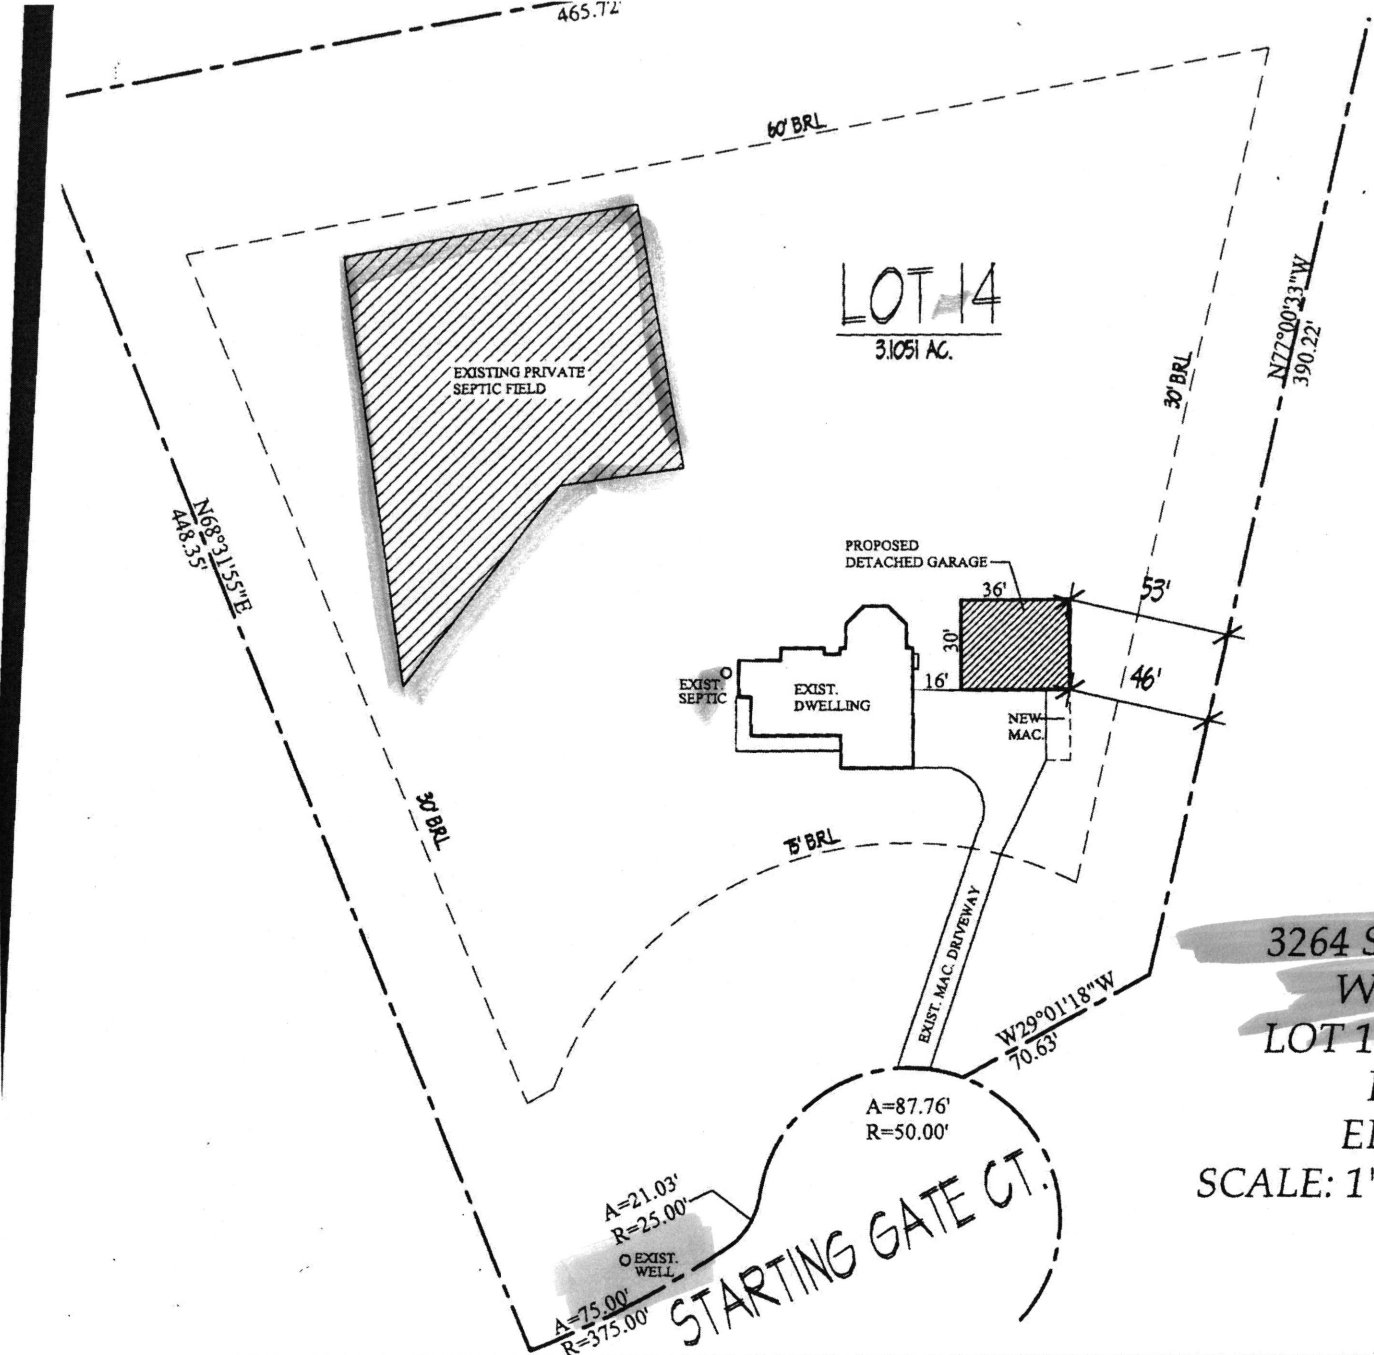

**LOT 14**  
3.1051 AC.

EXISTING PRIVATE SEPTIC FIELD

PROPOSED DETACHED GARAGE


EXIST. SEPTIC

EXIST. DWELLING

NEW MAC.


EXIST. MAC. DRIVEWAY

STARTING GATE CT.

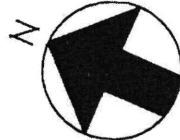

3264 STARTING GATE COURT  
 WOODBINE, MD 21797  
 LOT 14 CABIN BRANCH FARM  
 HOWARD COUNTY  
 ELECTION DISTRICT 4  
 SCALE: 1"=60'    DATE: JUNE 19, 2014

SITE PLAN

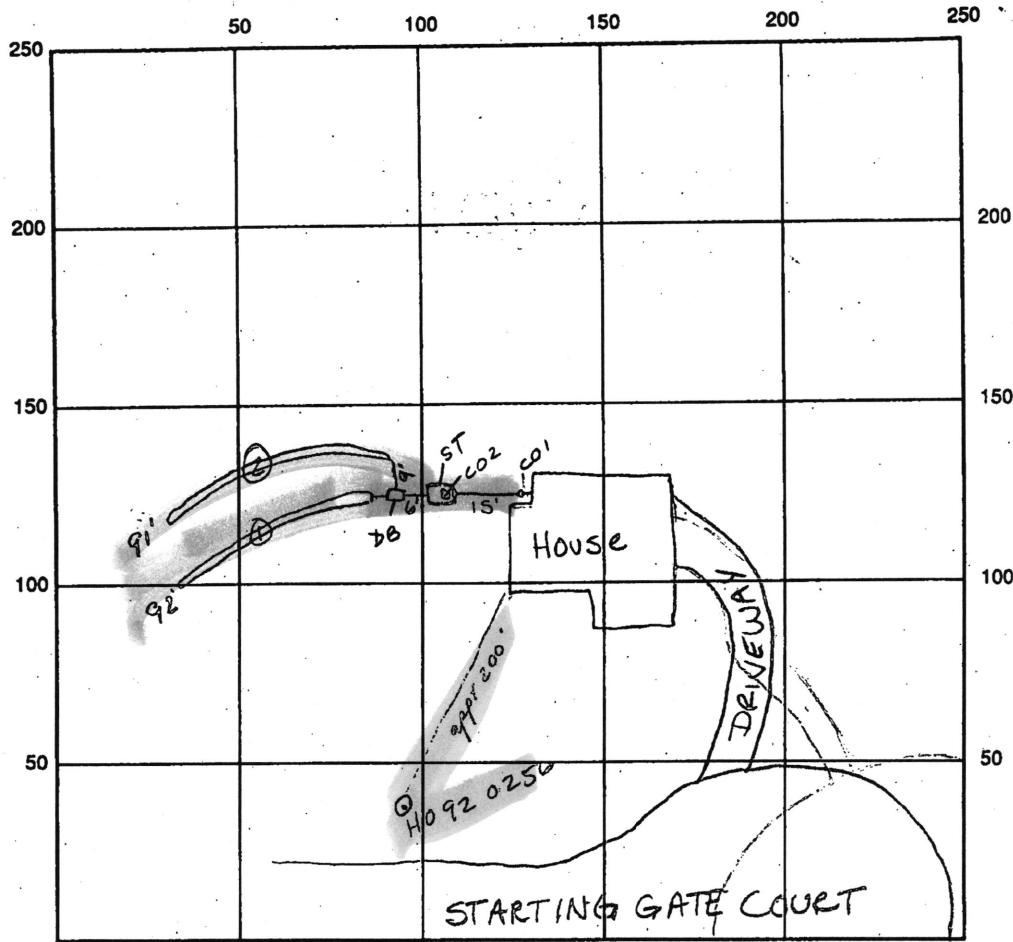

INDICATE NORTH - NAME ADJOINING ROADWAY AS BASE LINE

SEPTIC TANK LEVEL 1000 gne OK CLEANOUTS #1 OK #2 OK

DISTRIBUTION BOX LEVEL OK Daffle IS IN

DRAIN FIELD/TITLE DEPTH 5' FT. TRENCH WIDTH 3' FT. INLET DEPTH 3' FT.

EFFECTIVE GRAVEL DEPTH 2' FT. TOTAL LENGTH ①92 = 183' total  
②91 = 183' total FT.

NUMBER OF TRENCHES 2 ONE SIDEWALL/BOTTOM AREA 549 SQ. FT.  $\frac{183^2}{3}$

DRYWALL INSIDE DIAMETER      FT. EFFECTIVE DEPTH BELOW INLET      FT.

ABSORBENT AREA      SQ. FT.

REMARKS: 12/17/93 OK to cover all work. No house connection ALM

1/26/94 House connection made ALM

12/28/93 WPI OK to cover ALM

DATE SYSTEM APPROVED 1/26/94 INSPECTOR A. McMullen