

\*\*\*\*\*  
 WATER WELL ABANDONMENT-SEALING REPORT FORM  
 \*\*\*\*\*

SUBMIT COPIES OF COMPLETED FORM TO:

- \* COUNTY ENVIRONMENTAL AGENCY (contact MDE, WMA if address needed)
- \* WELL OWNER
- \* MDE, WATER MANAGEMENT ADMINISTRATION, WELL PROGRAM

PK 6K  
 12/4/14

DATE WELL ABANDONED: 10-29-14 (month/day/year)

\* PERMIT NUMBER OF ABANDONED WELL (if any) \_\_\_\_\_

\* PERMIT NUMBER OF REPLACEMENT WELL: \_\_\_\_\_


\* PERSON ABANDONING WELL: Allen Gington WELL DRILLER'S LICENSE NUMBER: 009

CIRCLE: MWD / MSD / MGD

\* OWNER'S NAME: John McDaniel

\* WELL LOCATION:  
 COUNTY: Howard  
 NEAREST TOWN: Highland  
 TAX MAP 34 BLOCK 122 PARCEL 401  
 SUBDIVISION: McDaniel PRO.  
 SECTION: \_\_\_\_\_ LOT: 3  
 STREET ADDRESS: 13032 Highland rd

SITE LOCATION MAP

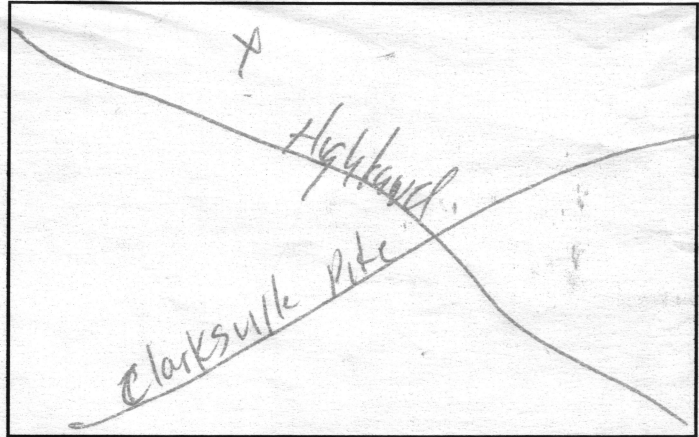

LATITUDE 3 9.185287

LONGITUDE 7 6.964859

- \* TYPE OF WELL BEING ABANDONED:  
 DRILLED                       JETTED  
 BORED                               HAND DUG  
 OTHER (specify) Drill hole

LOG OF SEALING MATERIAL

MATERIAL	FEET	
	FROM	TO
<u>cement</u>	<u>0</u>	<u>69</u>
<u>stone</u>	<u>69</u>	<u>300</u>
VOLUME OF MATERIAL USED		
<u>1 yard</u>		

- \* USE CODE:  
 DOMESTIC                       MUNICIPAL/PUBLIC  
 IRRIGATION                       INDUSTRIAL  
 TEST/OBSERVATION               GEOTHERMAL

- \* TYPE OF CASING:  
 STEEL                               PLASTIC  
 CONCRETE                       OTHER (specify) \_\_\_\_\_

SIZE OF CASING: 6 INCHES IN DIAMETER

DEPTH OF WELL: 300 FEET DEEP

WAS ANY CASING REMOVED?  YES  NO  
 If yes, length removed, in feet: 2

WAS CASING RIPPED OR PERFORATED?  YES  NO

Allen Gington 009  
 SIGNATURE-MASTER WELL DRILLER OR SUPERVISING SANITARIAN LICENSE#

MWD / MSD / MGS

CIRCLE ONE

11-18-14  
 DATE

\*\*\*\*\*  
 WATER WELL ABANDONMENT-SEALING REPORT FORM  
 \*\*\*\*\*

SUBMIT COPIES OF COMPLETED FORM TO:

- \* COUNTY ENVIRONMENTAL AGENCY (contact MDE, WMA if address needed)
- \* WELL OWNER
- \* MDE, WATER MANAGEMENT ADMINISTRATION, WELL PROGRAM

DR 12/4/14  
 DK

DATE WELL ABANDONED: 10-29-14 (month/day/year)

\* PERMIT NUMBER OF ABANDONED WELL (if any) \_\_\_\_\_


\* PERMIT NUMBER OF REPLACEMENT WELL: \_\_\_\_\_

\* PERSON ABANDONING WELL: Allen Ampton WELL DRILLER'S LICENSE NUMBER: 009

\* OWNER'S NAME: John McDaniel CIRCLE: MWD / MSD / MGD

\* WELL LOCATION:  
 COUNTY: Howard  
 NEAREST TOWN: Highland  
 TAX MAP 34 BLOCK 22 PARCEL 401  
 SUBDIVISION: McDaniel prop.  
 SECTION: \_\_\_\_\_ LOT: 3  
 STREET ADDRESS: 13032 Highland rd

SITE LOCATION MAP

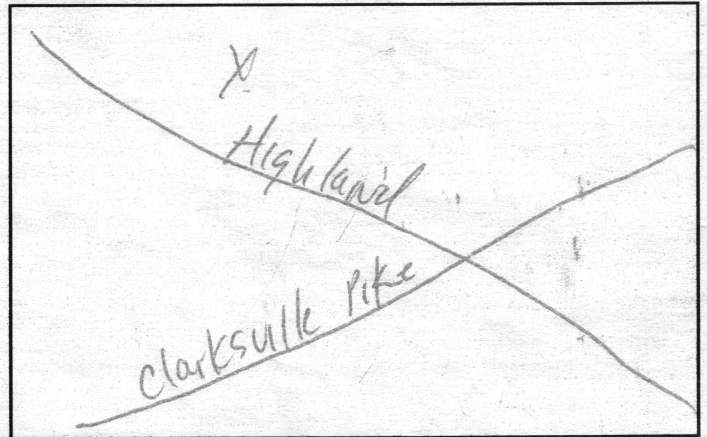

LATITUDE 3 9 . 1 8 6 1 5

LONGITUDE 7 6 . 9 6 5 9 1 9

- \* TYPE OF WELL BEING ABANDONED:  
 DRILLED  JETTED  
 BORED  HAND DUG  
 OTHER (specify) Dry hole

LOG OF SEALING MATERIAL

- \* USE CODE:  
 DOMESTIC  MUNICIPAL/PUBLIC  
 IRRIGATION  INDUSTRIAL  
 TEST/OBSERVATION  GEOTHERMAL

- \* TYPE OF CASING:  
 STEEL  PLASTIC  
 CONCRETE  OTHER (specify) \_\_\_\_\_

MATERIAL	FEET	
	FROM	TO
<u>Cement</u>	<u>0</u>	<u>63</u>
<u>Stone</u>	<u>63</u>	<u>500</u>

SIZE OF CASING: 6 INCHES IN DIAMETER

DEPTH OF WELL: 500 FEET DEEP

WAS ANY CASING REMOVED?  YES  NO  
 If yes, length removed, in feet: 2

WAS CASING RIPPED OR PERFORATED?  YES  NO

SIGNATURE-MASTER WELL DRILLER OR SUPERVISING SANITARIAN Allen Ampton LICENSE# 009

MWD / MSD / MGS 009 CIRCLE ONE  
 DATE 11-18-14