

Maura J. Rossman, M.D., Health Officer

Bureau of Environmental Health
8930 Stanford Boulevard, Columbia, MD 21045
Main: 410-313-2640 | Fax: 410-313-2648
TDD 410-313-2323 | Toll Free 1-866-313-6300
www.hchealth.org
Facebook: www.facebook.com/hocohealth

RECEIPT DATE: 2/3/2026 ONSITE SEWAGE DISPOSAL SYSTEM P 5-90333

APPROVAL DATE: 2/13/2026 PERMIT: REPAIR A

PROPERTY ADDRESS: 860 Hoods Mill Rd (RT 97), Woodbine MD 21723

SUBDIVISION: LOT: TAX ID: 04-342038

CONTRACTOR: Fogle's Septic Clean EMAIL: john@foglesinc.com

CONTRACTOR ADDRESS: 580 Obrecht Rd, Sykesville, MD 21784 PHONE: 410-798-5670

PROPERTY OWNER: George Biersdorf EMAIL: gtbiere@aol.com

OWNER ADDRESS: 860 Hoods Mill Rd (RT 97), Woodbine MD 21723 PHONE: 410-935-5618

SEPTIC TANK SIZE (GALLONS): Ex 1000 TANK MANUFACTURER: Existing

PUMP MODEL: N/A PUMP SIZE N/A PUMP TANK CAPACITY: N/A

DISTRIBUTION SYSTEM: [X] GRAVITY [ ] PRESSURE DOSED BEDROOMS: 3 APPLICATION RATE: 1.2


Table with 2 columns: Field Name (TRENCHES, LOCATION, NOTES) and Field Value (Linear feet required, trench width, location plan, notes on trench and drywell).

ISSUED BY: S. Page ISSUE DATE: 2/3/2026 EXPIRATION DATE: 2/3/2027

- NOTE: CONTRACTOR MUST SCHEDULE A PRE-CONSTRUCTION INSPECTION PRIOR TO BEGINNING ANY INSTALLATION
NOTE: CONTRACTOR MUST SCHEDULE AN INSPECTION AND GAIN APPROVAL OF ALL COMPONENTS PRIOR TO COVERING
NOTE: STONE MUST BE APPROVED BY HEALTH DEPARTMENT AND GRAVEL TICKET MUST BE AVAILABLE FOR REVIEW.
NOTE: WATERTIGHT TANKS REQUIRED
NOTE: ALL PARTS OF SEPTIC SYSTEM SHALL BE AT LEAST 100 FEET DOWNGRADIENT FROM ANY WATER WELL
NOTE: MANHOLE RISERS REQUIRED ON ALL SEPTIC TANKS AND PUMP CHAMBERS
NOTE: AN ELECTRICAL PERMIT IS REQUIRED FOR INSTALLATION OF ANY ELECTRICAL COMPONENTS OF THE SYSTEM
[X] ELECTRICAL PERMIT ISSUED E N/A
NOTE: MDE RECOMMENDS SEPTIC TANKS, BAT, AND OTHER PRETREATMENT UNITS BE PUMPED AT A FREQUENCY ADEQUATE TO ENSURE THAT SOLIDS ARE NOT DISCHARGED TO THE DISPOSAL AREA

NEITHER THE HOWARD COUNTY COUNCIL NOR THE HEALTH DEPARTMENT IS RESPONSIBLE FOR THE SUCCESSFUL OPERATION OF ANY SYSTEM.
PERMITTEE RESPONSIBLE FOR OBTAINING FINAL APPROVAL ON THIS PERMIT.
CALL 410-313-1771 TO SCHEDULE INSPECTIONS.

NOT TO SCALE

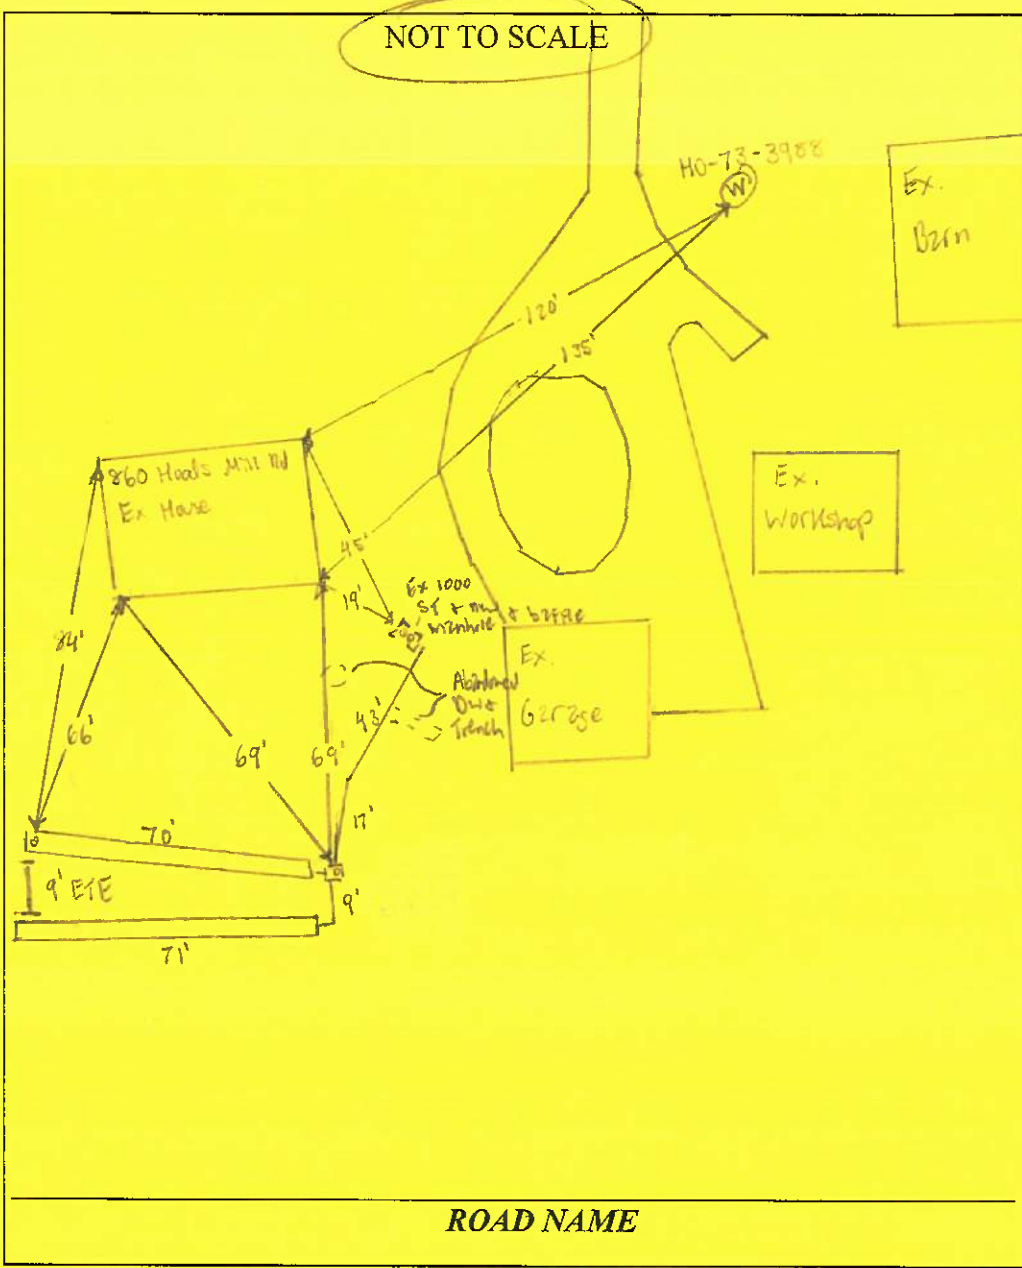

ROAD NAME

**TRENCH/DRAINFIELD DATA**

WIDTH	INLET	BOTTOM
2'	3'	7'
NUMBER OF TRENCHES		2
TOTAL LENGTH		141'
ABSORPTION AREA		282 ft <sup>2</sup> @ 6" W
DISTRIBUTION BOX LEVEL		YES
DISTRIBUTION BOX BAFFLE		YES
DISTRIBUTION BOX PORT		YES

Existing:

**SEPTIC TANK DATA**

SEPTIC TANK 1 LEVEL	N/A
MANUFACTURER	
CAPACITY	GAL
SEAM LOC	
TANK LID DEPTH	3'
BAFFLES	New 9" back baffles
BAFFLE FILTER	
MANHOLE LOC	New back riser
6" PORT LOC	Ex 6" port
WATERTIGHT TEST	
SLOTTED	
DATE ON LID	

**PUMP/SEPTIC TANK LEVEL**

MANUFACTURER	
CAPACITY	GAL
SEAM LOC	
TANK LID DEPTH	
BAFFLES	
BAFFLE FILTER	
MANHOLE LOC	
6" PORT LOC	
WATERTIGHT TEST	
SLOTTED	
DATE ON LID	

SEPTIC CONTRACTOR ONSITE INSTALLING SYTEM: Mike Hoopes  
SEPTIC CONTRACTOR ONSITE LICENSED WITH THE STATE OF MD: YES/NO

**PRE-CONSTRUCTION NOTES:**

7/3/2026--Plans Approved. (SP)


**CONTROL PANEL DATA**

CONTROL PANEL HEIGHT (MIN 30")	N/A
INSPECTION DATE	N/A
INSPECTION: PASS/FAIL (CIRCLE ONE)	

**INSTALLATION NOTES:**

- 2/11/2026 - Engle's septic clean manhole to pump ss, no well pumped out 2 weeks prior & still dry. No. 1000 manhole filter installed on tank. (SP)
- 2/23/2026 - Installer made per PM inspection and said no. No. needed to new drive upper trench installed & connected. Length @ 70', inlet @ 3' & lower trench bottom exposed 7' deep per PM. connected to 1/4" d. box & inlet lower trench. (SP)
- 2/23/2026 - Installer made per PM inspection. Lower trench fit and ETE 9'-8.5'. Length @ 71', inlet @ 3', stone & fabric ok. 0-Box leveled while on-site. on to Backfill. (SP)

FINAL INSPECTOR S. Price DATE OF APPROVAL 2/13/2026

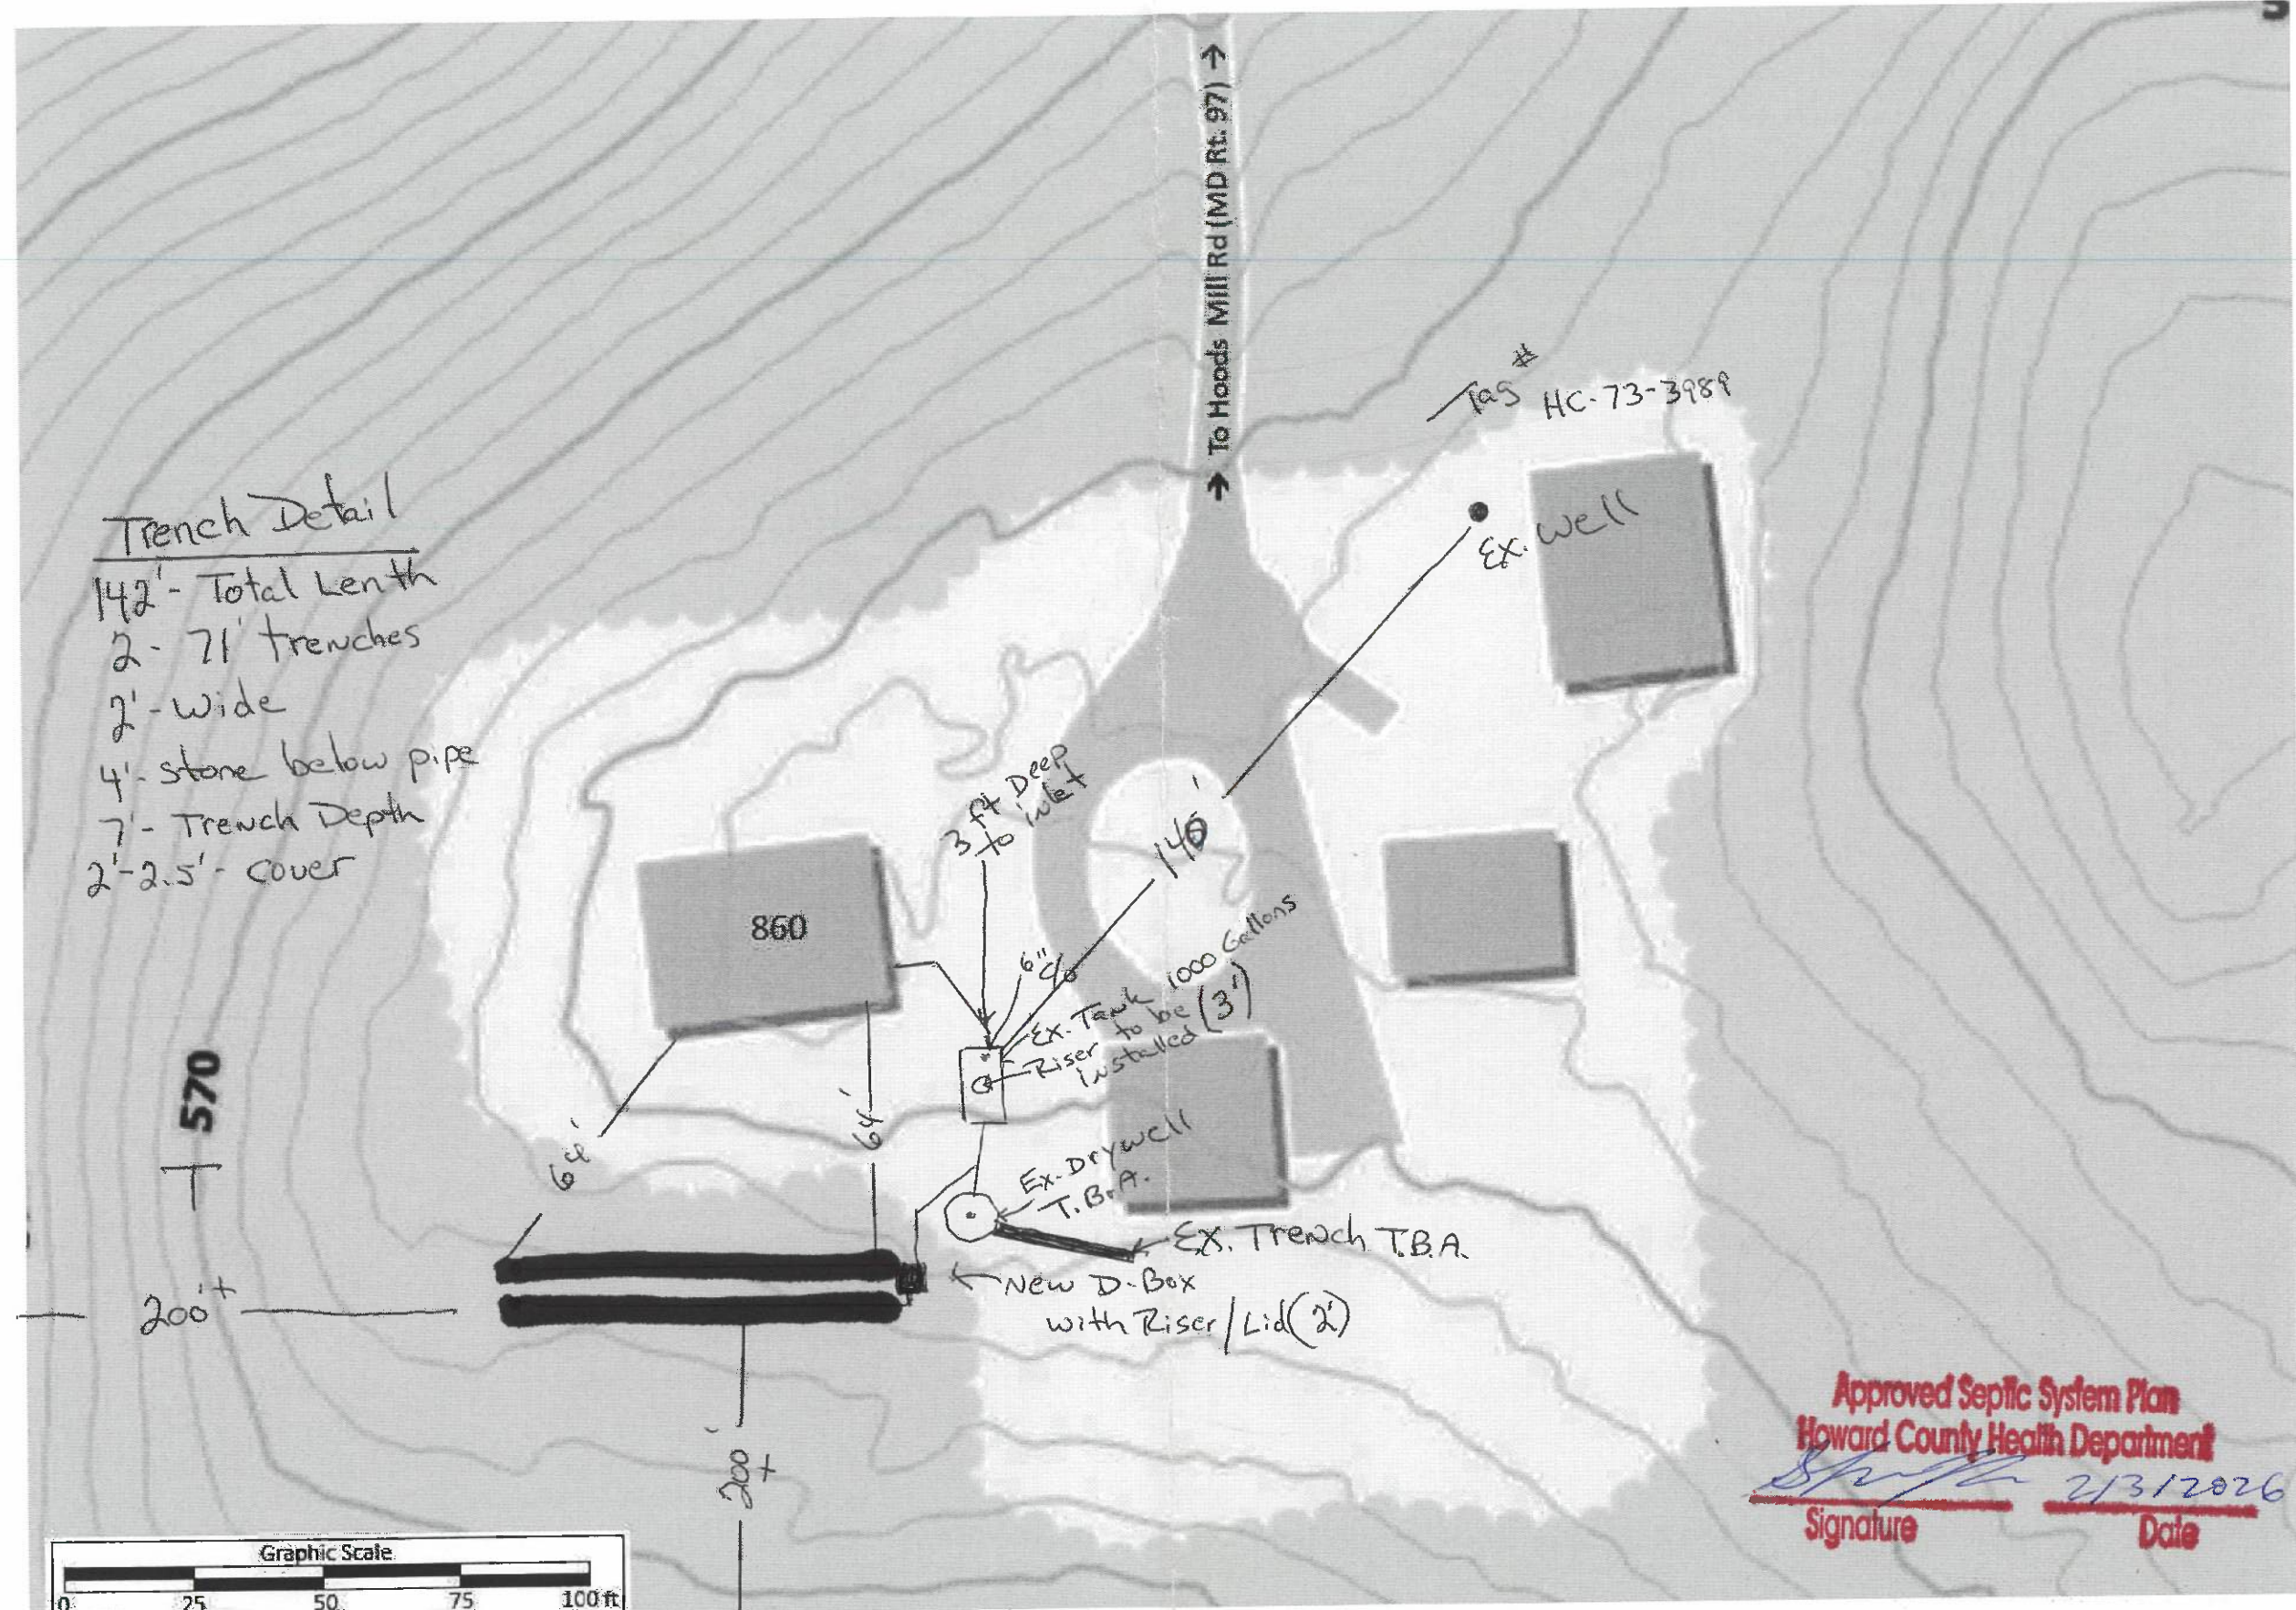


**Trench Detail**  
 142' - Total Length  
 2 - 71' trenches  
 2' - Wide  
 4' - stone below pipe  
 7' - Trench Depth  
 2'-2.5' - cover

Approved Septic System Plan  
 Howard County Health Department  
 Signature \_\_\_\_\_ Date 2/3/2026



**Septic Repair Design Plan**

Designer & Installer Info		Property Info	Owner Info	Additional Info		
	Installer: Fogle's Septic Clean, Inc Address: 580 Obrecht Rd Sykesville, MD 21784	Designer: John Heatzman Phone: 410-795-5670 Email: john@foglesinc.com	Address: 860 MD Route 97 Cooksville, MD 21723	Name: George Biersdorf Phone: 410-935-5618 Email: gtbiere@aol.com	Perc Date: 1/15/26 Permit No.: Bedrooms: 3	Version: 1.0 Date: Job No.: 1018