

1/16/76

*As soon as possible
Need to see house -> ST conn. with*

Ho 73 1133

PERMIT

P 21756
A 21692

SEWAGE DISPOSAL SYSTEM

MARYLAND STATE DEPARTMENT OF HEALTH

HOWARD COUNTY

ELLICOTT CITY

*1/17/78 Installed, not approved. House to ST connection
not made or seen at final instpt. WWS.*

DISTRICT 3rd

DATE 7/2/75

INDEXED

Jack Fyock _____ IS PERMITTED TO INSTALL ALTER _____

ADDRESS Ten Oaks Road, Glenelg, Md. _____ PHONE 286-2939 _____

A SEWAGE DISPOSAL SYSTEM LOCATED AT _____

SUBDIVISION _____ ROAD 13190 Folly Quarter Road _____ LOT _____

PROPERTY OWNER James F. Trail _____

ADDRESS Howard Road, Dayton, Maryland _____ Phone: 286-3751 _____

SPECIFICATIONS 3 bedrooms

DRAIN FIELD _____ DEPTH _____ FEET, BOTTOM AREA _____ SQ. FT.

SEEPAGE PITS _____ ABSORBENT SIDE-WALL AREA _____ SQ. FT.

SEPTIC TANK CAPACITY 1000 GALLONS

FOR GARBAGE GRINDER, INCREASE DISPOSAL AREA 22% & TANK CAPACITY 50%.

OTHER TRENCH - 100 ft. long - $1\frac{1}{2}$ ft. wide and 7 ft. deep - filled with 4 ft. of stone. Place the ditch between 10 ft. and 15 ft. from the back lot line and between 10 ft. and 110 ft. from the left side of the lot as seen when facing the lot from Folly Quarter Road. Two inspections of deep ditch are needed (1) before stone is added and (2) one after stone added. A sewage lift pump is needed for the job.

NOTE: ALL PIPE FROM HOUSE TO DISPOSAL AREA MUST BE CAST IRON.

PERMIT VOID AFTER THREE YEARS.

NOTE: INSTALL STAND PIPE ON SEPTIC TANK. STAND PIPES MUST BE 6 INCHES IN DIAMETER.

CAST IRON, CONCRETE OR TERRA COTTA ACCEPTED.

PLANS APPROVED BY Raymond Hodges & Donald W. Monaghan DATE 9/29/75

FILL SEPTIC TANK AND DISTRIBUTION BOX WITH WATER BEFORE CALLING FOR AN INSPECTION. COVER NO WORK UNTIL INSPECTED AND APPROVED.

NEITHER THE HOWARD COUNTY COMMISSIONERS NOR THE HEALTH DEPARTMENT IS RESPONSIBLE FOR THE SUCCESSFUL OPERATION OF ANY SYSTEM.

DRILLED well
Ho 73-1133.


300' 16.P.M

DRILLED STATIC 30'
-> SEPT 75

~~DUG WELL 40' FROM SHINGLED FRAME HOUSE
WELL PIT IMPROPERLY PROTECTED
50' WELL UPHILL DW.
NO ONE HOME TO CONDUCT WATER TEST
4-27-83 CW~~

21692

216.92

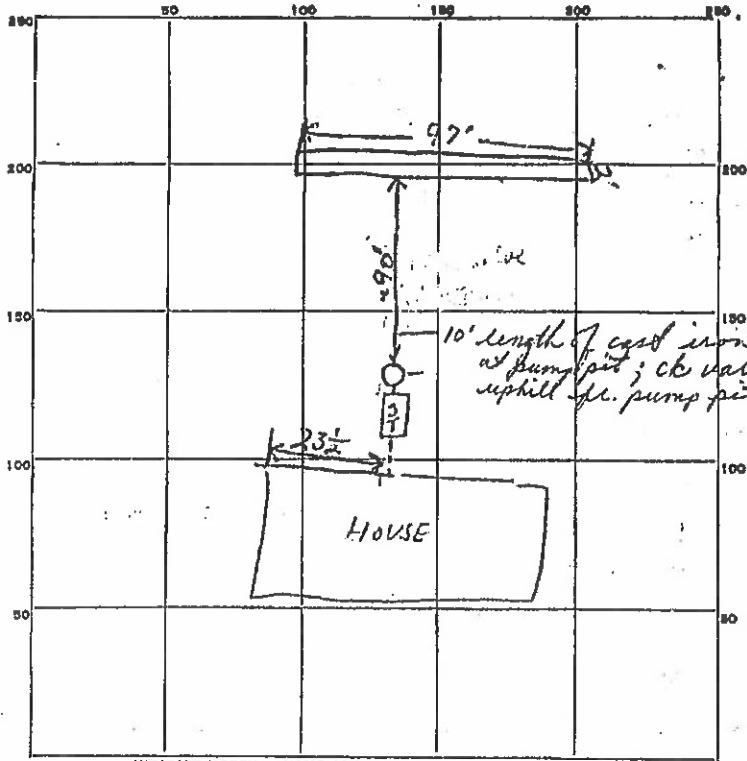

INDICATE NORTH - NAME ADJOINING ROADWAY AS BASE LINE.

FOLLY QUARTER RD

PERMIT CARD none seen

SEPTIC TANK, LEVEL 1000 gal CLEANOUTS ST ✓

DISTRIBUTION BOX, LEVEL _____

TILE FIELD, DEPTH _____ FT. TRENCH WIDTH 2 1/2 FT.

GRAVEL DEPTH 4-4 1/2 IN. TOTAL LENGTH 97' FT.

NUMBER OF TRENCHES 1 TOTAL SIDEWALL BOTTOM AREA 412 ✓

SEEPAGE PITS, INSIDE DIAMETER _____ FT. DEPTH BELOW INLET _____ FT.

ABSORBENT AREA _____ SQ. FT.

97
7 1/2 4 1/4
2 1/2 24
398
24
412

REMARKS 1/16/77, ① 3 well rings comprising pump pit. Electrical service present fr. house to pump pit. Trench depth 7-7 1/2' deep. W3+H3Z

② gravel to w/in 3' of surface. OK to cover.

4/27/83 System appears PVC pipe fr. pump pit uphill to trench. Need to OR report to see house -> ST conn. W3Z.

DATE SYSTEM APPROVED 4/27/83 INSPECTOR F. Skinn

APPLICATION

A 21692

P _____

SEWAGE DISPOSAL TESTING

STATE OF MARYLAND - DEPARTMENT OF HEALTH AND MENTAL HYGIENE

HOWARD COUNTY HEALTH DEPARTMENT
ENVIRONMENTAL HEALTH SERVICES
P. O. BOX 476, ELLICOTT CITY, MARYLAND 21043
TELEPHONE: 465-5000, EXT. 356

DISTRICT 3

DATE 6/23/75

TO: THE COUNTY HEALTH OFFICER
ELLICOTT CITY, MARYLAND

I, HEREBY, APPLY FOR THE NECESSARY TEST IN ORDER TO CONSTRUCT (OR RECONSTRUCT) A SEWAGE DISPOSAL SYSTEM.

PROPERTY OWNER David H. Kerston

James P. Trail - Contract Purchaser

ADDRESS Dayton, Maryland PHONE 286-3751

PROPERTY LOCATION:

SUBDIVISION _____ LOT NO. _____

ROAD AND DESCRIPTION 13190 Folly Quarter Road

SIZE OF LOT .972 acres TYPE BLDG. Existing house
3

IF NOT SINGLE RESIDENCE DESCRIBE _____
(Single Fmly. Dwlg.)

THE SYSTEM INSTALLED UNDER THIS APPLICATION IS ACCEPTABLE ONLY UNTIL PUBLIC FACILITIES BECOME AVAILABLE.

SIGNATURE OF APPLICANT James P. Trail

APPROVED BY _____ FOR _____ DATE _____
(KIND OF SYSTEM)


REJECTED BY _____ FOR _____ DATE _____
(KIND OF SYSTEM)

HOLD PENDING FURTHER TESTS _____ DATE _____

REASONS FOR REJECTION OR HOLDING _____

THIS IS NOT A PERMIT

2169.2

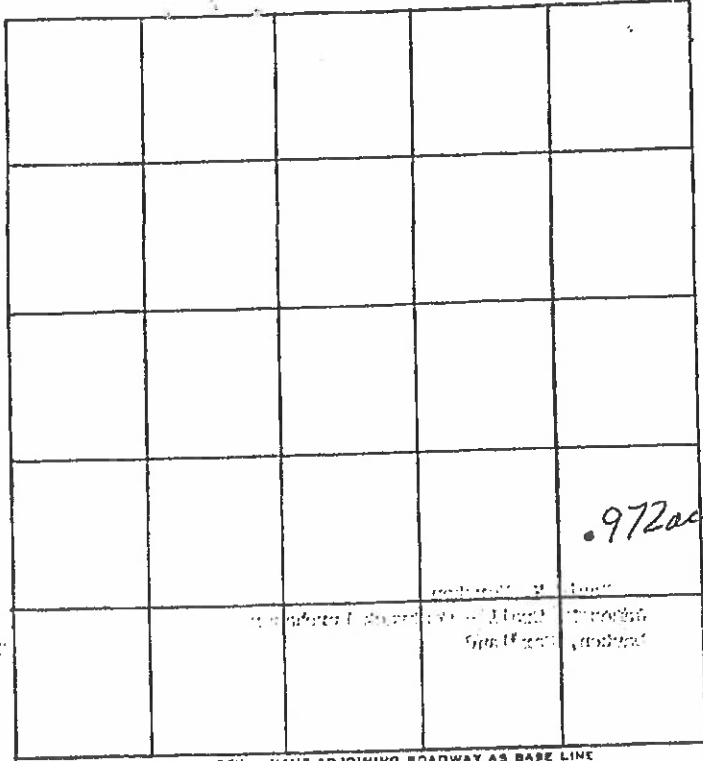

.972 acres

97

INDICATE NORTH - NAME ADJOINING ROADWAY AS BASE LINE

RELATIVE ELEVATION

DATE	TEST NO.	DEPTH	PRE-WET		TEST - 1" DROP		TIME	REMARKS
			START	STOP	START	STOP		
7/30/75	6	8	ALL CLAY	WATER				6TH HIGHEST
7/30/75	7	7	TOP 2 FT SANDY	CLAY MIDDLE	ROCK BOTTOM	DRY		HIGHEST 1ST
8/1/75	8	8	123	124	124	127	3	ABOUT SAME AS ⑤
	8A	4 1/2	123	124	124	126	2	
	8B	9 1/2	VISUAL DRY					
	9	9 1/2	136	139	139	144	5	ABOUT SAME AS ⑦
	9A	5	136	137	137	140	3	
8/1/75	9B	10 1/2	VISUAL DRY		ROCK BOTTOM			

TOP 3 FT CLAY
MID 9 FT SAND
BOT 1/2 FT ROCK

TOP 3 FT CLAY
MID 1/2 FT SAND
BOT 1/2 FT ROCK

REMARKS FRONT RIGHT CORNER OF LOT IS 20 FT LOWER THAN BACK RIGHT CORNER AS SEEN WHEN FACING THE LOT FROM THE ROAD

TESTED BY SIGHT LEVEL USED ALSO PRESENT: JACK FROCK 8/1/75
RH 8/1/75

Resident
4-12 holes
on 10,000 ft.

130 PM

APPLICATION

A 21692

SEWAGE DISPOSAL TESTING

P _____

STATE OF MARYLAND - DEPARTMENT OF HEALTH AND MENTAL HYGIENE

HOWARD COUNTY HEALTH DEPARTMENT
ENVIRONMENTAL HEALTH SERVICES
P. O. BOX 275, ELLICOTT CITY, MARYLAND 21043
TELEPHONE 465-5000, EXT. 356

DISTRICT 3

DATE 6/23/75

TO: THE COUNTY HEALTH OFFICER
ELLICOTT CITY, MARYLAND

I, HEREBY, APPLY FOR THE NECESSARY TEST IN ORDER TO CONSTRUCT (OR RECONSTRUCT) A SEWAGE DISPOSAL SYSTEM.

PROPERTY OWNER David H. Kersten

ADDRESS James F. Trail - Contract Purchaser
Dayton, Maryland Howard Road PHONE 286-3751

TRAILS #

PROPERTY LOCATION:

SUBDIVISION _____ LOT NO. _____

ROAD AND DESCRIPTION 13190 Holly Quarter Road

SIZE OF LOT .972 acres TYPE BLDG. Existing house
3

IF NOT SINGLE RESIDENCE DESCRIBE _____ NUMBER OF BEDROOMS
(Single Fmly. Dwlg.)

THE SYSTEM INSTALLED UNDER THIS APPLICATION IS ACCEPTABLE ONLY UNTIL PUBLIC FACILITIES BECOME AVAILABLE.

SIGNATURE OF APPLICANT James F. Trail

APPROVED BY _____ FOR _____ DATE _____
(KIND OF SYSTEM)

REJECTED BY _____ FOR _____ DATE _____
(KIND OF SYSTEM)

HOLD PENDING FURTHER TESTS _____ DATE _____

REASONS FOR REJECTION OR HOLDING 7/30/75 Must Hold for Review Rock & Soil #
7/31/75 Hold for Review More Holes Needed 8/1/75 Hold for Review

THIS IS NOT A PERMIT