

**COMPLETE THIS FORM WHEN DROPPING OFF ANY  
CORRESPONDENCE AND/OR PLANS TO THE HOWARD COUNTY  
DEPARTMENT OF INSPECTIONS, LICENSES AND PERMITS COUNTER:**

Date: 5.22.24       ONLINE SUBMITTAL       PAPER SUBMITTAL

To: Health (Reviewer/Requestor's Name)      (Division)


From: Bryan Grimaldi (Your Name, Company Name)      (Phone Number)

Subject: Project name Grimaldi Pool

Project site address 7371 Hallmark Rd

Permit # B20001754      SDP # \_\_\_\_\_

Other information pertinent to this project \_\_\_\_\_

- Please check the attachments below that you are submitting with this transmittal:
- Letter of response to address plan review comment letter
  - Revised plans and/or revised details: When submitting for a complete re-review, duplicate sets shall be submitted.
  - Letter Summarizing Changes
  - Energy conservation calculations
  - Copies of \_\_\_\_\_ (be specific). 
  - \_\_\_\_\_ Health Department Request      \_\_\_\_\_ DPZ/ DED Request      \_\_\_\_\_ Applicant's Request
  - Two sets of single-family model plans to be placed on permanent file: Model name and/or # \_\_\_\_\_
  - Other \_\_\_\_\_

**Contact Person Information: (Required)**


Bryan Grimaldi      Telephone No: 240-463-8551  
Please Print Name      E-Mail Address: bgrimaldi77@gmail.com

**PLEASE ASSURE ALL DOCUMENTS AND/OR REVISIONS ARE APPROPRIATELY SIGNED AND SEALED, IF NECESSARY, BY A LICENSED ARCHITECT OR ENGINEER. PLEASE BE ADVISED THAT INSUFFICIENT INFORMATION MAY RESULT IN THE DELAY OF REVIEW BY THE PLANS EXAMINER. THE DEPARTMENT OF INSPECTIONS, LICENSES AND PERMITS WILL CONTACT YOU IF THERE IS A PROBLEM. IN ADDITION, ONCE THE BUILDING PERMIT IS APPROVED BY THE PLAN REVIEW DIVISION AND ALL OTHER REQUIRED SIGNATORY AGENCIES, AND THE BUILDING PERMIT IS READY FOR ISSUANCE, THE PERMIT DIVISION WILL NOTIFY THE APPROPRIATE CONTACT PERSON FOR PERMIT PICK UP. ALL PERMIT STATUS INQUIRIES SHALL BE DIRECTED TO THE PERMIT DIVISION AT 410-313-2455 OPTION #4 OR BY VISITING MYHOWARD.INFO. CODE RELATED QUESTIONS AND PLAN REVIEW INQUIRIES SHALL BE DIRECTED TO THE PLAN REVIEW DIVISION AT 410-313-2436. PLEASE ALLOW A MINIMUM OF FIVE (5) WORKING DAYS FOR ANY PLAN SUBMITTALS TO BE REVIEWED. THANK YOU.**


Received by TR  
White-Plan Review / Yellow-Applicant / Pink-Permit Division  
t:\Operations\Updated forms\HoCoTransmittalForm05.2022

*Approved R/R  
5/22/2024*

*Rev 1*

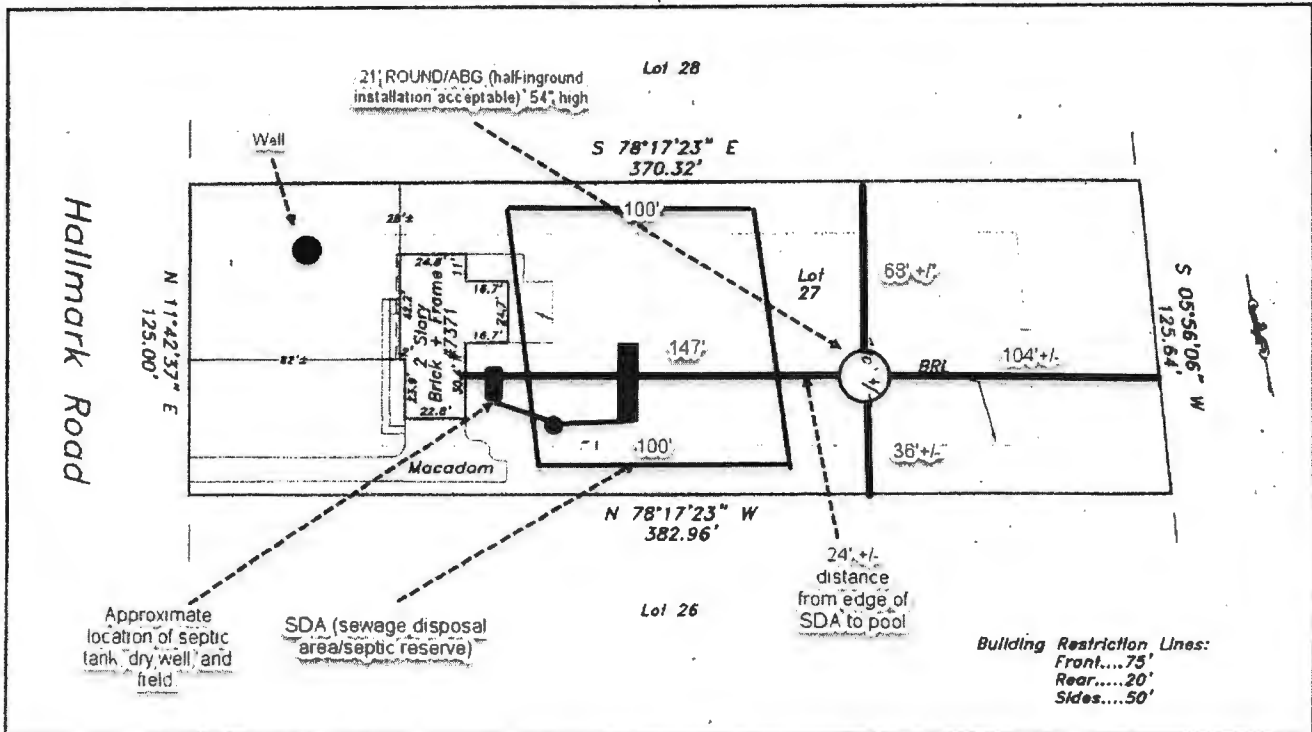

The purpose of this drawing is to locate, describe, and represent the positions of buildings and substantial improvements affecting the property shown hereon, being known as:  
 Lot 27, Section One,  
 HALLMARK  
 recorded among the land records of Howard County, Maryland in Plat 3889

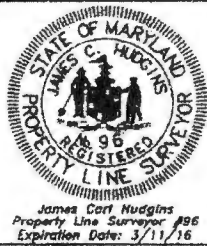

**LOCATION DRAWING**  
 7371 Hallmark Road  
 5th ELECTION DISTRICT  
 HOWARD COUNTY, MARYLAND

PREPARED FOR:

**SAGE TITLE GROUP**  
 THE WISE CHOICE

This is page one of a two page document. The advice found on the affixed page is an integral part of this drawing, and is not valid without all pages.

**NTT Associates, Inc.**  
 16205 Old Frederick Rd.  
 Mt. Airy, Maryland 21771  
 Phone: (410) 442-2031  
 Fax: (410) 442-1315  
 www.nttsurveyors.com

Scale:	1" = 50'
Date:	12-28-15
Field By:	DR
Drawn By:	DR
File No.:	162778ELCS
Page No.:	1 of 2

