

Name: Roger Surber- Surber Construction
Street Address: 20529 Locust Grove Rd
City, State, Zip: Rohrersville MD 21779
Date: May 27, 2025

Amendment, Permit # B22000269

Ms. Debbie Whalen
Division of Plan Review
Department of Inspections, Licenses and Permits
Howard County Government
3430 Court House Drive
Ellicott City, MD 21043

RECEIVED

MAY 29 2025

LICENSES & PERMITS
DIVISION

Dear Ms. Whalen:

I am requesting to amend Permit # B22000269 at
13080 Williamfield Dr. Ellicott City MD to
Remodel existing second floor bathroom, enlarge and add walk in closet. Relocate proposed
2 nd floor bathroom to first floor of addition, change space on second floor to walk in closet

Enclosed:


- Fee: _____
- Plot Plans
- Sets of Construction Drawings
- Other: _____

If there is anything we can do to assist you, please let me know.


Sincerely,
John Kowalski

Name: John Kowalski
Title: JDK Design
Phone: 301-977-3652

Approved Septic System Plan
Howard County Health Department
Dana Bernard 6-11-25
Signature Date

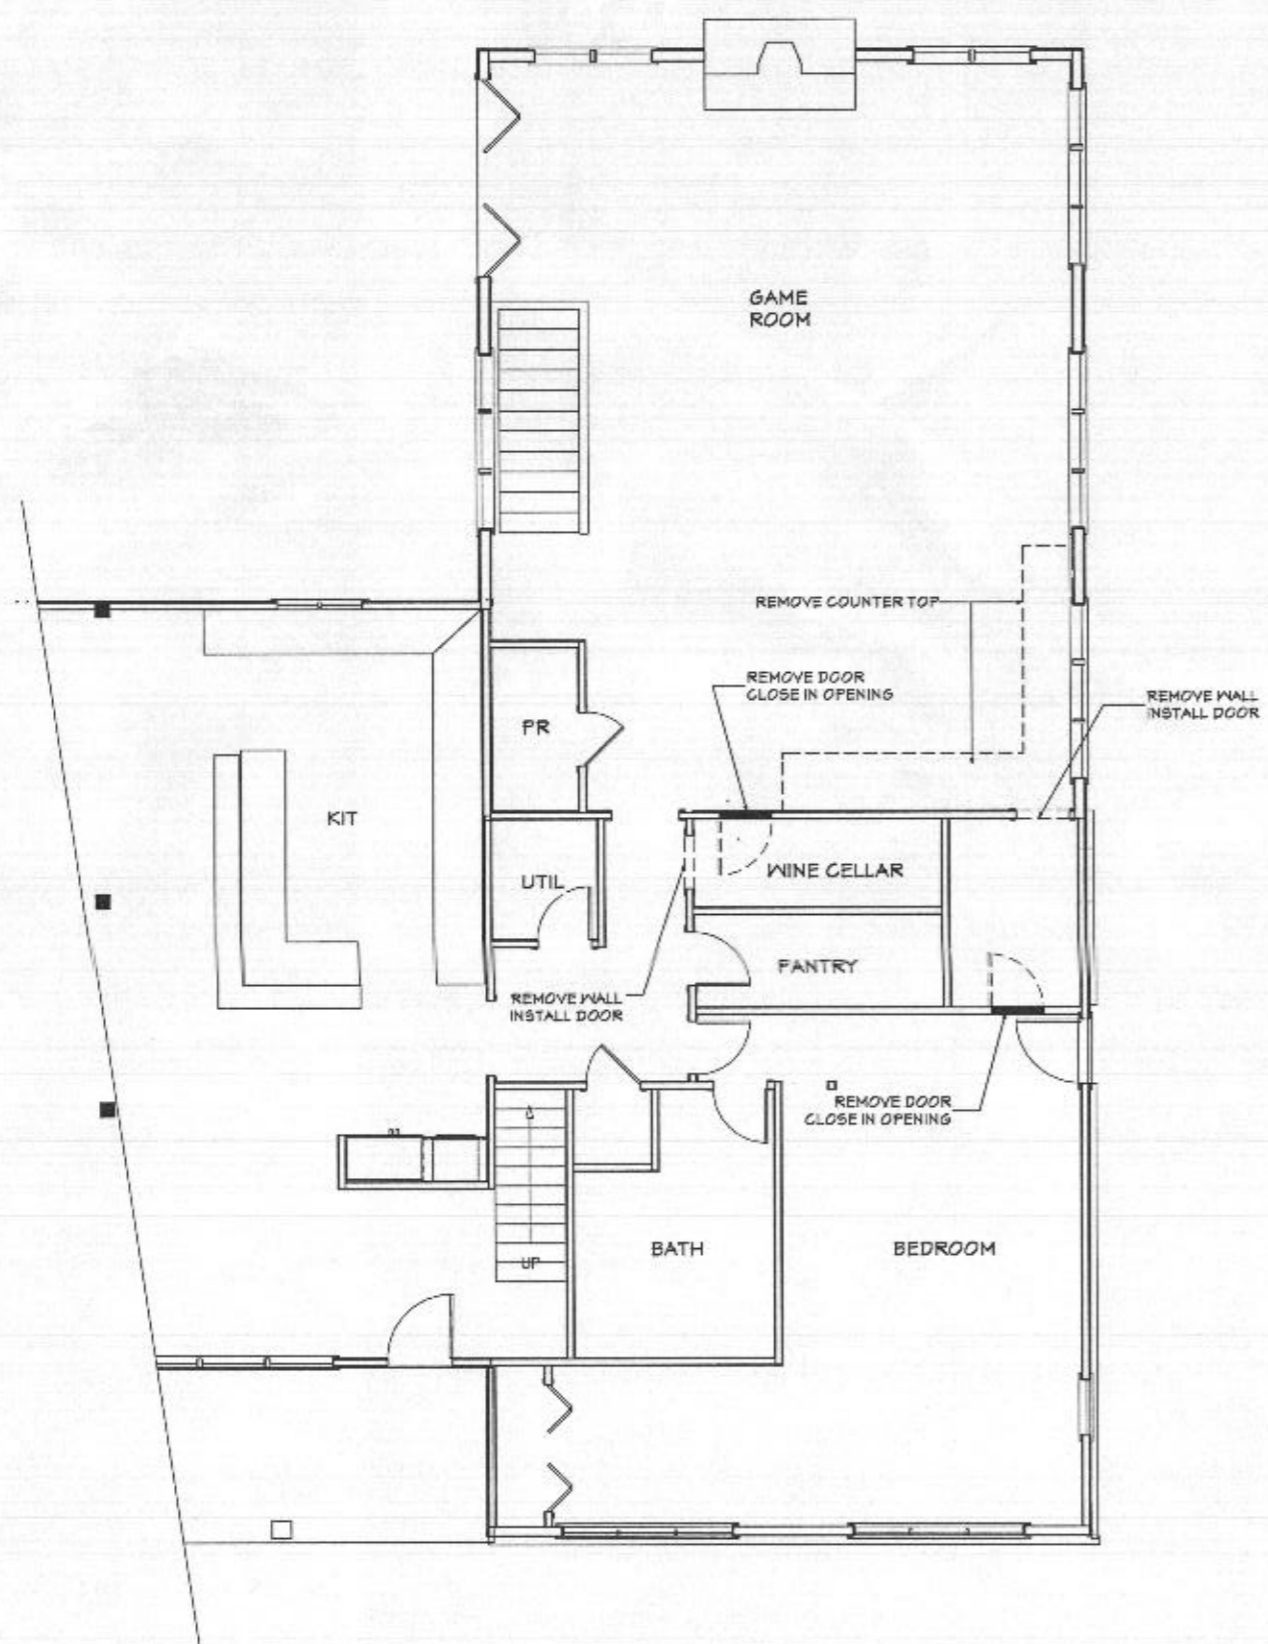

PART FIRST FLOOR PLAN - DEMOLITION
 1/4" = 1'-0"

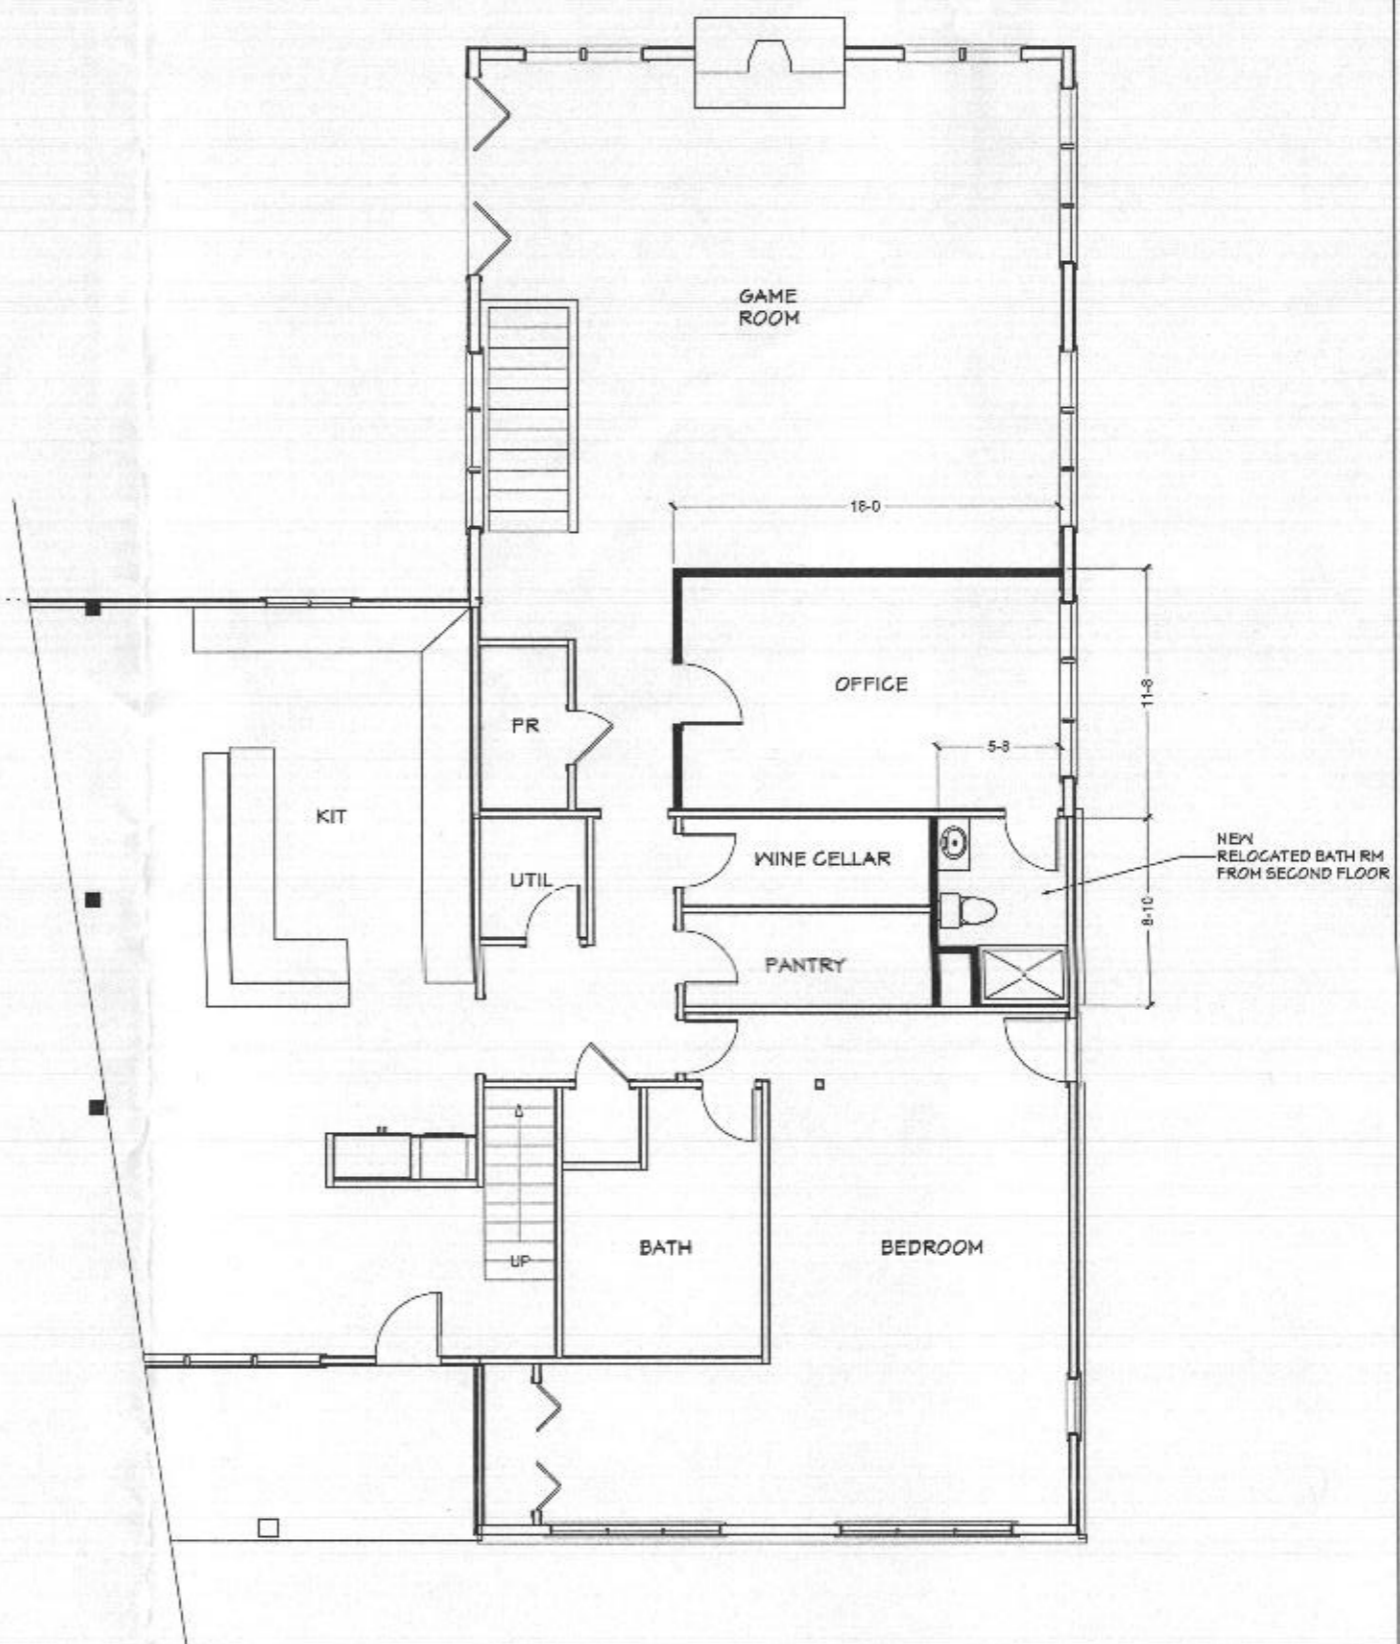

PART FIRST FLOOR PLAN - RELOCATED BATHROOM, ADDED OFFICE
 1/4" = 1'-0"


REVISIONS
 5-1-25

JDK DESIGN CONCEPTS
 JAYTONSVILLE MD 301-471-3652

SURBER CONSTRUCTION
 FREDERICK MD (301) 338-5641


ADDITIONS / RENOVATIONS TO
 DISSANAYAKE RESIDENCE
 13080 WILLIAMFIELD DRIVE
 ELLICOTT CITY MD 21042

FIRST FLR - DEMOLITION
 SECOND FLR - BATH / OFFICE
 MAY 2025
 SCALE AS NOTED

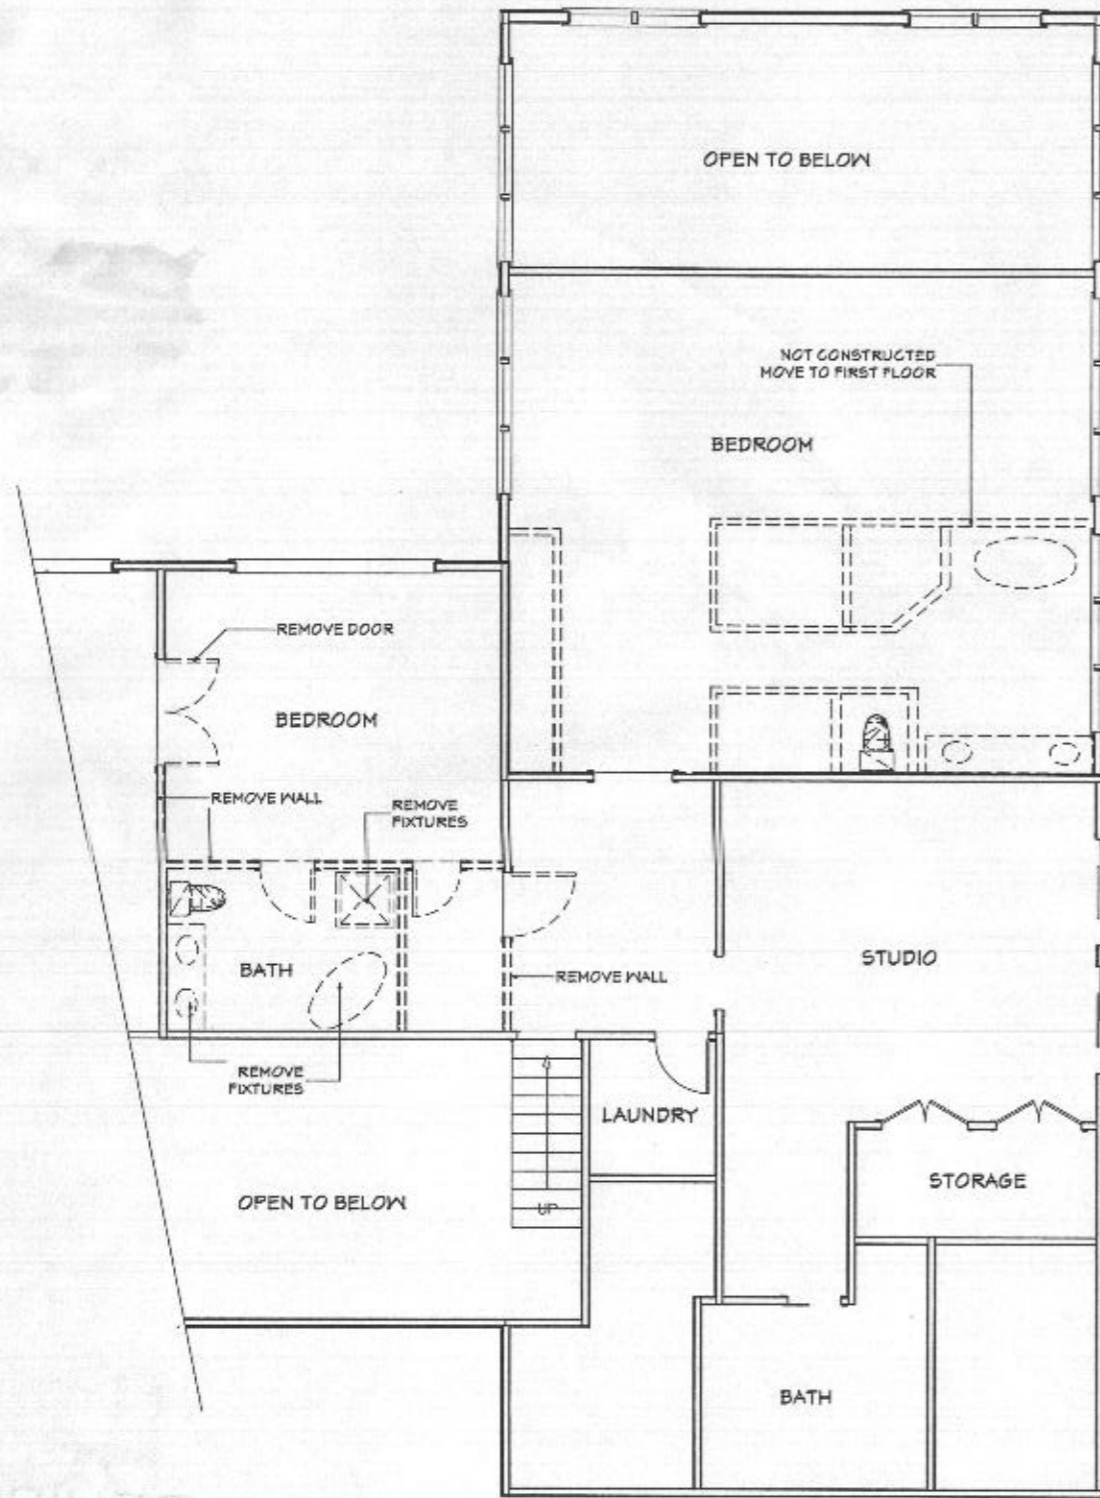

PART SECOND FLR- DEMOLITION

1/4" = 1'-0"

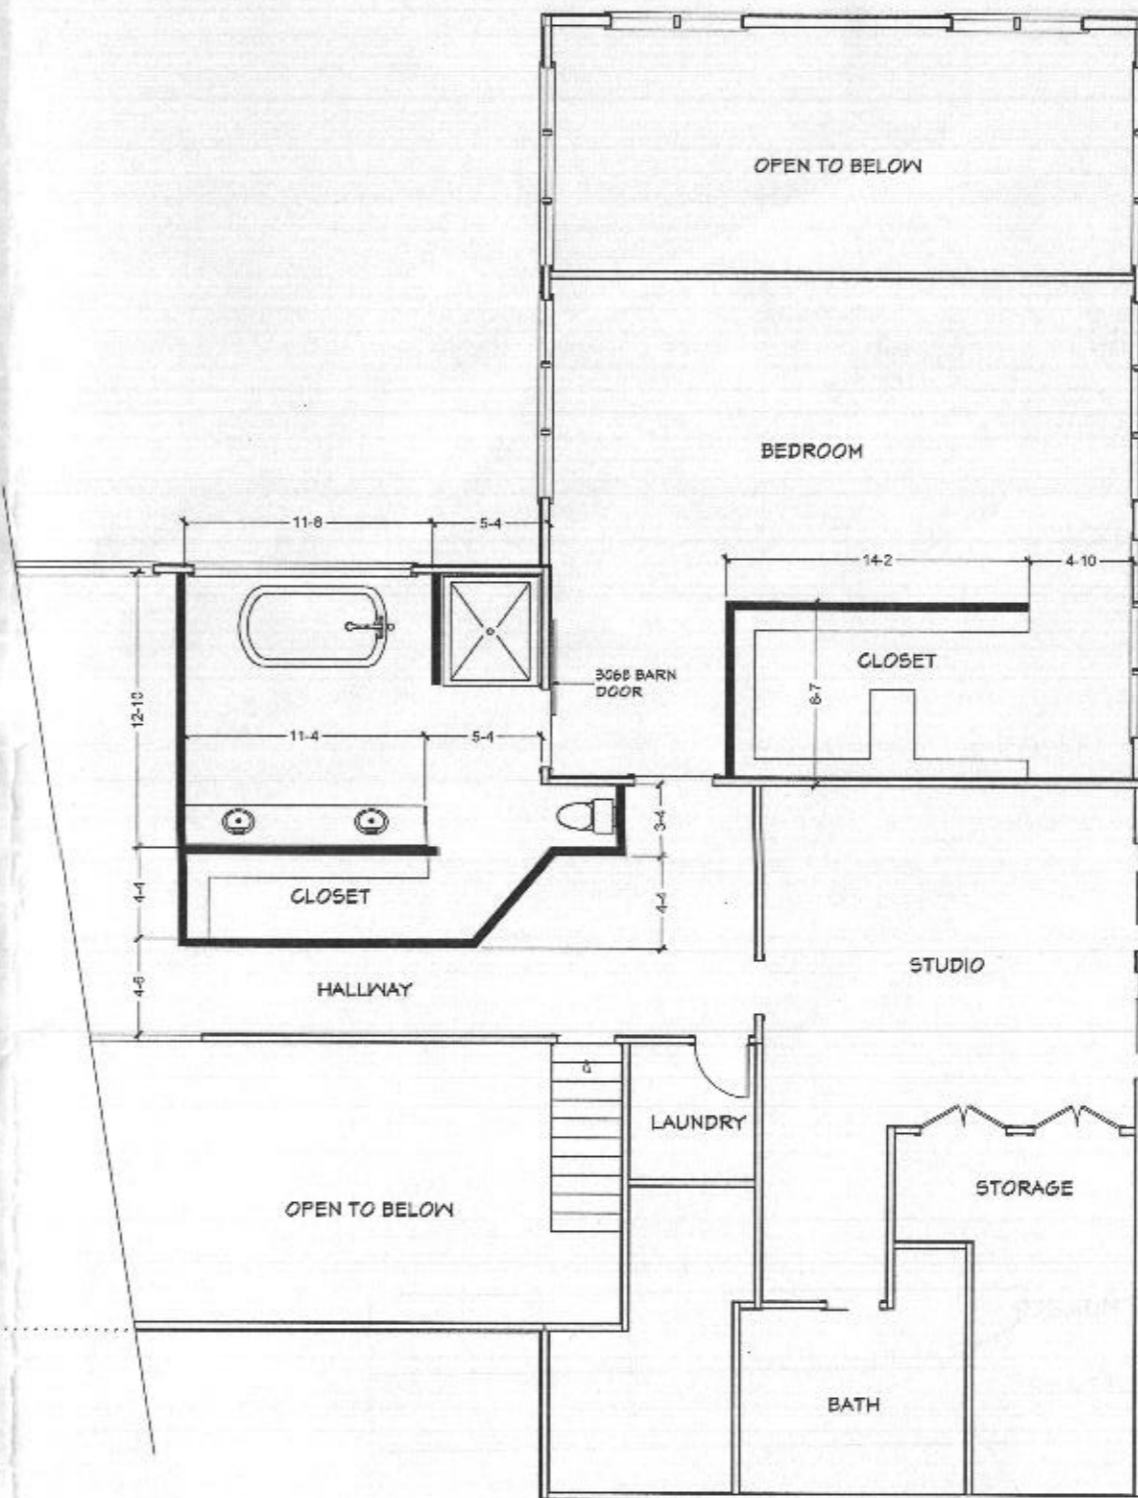

PART SECOND FLR- REMODELED BATH, ADDED CLOSET

1/4" = 1'-0"

REVISIONS
5-1-25

JK DESIGN CONCEPTS
LAYTONSVILLE MD 301-477-3652

SURBER
CONSTRUCTION
FREDERICK MD (301) 888-8911

ADDITIONS / RENOVATIONS TO
DISSANAYAKE RESIDENCE
13080 WILLIAMFIELD DRIVE
ELLICOTT CITY MD 21042

SCALE AS NOTED

SECOND FLR - DEMOLITION
SECOND FLR - CLOSET/ BATH

MAY 2025