




HOWARD COUNTY HEALTH DEPARTMENT

90370

☐ CASH ☒ CHECK NO. 82609 \$ 2051.00	CODES 12191 Filly Quar	DATE 3/11/26	Received From Fogles For Repair - Two hundred sixty Dollars
	Received By [Signature]		

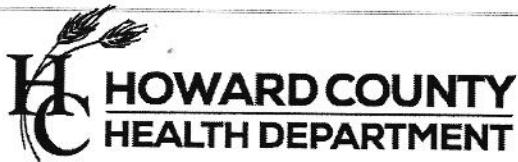

Bureau of Environmental Health
8930 Stanford Blvd | Columbia, MD 21045
410.313.2640 - Voice/Relay
410.313.2648 - Fax
1.866.313.6300 - Toll Free

Maura J. Rossman, M.D., Health Officer

APPLICATION FOR PERCOLATION TESTING AND SITE EVALUATION

PROPERTY LOCATION

SUBDIVISION/PROPERTY NAME Glenelg Manor

PROPERTY ADDRESS 12740 Folly Quarter Rd Ellicott City, MD 21042
STREET TOWN ZIP

TAX ACCOUNT # 05-374340 TAX MAP 22 GRID 23 PARCEL 445 LOT NO. 8 C PROPOSED LOT
ZONING CATEGORY TIER SIZE (ACRES) 1.48 acres

PROPERTY OWNER(S) Jeremy & Shari Hammond

DAYTIME PHONE 443-838-3524 CELL EMAIL sharihammondhomesales@gmail.com

MAILING ADDRESS 12741 Folly Quarter Rd Ellicott City, MD 21042
STREET CITY, STATE ZIP

APPLICANT Fogle's Septic Clean, Inc. RELATIONSHIP TO OWNER: Septic Contractor

DAYTIME PHONE 410-795-5670 CELL EMAIL john@foglesinc.com

MAILING ADDRESS 580 Obrecht Rd Sykesville, MD 21784
STREET CITY, STATE ZIP

I HEREBY APPLY FOR THE NECESSARY TESTING/EVALUATION PRIOR TO ISSUANCE OF SEWAGE DISPOSAL SYSTEM PERMIT(S):

PROPERTY:

- ☐ SUBDIVISION: NUMBER OF LOTS INCLUDING RESIDUE: SUBDIVISION CLASSIFICATION (PER DEPT. OF PLANNING AND ZONING) ☐ MAJOR ☐ MINOR
- ☐ CONSTRUCT NEW OSDS ON UNDEVELOPED LOT
- ☒ REPAIR OR REPLACE FAILING OSDS
- ☐ UPGRADE EXISTING OSDS

BUILDING:

- ☒ RESIDENTIAL WITH 4 EXISTING OR PROPOSED BEDROOMS IN THE COMPLETED STRUCTURE
- ☐ COMMERCIAL (PROVIDE DETAIL OF TYPE OF USE AND NUMBERS OF EMPLOYEES/CUSTOMERS ON ACCOMPANYING PLAN)

IS THE PROPERTY WITHIN 2500 FEET OF ANY RESERVOIR?

- ☐ YES
- ☒ NO

AS APPLICANT, I UNDERSTAND THE FOLLOWING:

- THIS APPLICATION IS VALID FOR TWO(2) YEARS FROM DATE OF FEE PAYMENT AND APPROVAL IS BASED UPON HEALTH OFFICER SIGNATURE OF A PERC CERTIFICATION PLAN PRIOR TO EXPIRATION OF THIS PERMIT.
- THE APPLICATION FEE IS NON-REFUNDABLE
- THIS APPLICATION MUST BE ACCOMPANIED BY ALL APPLICABLE FEES AND A SUITABLE SITE PLAN IN ORDER TO BE PROCESSED
- THIS IS A PUBLIC DOCUMENT

I declare and affirm that to the best of my knowledge, the information contained herein is correct. I declare that I am the owner of the property or duly authorized to make this application on behalf of the owner. I agree to comply with all applicable state and county regulations.


By signature of this application, I hereby grant Howard County Health Department officials the right to enter onto the property for the purpose of inspecting the property as directly related to the requested permit/service.

SIGNATURE OF APPLICANT

3/11/2026

DATE

PLOT PLAN
SCALE 1" = 100'

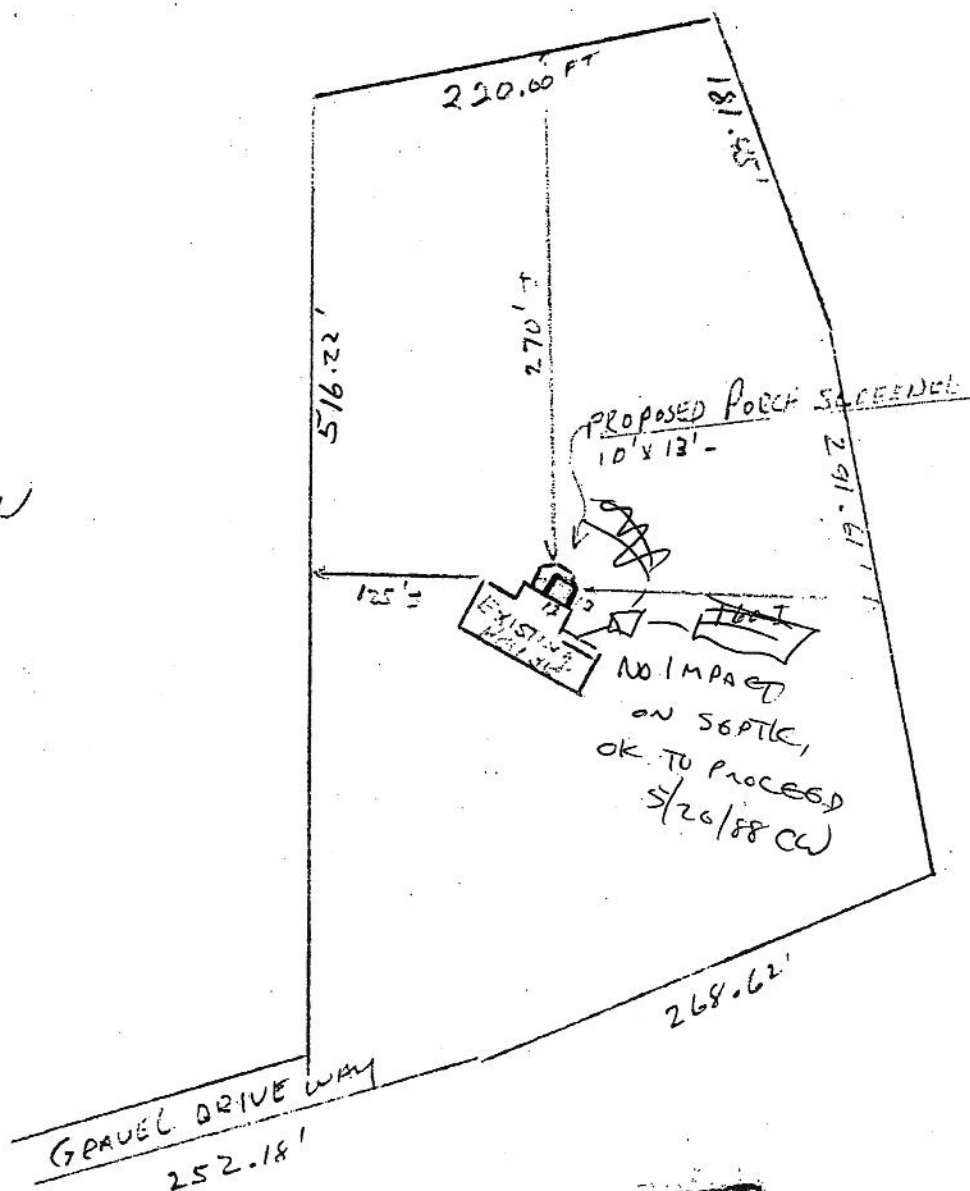


BDDG. PERMIT SIGNED
AND RETURNED 5-26-88

BP1875C
Puch/dick

OWNER - MARK KAPLIN
6652 LUSTER DR.
HIGHLAND, MD. 20777

6652 LUSTER DRIVE
LOT 1
JOCEY LN ACRES
SECTION 4
5TH ELECTION DIST.
HOWARD COUNTY MD

AP

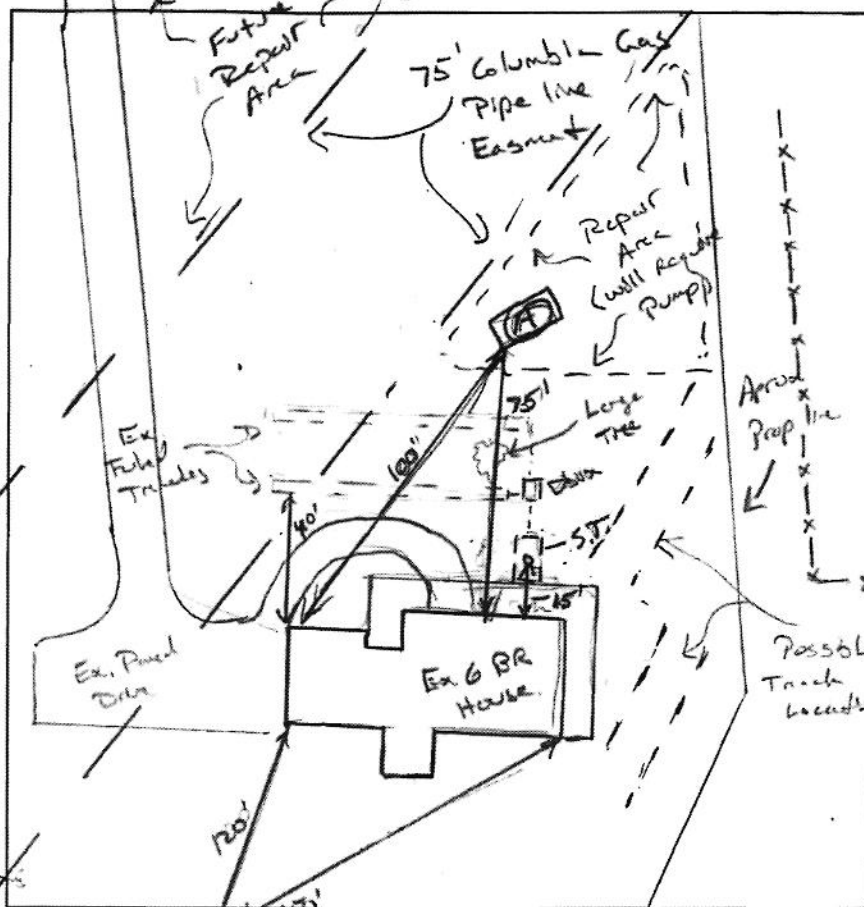

(A)
 OM, strong Br L.
 root's, SCK
 10'
 Br/R/L, CL
 CW, 2 SCK
 Frable, roots
 8'
 Br CL,
 Somewhat platy.
 CW, Frable,
 Dry
 6'
 1 lb L,
 Tight, S. stones
 7'
 Br/R/Y SL,
 Manganese
 Platy structure.
 Very Loose, Dry.

166" $\frac{1420 \text{ scap}}{166}$

DATE	TEST #	DEPTH	START	BREAK 1" DROP	STOP 2" DROP	TIME OF 2ND INCH	P/F/H
5/27/14	(A)	6' 1/4"	1:07	pulled,	1/2 movement 10 ms		
		6' 10"	1:22	1:33	1:53	20	(P)

REMARKS Property within 75' easement Columbia Gas line

SANITARIAN: K. Wolf BACKHOE Eds-Fox Hs OTHERS H/L, owner


TEST HOLES USED IN SDA _____ AVG. PERC TIME _____ SQ. FT/BR _____

TRENCH WIDTH 2 INLET DEPTH 4' MAX. BOT DEPTH 11' EFFECTIVE S/W 6.0'

$$6BR \Rightarrow \frac{900 \text{ gal}}{0.6} = 1500 \div 2 = 750 (.31) = 232 LF$$

(31)

12739 Folly Quarter Rd.
Building permit # 66796

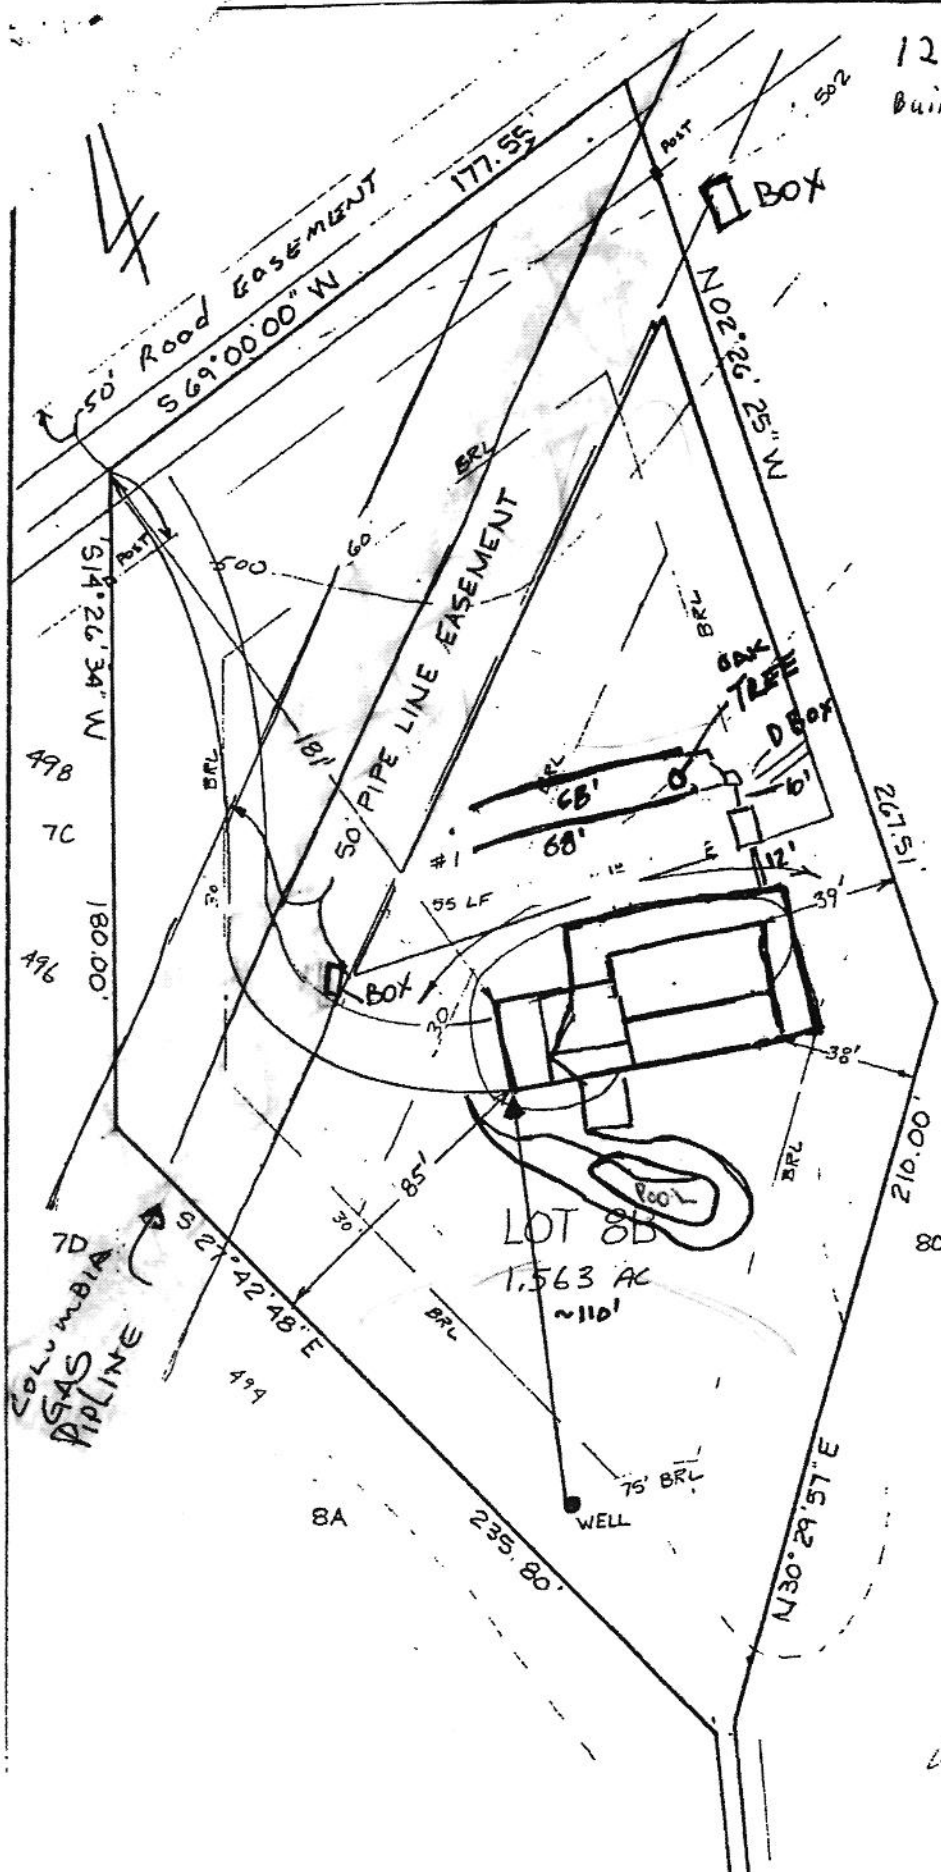

HOUSE:

FIRST FLOOR	499.5
BASEMENT	490.5
INVERT	494.26

SEPTIC TANK:

EXISTING GRADE	497.3
PROPOSED GRADE	498.0
INVERT IN	494.05
INVERT OUT	493.80

DISTRIBUTION BOX:

EXISTING GRADE	497.9
PROPOSED GRADE	497.9
INVERT IN	493.70
INVERT OUT	493.60

<u>TRENCH:</u>	#1	#2
LENGTH	55.0'	60'
WIDTH	2'	2'
STONE	4 1/2'	4 1/2'
INVERT	493.5'	493.3
BOTTOM	489.0	488.8

PLOT PLAN
PARCEL 8B
GLENELG MANOR II
3rd ELECTION DISTRICT
HOWARD COUNTY, MARYLAND
SCALE 1"=50' DATE 3/21/85

I certify the above
measurements and elevations
are actual and true for this
property.

J. Carl Hudgins
J. Carl Hudgins