

6-10-88  
9:30 AM

# APPLICATION

PERCOLATION TESTING

A 41842

P \_\_\_\_\_

HOWARD COUNTY HEALTH DEPARTMENT  
BUREAU OF ENVIRONMENTAL HEALTH  
P.O. BOX 476 ELLICOTT CITY, MARYLAND 21043  
TELEPHONE: 461-9933

DISTRICT \_\_\_\_\_

DATE 4 May 88

TO: THE COUNTY HEALTH OFFICER  
ELLICOTT CITY, MARYLAND

I, HEREBY, APPLY FOR THE NECESSARY TEST IN ORDER TO CONSTRUCT (OR RECONSTRUCT) A SEWAGE DISPOSAL SYSTEM.

PROPERTY OWNER Lewis and Elisabeth A. Larson RES CONSTRUCTION 946-7200  
688-6499 (work)

ADDRESS 8959 Skyrock Ct Columbia, MD 21046 PHONE 381-8546

PROSPECTIVE BUYER \_\_\_\_\_

ADDRESS \_\_\_\_\_ PHONE \_\_\_\_\_

PROPERTY LOCATION:

SUBDIVISION Whistledown LOT NO. 7

ROAD AND DESCRIPTION 7005 Woodscape Drive, off Rte 32 in Clarksuite

TAX MAP 41 PARCEL # 276

SIZE OF LOT 3.00<sup>00</sup> acres TYPE BLDG Single family dwelling  
(SINGLE FAMILY DWELLING OR COMMERCIAL)

THE SYSTEM INSTALLED UNDER THIS APPLICATION IS ACCEPTABLE ONLY UNTIL PUBLIC FACILITIES BECOME AVAILABLE. I FULLY UNDERSTAND THE FEE CONNECTED WITH THE FILING OF THIS PERC TEST APPLICATION IS NON-REFUNDABLE UNDER ANY CIRCUMSTANCES. I ALSO AGREE TO COMPLY WITH ALL M.O.S.H.A. REQUIREMENTS IN TESTING THIS LOT. Elisabeth A. Larson

(SIGNATURE OF APPLICANT)

APPROVED BY Sidney Ab FOR Deputy DATE 3-23-89

REJECTED BY \_\_\_\_\_ FOR \_\_\_\_\_ DATE \_\_\_\_\_

HOLD PENDING FURTHER TESTS \_\_\_\_\_ DATE \_\_\_\_\_



REASONS FOR REJECTION OR HOLDING 6-10-88 Per Satisfactory - Hold for year  
REVISION. Saw

BLDG. PERMIT SIGNED  
AND RETURNED 3-23-89  
BP24321 SA

# THIS IS NOT A PERMIT

HD-216

SOIL PROFILE

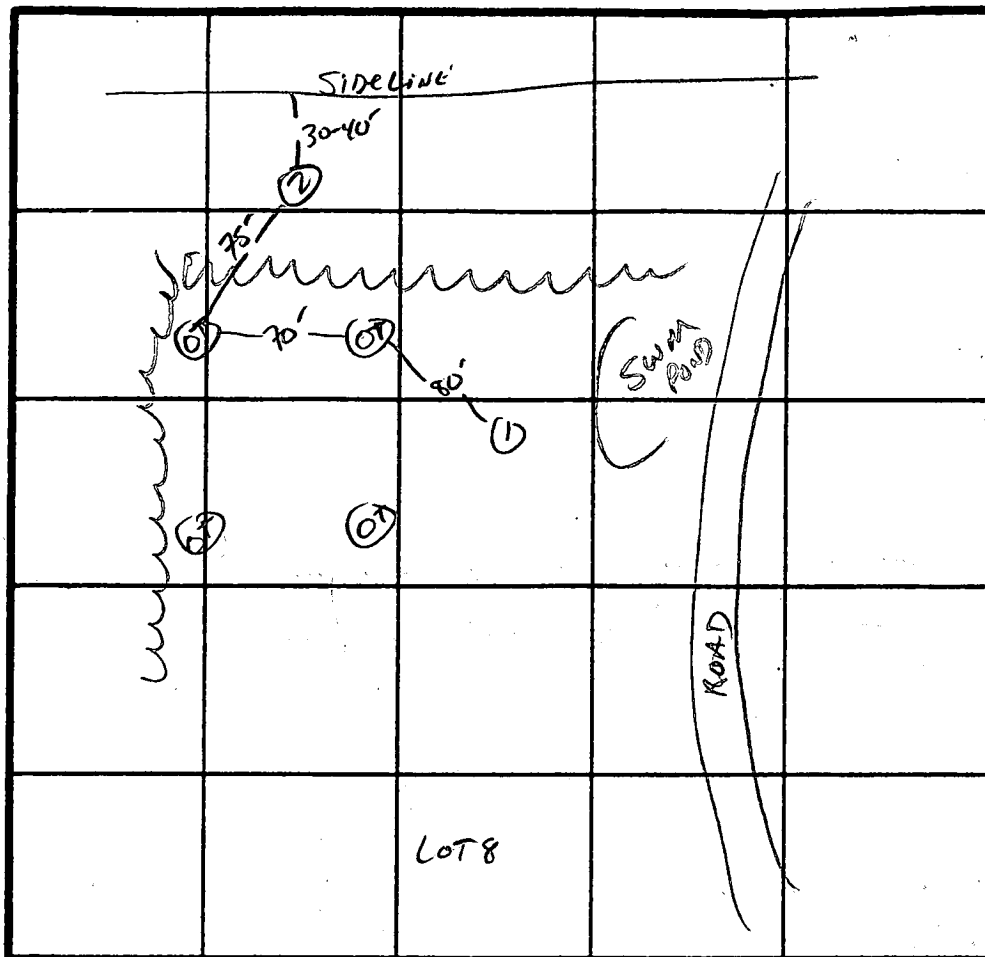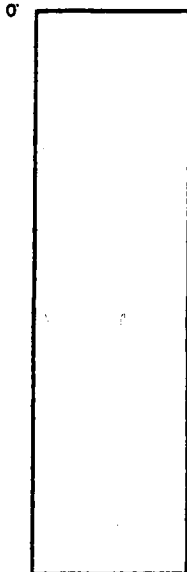

INDICATE NORTH - NAME ADJOINING ROADWAY AS BASE LINE.

Rt 32

DATE	TEST NO.	DEPTH	PRE-WET		TEST - 1" DROP		TIME	
			START	STOP	START	STOP		
6/10/88	1S	2.5	10:11	10:20	10:20	10:32	12 MIN	
		9.0	10:16	10:29	10:29	10:50	21 MIN	
	1U	14	UNIFORM SOIL below 2"					
	2S	4"	10:35	10:37	10:37	10:45	8 MIN	
	2U	13"	UNIFORM SOIL below 3.5"					

REMARKS Deep Syst. OK

TYPE OF SOIL Chertex

TESTED BY S. Webb ALSO PRESENT Parlett (owner) / Sean