



Howard County
Health Department

Maura J. Rossman, M.D., Health Officer

Bureau of Environmental Health

8930 Stanford Boulevard, Columbia, MD 21045

Main: 410-313-2640 | Fax: 410-313-2648

TDD 410-313-2323 | Toll Free 1-866-313-6300

www.hchealth.org

Facebook: www.facebook.com/hocohealth

11/13/26
68
RECEIPT DATE: 7/20/21 **ONSITE SEWAGE DISPOSAL SYSTEM**

P 569615

APPROVAL DATE: 10/13/21 **PERMIT: HOLDING TANK**

A _____

PROPERTY ADDRESS: 417 Woodbine Road, Woodbine, MD 21797

SUBDIVISION: _____ LOT: _____ TAX ID: 04-310462

CONTRACTOR: Young Excavating, LLC EMAIL: _____

CONTRACTOR ADDRESS: P.O Box 220, Keymar, MD 21757 PHONE: (443) 398-5089

PROPERTY OWNER: Division, LLC EMAIL: _____

OWNER ADDRESS: 3070 Milltowne Drive, Unit 303, Ellicott City, MD 21043 PHONE: _____

TANK: 2000 g PUMP SIZE: n/a PUMP TANK CAPACITY: n/a

	DATE SIGNED:	DATE RECORDED:
HOLDING TANK AGREEMENT	4/6/21	7/2/2021

NOTES:

Install in series with existing tank with alarm float in last chamber. Alarm must be on dedicated circuit. Watertight test of tank required.

ISSUED BY: Kevin Wolf ISSUE DATE: 7/20/21 EXPIRATION DATE: 7/20/22

NOTE: CONTRACTOR MUST SCHEDULE A PRE-CONSTRUCTION INSPECTION PRIOR TO BEGINNING ANY INSTALLATION

NOTE: CONTRACTOR MUST SCHEDULE AN INSPECTION AND GAIN APPROVAL OF ALL COMPONENTS PRIOR TO COVERING

NOTE: STONE MUST BE APPROVED BY HEALTH DEPARTMENT AND GRAVEL TICKET MUST BE AVAILABLE FOR REVIEW.

NOTE: WATERTIGHT SEPTIC TANKS REQUIRED

NOTE: ALL PARTS OF SEPTIC SYSTEM SHALL BE AT LEAST 100 FEET DOWNGRADIENT FROM ANY WATER WELL

NOTE: MANHOLE RISERS REQUIRED ON ALL SEPTIC TANKS AND PUMP CHAMBERS

NOTE: AN ELECTRICAL PERMIT IS REQUIRED FOR INSTALLATION OF ANY ELECTRICAL COMPONENTS OF THE SYSTEM

☒ ELECTRICAL PERMIT ISSUED E 22000718

NOTE: AN INDIVIDUAL CERTIFIED BY MDE AND THE MANUFACTURER FOR BAT INSTALLATION MUST BE PRESENT AT ALL TIMES DURING BAT INSTALLATION.


NOTE: MDE RECOMMENDS SEPTIC TANKS, BAT, AND OTHER PRETREATMENT UNITS BE PUMPED AT A FREQUENCY ADEQUATE TO ENSURE THAT SOLIDS ARE NOT DISCHARGED TO THE DISPOSAL AREA

NEITHER THE HOWARD COUNTY COUNCIL NOR THE HEALTH DEPARTMENT IS RESPONSIBLE FOR THE
SUCCESSFUL OPERATION OF ANY SYSTEM.

PERMITTEE RESPONSIBLE FOR OBTAINING FINAL APPROVAL ON THIS PERMIT.

CALL 410-313-1771 TO SCHEDULE INSPECTIONS.

NOT TO SCALE

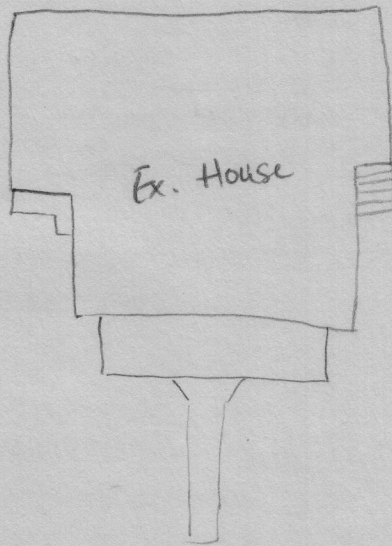

ROAD NAME

Woodbine Rd

TRENCH/DRAINFIELD DATA

WIDTH INLET BOTTOM

NUMBER OF TRENCHES

TOTAL LENGTH

ABSORPTION AREA

DISTRIBUTION BOX LEVEL

DISTRIBUTION BOX BAFFLE

DISTRIBUTION BOX PORT

SEPTIC TANK DATA

SEPTIC TANK 1 LEVEL

MANUFACTURER

CAPACITY ~1000 GAL

SEAM LOC midseam

TANK LID DEPTH 3'

BAFFLES

BAFFLE FILTER

MANHOLE LOC outlet

6" PORT LOC inlet, new Pvc

WATERTIGHT TEST passed

SLOTTED no

DATE ON LID

PUMP/SEPTIC TANK LEVEL

MANUFACTURER Babylon

CAPACITY 2000 GAL

SEAM LOC top

TANK LID DEPTH 4.5'

BAFFLES

BAFFLE FILTER

MANHOLE LOC inlet

6" PORT LOC

WATERTIGHT TEST

SLOTTED no

DATE ON LID 9-6-21

PRE-CONSTRUCTION:

9/29/21 Met with Don Young, he plans to put new tank in front of old tank, near road. Old tank appears to be slightly angled onto neighbor's property. Property line was staked. (S)

INSTALLATION: 10/12/21 Tank set. Watertight test begun at 3:30 PM. Water level 65.5" when measured from edge of riser. (S) 10/13/21 Water level at 65.5". No sign of water leaking around tank or from tank seam. Alarm float installed. Alarm located in basement, plugged into socket. Alarm observed to work. (S) 10/14/21 Spoke with Jeff Williams, Well and Septic program supervisor. He said alarm must be wired directly to electrical panel, on it's own circuit. Contractor must call for re-insp. (S) 1/13/2026 - Donnie Young septic & Electrician onsite. Electrical work in HT fixed. Alarm inside house sounds when float pulled. (S)

FINAL INSPECTOR S. Page . DATE OF APPROVAL 1/13/2026 .