



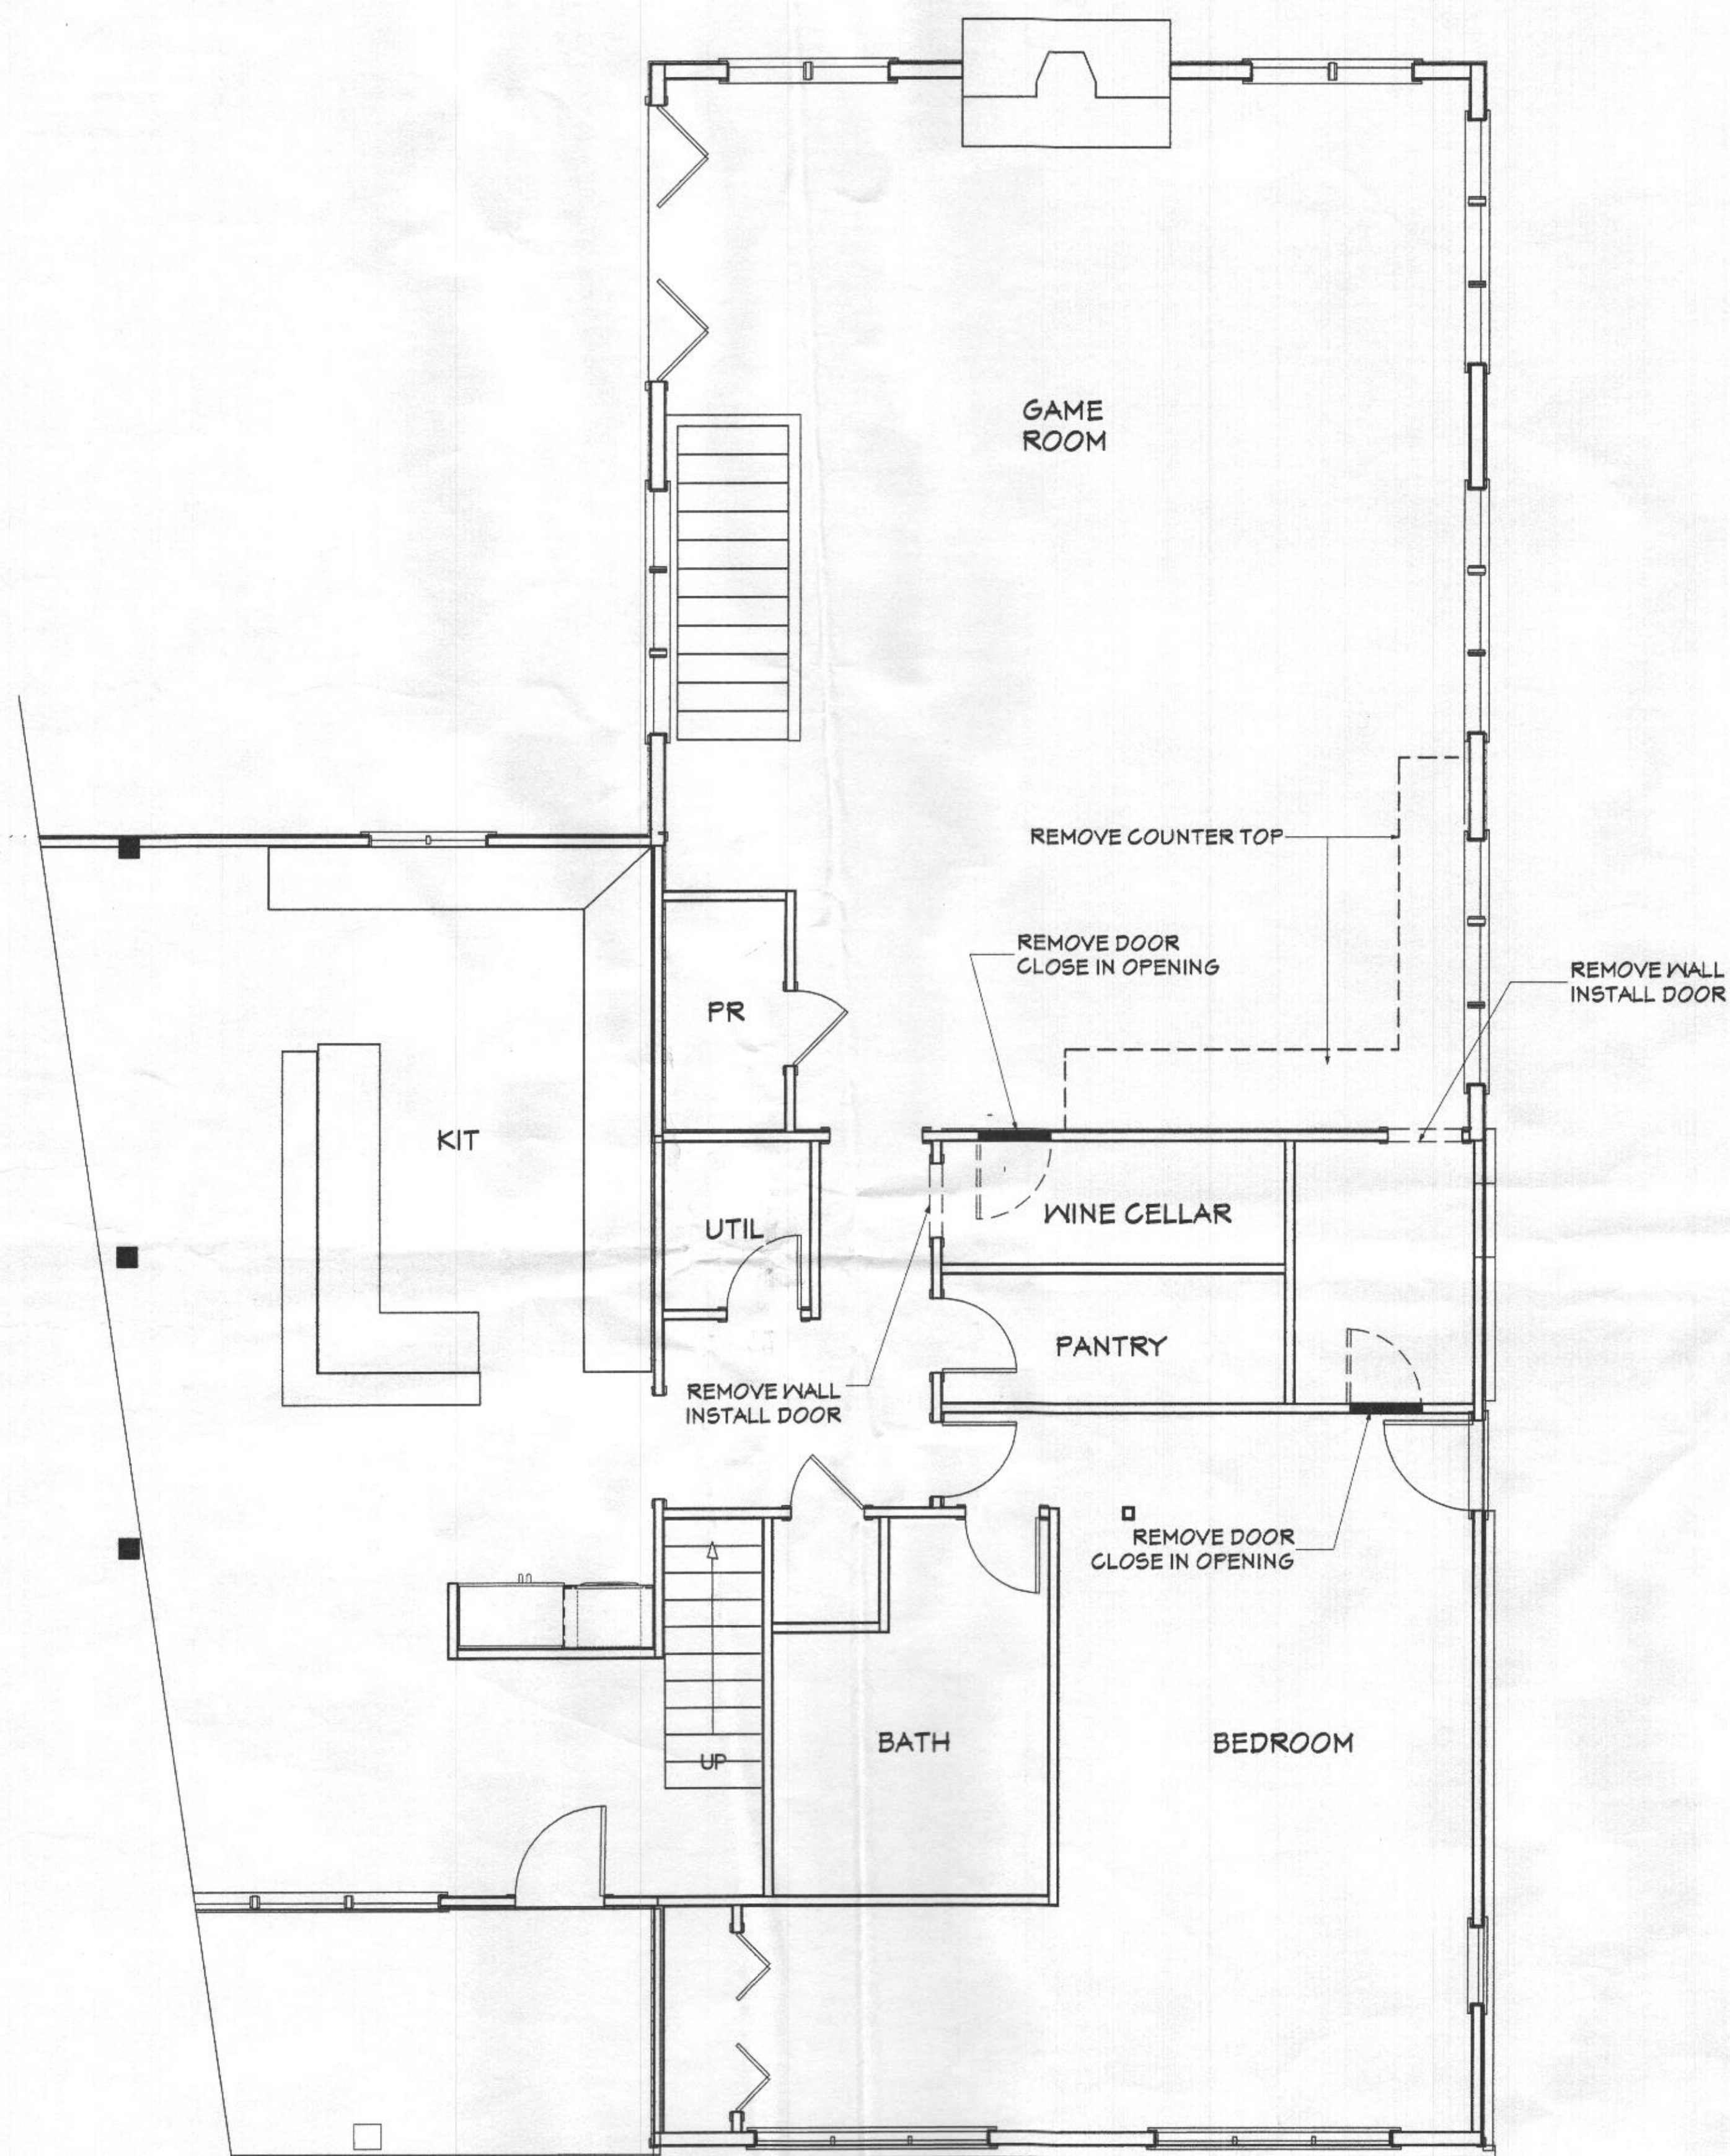

PART FIRST FLOOR PLAN - DEMOLITION
1/4" = 1'-0"

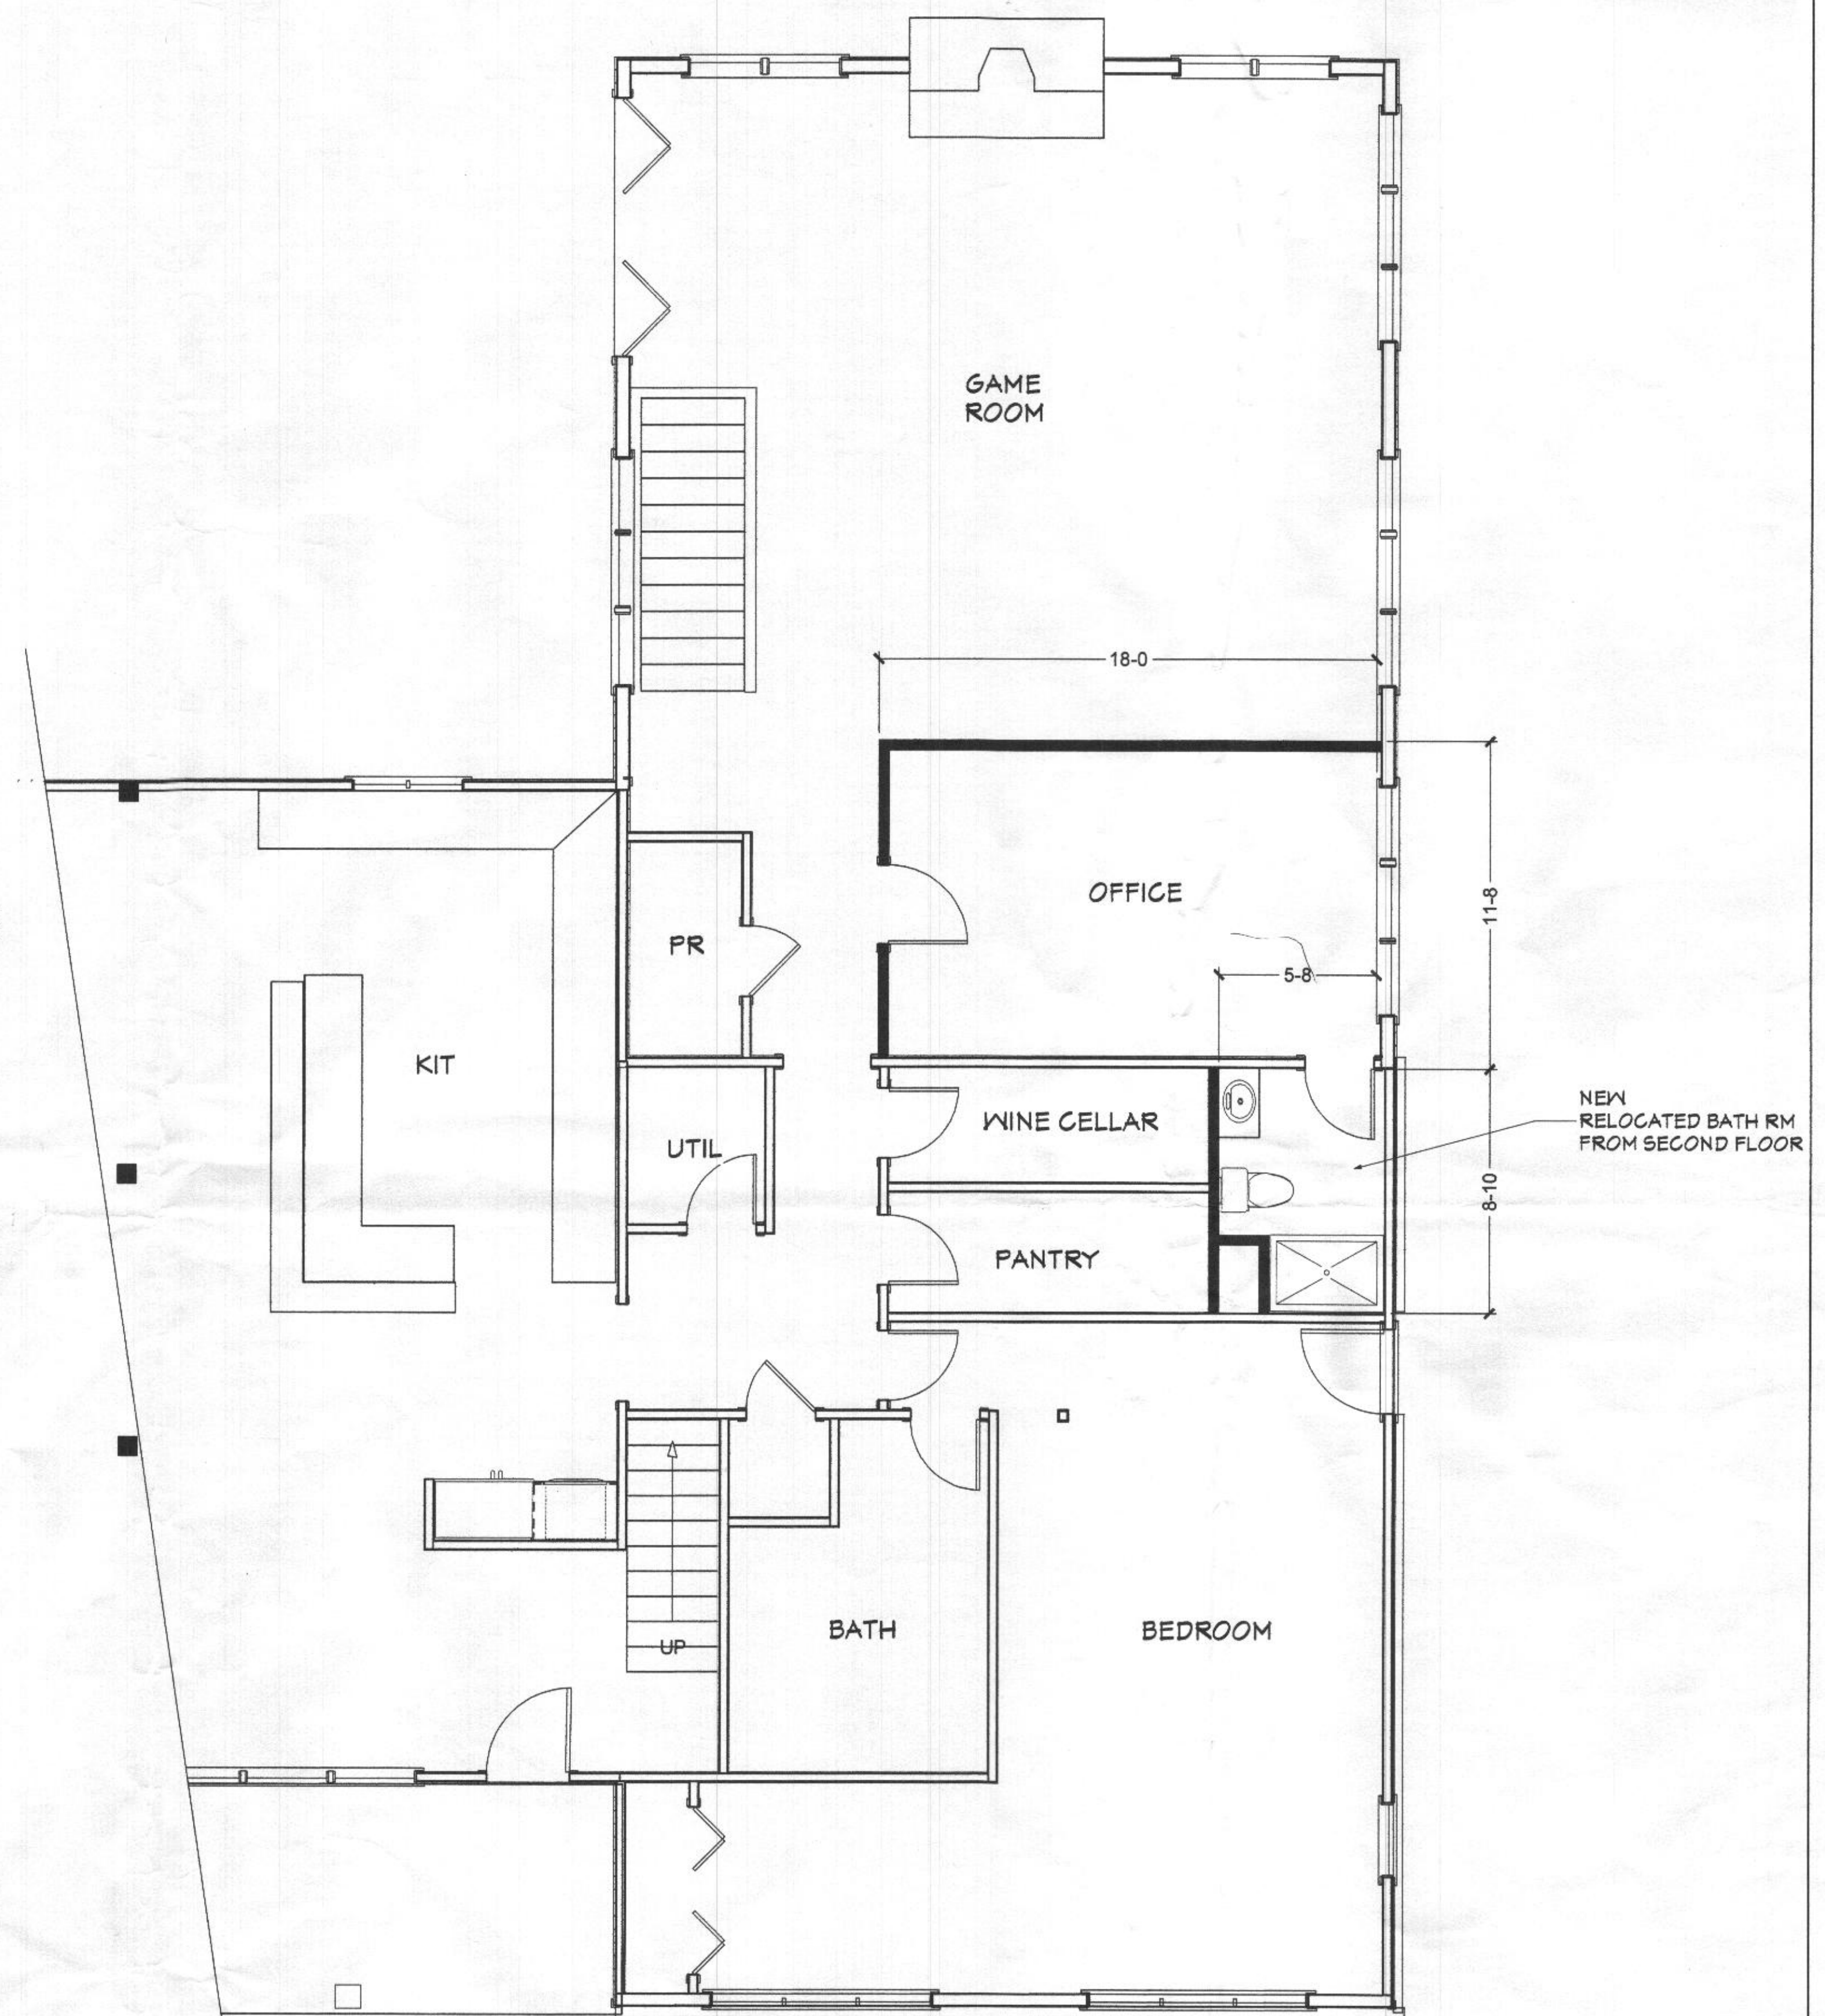

PART FIRST FLOOR PLAN - RELOCATED BATHROOM, ADDED OFFICE
1/4" = 1'-0"


REVISIONS
5-1-25

JDK DESIGN CONCEPTS
LATONSVILLE MD 301.577.3652


SURBER
CONSTRUCTION
FREDERICK MD (301) 708-5041

ADDITIONS / RENOVATIONS TO
DISSANAYAKE RESIDENCE
13080 WILLIAMFIELD DRIVE
ELLICOTT CITY MD 21042

FIRST FLR - DEMOLITION
SECOND FLR - BATH/ OFFICE
MAY 2025
SCALE AS NOTED

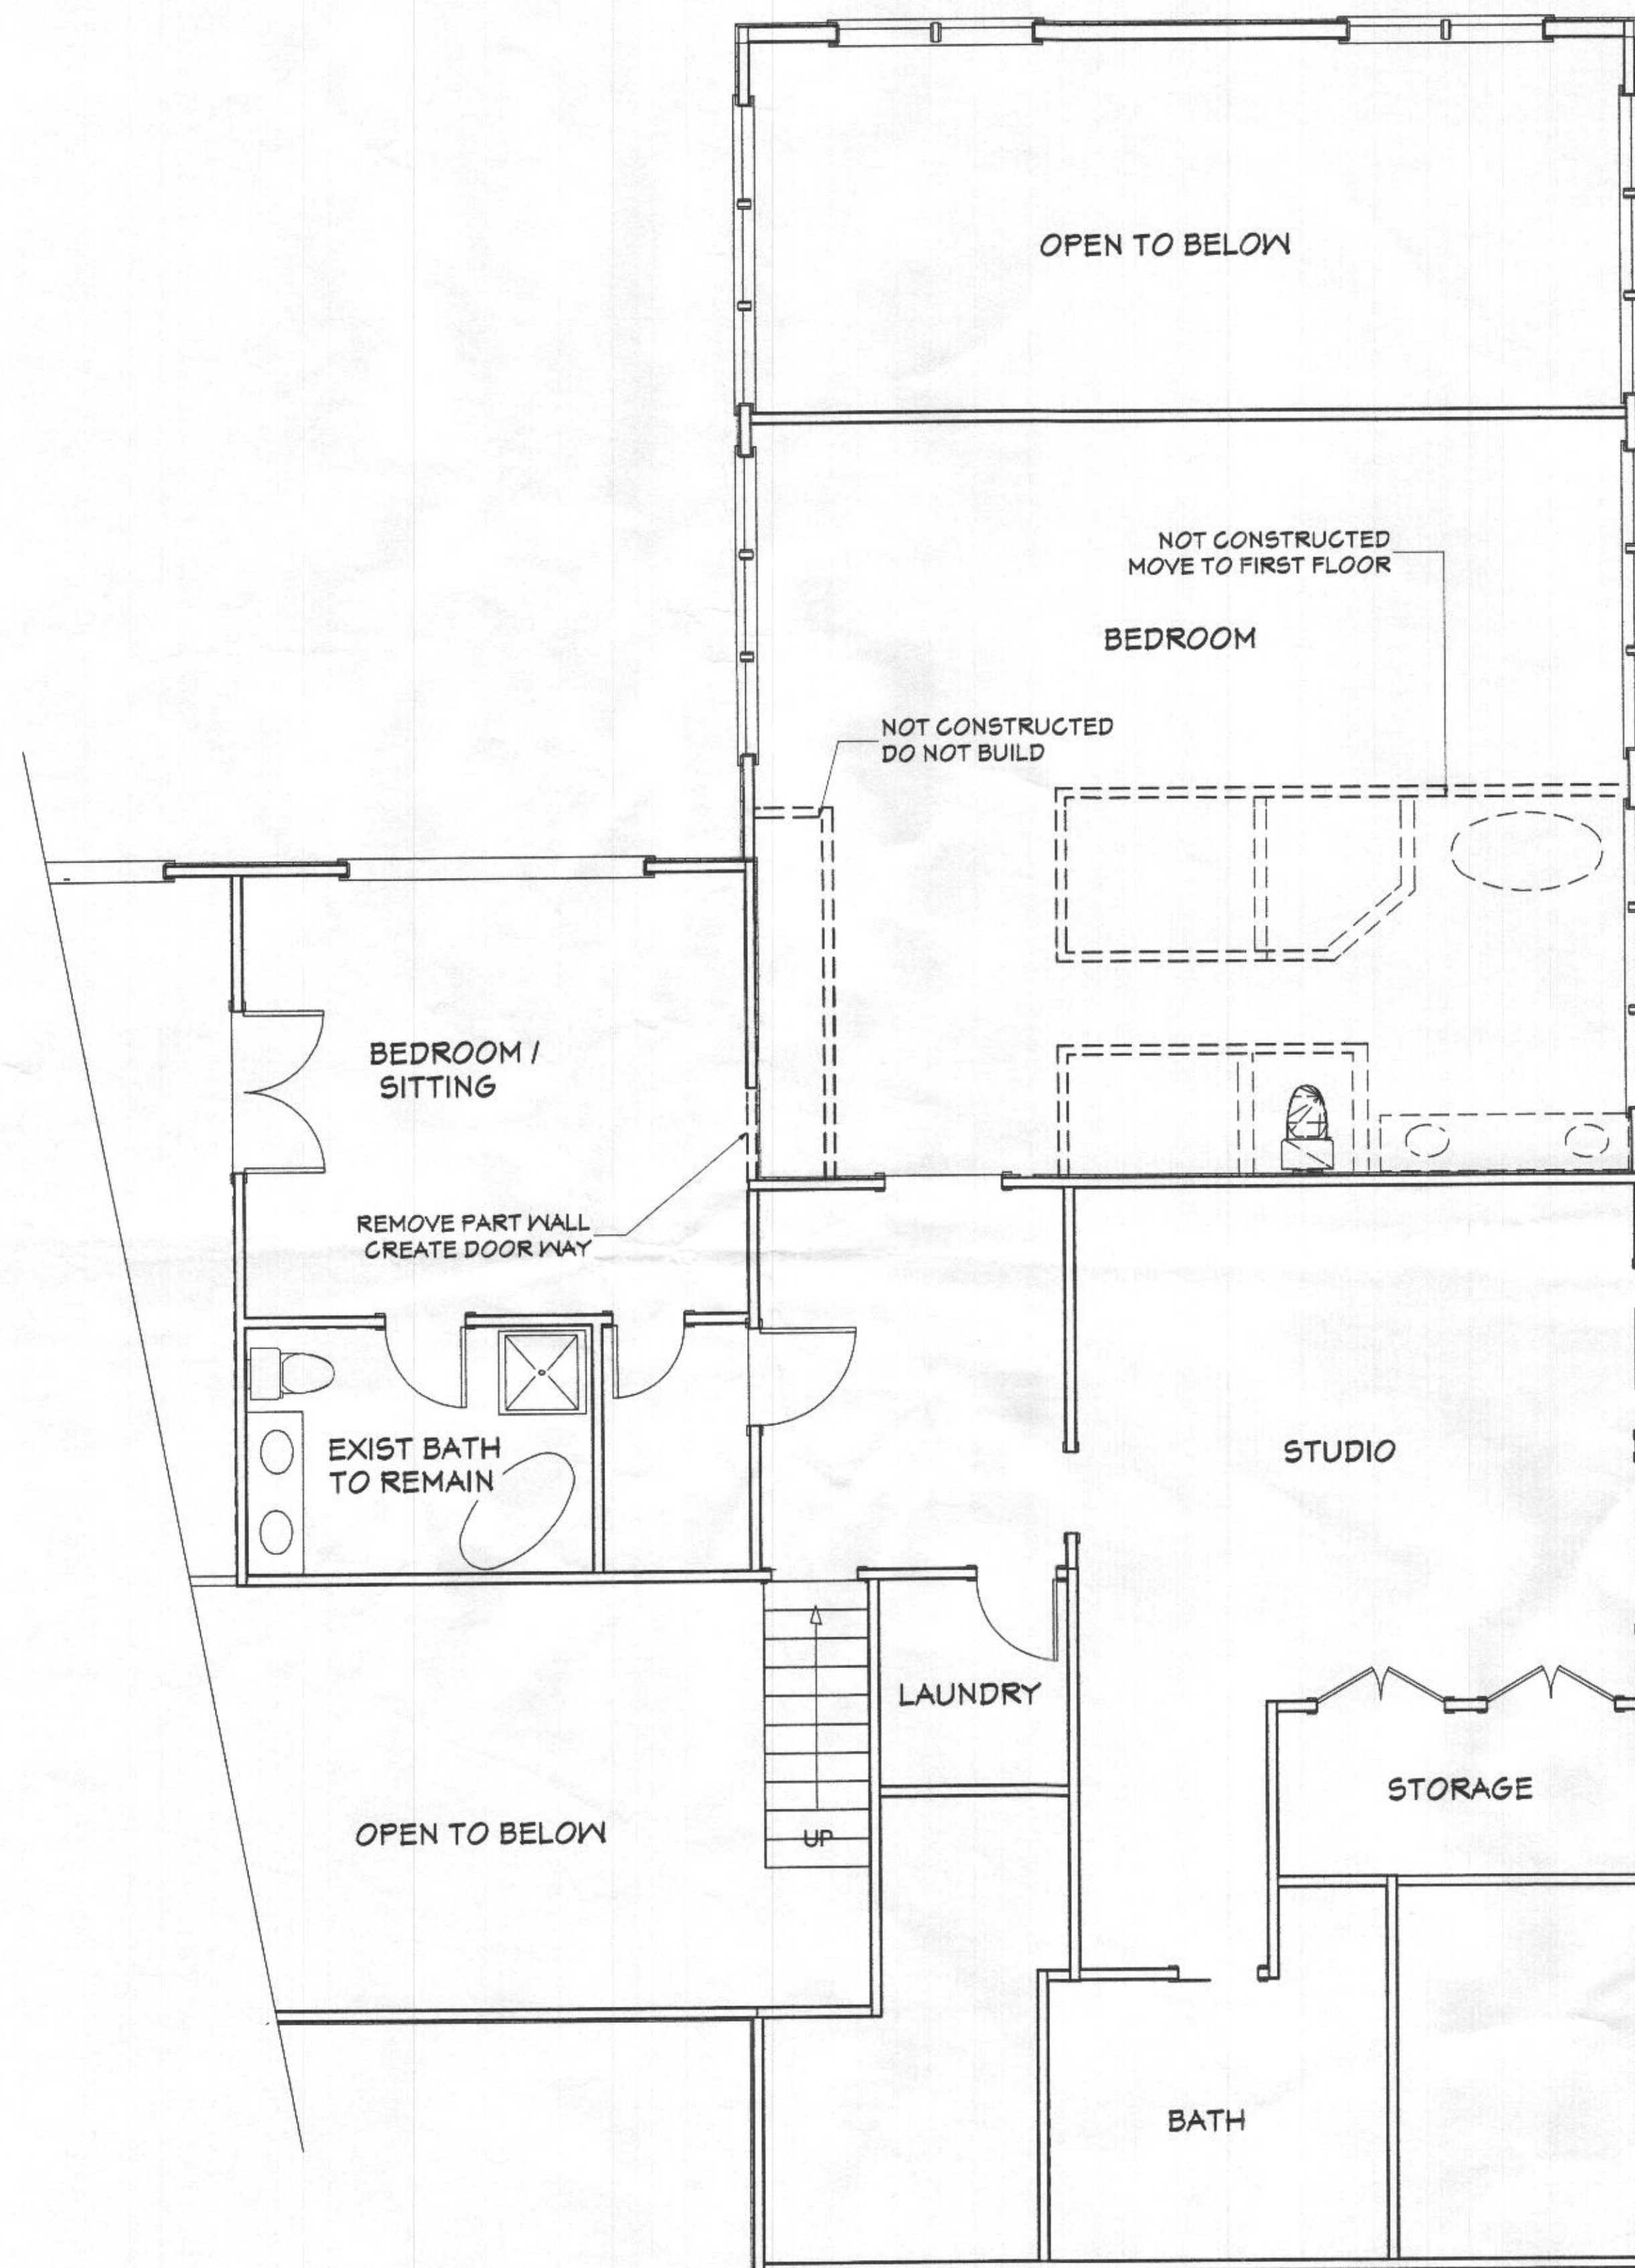

PART SECOND FLR- DEMOLITION
1/4" = 1'-0"

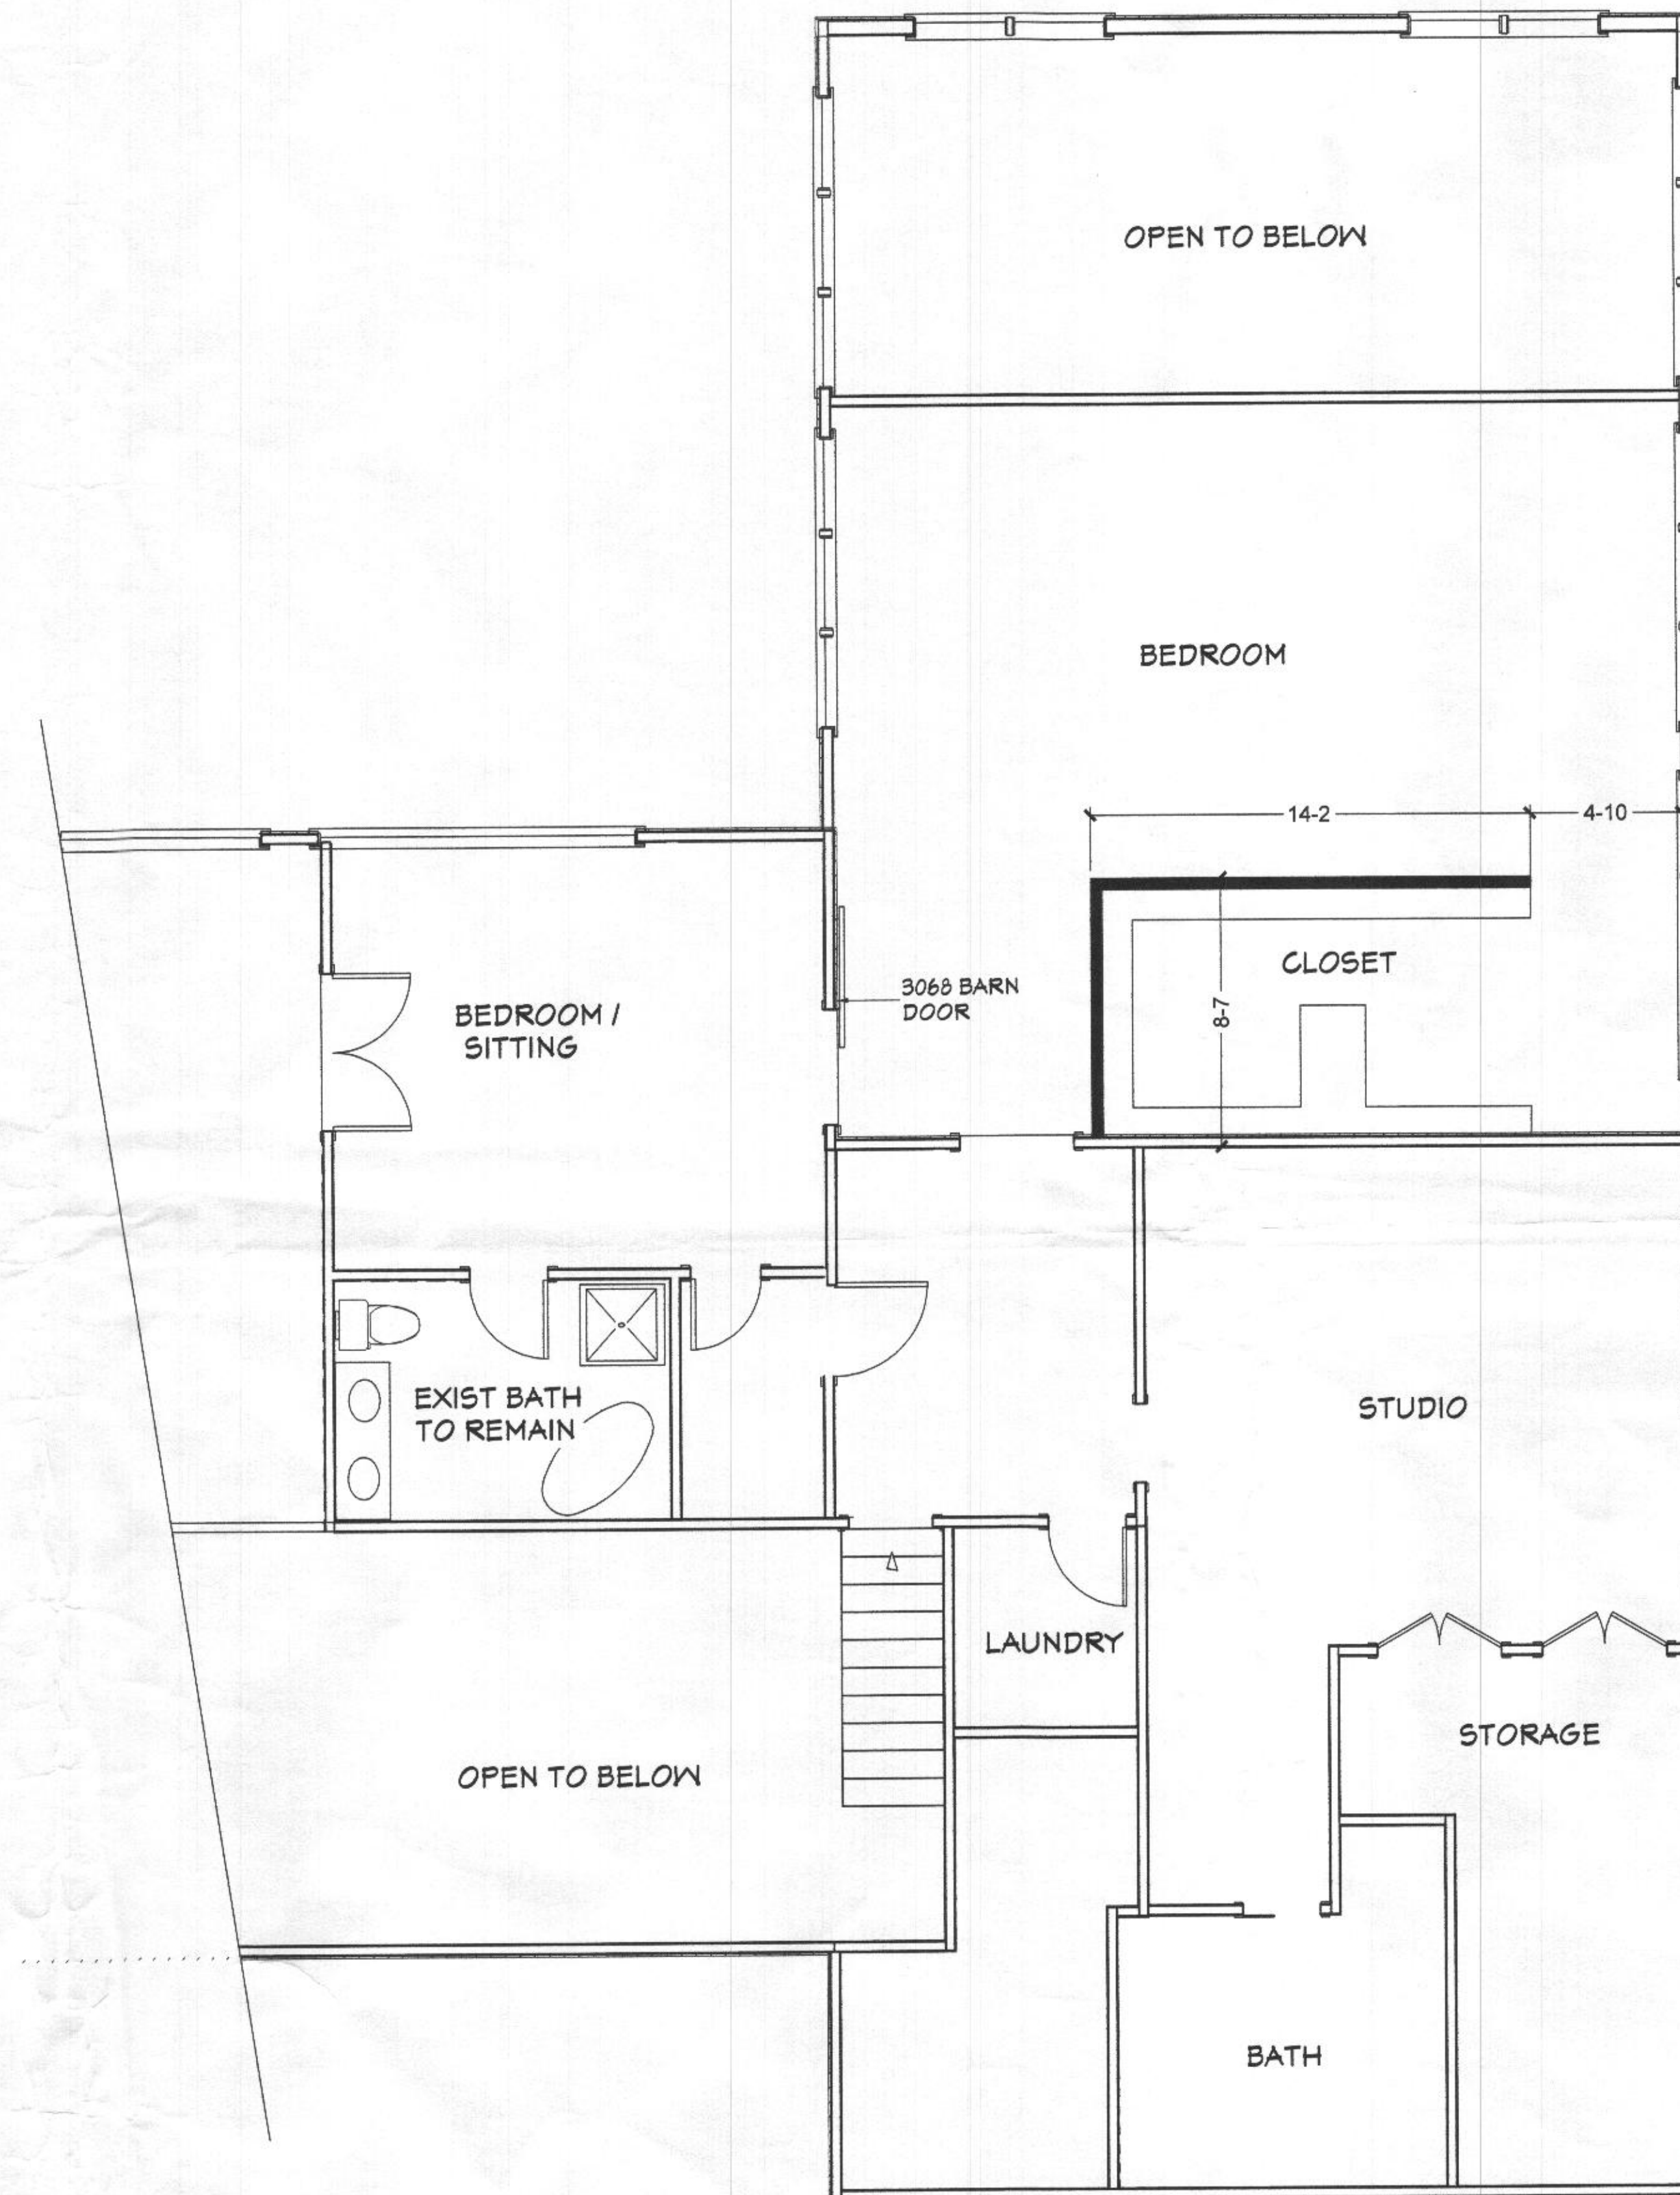

PART SECOND FLR- REMODELED BATH, ADDED CLOSET
1/4" = 1'-0"

REVISIONS
5-1-25

JDK DESIGN CONCEPTS
LATONSVILLE MD 301-977-9652

**SURBER
CONSTRUCTION**
FREDERICK MD (301) 788-5041

ADDITIONS / RENOVATIONS TO
DISSANAYAKE RESIDENCE
13080 WILLIAMFIELD DRIVE
ELLICOTT CITY MD 21042

SECOND FLR - DEMOLITION
SECOND FLR - CLOSET/ BATH
MAY 2025
SCALE AS NOTED