

OR/Mb 7/29/25

MARYLAND DEPARTMENT OF THE ENVIRONMENT, WATER MANAGEMENT ADMINISTRATION
1800 Washington Blvd., Baltimore, Maryland 21230 (410) 537-3784

WATER WELL ABANDONMENT-SEALING REPORT FORM

SUBMIT COPIES OF COMPLETED FORM TO:

- * COUNTY ENVIRONMENTAL AGENCY (contact MDE, WMA if address needed)
- * WELL OWNER
- * MDE, WATER MANAGEMENT ADMINISTRATION, WELL PROGRAM

DATE WELL ABANDONED: 07-09-25 (month/day/year)

* PERMIT NUMBER OF ABANDONED WELL (if any)

* PERMIT NUMBER OF REPLACEMENT WELL:

HO - 73 - 2057

* PERSON ABANDONING WELL: Dillon Foley


WELL DRILLER'S LICENSE NUMBER: AWD 1163

CIRCLE: MWD / MSD / MGD

* OWNER'S NAME: GreyKell Dutton

* WELL LOCATION:
 COUNTY: Howard
 NEAREST TOWN: Fulton
 TAX MAP 0045 BLOCK: _____ PARCEL 0055
 SUBDIVISION: 2001
 SECTION: _____ LOT: 36
 STREET ADDRESS: 9431 Lovett Road

SITE LOCATION MAP

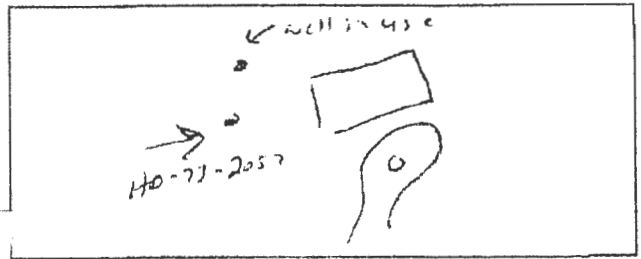

LATITUDE 39.124002

LONGITUDE 76.964451

LOG OF SEALING MATERIAL

MATERIAL	FEET	
	FROM	TO
<u>Benton Clay</u>	<u>160</u>	<u>0</u>
VOLUME OF MATERIAL USED		
<u>240 Gallons Bentonite</u>		

* TYPE OF WELL BEING ABANDONED:
 DRILLED _____ JETTED
 _____ BORED _____ HAND DUG
 _____ OTHER (specify) _____

* USE CODE:
 DOMESTIC _____ MUNICIPAL/PUBLIC
 _____ IRRIGATION _____ INDUSTRIAL
 _____ TEST/OBSERVATION _____ GEOTHERMAL

* TYPE OF CASING:
 STEEL _____ PLASTIC
 _____ CONCRETE _____ OTHER (specify) _____

SIZE OF CASING: 4 INCHES IN DIAMETER

DEPTH OF WELL: 160 FEET DEEP

WAS ANY CASING REMOVED? YES _____ NO
If yes, length removed, in feet: 4 FT

WAS CASING RIPPED OR PERFORATED? _____ YES NO

SIGNATURE OF MASTER WELL DRILLER OR SUPERVISING SANITARIAN LICENSE#

[Handwritten Signature]

553 (MWD) MSD / MGS
CIRCLE ONE

07-09-25 DATE

ORIGINAL

Pursuant to § 10-624 of the State Govt. Article of the Maryland Code, personal info requested on this form is used in processing this form pursuant to COMAR 26.04.04. Failure to provide the info may result in this form not being processed. You have the right to inspect, amend, or correct this form. The Maryland Department of the Environment is subject to the Maryland Public Information Act. This form may be made available on the Internet via MDE's website and is subject to inspection or copying, in whole or in part, by the public and other governmental agencies, if not protected by federal or State Law.

MARYLAND DEPARTMENT OF THE ENVIRONMENT, WATER MANAGEMENT ADMINISTRATION
1800 Washington Blvd., Baltimore, Maryland 21230 (410) 537-3784

WATER WELL ABANDONMENT-SEALING REPORT FORM

SUBMIT COPIES OF COMPLETED FORM TO:

- * COUNTY ENVIRONMENTAL AGENCY (contact MDE, WMA if address needed)
- * WELL OWNER
- * MDE, WATER MANAGEMENT ADMINISTRATION, WELL PROGRAM

DATE WELL ABANDONED: 07-09-25 (month/day/year)

* PERMIT NUMBER OF ABANDONED WELL (if any)

* PERMIT NUMBER OF REPLACEMENT WELL:

HO - 73 - 2057

* PERSON ABANDONING WELL: Dillon Fahy


WELL DRILLER'S LICENSE NUMBER: AWD 1163

CIRCLE: MWD / MSD / MGD

* OWNER'S NAME: Greykell Dutton

SITE LOCATION MAP

* WELL LOCATION:
COUNTY: Howard
NEAREST TOWN: Fulton
TAX MAP 0045 BLOCK 0055 PARCEL 0055
SUBDIVISION: 2001
SECTION: _____ LOT: 36
STREET ADDRESS: 9431 Lovat Road

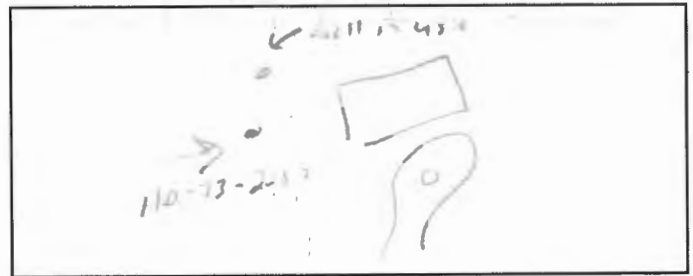

LATITUDE 3 39.4735

LONGITUDE 7 76.9392

LOG OF SEALING MATERIAL

MATERIAL	FEET	
	FROM	TO
<u>Ben-bu clay</u>	<u>160</u>	<u>0</u>
VOLUME OF MATERIAL USED		
<u>240 Gallons Ben-bu</u>		

* TYPE OF WELL BEING ABANDONED:
 DRILLED _____ JETTED
 BORED _____ HAND DUG
 OTHER (specify) _____

* USE CODE:
 DOMESTIC _____ MUNICIPAL/PUBLIC
 IRRIGATION _____ INDUSTRIAL
 TEST/OBSERVATION _____ GEOTHERMAL

* TYPE OF CASING:
 STEEL _____ PLASTIC
 CONCRETE _____ OTHER (specify) _____

SIZE OF CASING: 6 INCHES IN DIAMETER

DEPTH OF WELL: 160 FEET DEEP

WAS ANY CASING REMOVED? YES _____ NO
If yes, length removed, in feet: 4 FT

WAS CASING RIPPED OR PERFORATED? _____ YES NO

SIGNATURE-MASTER WELL DRILLER OR SUPERVISING SANITARIAN LICENSE#

553 MWD / MSD / MGS 07-09-25 CIRCLE ONE DATE

COUNTY

Pursuant to § 10-624 of the State Govt. Article of the Maryland Code, personal info requested on this form is used in processing this form pursuant to COMAR 26.04.04. Failure to provide the info may result in this form not being processed. You have the right to inspect, amend, or correct this form. The Maryland Department of the Environment is subject to the Maryland Public Information Act. This form may be made available on the Internet via MDE's website and is subject to inspection or copying, in whole or in part, by the public and other governmental agencies, if not protected by federal or State Law.