

HOWARD COUNTY
PERMIT APPLICATION

PERMIT NUMBER

000159341

Building Address 2621 Wynfield Rd
West Friendship 21794

Suite/Apt. #: _____ SDP/WP/Petition #: _____

Census Tract _____ Subdivision W. Friendship

Section _____ Area _____ Lot 10

Tax Map 15 Parcel 34 Grid 18

Zoning _____ Map Coordinates _____ Lot size 3.29

Existing Use SFD

Proposed Use Inground pool

Estimated Construction Cost \$ 20,000


Description of Work 23' x 40' inground pool,
3 1/2 to 8 1/2' depth, fence to
code, filled by truck

Property Owner's Name Christopher Thorpe

Address 2621 Wynfield Rd

City West Friendship State _____ Zip Code 21794

Home Phone _____ Work Phone _____

Appl.  Mrs. Karen H. Klayman stated hereon: 410-507

293 Southland Ct.

Dunkirk, MD 20754 7705

Co _____

Cc _____

— SUNRISE POOLS

1460 Ritchie Hwy. Suite 108

Arnold, Md. 21012

410-349-3852

M.H.I.C. 45494A

C _____

Li _____

Phone _____

Occupant or Tenant _____

Contact Name _____

Address _____

City _____ State _____ Zip Code _____

Phone _____ Fax _____

Engineer or Architect Company _____

Contact Person _____

Address _____

City _____ State _____ Zip Code _____

Phone _____ Fax _____

BUILDING DESCRIPTION - COMMERCIAL

BUILDING DESCRIPTION - RESIDENTIAL

Building Characteristics

Utilities

Height: _____

No. of stories: _____

Gross area, sq. ft. per floor: _____

Use group: _____

Construction type:

_____ Reinforced Concrete

_____ Structural Steel

_____ Masonry

_____ Wood Frame

_____ State Certified Modular

Water Supply:

_____ Public

_____ Private

Sewage Disposal:

_____ Public

_____ Private

Electric Yes ☐ No ☐

Gas Yes ☐ No ☐

Heating System:

Electric ☐ Oil ☐

Natural Gas ☐

Propane Gas ☐

Sprinkler system: N/A ☐

_____ Full

_____ Partial

_____ Other Suppression

_____ # of Heads

Building Characteristics

Utilities

SF Dwelling ☐ SF Townhouse ☐

Depth Width

1st floor: _____

2nd floor: _____

Basement: _____

Finished Basement ☐ Unfinished Basement ☐

Crawl space ☐ Slab on Grade ☐

No. of Bedrooms _____

Height: _____

Multi-family dwellings:

No. of efficiency units: _____

No. of 1 BR units: _____

No. of 2 BR units: _____

No. of 3 BR units: _____

Other Structure: _____

Dimensions: _____

Footings: _____

Roof Height: _____

_____ State Certified Modular

_____ Manufactured Home

Water Supply:

_____ Public

☒ Private

Sewage Disposal:

_____ Public

_____ Private

Electric Yes ☐ No ☐

Gas Yes ☐ No ☐

Heating System:

Electric ☐ Oil ☐

Natural Gas ☐

Propane Gas ☐

Sprinkler system: N/A ☐

_____ NFPA #13D

_____ NFPA #13R

_____ Other:

THE UNDERSIGNED HEREBY CERTIFIES AND AGREES AS FOLLOWS: (1) THAT HE/SHE IS AUTHORIZED TO MAKE THIS APPLICATION; (2) THAT THE INFORMATION IS CORRECT; (3) THAT HE/SHE WILL COMPLY WITH ALL REGULATIONS OF HOWARD COUNTY WHICH ARE APPLICABLE THERETO; (4) THAT HE/SHE WILL PERFORM NO WORK ON THE ABOVE REFERENCED PROPERTY NOT SPECIFICALLY DESCRIBED IN THIS APPLICATION; (5) THAT HE/SHE GRANTS COUNTY OFFICIALS THE RIGHT TO ENTER ONTO THIS PROPERTY FOR THE PURPOSE OF INSPECTING THE WORK PERMITTED AND POSTING NOTICES.

Applicant's Signature

Print Name

Date

Checks payable to: **DIRECTOR OF FINANCE OF HOWARD COUNTY**

** PLEASE WRITE NEATLY AND LEGIBLY. **

- FOR OFFICE USE ONLY -

AGENCY DATE SIGNATURE APPROVAL

Land Development, DPZ

State Highways

Building Official

Dev. Engineering, DPZ

Health 5/2/06 [Signature]

Fire Protection

Is Sediment Control approval required prior to issuance?

YES ☐ NO ☐

CONTINGENCY CONSTRUCTION START: ☐

ONE STOP SHOP: ☐

Distribution of Copies-

White: Building Official

Green: LDD, DPZ

Yellow: DED, DPZ

Pink: Health

Gold: SHA

T:\norma\PERMIT.FRM

DPZ SETBACK INFORMATION

PROPERTY ID#:

Front: _____ Filing fee \$ _____

Rear: _____ Permit fee \$ _____

Side: _____ Excise tax \$ _____

Side St.: _____ Add'l per. fee \$ _____

All minimum setbacks met? TOTAL FEES \$ _____

YES ☐ NO ☐ Sub-total paid \$ _____

Is Entrance Permit required? Balance due \$ _____

YES ☐ NO ☐ Check # _____

Historic District? Validation # _____


YES ☐ NO ☐

Lot Coverage for NewTown Zone _____

SDP/Red-line approval date _____ Accepted by _____

NOTES:

- 1) B.P.L. information, if shown, was obtained from existing record plat or local agencies and is not guaranteed by NTT, Inc.
- 2) Building line and/or Flood Zone information is subject to the interpretation of the originator.
- 3) NTT, Inc. does not certify to unknown or unrecorded encroachments or overlaps.
- 4) Property markers NOT found, or guaranteed by this location.
- 5) Setback distances accuracy 1/2"

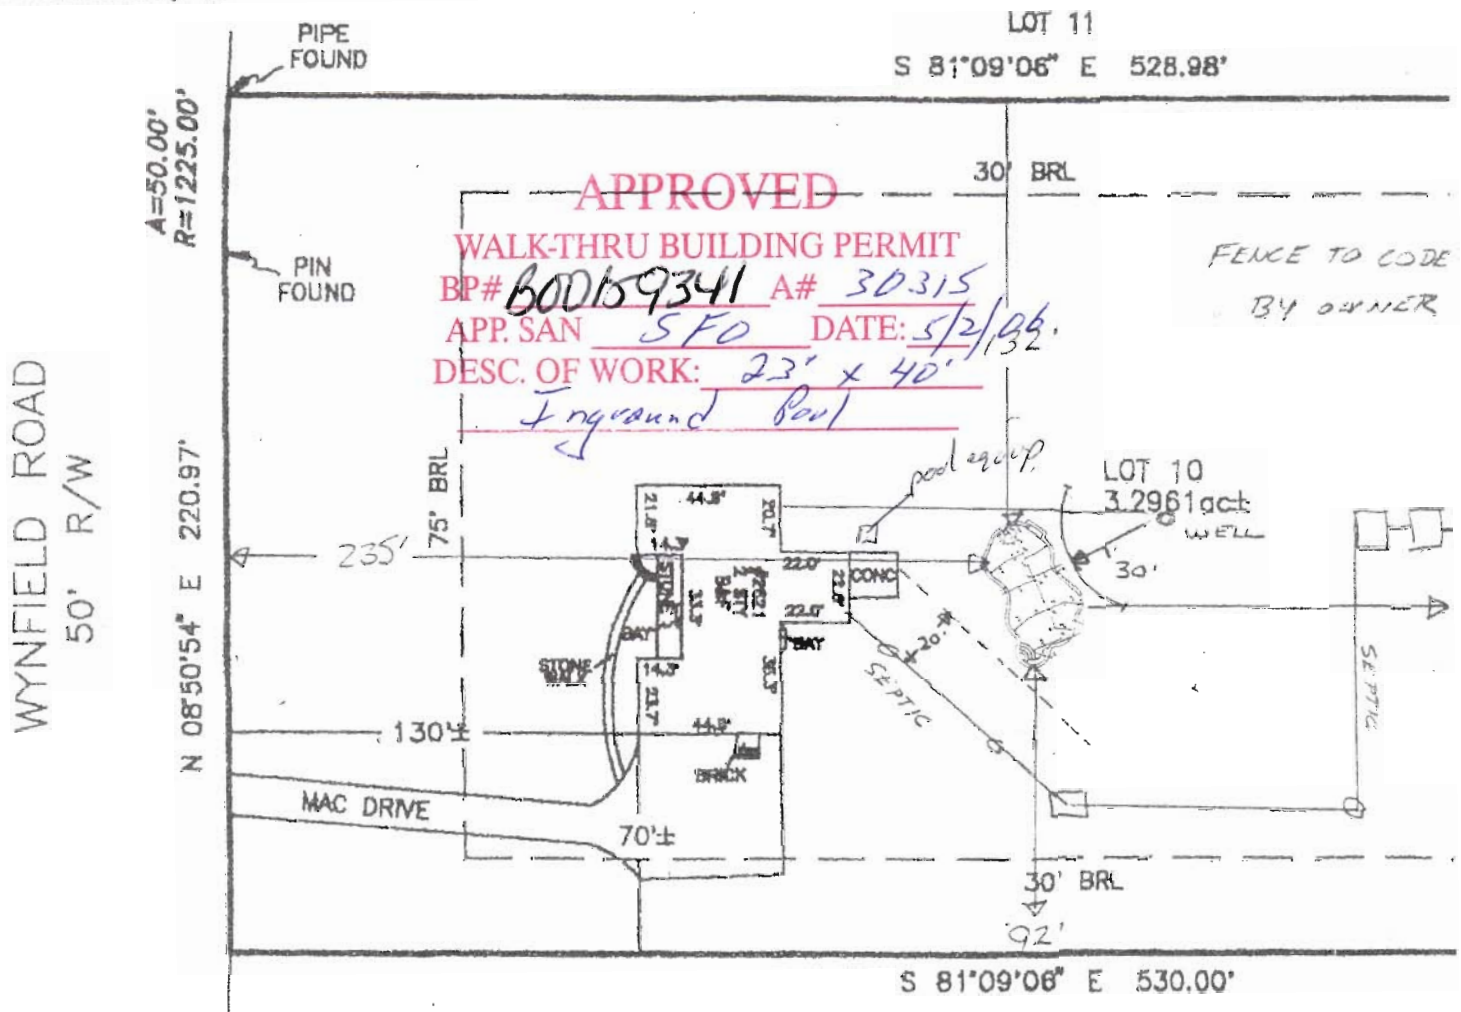

Subject property is shown in Zone C
on the FIRM Map of HOWARD COUNTY,
Maryland on Community Panel
240044 0015 B.Effective DECEMBER 4, 1986

This is to certify that I have surveyed the property shown hereon,
being known as LOT 10 FINAL PLAT SECTION 1
SHEET 1 OF 2 "WYNFIELD"
and recorded among the land records of HOWARD County,
Maryland in Plat 4870, folio
for the purpose of locating the improvements thereon.

- * This plat is of benefit to the consumer only insofar as it is required by a lender or a title insurance company or its agent in connection with contemplated transfer, financing, or refinancing purposes.
- * This plat is not to be relied upon for the establishment of location of fences, garages, buildings, or other existing or future structures.
- * This plat does not provide for the accurate identification of property boundary lines, but such identification may not be required for the transfer of title or for securing financing or refinancing.



NTT A
16205
Mt. Airy
Ph.
Fax N