
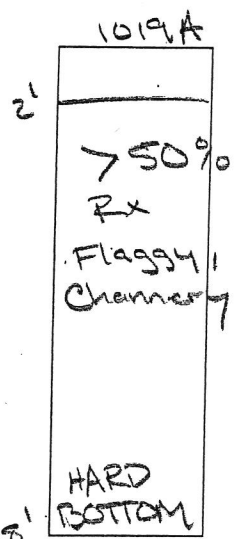
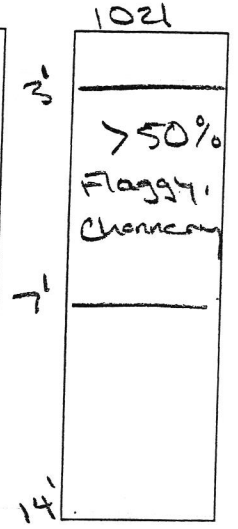
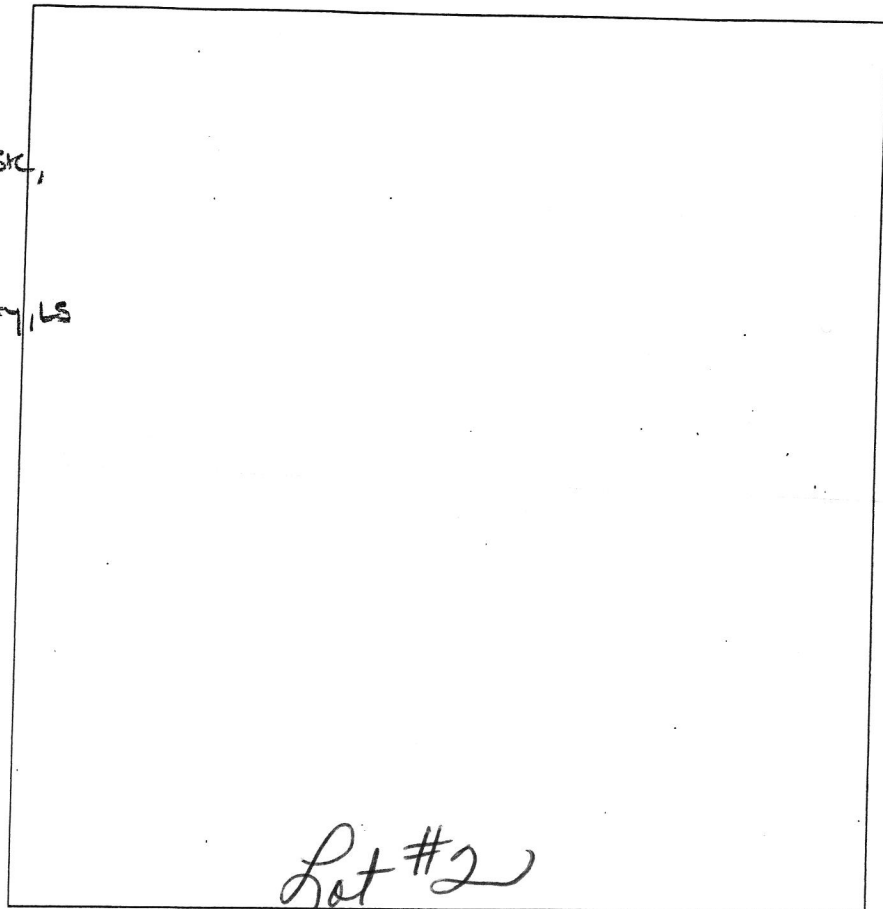
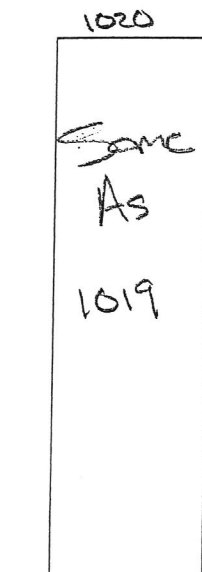
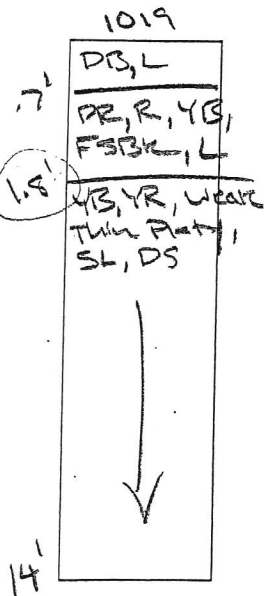



AP _____

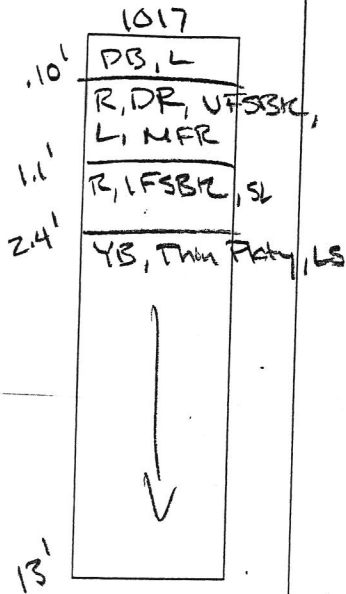

DATE	TEST #	DEPTH	START	BREAK 1" DROP	STOP 2" DROP	TIME OF 2ND INCH	P/F/H
5/14/2018	1017	55 / 13	12:26	12:32	12:40	8	P
	1019	5 / 14	12:52	12:55	12:58	4	P
	1020	4 / 13	1:16	1:20	1:26	6	P
	1021	14	VISUAL				F
	1019A	8	VISUAL				F

REMARKS _____
 SANITARIAN RSG BACKHOE _____ OTHERS _____
 TEST HOLES USED IN SDA _____ AVG. PERC TIME _____ SQ. FT/BR _____
 TRENCH WIDTH _____ INLET DEPTH _____ MAX. BOT DEPTH _____ EFFECTIVE SW _____

1711 Bruball Way

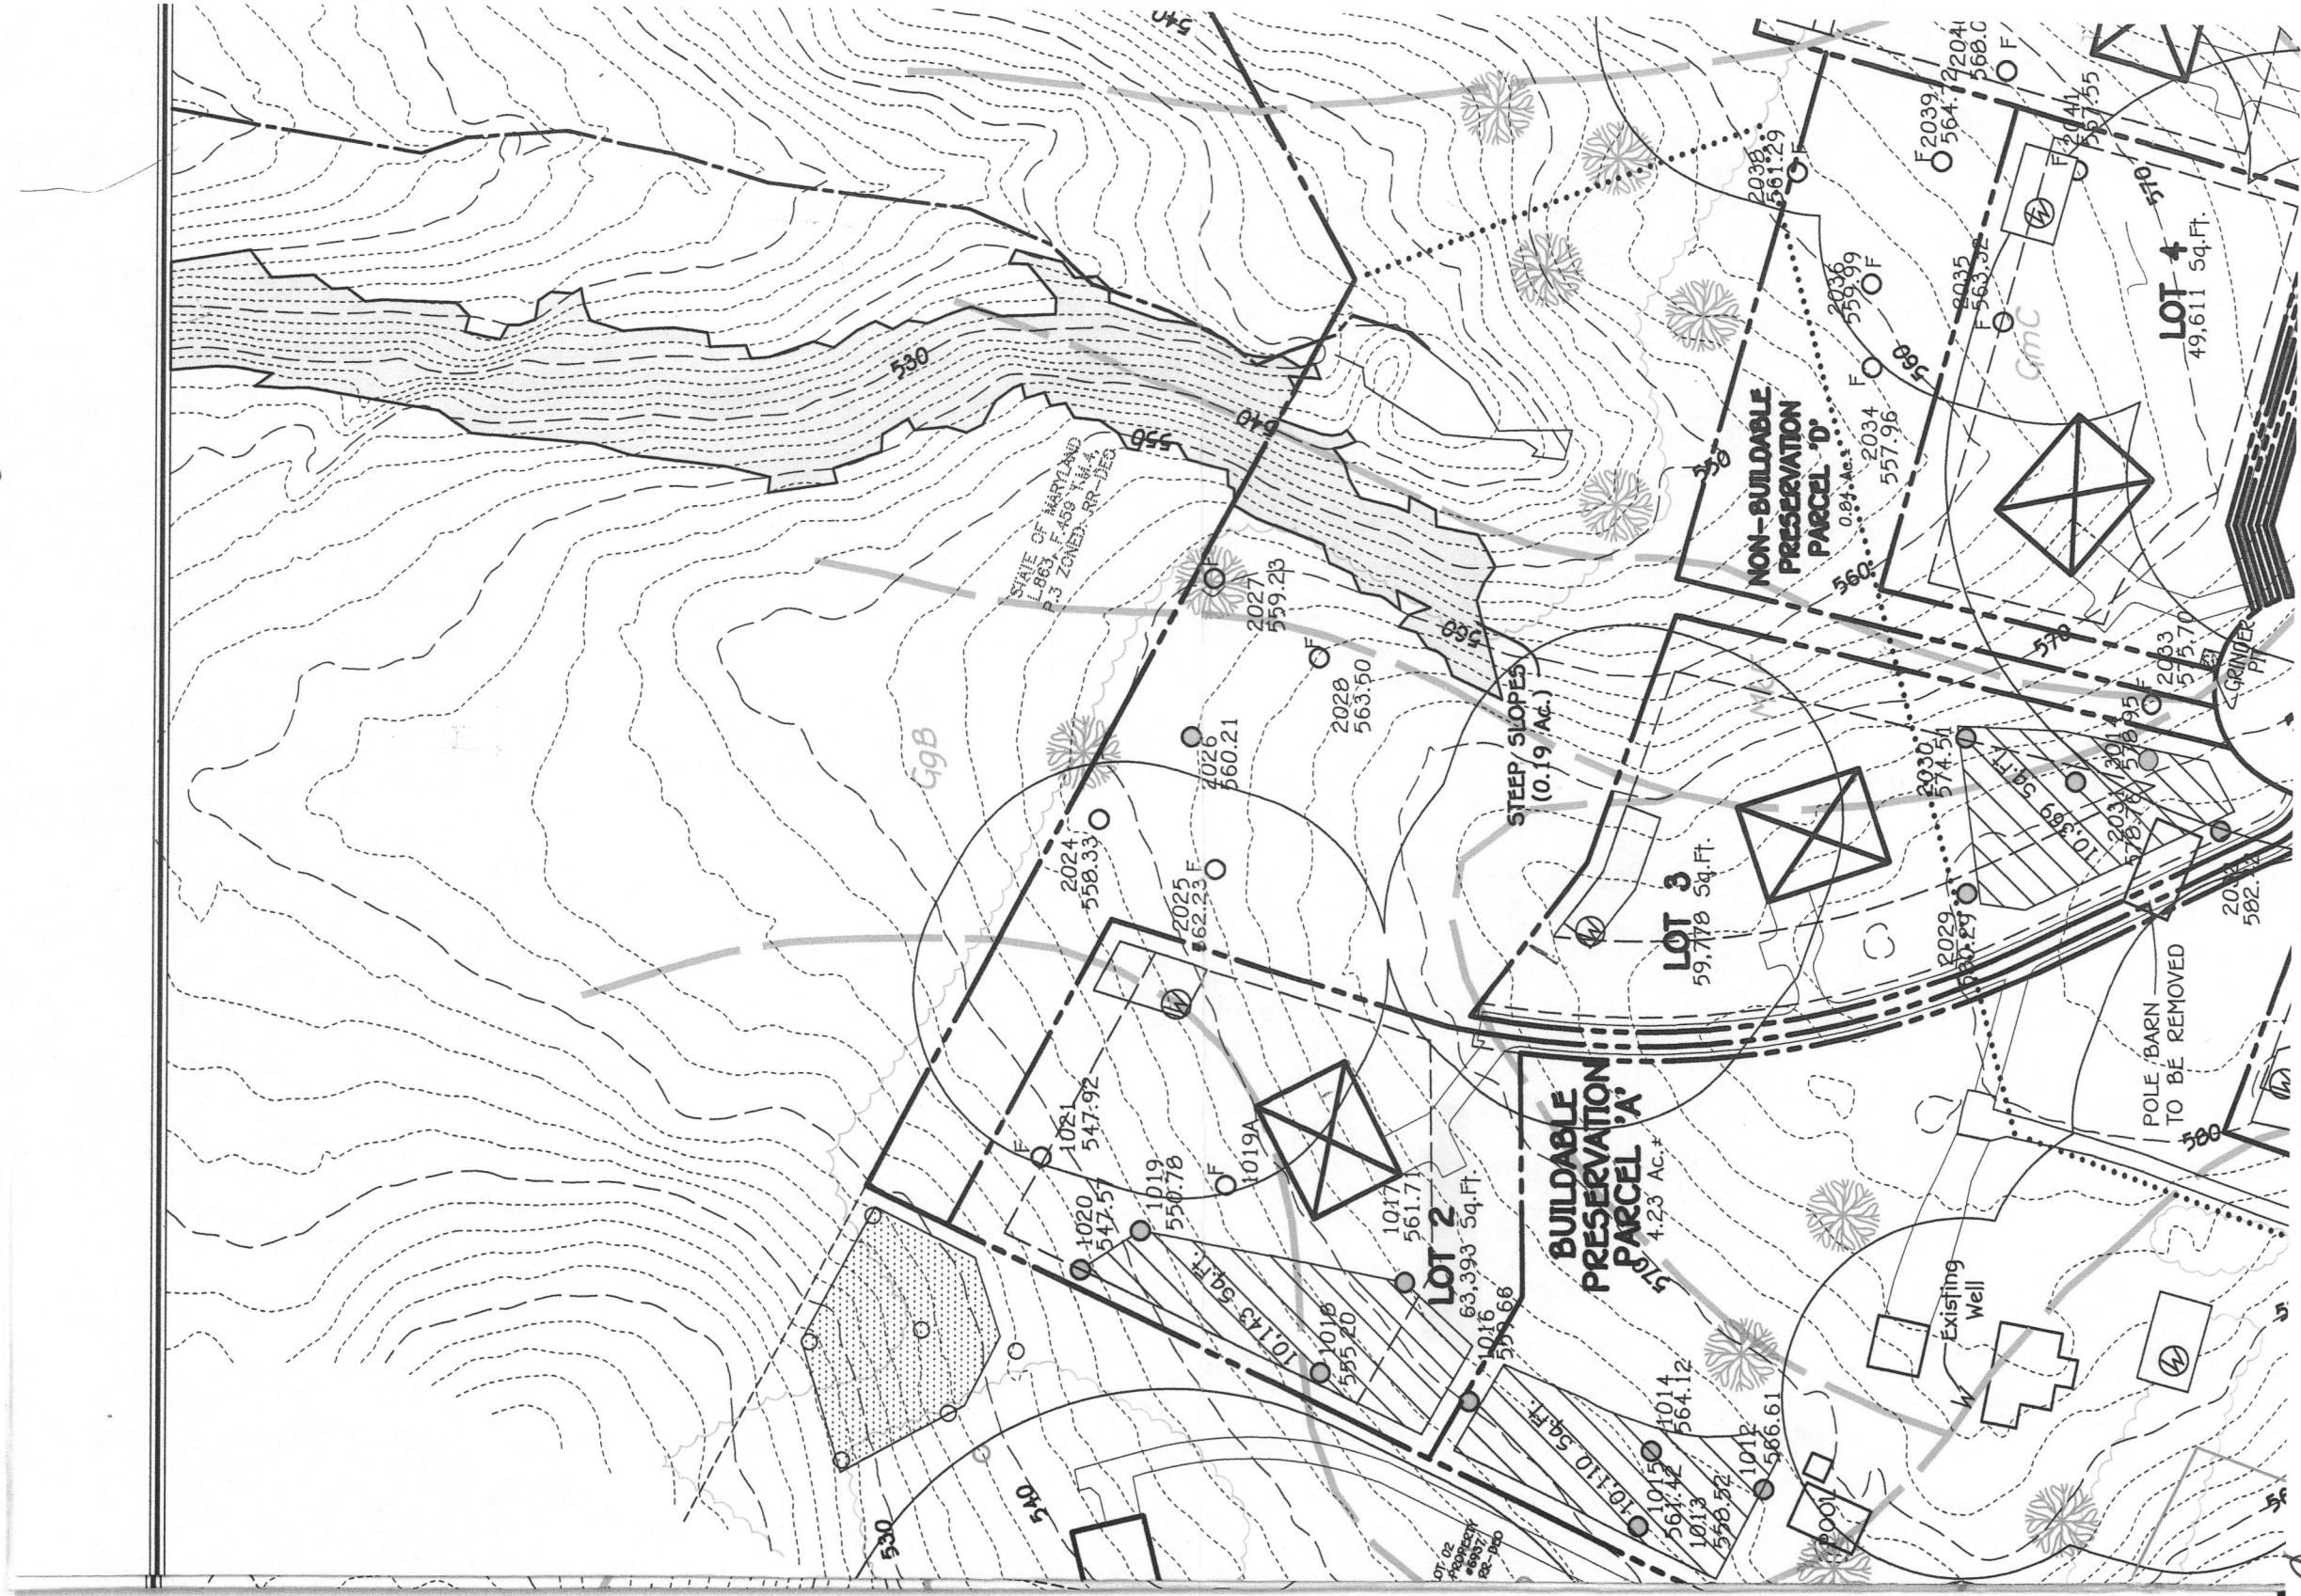

Copy Approved PC 6/21/2019 RB