

SITE INSPECTION SHEET

OWNER: Swappil PHONE #: 205-441-1650


ADDRESS: 3018 Mullineux Ln CONTRACTOR: \_\_\_\_\_

Elliecott City WELL TAG #: No Tag

SUBDIVISION: \_\_\_\_\_ LOT: \_\_\_\_\_ COUNTY #: 13

PROPOSAL: Owner would like BRF to upgrade or connect to county sewer. Inspected septic condition.

LOCATION DIAGRAM

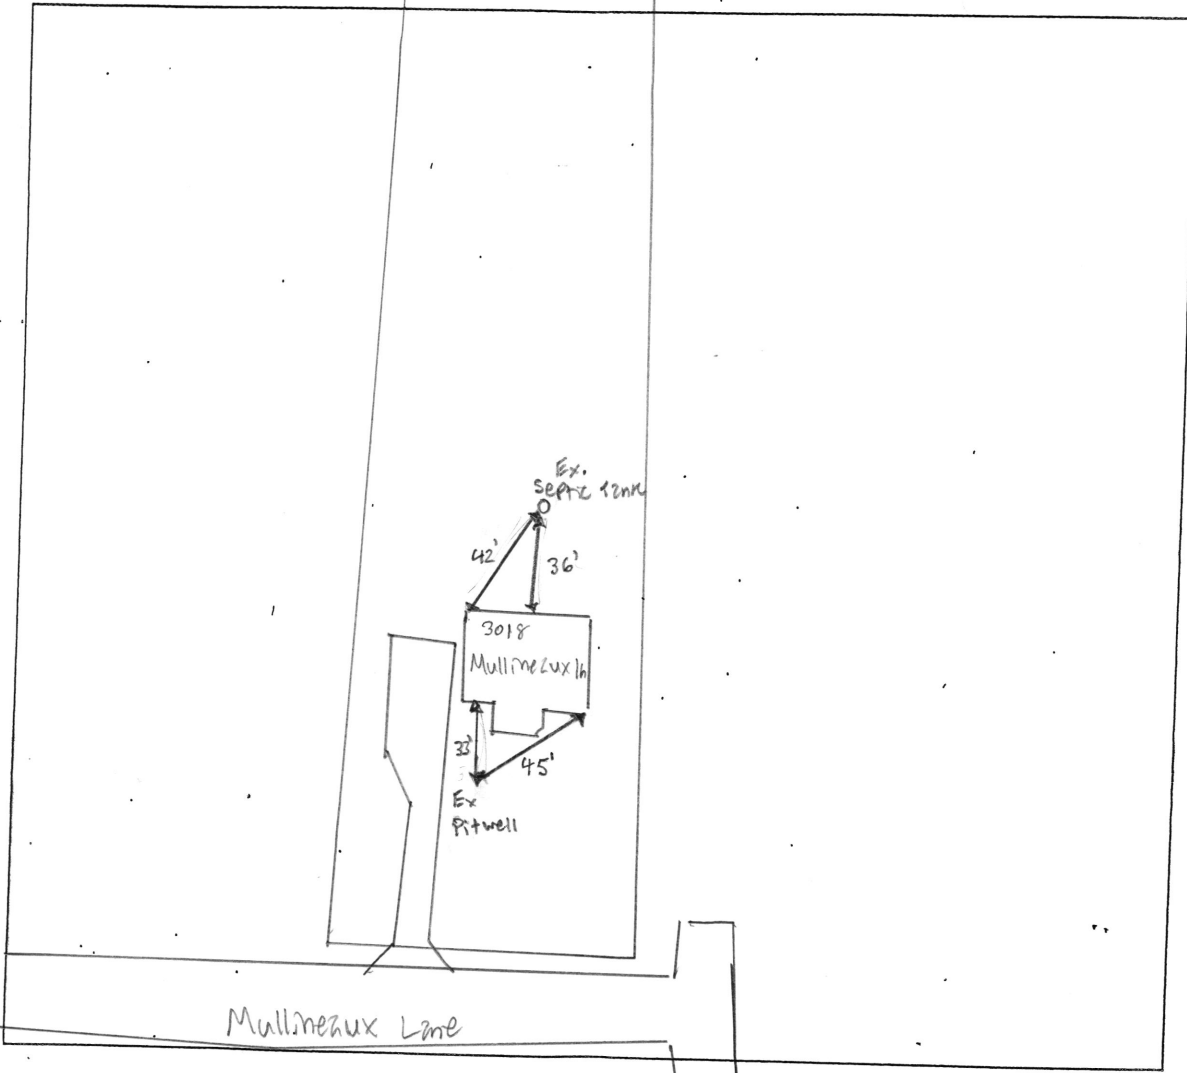

COMMENTS: 7/11/2024 - Met w/ Homeowner to verify septic condition. Homeowner had sewage coming back into house, had to replace inside plumbing. Area around septic stripped of grass (see attached image) due to sewage surfacing. Neighbor has also complaint of sewage smell. Homeowner has contracted S. Carroll Betcher to assess septic system. SP/MB

DATE: 7/11/2024.

INSPECTOR: S. Paige M. Burns

## Williams, Jeffrey

---

**From:** Swapnil Konde <swapnilkonde@gmail.com>  
**Sent:** Wednesday, July 10, 2024 11:09 AM  
**To:** Williams, Jeffrey  
**Subject:** 3018 Mullineaux Lane Ellicott City

[Note: This email originated from outside of the organization. Please only click on links or attachments if you know the sender.]

Good Morning Jeff,

We have septic and which looks like failing and would like to upgrade or connect to county sewer. We would like to apply for BRS grant. I will appreciate if you could call me at +12054411650

Thanks,  
Swapnil  
Sent from my iPhone