

OS-354889

EMERGENCY TEMP NO. IF ANY

B 1	86684	SEQUENCE NO. (MDE-USE ONLY)	STATE OF MARYLAND APPLICATION FOR PERMIT TO DRILL WELL please type	STATE PERMIT NUMBER #0-20-0203 fill in this form completely
-----	-------	-----------------------------	--	---

1 2 3 6

Date Received (APA)

OWNER INFORMATION

8 MM DD YY 13
Lakehart ETAL Milton + Christine

15 Last Name Owner First Name 34
12000 Hall Shop Rd

36 Clarksville MD 21029

57 Town 70 State 72 Zip 76

B 2

LOCATION OF WELL

8 COUNTY Howard 21

23 SUBDIVISION

SECTION 24 46 LOT 48 50
Clarksville

52 NEAREST TOWN 71

DRILLER INFORMATION

Driller's Name Michael Kohler M S 028
76 License No. 81

Firm Name Allied Well Drilling

Address PO Box 129 Annapolis Junction MD 20701

Signature Michael J. Kohler Date 07/12/22

SOURCES OF DRILLING WATER

1. Public

11 STREET ADDRESS 38
12000 NW Hall Shop Rd

ON WHICH SIDE OF ROAD (CIRCLE APPROPRIATE BOX)

34 30 37
DISTANCE FROM ROAD

ENTER FT OR MI 38 39

TAX MAP: 0035 BLK: PARCEL 0278

B 2

WELL INFORMATION

APPROX. PUMPING RATE (GAL. PER MIN.) 10
8 12

AVERAGE DAILY QUANTITY NEEDED (GAL. PER DAY) 1,000
14 20

USE FOR WATER (CIRCLE APPROPRIATE BOX)

DOMESTIC POTABLE SUPPLY & RESIDENTIAL IRRIGATION

FARMING (LIVESTOCK WATERING & AGRICULTURAL IRRIGATION)

INDUSTRIAL, COMMERCIAL, DEWATERING

PUBLIC WATER SUPPLY WELL

TEST, OBSERVATION, MONITORING

OPEN LOOP GEOTHERMAL

CLOSED LOOP GEOTHERMAL

NOT TO BE FILLED IN BY DRILLER HEALTH DEPARTMENT APPROVAL

COUNTY NAME Howard COUNTY NO. 21

STATE SIGNATURE [Signature] INSERT S → 41

DATE ISSUED 07/12/22 EXP. DATE 07/12/25
43 MM DD YY 48

APPROXIMATE DEPTH OF WELL 400 FEET
24 28

APPROXIMATE DIAMETER OF WELL 6 INCH
NEAREST INCH

PROPOSED LOCATION OF WELL ON LOT

SHOW PERMANENT STRUCTURES SUCH AS BUILDINGS, SEPTIC SYSTEM, ROADS AND/OR LANDMARKS AND INDICATE NOT LESS THAN TWO DISTANCE MEASUREMENTS TO WELL

A B
72' 82'

Old well

Pursuant to § 10-624 of the State Govt. Article of the Maryland Code, personal info requested on this form is used in processing this form pursuant to COMAR 26.04.04. Failure to provide the info may result in this form not being processed. You have the right to inspect, amend or correct this form. The Maryland Department of the Environment is subject to the Maryland Public Information Act. This form may be made available on the Internet, MDE's website and is subject to inspection or copying, in whole or in part, by the public and other governmental agencies, if not protected by federal or State Law.

METHOD OF DRILLING (circle one)

BORED (or Augered) JETTED Jetted & DRIVEN

AIR-ROTary AIR-PERCussion ROTARY (Hydraulic Rotary)

CABLE REVERSE-ROTary DRIVE-POINT

other

REPLACEMENT OR DEEPEMED WELLS (CIRCLE APPROPRIATE BOX)

THIS WELL WILL NOT REPLACE AN EXISTING WELL

THIS WELL WILL REPLACE A WELL THAT WILL BE ABANDONED AND SEALED

THIS WELL WILL REPLACE A WELL THAT WILL BE USED AS A STANDBY-CONTACT LOCAL APPROVING AUTHORITY FOR POLICY ON STANDBY WELLS

THIS WELL WILL DEEPEM AN EXISTING WELL

PERMIT NUMBER OF WELL TO BE REPLACED OR DEEPEMED (IF AVAILABLE) 41 52

Not to be filled in by driller (MDE OR COUNTY USE ONLY)

APPROX. PERMIT NUMBER G

PERMIT No. #0-20-0203
70 71 72 73 74 75 76 77 78 79

SPECIAL CONDITIONS

NOTE APPROVING AUTHORITIES SHOULD USE SEPARATE SHEET IF NEEDED- RADIUM TEST. CALL FOR WATERLINE.

OS-354889

B 1 SEQUENCE NO. (MDE USE ONLY) STATE OF MARYLAND APPLICATION FOR PERMIT TO DRILL WELL STATE PERMIT NUMBER
 10 - 20 - 0203
 fill in this form completely

OWNER INFORMATION

8 MM DD YY 13
 15 Last Name Owner First Name 34
 36 Street or RFD 55
 57 Town 70 State 72 Zip 76

B 3 LOCATION OF WELL

8 COUNTY 21
 23 SUBDIVISION 42
 SECTION 44 46 LOT 48 50
 52 NEAREST TOWN 71

DRILLER INFORMATION

Driller's Name M D
 76 License No. 81
 Firm Name
 Address
 Signature Date

B 4 SOURCES OF DRILLING WATER

1. Public
 2.
 3.

11 STREET ADDRESS 30
 ON WHICH SIDE OF ROAD (CIRCLE APPROPRIATE BOX)
 NORTH N
 WEST W EAST E
 SOUTH S
 34 30 37
 DISTANCE FROM ROAD
 ENTER FT OR MI 38 39
 TAX MAP: 0035 BLK: PARCEL 0278

B 2 WELL INFORMATION

1 2
 APPROX. PUMPING RATE (GAL. PER MIN.) 8 12
 AVERAGE DAILY QUANTITY NEEDED (GAL. PER DAY) 14 20

USE FOR WATER (CIRCLE APPROPRIATE BOX)

DOMESTIC POTABLE SUPPLY & RESIDENTIAL IRRIGATION
 FARMING (LIVESTOCK WATERING & AGRICULTURAL IRRIGATION)
 INDUSTRIAL, COMMERCIAL, DEWATERING
 PUBLIC WATER SUPPLY WELL
 TEST, OBSERVATION, MONITORING
 OPEN LOOP GEOTHERMAL
 CLOSED LOOP GEOTHERMAL

NOT TO BE FILLED IN BY DRILLER HEALTH DEPARTMENT APPROVAL


COUNTY NAME COUNTY NO.
 STATE SIGNATURE INSERT S 41
 DATE ISSUED
 43 MM DD YY 48 CO SIGNATURE EXP. DATE

APPROXIMATE DEPTH OF WELL 400 FEET
 24 26

APPROXIMATE DIAMETER OF WELL NEAREST INCH

METHOD OF DRILLING (circle one)

BORED (or Augered) JETTED Jetted & DRIVEN
 30 AIR-ROTary AIR-PERCussion ROTARY (Hydraulic Rotary)
 37 CABLE REVERSE-ROTary Drive-POINT
 other

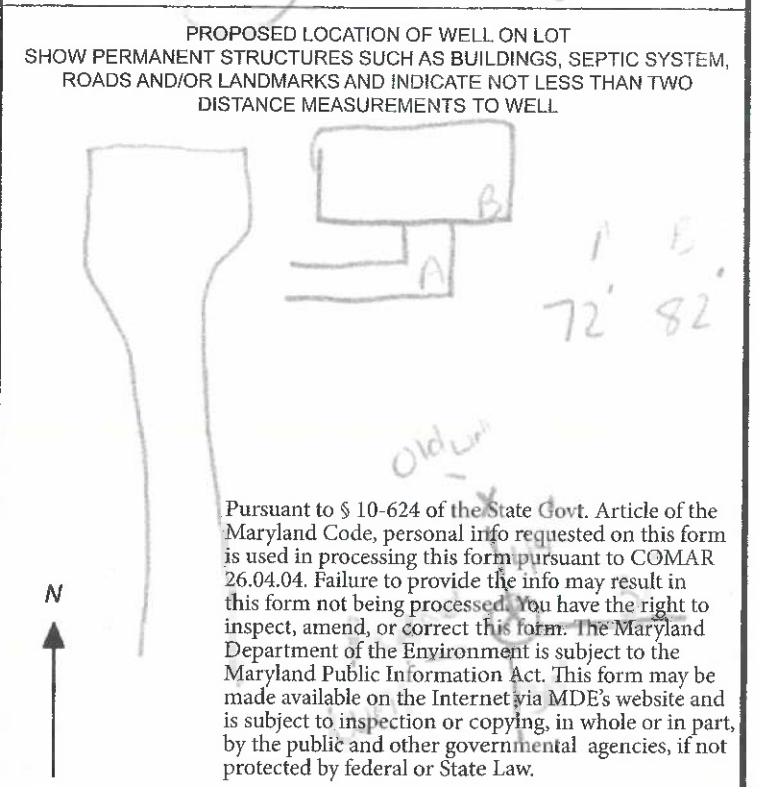

REPLACEMENT OR DEEPEMED WELLS (CIRCLE APPROPRIATE BOX)

THIS WELL WILL NOT REPLACE AN EXISTING WELL
 THIS WELL WILL REPLACE A WELL THAT WILL BE ABANDONED AND SEALED
 THIS WELL WILL REPLACE A WELL THAT WILL BE USED AS A STANDBY-CONTACT LOCAL APPROVING AUTHORITY FOR POLICY ON STANDBY WELLS
 THIS WELL WILL DEEPEM AN EXISTING WELL

PERMIT NUMBER OF WELL TO BE REPLACED OR DEEPEMED (IF AVAILABLE) 41 52

Not to be filled in by driller (MDE OR COUNTY USE ONLY)

APPROP. PERMIT NUMBER G
 PERMIT No. 10 70 71 72 73 74 75 76 77 78 79


SPECIAL CONDITIONS
 NOTE APPROVING AUTHORITIES SHOULD USE SEPARATE SHEET IF NEEDED

(To Existing Well)

A B
72 82



SITE PLAN

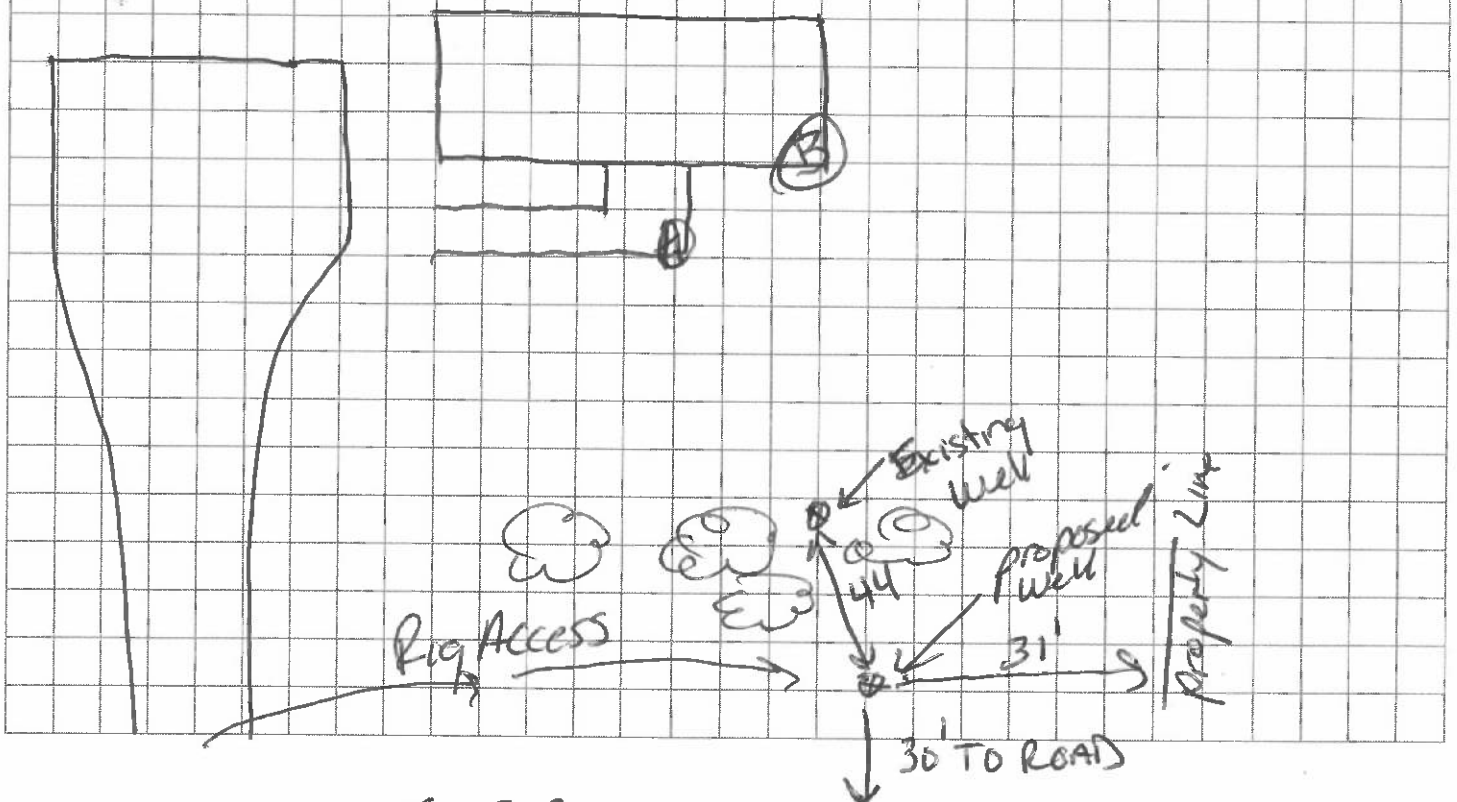

Sediment Control Protocol: SILT Fence

Neighbors Well: HO-94-0870

Distance From House: 120'

From Septic: 150'

From Sewer: N/A

From Property Line: 31'

From Street: 30'

Trees Nearby: Yes

Utility Issues: NO

Mats Needed: Yes

Access For H/U: BY OTHERS

Neighboring Tags: See Comps

Comments: Replacing Well ~~HO-73-1624~~ HO-73-1624

Person Completing Form: Wes Wolfe



HOWARD COUNTY HEALTH DEPARTMENT

72083

DATE 7/12/22

W5

Received From

Allied Environmental Services, Inc

PHONE #

CASH
 CHECK

For

Emergency Remedial Well
12000 Trade Shop Rd

NO.

28019

One Hundred Sixty

Dollars

\$ 160

Received By M. J. [Signature]