

DEPARTMENT OF INSPECTIONS, LICENSES AND PERMITS 3430 COURT HOUSE DRIVE ELLCOTT CITY, MD 21043 PERMITS (410) 313-2455 INSPECTIONS (410) 313-1810 AUTOMATED INFORMATION (410) 313-3800		HOWARD COUNTY PERMIT APPLICATION		PERMIT NUMBER B07001732	
Building Address <u>2761 WYNFIELD RD</u> <u>WREST FLEMING MD 21144-9124</u>			Property Owner's Name <u>Michael G. Cyden</u>		
Suite/Apt. #: _____ SDP/WP/Petition #: _____			Address <u>same</u>		
Census Tract _____ Subdivision _____			City _____ State _____ Zip Code _____		
Section _____ Area _____ Lot <u>22</u>			Home Phone _____ Work Phone _____		
Tax Map <u>15</u> Parcel <u>88</u> Grid <u>13</u>			Applicant's Name & Mailing Address, (if other than stated hereon): _____		
Zoning _____ Map Coordinates _____ Lot size <u>23600 sq ft</u>			Phone <u>410-489-2953</u> Fax _____		
Existing Use <u>N/A NEW</u>			Contractor Company <u>Thompson Electric</u>		
Proposed Use <u>Pool Heater (pooling)</u>			Contact Person <u>Rick Stevens</u>		
Estimated Construction Cost \$ <u>2,000</u>			Address _____		
Description of Work <u>Excavate install 2' x 4' x 15' to Pool Heater</u>			City <u>Bethesda</u> State <u>MD</u> Zip Code <u>20813</u>		
Occupant or Tenant <u>same as above</u>			License No. <u>GA504104</u>		
Contact Name _____			Phone <u>301-432-6611</u> Fax <u>301-432-7147</u>		
Address _____			Engineer or Architect Company _____		
City _____ State _____ Zip Code _____			Contact Person _____		
Phone _____ Fax _____			Address _____		
			City _____ State _____ Zip Code _____		
			Phone _____ Fax _____		


BUILDING DESCRIPTION - <u>COMMERCIAL</u>		BUILDING DESCRIPTION - <u>RESIDENTIAL</u>	
Building Characteristics	Utilities	Building Characteristics	Utilities
Height: _____	Water Supply: _____ Public _____ Private _____	SF Dwelling ☒ SF Townhouse ☐ Depth Width	Water Supply: _____ Public _____ Private _____
No. of stories: _____	Sewage Disposal: _____ Public _____ Private _____	1st floor: _____	Sewage Disposal: _____ Public _____ Private _____
Gross area, sq. ft. per floor: _____	Electric Yes ☐ No ☐ Gas Yes ☐ No ☐	2nd floor: _____	Electric Yes ☐ No ☐ Gas Yes ☐ No ☐
Use group: _____	Heating System: _____ Electric ☐ Oil ☐ Natural Gas ☐ Propane Gas ☐	Basement: _____	Heating System: _____ Electric ☐ Oil ☐ Natural Gas ☐ Propane Gas ☒
Construction type: _____ Reinforced Concrete _____ Structural Steel _____ Masonry _____ Wood Frame _____ State Certified Modular _____	Sprinkler system: N/A ☐ Full _____ Partial _____ Other Suppression _____ # of Heads _____	Finished Basement ☐ Unfinished Basement ☐ Crawl space ☐ Slab on Grade ☐ No. of Bedrooms _____ Height: _____ Multi-family dwellings: _____ No. of efficiency units: _____ No. of 1 BR units: _____ No. of 2 BR units: _____ No. of 3 BR units: _____ Other Structure: _____ Dimensions: _____ Footings: _____ Roof Height: _____ State Certified Modular _____ Manufactured Home _____	Sprinkler system: N/A ☐ NFPA #13D _____ NFPA #13R _____ Other: _____

THE UNDERSIGNED HEREBY CERTIFIES AND AGREES AS FOLLOWS: (1) THAT HE/SHE IS AUTHORIZED TO MAKE THIS APPLICATION; (2) THAT THE INFORMATION IS CORRECT; (3) THAT HE/SHE WILL COMPLY WITH ALL REGULATIONS OF HOWARD COUNTY WHICH ARE APPLICABLE THERETO; (4) THAT HE/SHE WILL PERFORM NO WORK ON THE ABOVE REFERENCED PROPERTY NOT SPECIFICALLY DESCRIBED IN THIS APPLICATION; (5) THAT HE/SHE GRANTS COUNTY OFFICIALS THE RIGHT TO ENTER ONTO THIS PROPERTY FOR THE PURPOSE OF INSPECTING THE WORK PERMITTED AND POSTING NOTICES.

Applicant's Signature _____ Print Name _____
Title/Company _____ Date _____

Checks payable to: **DIRECTOR OF FINANCE OF HOWARD COUNTY**
** PLEASE WRITE NEATLY AND LEGIBLY. **
- FOR OFFICE USE ONLY -



AGENCY	DATE	SIGNATURE APPROVAL	DPZ SETBACK INFORMATION	PROPERTY ID#
Land Development, DPZ			Front: _____	Filing fee \$ _____
State Highways			Rear: _____	Permit fee \$ _____
Building Official			Side: _____	Excise tax \$ _____
Dev. Engineering, DPZ			Side St: _____	Add'l per. fee \$ _____
Health	6/6/2007	<i>John P. G.</i>	All minimum setbacks met? YES ☐ NO ☐	TOTAL FEES \$ _____
Fire Protection			Is Entrance Permit required? YES ☐ NO ☐	Sub-total paid \$ _____
Is Sediment Control approval required prior to issuance? YES ☐ NO ☐			Historic District? YES ☐ NO ☐	Balance due \$ _____
CONTINGENCY CONSTRUCTION START: ☐			Lot Coverage for NewTown Zone _____	Check # _____
ONE STOP SHOP: ☐			SDP/Red-line approval date _____	Validation # _____
Distribution of Copies: _____			Accepted by: _____	
While: Building Official _____ Green: LDD, DPZ _____ Yellow: DED, DPZ _____ Pink: Health _____ Gold: SHA _____				
7: Home/PERMIT.FRM				

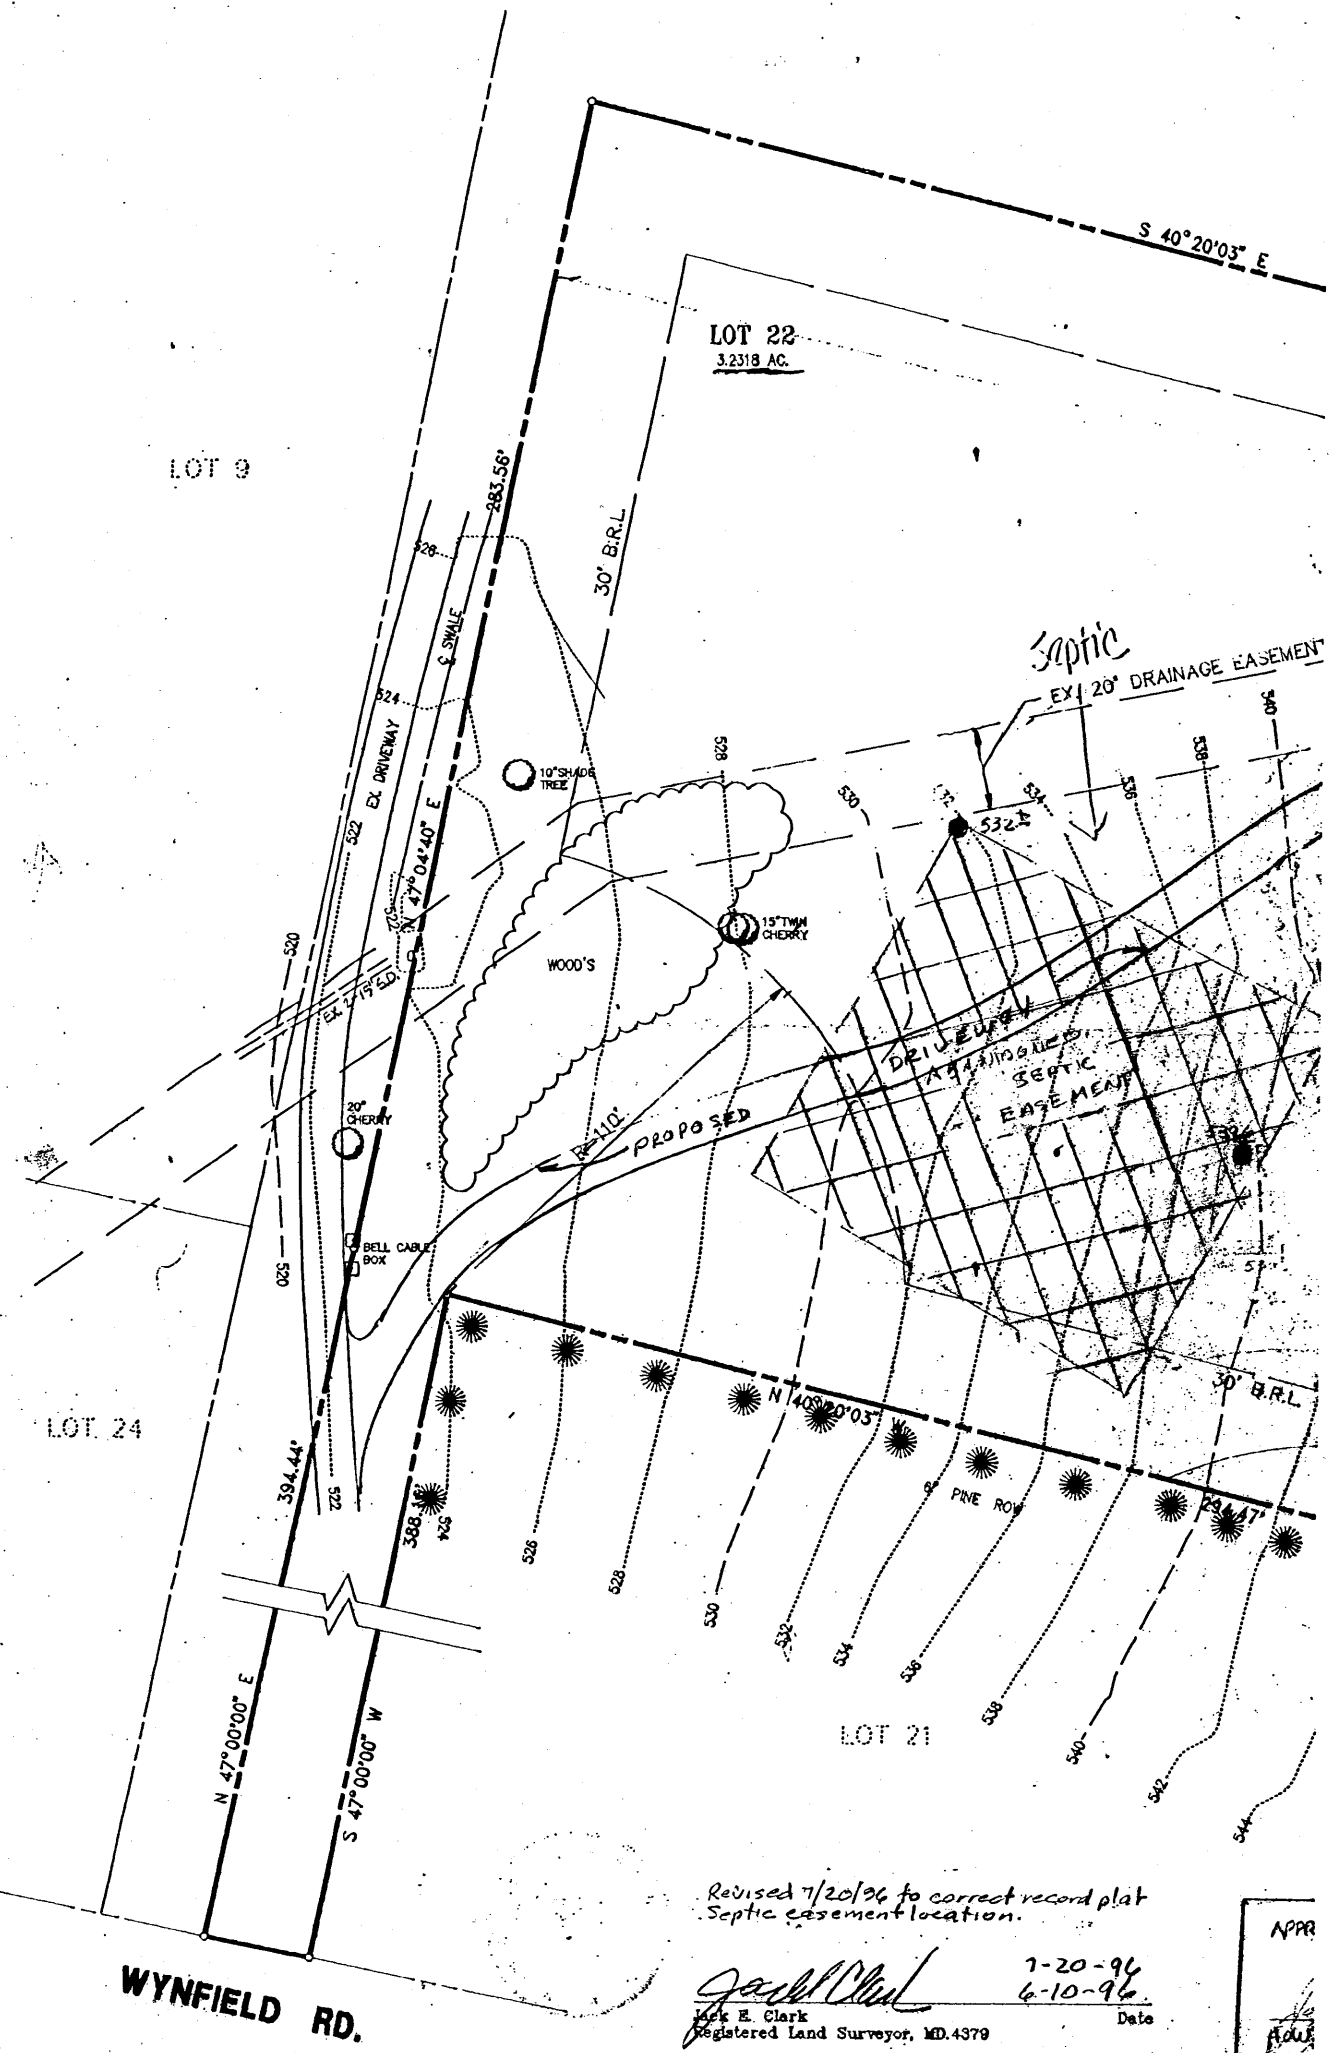

Revised 7/20/96 to correct record plat
Septic easement location.

Jack E. Clark
 Jack E. Clark
 Registered Land Surveyor, MD. 4379
 7-20-96
 6-10-96
 Date

APPR
[Signature]

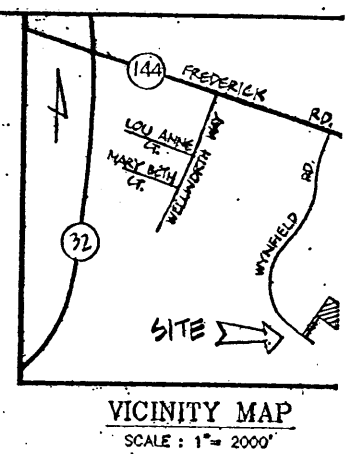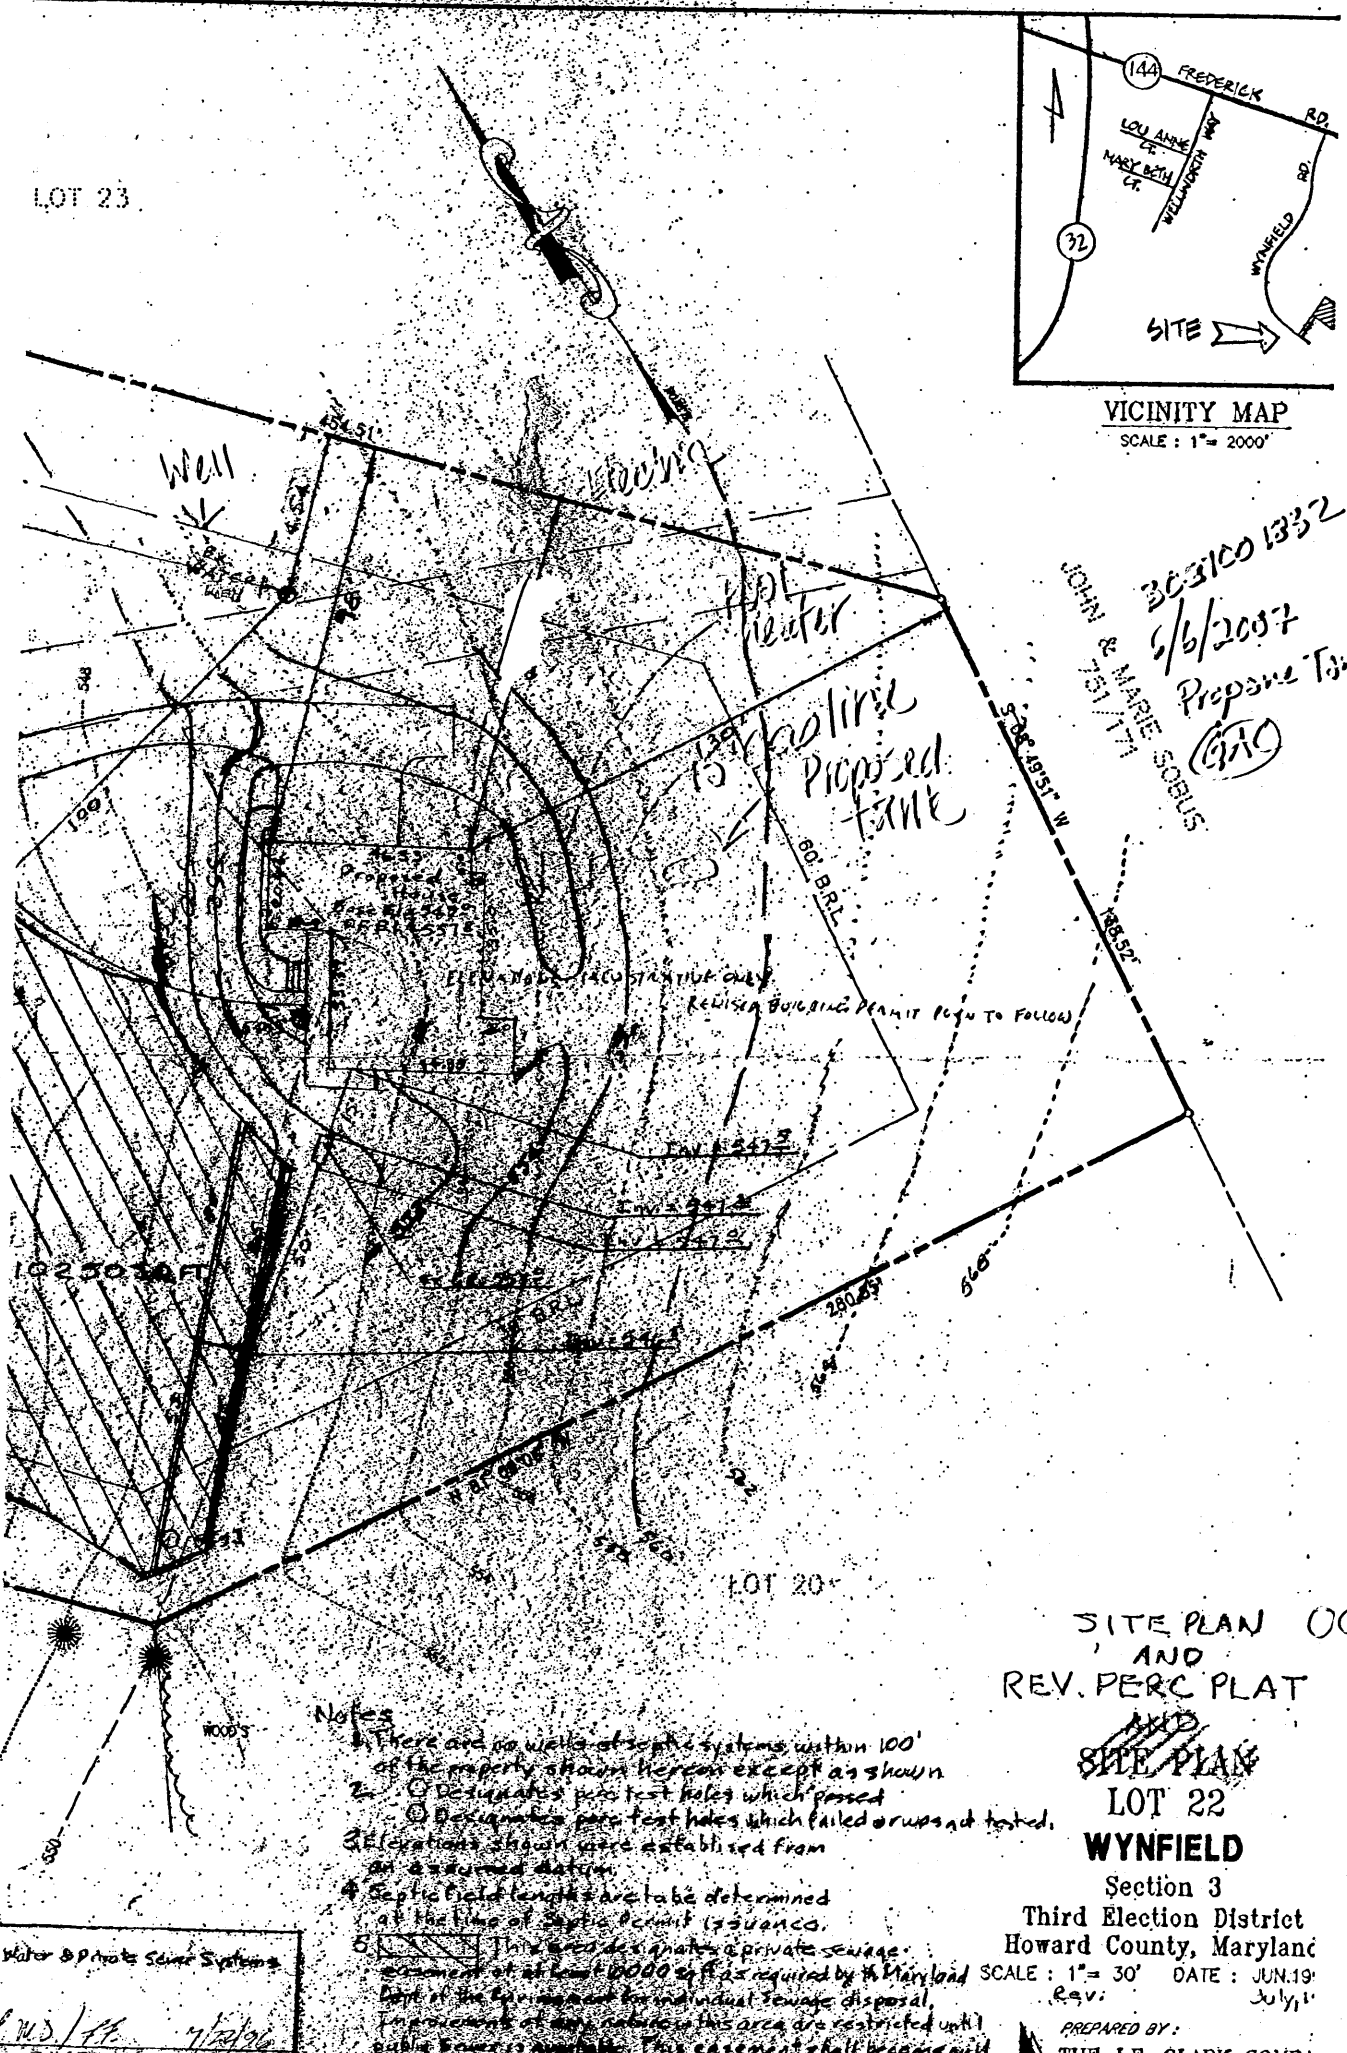

3031001332
 6/6/2007
 Prepare Tank ok.
 (GAC)
 JOHN & MARIE SOBUS
 751/177

**SITE PLAN OGDEN
 AND
 REV. PERC PLAT
 AND
 SITE PLAN
 LOT 22
 WYNFIELD**
 Section 3
 Third Election District
 Howard County, Maryland
 SCALE: 1" = 30' DATE: JUN. 19
 Rev. July, 1
 PREPARED BY:
 THE J.E. CLARK COMPA

- Notes
1. There are no wells or septic systems within 100' of the property shown hereon except as shown.
 2. (a) Designates per test holes which passed.
 - (b) Designates per test holes which failed or were not tested.
 3. Elevations shown were established from an assumed datum.
 4. Septic field lengths are to be determined at the time of Septic Permit issuance.
 5. This area designates a private sewage easement of at least 6000 sq. ft. as required by the Maryland Dept. of the Environment for individual sewage disposal. The placement of any structures in this area are restricted until public sewers are available. This easement shall become null and void if public sewers are available.

Water & Private Sewer Systems
 CWS/FE 7/20/96

DEPARTMENT OF INSPECTIONS, LICENSES AND PERMITS 3400 COURT HOUSE DRIVE ELKACOTT CITY, MD 21043 PERMITS (410) 313-2455 INSPECTIONS (410) 313-1810 AUTOMATED INFORMATION (410) 313-3880		HOWARD COUNTY PERMIT APPLICATION		PERMIT NUMBER 306004839	
Building Address 2761 Wynfield Rd West Friendship Md 21794			Property Owner's Name Mike + Janine Ogden		
Suite/Apt. #: _____ SDP/MWP/Petition #: _____			Address 2761 Wynfield Rd		
Census Tract _____ Subdivision _____			City W. Friendship State Md Zip Code 21794		
Section _____ Area _____ Lot _____			Home Phone 410 489 2752 Work Phone 410 310 9684		
Tax Map _____ Parcel _____ Grid _____			Applicant's Name & Mailing Address, (if other than stated hereon): _____		
Zoning _____ Map Coordinates _____ Lot size _____			Phone 410 489 2752 Fax _____		
Existing Use SFD			Contractor Company SELF		
Proposed Use _____			Contact Person Mike Ogden		
Estimated Construction Cost \$ 2,000			Address see above		
Description of Work 2nd floor renovations remove vaulted ceiling to extend existing bedroom and add bathroom			City _____ State _____ Zip Code _____		
Occupant or Tenant _____			Engineer or Architect Company R.A.D.		
Contact Name see above			Contact Person Henry Williard		
Address see above			Address PO BOX 186		
City _____ State _____ Zip Code _____			City Openely State Md Zip Code 21737		
Phone _____ Fax _____			Phone 489 4673 Fax _____		

BUILDING DESCRIPTION - <u>COMMERCIAL</u>		BUILDING DESCRIPTION - <u>RESIDENTIAL</u>	
Building Characteristics Height: _____ No. of stories: _____ Gross area, sq. ft. per floor: _____ Use group: _____ Construction type: ☐ Reinforced Concrete ☐ Structural Steel ☐ Masonry ☐ Wood Frame ☐ State Certified Modular	Utilities Water Supply: ☐ Public ☐ Private Sewage Disposal: ☐ Public ☐ Private Electric Yes ☐ No ☐ Gas Yes ☐ No ☐ Heating System: Electric ☐ Oil ☐ Natural Gas ☐ Propane Gas ☐ Sprinkler system: N/A ☐ ☐ Full ☐ Partial ☐ Other Suppression ☐ # of Heads	Building Characteristics SF Dwelling ☒ SF Townhouse ☐ Depth Width 1st floor: _____ 2nd floor: _____ Basement: _____ Finished Basement ☒ Unfinished Basement ☒ Crawl space ☐ Slab on Grade ☐ No. of Bedrooms 4 Height: _____ Multi-family dwellings: No. of efficiency units: _____ No. of 1 BR units: _____ No. of 2 BR units: _____ No. of 3 BR units: _____ Other Structure: _____ Dimensions: _____ Footings: _____ Roof Height: _____ ☐ State Certified Modular ☐ Manufactured Home	Utilities Water Supply: ☐ Public ☒ Private Sewage Disposal: ☐ Public ☒ Private Electric Yes ☐ No ☐ Gas Yes ☐ No ☐ Heating System: Electric ☐ Oil ☐ Natural Gas ☒ Propane Gas ☐ Sprinkler system: N/A ☒ ☐ NFPA #13D ☐ NFPA #13R ☐ Other:


THE UNDERSIGNED HEREBY CERTIFIES AND AGREES AS FOLLOWS: (1) THAT HE/SHE IS AUTHORIZED TO MAKE THIS APPLICATION; (2) THAT THE INFORMATION IS CORRECT; (3) THAT HE/SHE WILL COMPLY WITH ALL REGULATIONS OF HOWARD COUNTY WHICH ARE APPLICABLE THEREIN; (4) THAT HE/SHE WILL PERFORM NO WORK ON THE ABOVE REFERENCED PROPERTY NOT SPECIFICALLY DESCRIBED IN THIS APPLICATION; (5) THAT HE/SHE GRANTS COUNTY OFFICIALS THE RIGHT TO ENTER ONTO THIS PROPERTY FOR THE PURPOSE OF INSPECTING THE WORK PERMITTED AND POSTING NOTICES.

J. Ogden Applicant's Signature	Janine Ogden Print Name
Title/Company	Date 9-19-06

Checks payable to: **DIRECTOR OF FINANCE OF HOWARD COUNTY**
 ** PLEASE WRITE NEATLY AND LEGIBLY. **
FOR OFFICE USE ONLY

AGENCY	DATE	SIGNATURE APPROVAL	DPZ SETBACK INFORMATION	PROPERTY ID#
Land Development DPZ			Front: _____	Filing fee \$ _____
State Highways			Rear: _____	Permit fee \$ _____
Building Official			Side: _____	Excise tax \$ _____
Dev. Engineering DPZ			Side St: _____	Add'l per. fee \$ _____
Health	9/19/06	Shirley	All minimum setbacks met?	TOTAL FEES \$ _____
Fire Protection			YES ☐ NO ☐	Sub-total paid \$ _____
Is Sediment Control approval required prior to issuance?			Is Entrance Permit required?	Balance due \$ _____
YES ☐ NO ☐			YES ☐ NO ☐	Check # _____
CONTINGENCY CONSTRUCTION START: ☐			Historic District?	Validation # _____
ONE STOP SHOP: ☐			YES ☐ NO ☐	
Distribution of Copies: _____			Lot Coverage for New Town Zone _____	
While: Building Official _____			SDP/Red-line approval date _____	Accepted by _____
Green: LDD, DPZ _____			Yellow: DED, DPZ _____	Gold: SHA _____
Pink: Health _____				

T:\forms\PERMIT.FRM Rev. 11/4/04

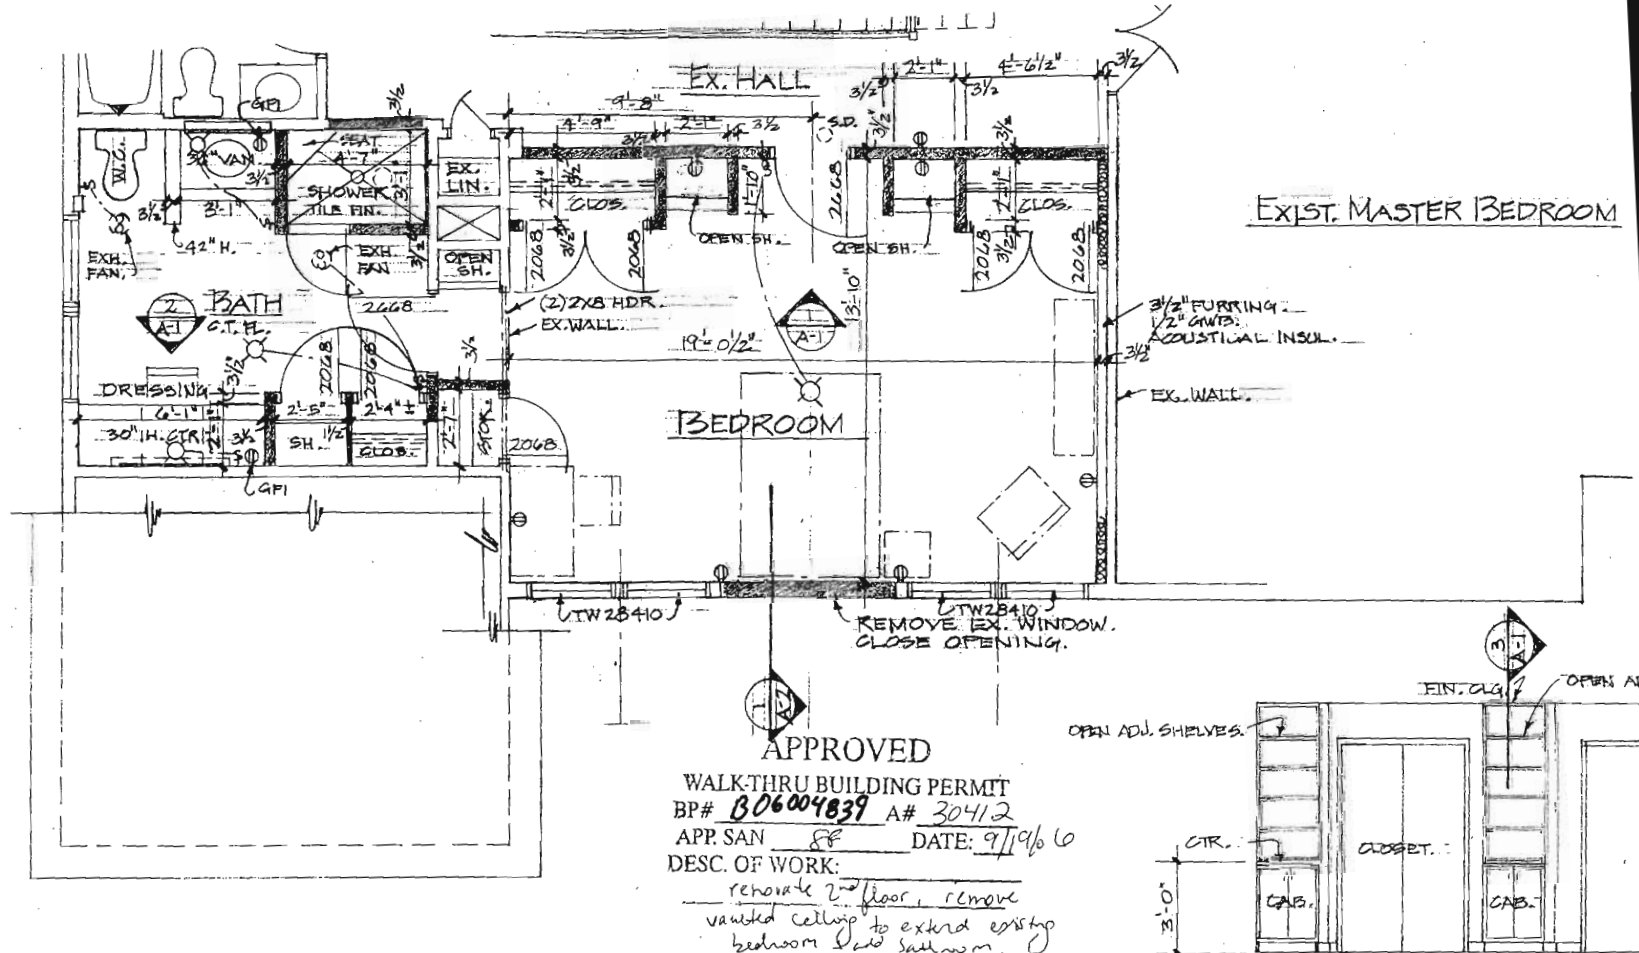

PART SECOND FLOOR PLAN

1/4" = 1'-0"

- NEW WALLS.
- EXISTING WALLS.

- DUPLEX ELECTRIC WALL OUTLET.

- LIGHT FIXTURE.

- SMOKE DETECTOR.

S.D.

INTERIOR ELEVATION

1/4" = 1'-0"

RENOVATIONS TO BEDROOMS AND MASTER BATH

FOR

MR. & MRS. MICHAEL OGDEN

2761 L. KIRKFIELD DRIVE

HOWARD COUNTY
PERMIT APPLICATION

PERMIT NUMBER

B00159542

Building Address 2761 Wynfield Rd
West Friendship 21794
Suite/Apt. #: _____ SDP/WP/Petition #: _____
Census Tract _____ Subdivision West Friendship
Section _____ Area _____ Lot 22
Tax Map 15 Parcel 88 Grid 18
Zoning _____ Map Coordinates 10-E5 Lot size _____

Property Owner's Name Janine + Michael Ogden
Address 2761 Wynfield Rd
City West Friendship State MD Zip Code 21794
Home Phone _____ Work Phone _____
Applicant's Name & Mailing Address, (if other than stated hereon): _____
Phone _____ Fax _____

Existing Use SPD
Proposed Use SPD + Pool
Estimated Construction Cost \$ 25,000
Description of Work Inground Pool 23' x 39'
in rear yard. w/ 48" high Fence
to code. Pool Filled by truck

Contractor Company Maryland Pools
Contact Person Joann Lathan
Address 9515 Germing LA
City Columbia State MD Zip Code 21046
License No. 6699
Phone 410-995-6600 Fax _____

Occupant or Tenant Owner
Contact Name _____
Address _____
City _____ State _____ Zip Code _____
Phone _____ Fax _____

Engineer or Architect Company _____
Contact Person _____
Address _____
City _____ State _____ Zip Code _____
Phone _____ Fax _____

BUILDING DESCRIPTION - COMMERCIAL

Building Characteristics	Utilities
Height: _____	Water Supply: _____ Public ☐ Private ☐
No. of stories: _____	Sewage Disposal: _____ Public ☐ Private ☐
Gross area, sq. ft. per floor: _____	Electric Yes ☐ No ☐ Gas Yes ☐ No ☐
Use group: _____	Heating System: _____ Electric ☐ Oil ☐ Natural Gas ☐ Propane Gas ☐
Construction type: _____ Reinforced Concrete ☐ Structural Steel ☐ Masonry ☐ Wood Frame ☐ State Certified Modular ☐	Sprinkler system: N/A ☐ Full ☐ Partial ☐ Other Suppression ☐ # of Heads _____

BUILDING DESCRIPTION - RESIDENTIAL

Building Characteristics	Utilities
SF Dwelling ☐ SF Townhouse ☐ Depth _____ Width _____	Water Supply: _____ Public ☐ Private ☐
1st floor: _____	Sewage Disposal: _____ Public ☐ Private ☐
2nd floor: <u>3-8'</u>	Electric Yes ☐ No ☐ Gas Yes ☐ No ☐
Basement: _____	Heating System: _____ Electric ☐ Oil ☐ Natural Gas ☐ Propane Gas ☐
Finished Basement ☐ Unfinished Basement ☐ Crawl space ☐ Slab on Grade ☐ No. of Bedrooms _____	Sprinkler system: N/A ☐ NFPA #13D ☐ NFPA #13R ☐ Other: _____
Height: _____ Multi-family dwellings: _____ No. of efficiency units: _____ No. of 1 BR units: _____ No. of 2 BR units: _____ No. of 3 BR units: _____	
Other Structure: _____ Dimensions: _____ Footings: _____ Roof Height: _____	
State Certified Modular ☐ Manufactured Home ☐	

THE UNDERSIGNED HEREBY CERTIFIES AND AGREES AS FOLLOWS: (1) THAT HE/SHE IS AUTHORIZED TO MAKE THIS APPLICATION; (2) THAT THE INFORMATION IS CORRECT; (3) THAT HE/SHE WILL COMPLY WITH ALL REGULATIONS OF HOWARD COUNTY WHICH ARE APPLICABLE THERETO; (4) THAT HE/SHE WILL PERFORM NO WORK ON THE ABOVE REFERENCED PROPERTY NOT SPECIFICALLY DESCRIBED IN THIS APPLICATION; (5) THAT HE/SHE GRANTS COUNTY OFFICIALS THE RIGHT TO ENTER ONTO THIS PROPERTY FOR THE PURPOSE OF INSPECTING THE WORK PERMITTED AND POSTING NOTICES.

J. Lathan
Applicant's Signature
agent
Title/Company

J. Lathan
Print Name
5-11-06
Date

Checks payable to: **DIRECTOR OF FINANCE OF HOWARD COUNTY**
** PLEASE WRITE NEATLY AND LEGIBLY. **
- FOR OFFICE USE ONLY -

AGENCY DATE SIGNATURE APPROVAL

Land Development DPZ
State Highways
Building Official
Dev. Engineering DPZ
Health 5-11-06 Kacie Norrie
Fire Protection

Is Sediment Control approval required prior to issuance?
YES ☐ NO ☐

CONTINGENCY CONSTRUCTION START: ☐
ONE STOP SHOP: ☐

Distribution of Copies: White: Building Official Green: LDD, DPZ
T:\forms\PERMIT.FRM

DPZ SETBACK INFORMATION

PROPERTY ID#:
Front: _____ Filing fee \$ _____
Rear: _____ Permit fee \$ _____
Side: _____ Excise tax \$ _____
Side St.: _____ Add'l per. fee \$ _____
All minimum setbacks met? TOTAL FEES \$ _____
YES ☐ NO ☐
Is Entrance Permit required? Sub-total paid \$ _____
YES ☐ NO ☐
Balance due \$ _____
Historic District? Check # _____
YES ☐ NO ☐
Lot Coverage for New/Town Zone Validation # _____
SDP/Red-line approval date _____

Accepted by _____

Yellow: DED, DPZ Pink: Health Gold: SHA

A30412

SETBACKS:
 REAR PL. 50'
 SIDE PL. 30'
 HOUSE N/A
 SEPTIC 20'
 WELL 30'

PRIVATE WELL & SEPTIC




SITE PLAN

1"=80'

LOT 22

WEST FRIENDSHIP

MAP 15, GRID 18, PARCEL 88
 ACCOUNT #309924
 ELECTION DISTRICT NO.03
 HOWARD COUNTY, MARYLAND

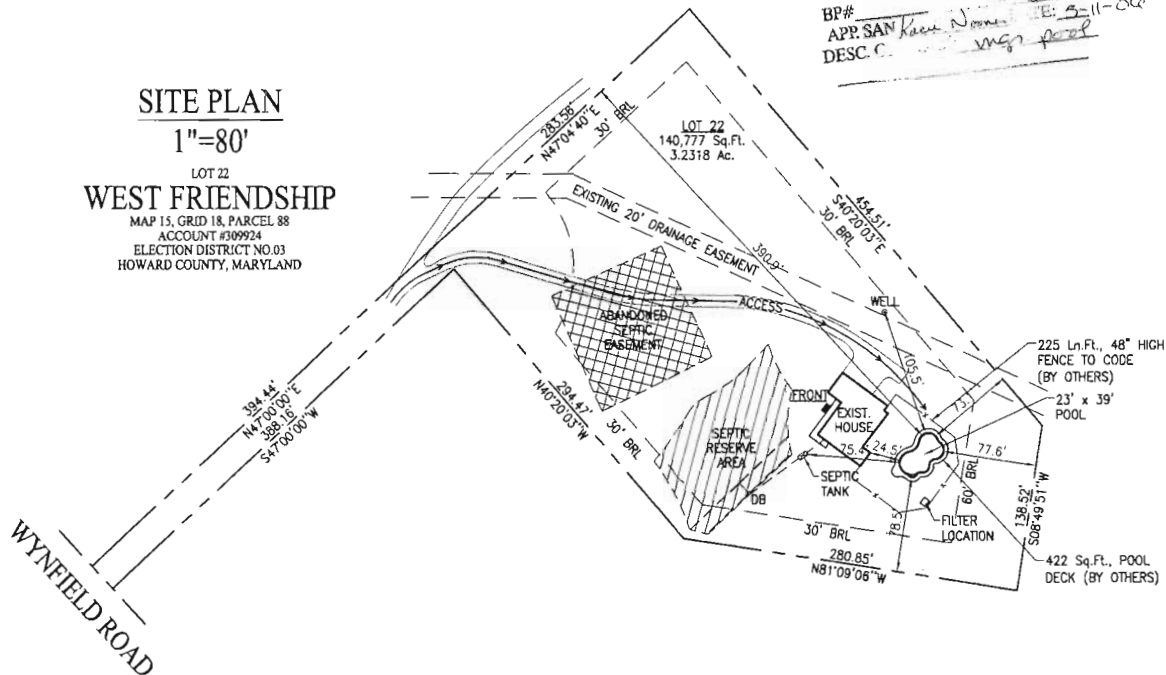

APPROVED
 WALKTHRU BY ENGINEER PERMIT
 BP# 30412
 APP. SAN Kate Nones DATE: 5-11-06
 DESC. WELL, septic pool

Maryland POOLS

9715 GREENWICH LANE 11166 MAIN STREET
 SUITE 121 SUITE 402
 COLEMAN, MD 21046 FAIRFAX, VA 22030
 410-272-6666 703-596-1700
 800-272-5200
 WWW.MARYLANDPOOLS.COM

EQUIPMENT LIST

DIRT/GRADING: SOME HAUL
 SPA: NONE
 RAISED BEAM: NONE
 TILE: STB-808
 COPING: 'SUIT SAVER' (WHITE)
 PLASTER: WHITE MARBELITE
 FILTER SYS: C&C 420 SF CART. W/2HP PUMP
 CLEANING SYS: PCC-2000
 TREATMENT SYS: NONE
 CONTROL SYS: NONE
 HEATER: NONE
 LIGHTS: (1) 3AM WATTS: 500 VOLTS: 120
 LOWSEAR: (1) 6' - OUTSIDE
 AQUA BENCH: NONE
 RAIL GOODS: NONE
 DECKING: BY OTHERS
 FENCE: BY OWNER
 POOL COVER: NONE TYPE: N/A
 CHEMICALS: \$50 CHEMICAL ALLOWANCE
 OTHER ITEMS: 8' DIVING BOARD & STAND
 EQUIPOTENTIAL BONDING GRID

ELECTRIC: 200 FT.

POOL DATA

SIZE/SHAPE: 23' x 39' - ARJUBAN (DIVING)
 POOL AREA: 700 SPA: OTHER: 12
 TOTAL AREA: 712
 PERIMETER: 113 SPA:
 GALLONAGE: 28,875 DEPTH: 3'-0" TO 8'-8"

DIRECTIONS TO SITE

DIRECTIONS:
 32 PM TO 144 (BEFORE 77) R/T 1/2 MILE TO WYNFIELD RD.
 R/T TO SITE ON LOT.

MAP #

10

GRID

E-5

*****LONG DRIVEWAY & L/T AT JUNCTION*****

Janine & Michael Ogden
 2761 Wynfield Road
 West Friendship, Maryland 21794
 Howard County

HOME PHONE: 410-488-2752
 OFFICE PHONE: 410-310-8684
 OTHER PHONE: 410-488-2753
 CELL PHONE:

PERMIT SET

PERMIT NUMBERS
 POOL:
 ELECT:
 OTHER:

DATE: 05-10-06

LOT: 22 SUBDIVISION NAME: WEST FRIENDSHIP DISTRICT: 03 PERM # 309924
 SCALE: 1"=80' BY: J.L.R. DATE: 05/10/06 JOB NUMBER: M506-8886 SHEET # 1.0