

6/11/76  
Requested you  
called your City of  
Howard County

# PERMIT

P. 23405

SEWAGE DISPOSAL SYSTEM

MARYLAND STATE DEPARTMENT OF HEALTH

HOWARD COUNTY

ELLICOTT CITY

DISTRICT 8th

## INDEXED

DATE 6/18/76

Jack Fyock

IS PERMITTED TO INSTALL ALTER X

ADDRESS 25775 Trindolphia Road, Glenolig, Md.

PHONE 908-97--

A SEWAGE DISPOSAL SYSTEM LOCATED AT \_\_\_\_\_

SUBDIVISION \_\_\_\_\_

5175  
Green Bridge Road

PROPERTY OWNER Paul (F) Blanchard

SEEK HELP TO DETERMINE IF THIS ROAD IS  
OF GOOD

ADDRESS Green Bridge Road, Dayton, Md.

### SPECIFICATIONS

DRAIN FIELD \_\_\_\_\_ DEPTH \_\_\_\_\_ FEET. BOTTOM AREA \_\_\_\_\_ SQ. FT.

SEEPAGE PITS \_\_\_\_\_ ABSORBENT SIDE WALL AREA \_\_\_\_\_ SQ. FT.

SEPTIC TANK CAPACITY \_\_\_\_\_ GALLONS

FOR GARAGE GRINDER, INCREASE DISPOSAL AREA AND TANK CAPACITY.

OTHER REPAIR - Call for inspection when ground is opened up so installation can  
recommended repair system.


PLANS APPROVED BY Fairfax F. Wise

DATE 6/18/76

FILL SEPTIC TANK AND DISTRIBUTION BOX WITH WATER BEFORE CALLING FOR AN INSPECTION. DO NOT OPERATE UNTIL INSPECTED AND APPROVED.

NEITHER THE HOWARD COUNTY COMMISSIONERS NOR THE HEALTH DEPARTMENT IS RESPONSIBLE FOR THE SUCCESSFUL OPERATION OF ANY SYSTEM.

23405

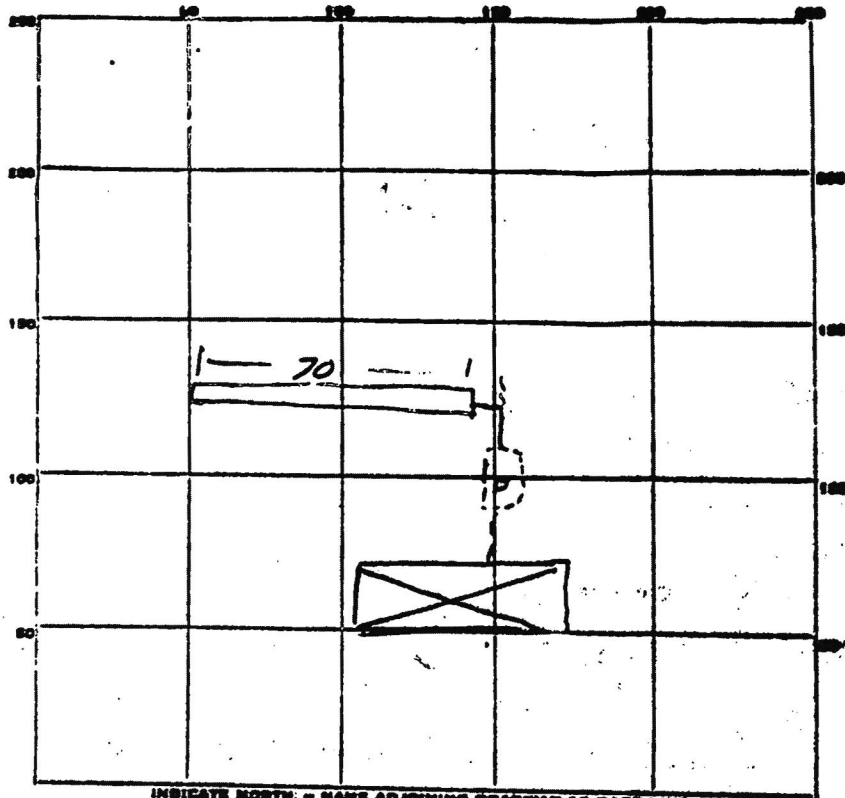

INDICATE NORTH - NAME ADJOINING ROADWAY AS SAGE LINE

PERMIT CARD \_\_\_\_\_

SEWER TANK LEVEL \_\_\_\_\_

CLEANING \_\_\_\_\_

DISTRIBUTION BOX LEVEL \_\_\_\_\_

TILE FIELD, DEPTH 11 FT. TRENCH WIDTH 2 FT.

GRAVEL DEPTH 7 1/2 FT. TOTAL LENGTH 70 FT.

NUMBER OF TRENCHES 1 TOTAL BOTTOM AREA 525

7.5  
70  
525.0

STORAGE PIT, INSIDE DIAMETER \_\_\_\_\_ FT. DEPTH BELOW INLET \_\_\_\_\_ FT.

ABSORBENT AREA 525 SQ. FT.

REMARKS \_\_\_\_\_

\_\_\_\_\_

\_\_\_\_\_

\_\_\_\_\_

\_\_\_\_\_

DATE SYSTEM APPROVED

6/16/76

INSPECTOR

R. Mansfield