

PUB. SEWER STATUS VERIFIED BY _____

ISSUE DATE: _____

APPROVAL DATE: _____

PERMIT

P 520417-C

INDEXED

A RE-INDEX

ON-SITE SEWAGE DISPOSAL SYSTEM HOWARD COUNTY HEALTH DEPARTMENT BUREAU OF ENVIRONMENTAL HEALTH

_____ IS PERMITTED TO INSTALL ALTER

ADDRESS: _____ PHONE NUMBER: _____

SUBDIVISION: _____ LOT NUMBER: _____

ADDRESS: 16440 Old Frederick Road PROPERTY OWNER: Amy & Richard Burns

SEPTIC TANK CAPACITY (GALLONS): _____

PUMP CHAMBER CAPACITY (GALLONS): _____

NUMBER OF BEDROOMS: _____

SQUARE FEET PER BEDROOM: _____

LINEAR FEET OF TRENCH REQUIRED: _____

TRENCHES:	Trench to be _____ feet wide. Inlet _____ feet below original grade. Bottom maximum depth _____ feet below original grade. Effective area begins at _____ feet of stone below distribution pipe.
LOCATION:	_____
PURPOSE:	Reindex file 7/30/04

PLANS APPROVED: _____ DATE: _____

- NOTE: PERMIT VOID AFTER 2 YEARS
- NOTE: CONTRACTOR RESPONSIBLE FOR SCHEDULING A PRE-CONSTRUCTION INSPECTION FOR ALL INSTALLATIONS
- NOTE: WATERTIGHT SEPTIC TANKS REQUIRED
- NOTE: ALL PARTS OF SEPTIC SYSTEM SHALL BE 100 FEET FROM ANY WATER WELL
- NOTE: MANHOLE RISERS REQUIRED ON ALL SEPTIC TANKS AND PUMP CHAMBERS

NEITHER THE HOWARD COUNTY COUNCIL OR THE HEALTH DEPARTMENT IS RESPONSIBLE FOR THE SUCCESSFUL OPERATION OF ANY SYSTEM PERMITTED RESPONSIBLE FOR OBTAINING FINAL APPROVAL ON THIS PERMIT CALL 410-313-2640 FOR INSPECTION OF SEPTIC SYSTEM

BUILDING PERMIT SIGNED AND RETURNED

6/17/04 B00148980 LA BATH + LAUNDRY

P520417-C

P52047-C

LISBON FARMS, PARCEL C 10440 OLD FREDERICK ROAD

PERMIT

SEWAGE DISPOSAL SYSTEM

MARYLAND STATE DEPARTMENT OF HEALTH

HOWARD COUNTY

ELLICOTT CITY

DISTRICT 4th

DATE 2/13/76

INDEXED

Handwritten notes:
1/24/76
1/24/76

P 22825
A 20835

Gerald Waser IS PERMITTED TO INSTALL ALTER

ADDRESS 2264 Mysthaven Lane, Gambrills, Md. 21054 PHONE 674-7546

A SEWAGE DISPOSAL SYSTEM LOCATED AT

SUBDIVISION (Lisbon Farms) ROAD 10440 Old Frederick Road LOT Parcel C

PROPERTY OWNER Mr. Gerald Waser

ADDRESS same as above

SPECIFICATIONS 4 bedrooms

DRAIN FIELD DEPTH FEET. BOTTOM AREA SQ. FT.

SEEPAGE PITS ABSORBENT SIDE-WALL AREA SQ. FT.

SEPTIC TANK CAPACITY 1250 GALLONS

FOR GARBAGE GRINDER, INCREASE DISPOSAL AREA 22% & TANK CAPACITY 80%.

OTHER DRY WELL - To have 13 sq. ft. effective absorbent sidewall area per bedroom below inlet. Inlet to be 4 ft. below original grade and maximum depth 11 1/2 ft. Locate dry well 123 ft. from right-of-way in towards back property line and 115 ft. off left property line when facing lot from right-of-way line as seen when facing lot from ~~back~~ front. Perc hole (3&4). See plat if necessary.

NOTE: ALL PIPE FROM HOUSE TO DISPOSAL AREA MUST BE CAST IRON.
PERMIT VOID AFTER THREE YEARS.

NOTE: INSTALL STAND PIPE ON SEPTIC TANK AND DRY WELL. STAND PIPES MUST BE 6 INCHES IN DIAMETER. CAST IRON, CONCRETE OR TERRA COTTA.

PLANS APPROVED BY Charles B. Streaker DATE 4/9/75


FILL SEPTIC TANK AND DISTRIBUTION BOX WITH WATER BEFORE CALLING FOR AN INSPECTION. COVER NO WORK UNTIL INSPECTED AND APPROVED.

NEITHER THE HOWARD COUNTY COMMISSIONERS NOR THE HEALTH DEPARTMENT IS RESPONSIBLE FOR THE SUCCESSFUL OPERATION OF ANY SYSTEM.

BLDG PLAN NO. 4453
AND RETURNED 5/10/75
Lisbon Farms
Dick

BUILDING PLAN NO. 4453
APPROVED 5/9/75
Lisbon Farms
2 car garage

20835

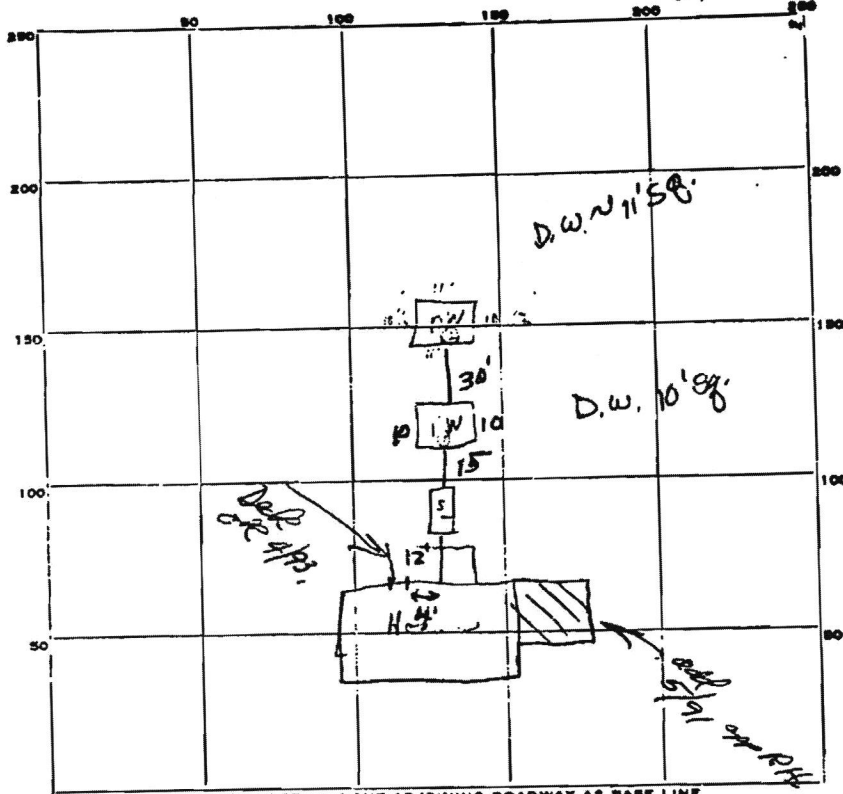

INDICATE NORTH - NAME ADJOINING ROADWAY AS BASE LINE.

PERMIT CARD Partial; Partial - no cond seen S.T. D.W.'s 2 {No cleanout or at time of inspection}

SEPTIC TANK, LEVEL ok CLEANOUTS ok 1/1/76

DISTRIBUTION BOX, LEVEL ←→

Tank, TRENCH DEPTH ←→ FT. TRENCH WIDTH ←→ FT. 5/20/76

GRAVEL DEPTH ←→ IN. TOTAL LENGTH ←→ FT.

NUMBER OF TRENCHES ←→ TOTAL BOTTOM AREA ←→

SEEPAGE PITS, INSIDE DIAMETER outside perimeter 12\"/>

REMARKS 4/5/76 g 1 11' x 11' x 11' = 1331'
2 4' x 4' x 4' = 64'
(outside perimeter - 12' x 12' = 144') 747'
4/9/76 Note appears then tank cleaned from surface
Tank & well no dry well - New septic tank
has unapproved cleanout, no approved cleanouts.
5/20/76 Cleanout checked Septic Tank
 DATE SYSTEM APPROVED 5/20/76 INSPECTOR C. B. Throckmorton