

PERMIT

SEWAGE DISPOSAL SYSTEM

DEPARTMENT OF HEALTH AND MENTAL HYGIENE

HOWARD COUNTY HEALTH DEPARTMENT

BUREAU OF ENVIRONMENTAL HEALTH

~~XX61-9933~~ 313-2640

INDEXED

03-309924

P 57302

A 30412

DISTRICT 3rd

DATE 10-4-96

DATE SYSTEM APPROVED 10-7-96

INSPECTOR DRS

Jack Fyock Septic Service

IS PERMITTED TO INSTALL ☒ ALTER ☐

ADDRESS 4105 Ten Oaks Road, Dayton, Maryland 21036 PHONE 988-9270

SUBDIVISION Wynfield LOT 22 ROAD 2761 Wynfield Road

PROPERTY OWNER Jeff VanStone

ADDRESS

SEPTIC TANK CAPACITY 1250 GALLONS

NUMBER OF BEDROOMS 4

180 SQUARE FEET PER BEDROOM

LINEAR FEET OF TRENCH REQUIRED 240

TRENCHES - Trench to be 3 feet wide. Inlet 3.5 feet below original grade. Bottom maximum depth 5.5 feet below original grade. Effective area begins at 5.5 feet below original grade. 2 feet of stone below distribution pipe.

LOCATION - Place the distribution box 70 feet off and 10 feet higher than the junction of the 294.47 and 280.85' lot lines. Run trenches along contour in both directions.

NOTES - No trench to exceed 100 feet in length. Provide 6" - 8" diameter cleanout and cap to grade or above on septic tank. 8/30/96 OK ALM

PLANS APPROVED BY Glen Savage DATE 08/21/96

COVER NO WORK UNTIL INSPECTED AND APPROVED

NEITHER THE HOWARD COUNTY COUNCIL NOR THE HEALTH DEPARTMENT IS RESPONSIBLE FOR THE SUCCESSFUL OPERATION OF ANY SYSTEM

NOTE: CLEANOUT REQUIRED EVERY 70 FEET OF SEWER LINE AND/OR AT 90° SWEEPS IN LINES FROM HOUSE TO DRAIN FIELDS, 90° ELBOWS NOT ACCEPTABLE.

NOTE: ALL PARTS OF SEPTIC SYSTEMS (I.E. TANK, DISTRIBUTION BOX TRENCHES) TO BE 100 FEET FROM WELL (UNLESS OTHERWISE SPECIFICALLY AUTHORIZED)

NOTE: IF DEEP TRENCH(ES) ARE USED CALL FOR INSPECTION BEFORE AND AFTER PLACING GRAVEL IN TRENCH(ES)

NOTE: NO DRY WELL SHALL EXCEED 15 FOOT IN DIAMETER NO ABSORPTION TRENCH TO EXCEED 100 FEET IN LENGTH

NOTE: ALL PIPE FROM HOUSE TO SEPTIC TANK MUST BE CAST IRON OR SCHEDULE 35/40 PVC OR ABS


PERMIT VOID AFTER TWO YEARS

NOTE: INSTALL STAND PIPE ON SEPTIC TANK AND DRY WELL STAND PIPES MUST BE 6 INCHES IN DIAMETER CAST IRON. CONCRETE OR TERRA COTTA OR PVA OR ABS ACCEPTED. IF TOP OF SEPTIC TANK IS DEEPER THAN 3 FEET. MANHOLE TO GRADE REQUIRED.

NOTE: DISTRIBUTION BOXES MUST HAVE BAFFLES

*INSTALLER IS RESPONSIBLE FOR OBTAINING FINAL APPROVAL ON THIS PERMIT

A 30412

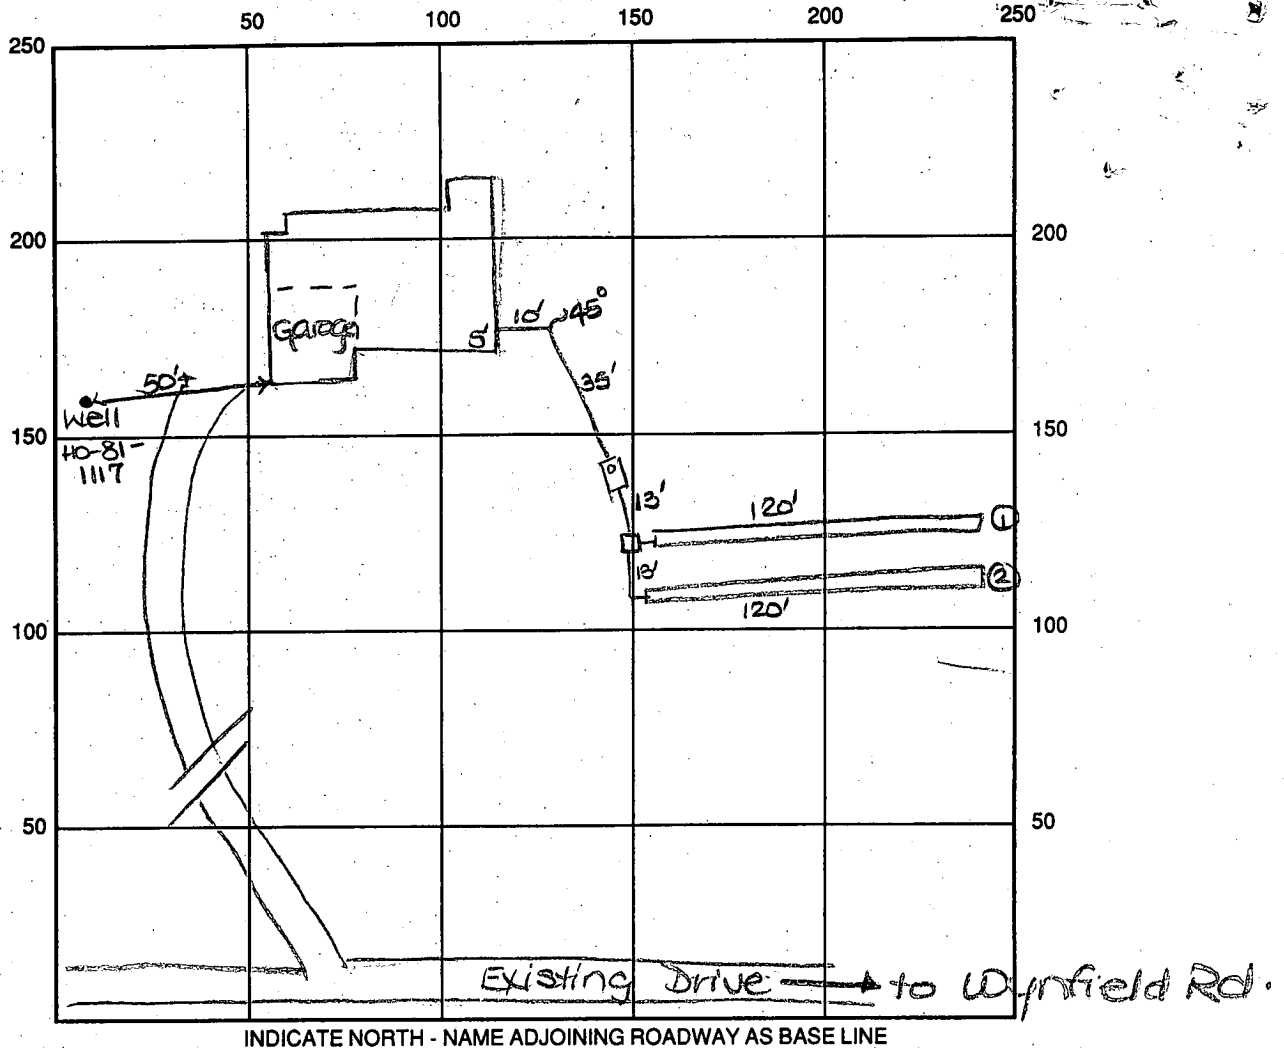

SEPTIC TANK LEVEL OK-1250 gal CLEANOUTS one on s.t.

DISTRIBUTION BOX LEVEL OK

DRAIN FIELD/TITLE DEPTH 5.5 FT. TRENCH WIDTH 3 FT. INLET DEPTH 3.5 FT.

EFFECTIVE GRAVEL DEPTH 2 FT. TOTAL LENGTH ① 120
② 120 FT. → 240'



NUMBER OF TRENCHES 2 ~~ONE SIDEWALK~~ / BOTTOM AREA 720 SQ. FT.


DRYWALL INSIDE DIAMETER — FT. EFFECTIVE DEPTH BELOW INLET — FT.

ABSORBENT AREA 720 SQ. FT.

REMARKS: 10/7/90 FINAL - OK to cover all work. DKS

DATE SYSTEM APPROVED 10/7/90 INSPECTOR Donna K. Joor

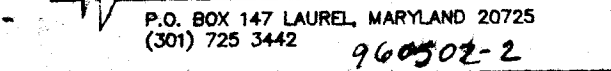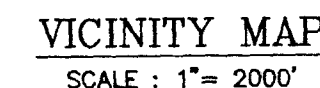

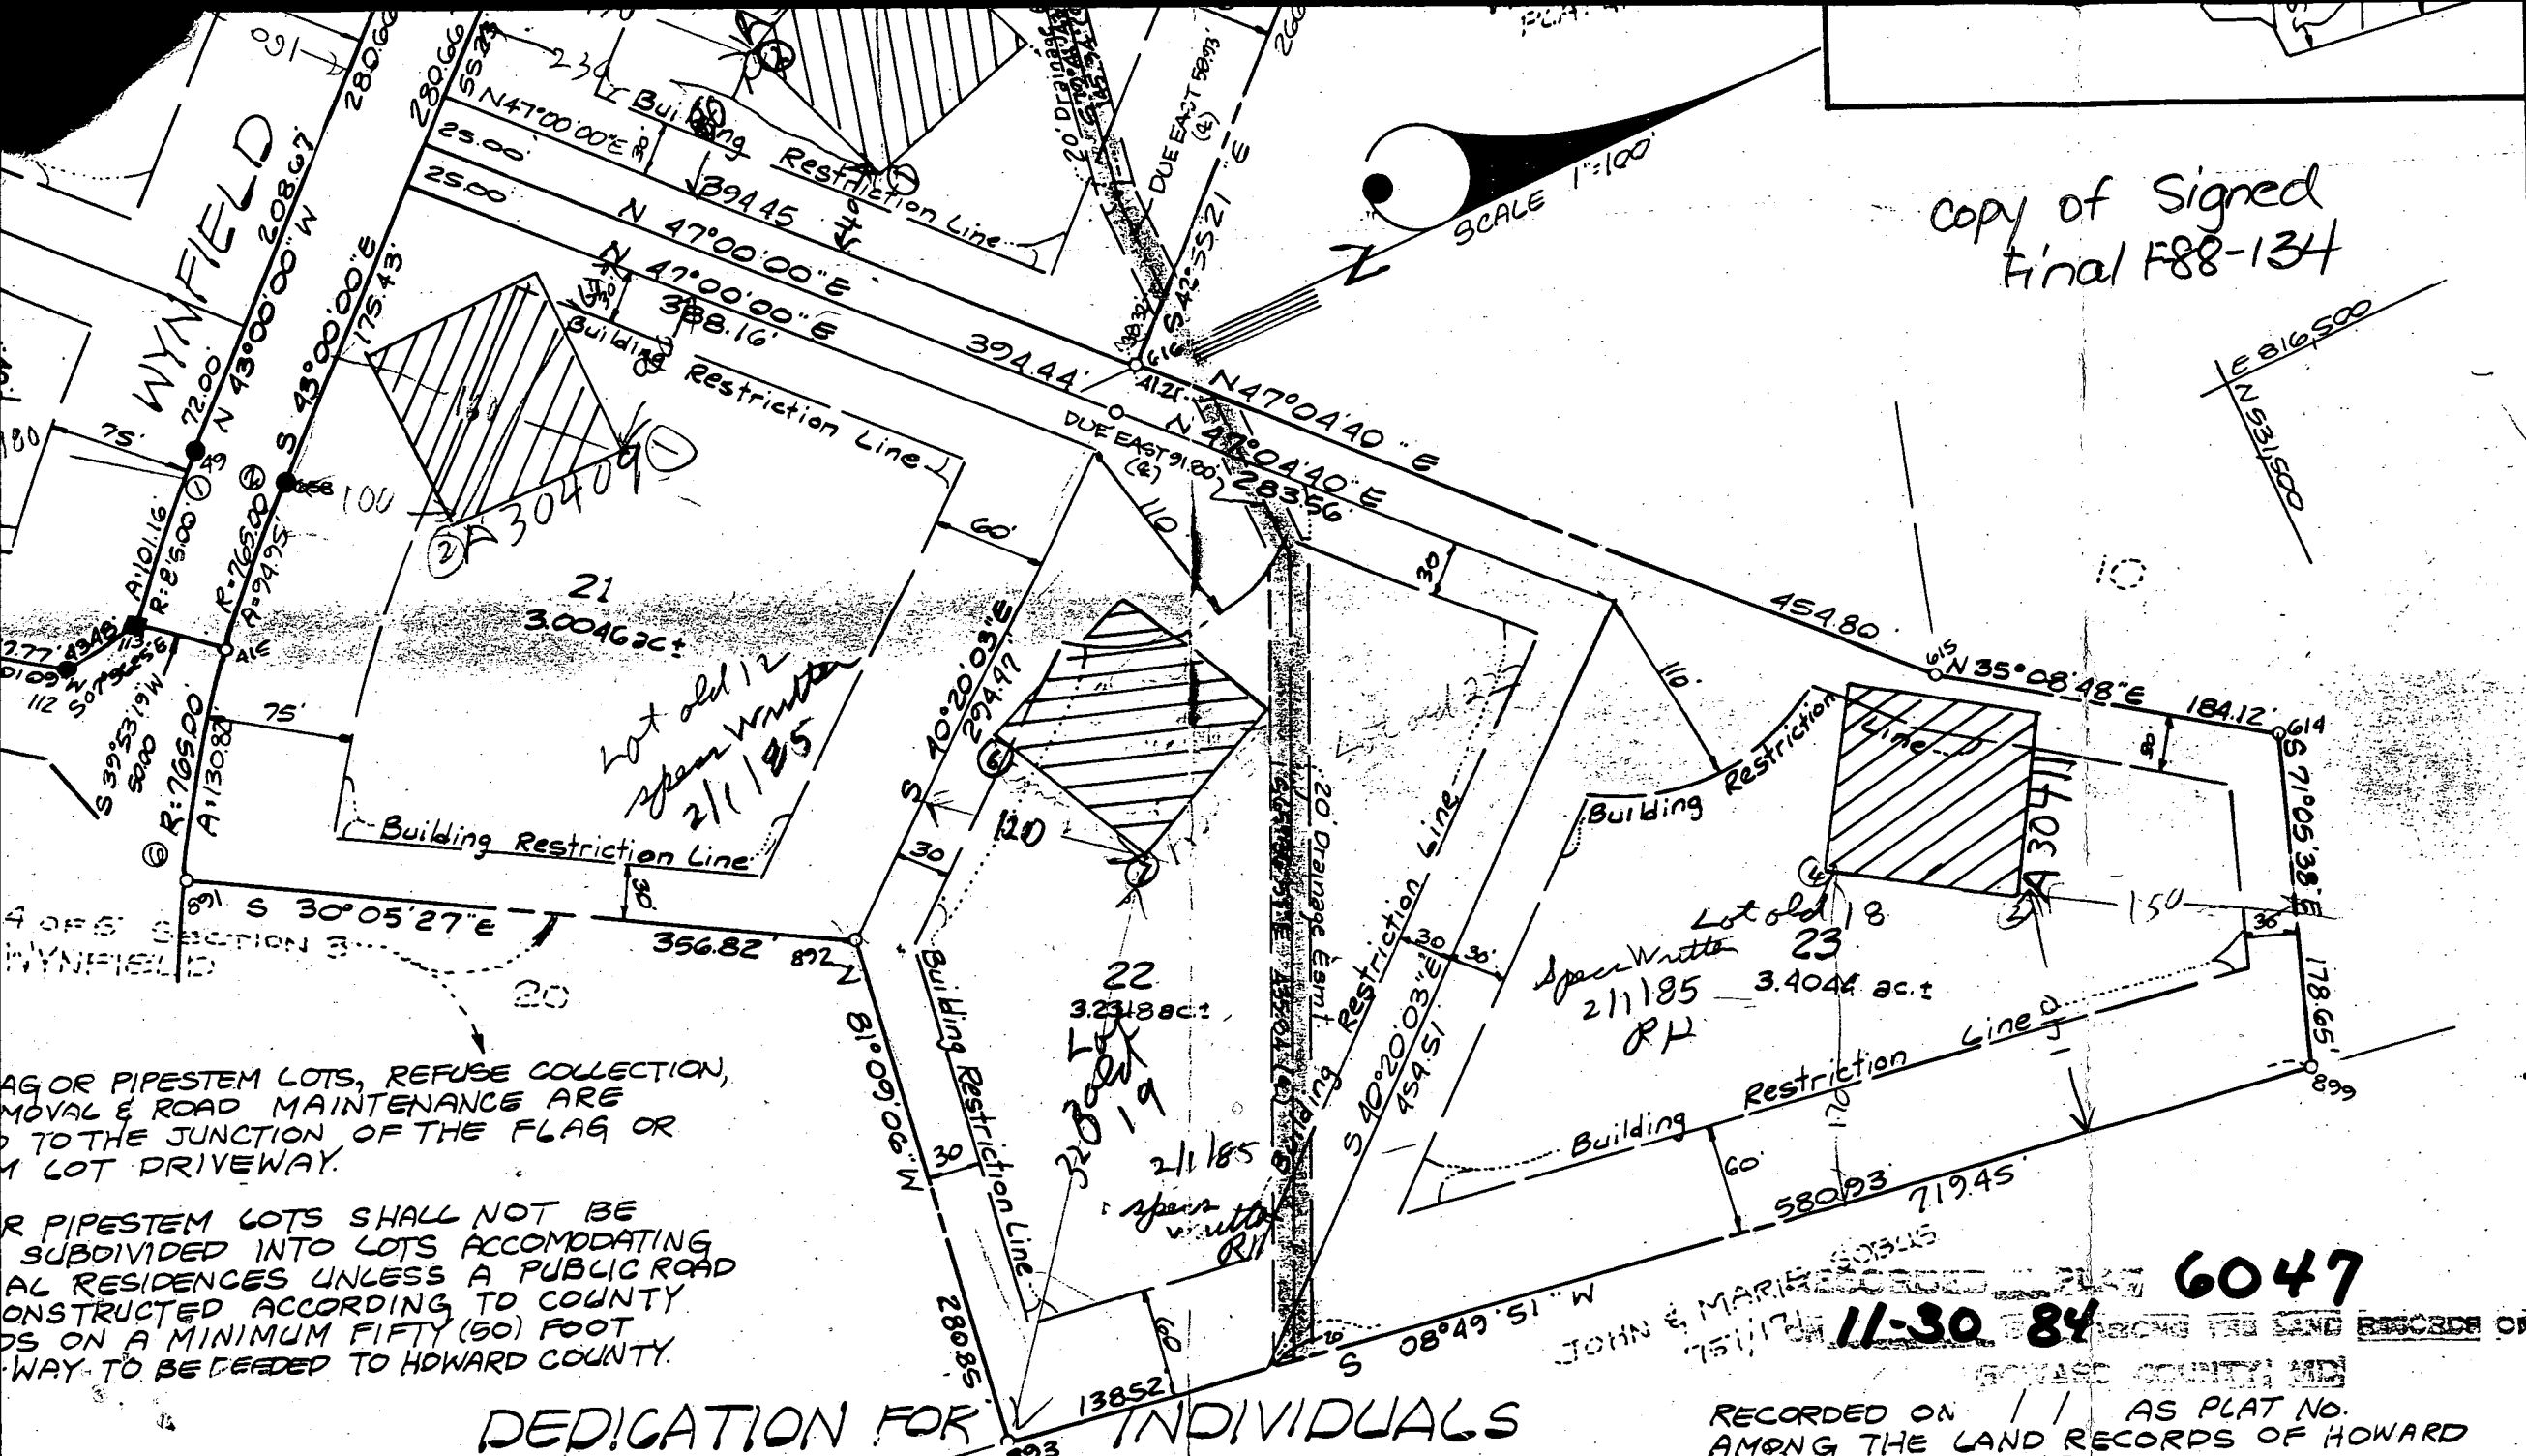

copy of signed
final F88-134

FLAG OR PIPESTEM LOTS, REFUSE COLLECTION,
REMOVAL & ROAD MAINTENANCE ARE
TO THE JUNCTION OF THE FLAG OR
LOT DRIVEWAY.

PIPESTEM LOTS SHALL NOT BE
SUBDIVIDED INTO LOTS ACCOMMODATING
RESIDENCES UNLESS A PUBLIC ROAD
CONSTRUCTED ACCORDING TO COUNTY
ORDINANCES ON A MINIMUM FIFTY (50) FOOT
DRIVEWAY TO BE DEDED TO HOWARD COUNTY.

DEDICATION FOR INDIVIDUALS

WE, BALLANGER CREEK ASSOCIATES, A MARYLAND LIMITED PARTNERSHIP,
BY KENNETH H. ROBERTS & THOMAS C. MUNZ, GENERAL PARTNERS, OWNERS OF THE
PROPERTY SHOWN AND DESCRIBED HEREON, HEREBY ADOPT THIS PLAN OF
SUBDIVISION, & IN CONSIDERATION OF THE APPROVAL OF THIS FINAL PLAT
BY THE OFFICE OF PLANNING AND ZONING, ESTABLISH THE MINIMUM BUILDING

JOHN E. MARSHALL
11-30-84
PLAT 6047
RECORDED IN THE LAND RECORDS OF
HOWARD COUNTY, MD

RECORDED ON 11 AS PLAT NO.
AMONG THE LAND RECORDS OF HOWARD
COUNTY, MARYLAND

FINAL PLAT

ADDITIONAL PERC TESTS DE
 LOTS 12, 13, 19, 34, 35, 36, 37, 3
 RETEST LOT NO. 29 & 30 DEC. 1

1" = 100'

UNNAMED
 75' 17'
 ZONED

North

