

PRELIMINARY

APPLICATION

SEWAGE DISPOSAL TESTING

STATE OF MARYLAND - DEPARTMENT OF HEALTH AND MENTAL HYGIENE

HOWARD COUNTY HEALTH DEPARTMENT
ENVIRONMENTAL HEALTH SERVICES

P.O. BOX 476 ELLICOTT, MARYLAND 21043
TELEPHONE: 992-2330

A 30410

P _____

DISTRICT 3rd.

DATE 12/10/79

TO: THE COUNTY HEALTH OFFICER
ELLICOTT CITY, MARYLAND

I, HEREBY, APPLY FOR THE NECESSARY TEST IN ORDER TO CONSTRUCT (OR RECONSTRUCT) A SEWAGE DISPOSAL SYSTEM.

PROPERTY OWNER Land Associates Richard L. & Harlene Hall 461-1443
4045 St. John Lane
ADDRESS 3450 Ft. Meade Rd., No. 206, Laurel, Md. 20810 PHONE Tom Munz - 792-2242
Ellicott City, Md or Ted Snovell - 285-6543

PROPERTY LOCATION: Wynfield
SUBDIVISION Hoffman property LOT NO. 13 SECTION 3
LOT 20

ROAD AND DESCRIPTION Route 144 28 2781 Wynfield Road

SIZE OF LOT 3 acres plus TYPE BLDG. 3 or 4 bedrooms

THE SYSTEM INSTALLED UNDER THIS APPLICATION IS ACCEPTABLE ONLY UNTIL PUBLIC FACILITIES BECOME AVAILABLE.

I FULLY UNDERSTAND THE FEE CONNECTED WITH THE FILING OF THIS PERC TEST APPLICATION IS NON-REFUNDABLE UNDER

ANY CIRCUMSTANCES.

SIGNATURE OF APPLICANT /s/ Ted Snovell for Land Associates

APPROVED BY R.D. & D.W.M. FOR DRY WELL DATE 12/27/79

REJECTED BY _____ FOR _____ DATE _____

HOLD PENDING FURTHER TESTS _____ DATE _____

REASONS FOR REJECTION OR HOLDING OK - R.D. - 12/19/79


BLDG. PERMIT SIGNED
AND RETURNED 8/6/85
Serial # 46310
SP# - 4 Bedrooms

THIS IS NOT A PERMIT


13

HOLE # 2



SOIL PROFILE

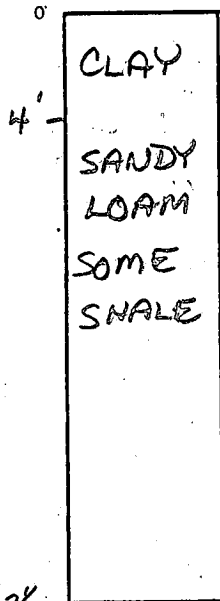

HOLE # 3 & 4

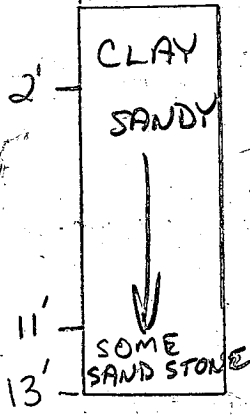

HOLE #

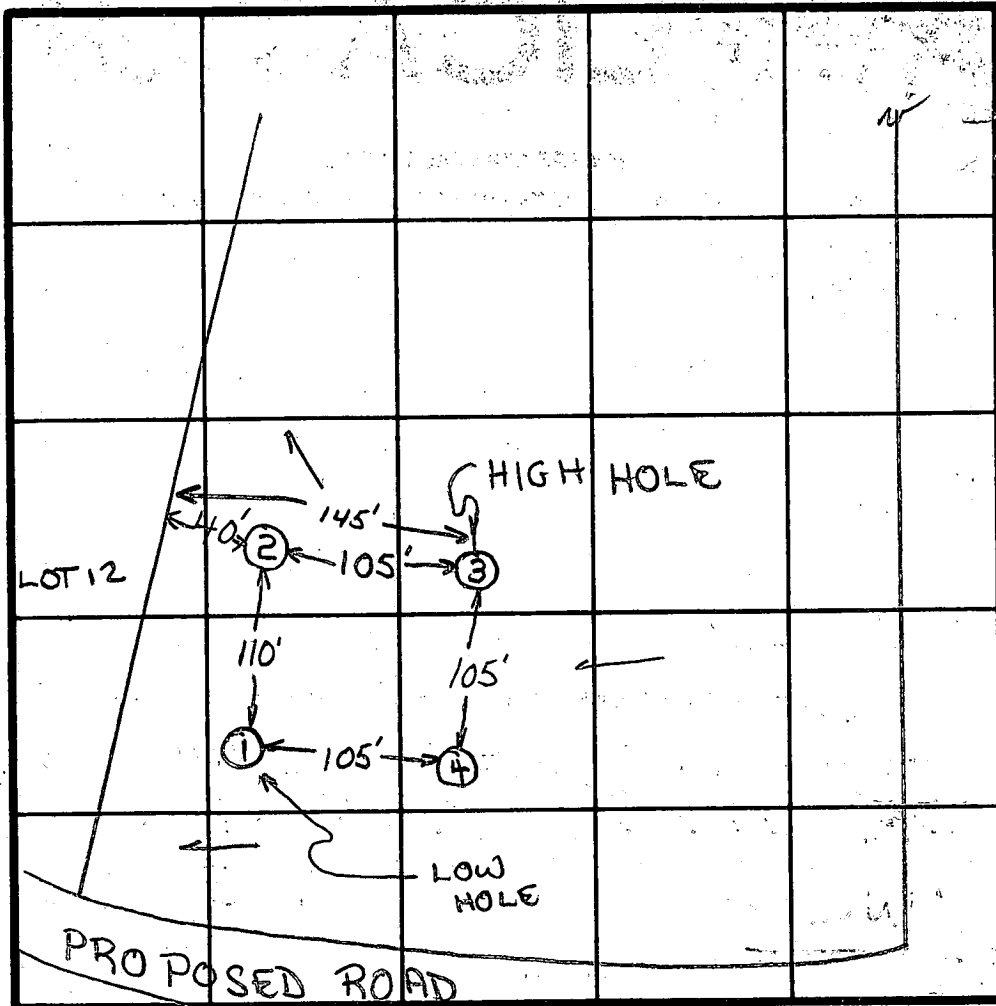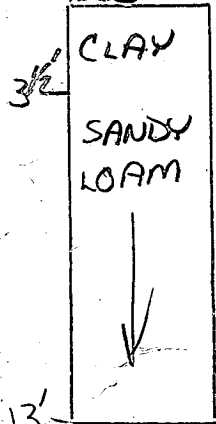

INDICATE NORTH - NAME ADJOINING ROADWAY AS BASE LINE.

DATE	TEST NO.	DEPTH	PRE-WET		TEST - 1" DROP		TIME
			START	STOP	START	STOP	
12/8/79	1S	3'	9:54	10:05	10:05	10:24	19
	1D	13'	9:54	9:56	9:56	10:02	6
	2S	4 1/2'	9:54	9:56	9:56	10:01	6
	2D	13 1/2'	9:54	10:07	10:07	10:28	21
	3S	4'	10:03	10:05	10:05	10:07	2
	3D	11 1/2'	10:06	10:09	10:09	10:14	5
	4S	4'	10:00	10:01	10:01	10:03	2
	4D	13'	10:02	10:04	10:04	10:07	3

3' in 1st
} HIGH
8 MIN. AVG.

REMARKS

TYPE OF SOIL

TESTED BY

J.S. & R.D.

ALSO PRESENT

JIM DUSZYNSKI