

2/28/86
10:30 AM

2-28-86

approved
S. Abel

PERMIT

P 30579

A 30410

SEWAGE DISPOSAL SYSTEM

MARYLAND STATE DEPARTMENT OF HEALTH

HOWARD COUNTY

BUREAU OF ENVIRONMENTAL HEALTH

902-2330

461-9933

03-309908

ELLICOTT CITY

DISTRICT 3rd.

DATE 2/24/86

INDEXED

Jack Fyock

IS PERMITTED TO INSTALL X ALTER

ADDRESS _____ PHONE 988-9270

SUBDIVISION Wynfield ROAD 2781 Wynfield Road LOT 20, Section 3

PROPERTY OWNER Richard L. Hall

ADDRESS _____

IF GARBAGE GRINDER IS USED INCREASE SEPTIC TANK CAPACITY BY 50% AND ABSORPTION AREA BY 22%.

GARBAGE GRINDER? YES _____ NO X

SEPTIC TANK CAPACITY 1000 GALLONS NUMBER OF BEDROOMS 3

TRENCHES - 163 sq. ft. per bedroom. Trench to be 2 feet wide. Inlet $3\frac{1}{2}$ feet below original grade. Bottom maximum depth 9 feet below original grade. Effective area begins at $3\frac{1}{2}$ - 5 feet below original grade. $5\frac{1}{2}$ feet of stone below distribution pipe.

LOCATION: Start the first trench 100 feet from the front lot line and 125 feet from the left side line, as seen when facing the lot from Wynfield Road. Continue to dig the trench on level ground running towards the front of the lot. Place the second trench parallel to and 10 feet away from the first trench.

NOTE: No trench to exceed 100 feet in length. If more than one trench used, a distribution box is required. Call for inspection of trench(s) before and after gravel is installed. Provide 6" - 8" diameter cleanout and cap to grade or above on septic tank. OK/cw

2-28-86 - Jack Fyock called - unable to hold sidewalls on deep trenches to put stone in; OK to in-

small leaching bed $\rightarrow$ 7' wide 114' long inlet 3.5' bottom 4.5', 1' stone below pipes.

will = 7980 AREA. S. Abel

PLANS APPROVED BY Frank Skinner DATE 8/06/85

COVER NO WORK UNTIL INSPECTED AND APPROVED.

NEITHER THE HOWARD COUNTY COUNCIL NOR THE HEALTH DEPARTMENT IS RESPONSIBLE FOR THE SUCCESSFUL OPERATION OF ANY SYSTEM.

NOTE: IF TRENCH IS USED CALL FOR INSPECTION BEFORE AND AFTER PLACING GRAVEL IN TRENCH.

NOTE: NO DRY WELL SHALL EXCEED 15 FOOT IN DIAMETER. NO ABSORPTION TRENCH TO EXCEED 100 FEET IN LENGTH.

NOTE: ALL PIPE FROM HOUSE TO SEPTIC TANK MUST BE CAST IRON OR SCHEDULE 40 PVC OR ABS.

PERMIT VOID AFTER THREE YEARS.

NOTE: INSTALL STAND PIPE ON SEPTIC TANK AND DRY WELL. STAND PIPES MUST BE 6 INCHES IN DIAMETER. CAST IRON, CONCRETE OR TERRA COTTA. OR PVC OR ABS ACCEPTED. IF TOP OF SEPTIC TANK IS DEEPER THAN 3 FEET MANHOLE TO GRADE REQUIRED.

BLDG. PERMIT SIGNED

AND RETURNED

Serial # 44023


dec

*INSTALLER IS RESPONSIBLE FOR OBTAINING FINAL APPROVAL ON THIS PERMIT

*CALL 992-2330 FOR INSPECTION OF SEPTIC SYSTEMS.

EH - 2-1082

A 30410

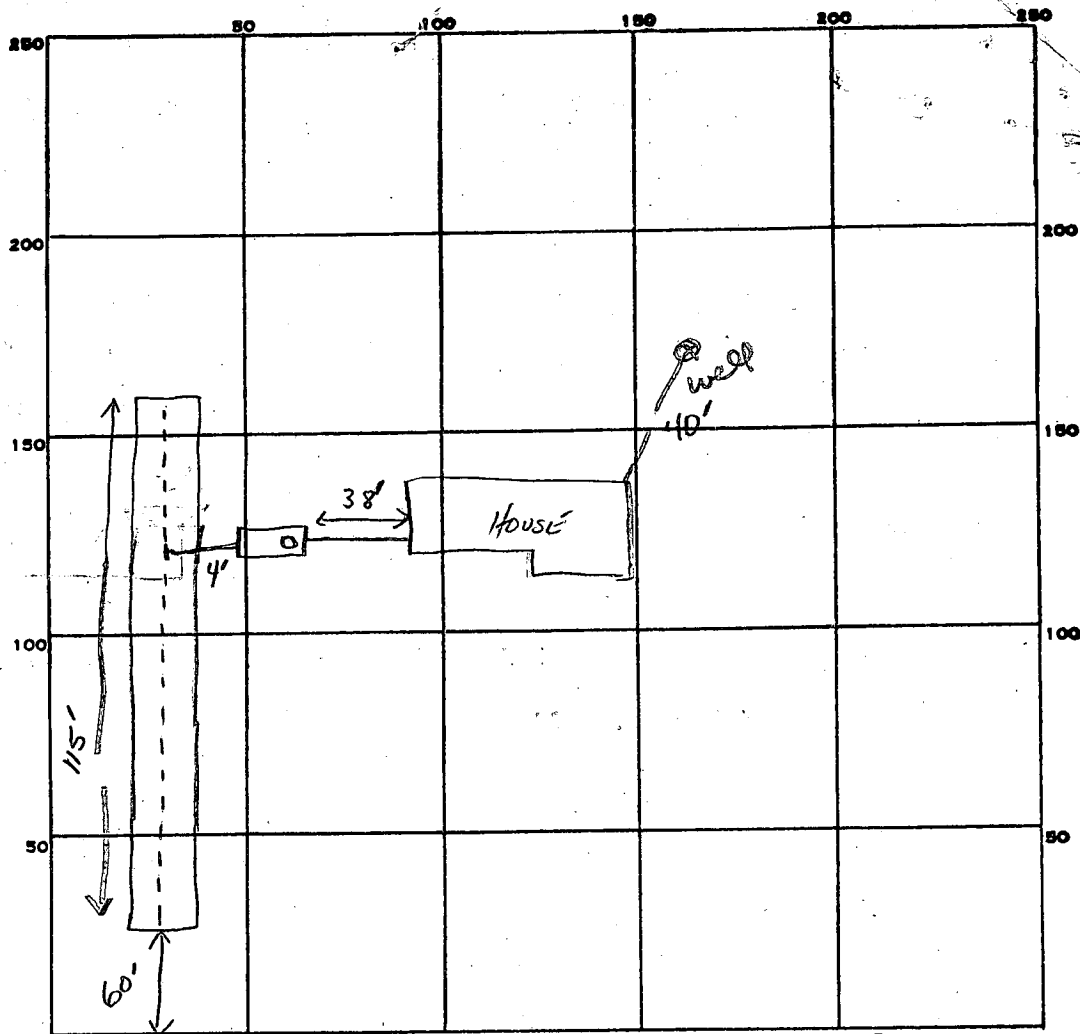

INDICATE NORTH. - NAME ADJOINING ROADWAY AS BASE LINE.

Wynfield Rd.

PERMIT CARD ✓

SEPTIC TANK, LEVEL ✓ 1000 GAL

CLEANOUTS ✓ 51

DISTRIBUTION BOX, LEVEL N/A

TILE FIELD, DEPTH 4.5 FT. TRENCH WIDTH 7 FT. INLET 35

GRAVEL DEPTH 12 IN. TOTAL LENGTH 115 FT.

NUMBER OF TRENCHES 1 TOTAL BOTTOM AREA 805 #

SEEPAGE PITS, INSIDE DIAMETER FT. DEPTH BELOW INLET FT.

ABSORBENT AREA 805 SQ. FT.

REMARKS 2-27-86 CONTINUE TO DIG BED; OK TO ADD SOME; OK TO COVER ST TO HOUSE S. Abel

2-28-86 OK TO COVER ALL WORK. S. Abel

DATE SYSTEM APPROVED 2-28-86

INSPECTOR S. Abel

SUBDIVISION:

Wynfield section 3

LOT NUMBER: 20

A 30410

DRY WELL OR DRY WELL AND TRENCH

	Septic Tank	_____ sq. ft./bedroom
3 bedroom	1000 gallon	_____
4 bedroom	1250 gallon	_____
5 bedroom	1500 gallon	_____

Inlet _____ feet below original grade.

Bottom maximum depth _____ feet below original grade.

Effective area begins at _____ feet below original grade.

NOTE: If trench is used to make up absorbent area, run the trench on level ground and leave a 5 foot earth buffer between dry well and trench. No trench is to exceed 100 feet in length. Trench inlet to be same as dry well, with _____ feet of stone below distribution pipe.


4B.R. per B.P. # 66310

TRENCHES163 sq. ft./bedroomTrench to be 2 wide.Inlet 3 1/2 feet below original grade.Bottom maximum depth 9 feet below original grade.Effective area begins at 3 1/2 feet below original grade.8 5/2 feet of stone below distribution pipe.

- NOTE:
- (1) No trench to exceed 100 feet in length.
 - (2) If more than one trench used, a distribution box is required.
 - (3) Trenches to be installed on level ground.
 - (4) Call for inspection of trench before gravel is installed.
 - (5) Provide 6"-8" diameter cleanout and cap to grade or above on septic tank and drywell.
 - (6) If a Garbage disposal is used, increase septic tank capacity by 50% and increase absorbant sidewall area by 22%.

LOCATION: Start the first trench 100ft. from the front lot line and 125ft. from the left side line, as seen when facing the lot from Wynfield Rd. Continue to dig the trench on level ground running towards the front of the lot. Place the second trench parallel to and 10 feet away from the first trench

8/6/85 Sam H. Shinn

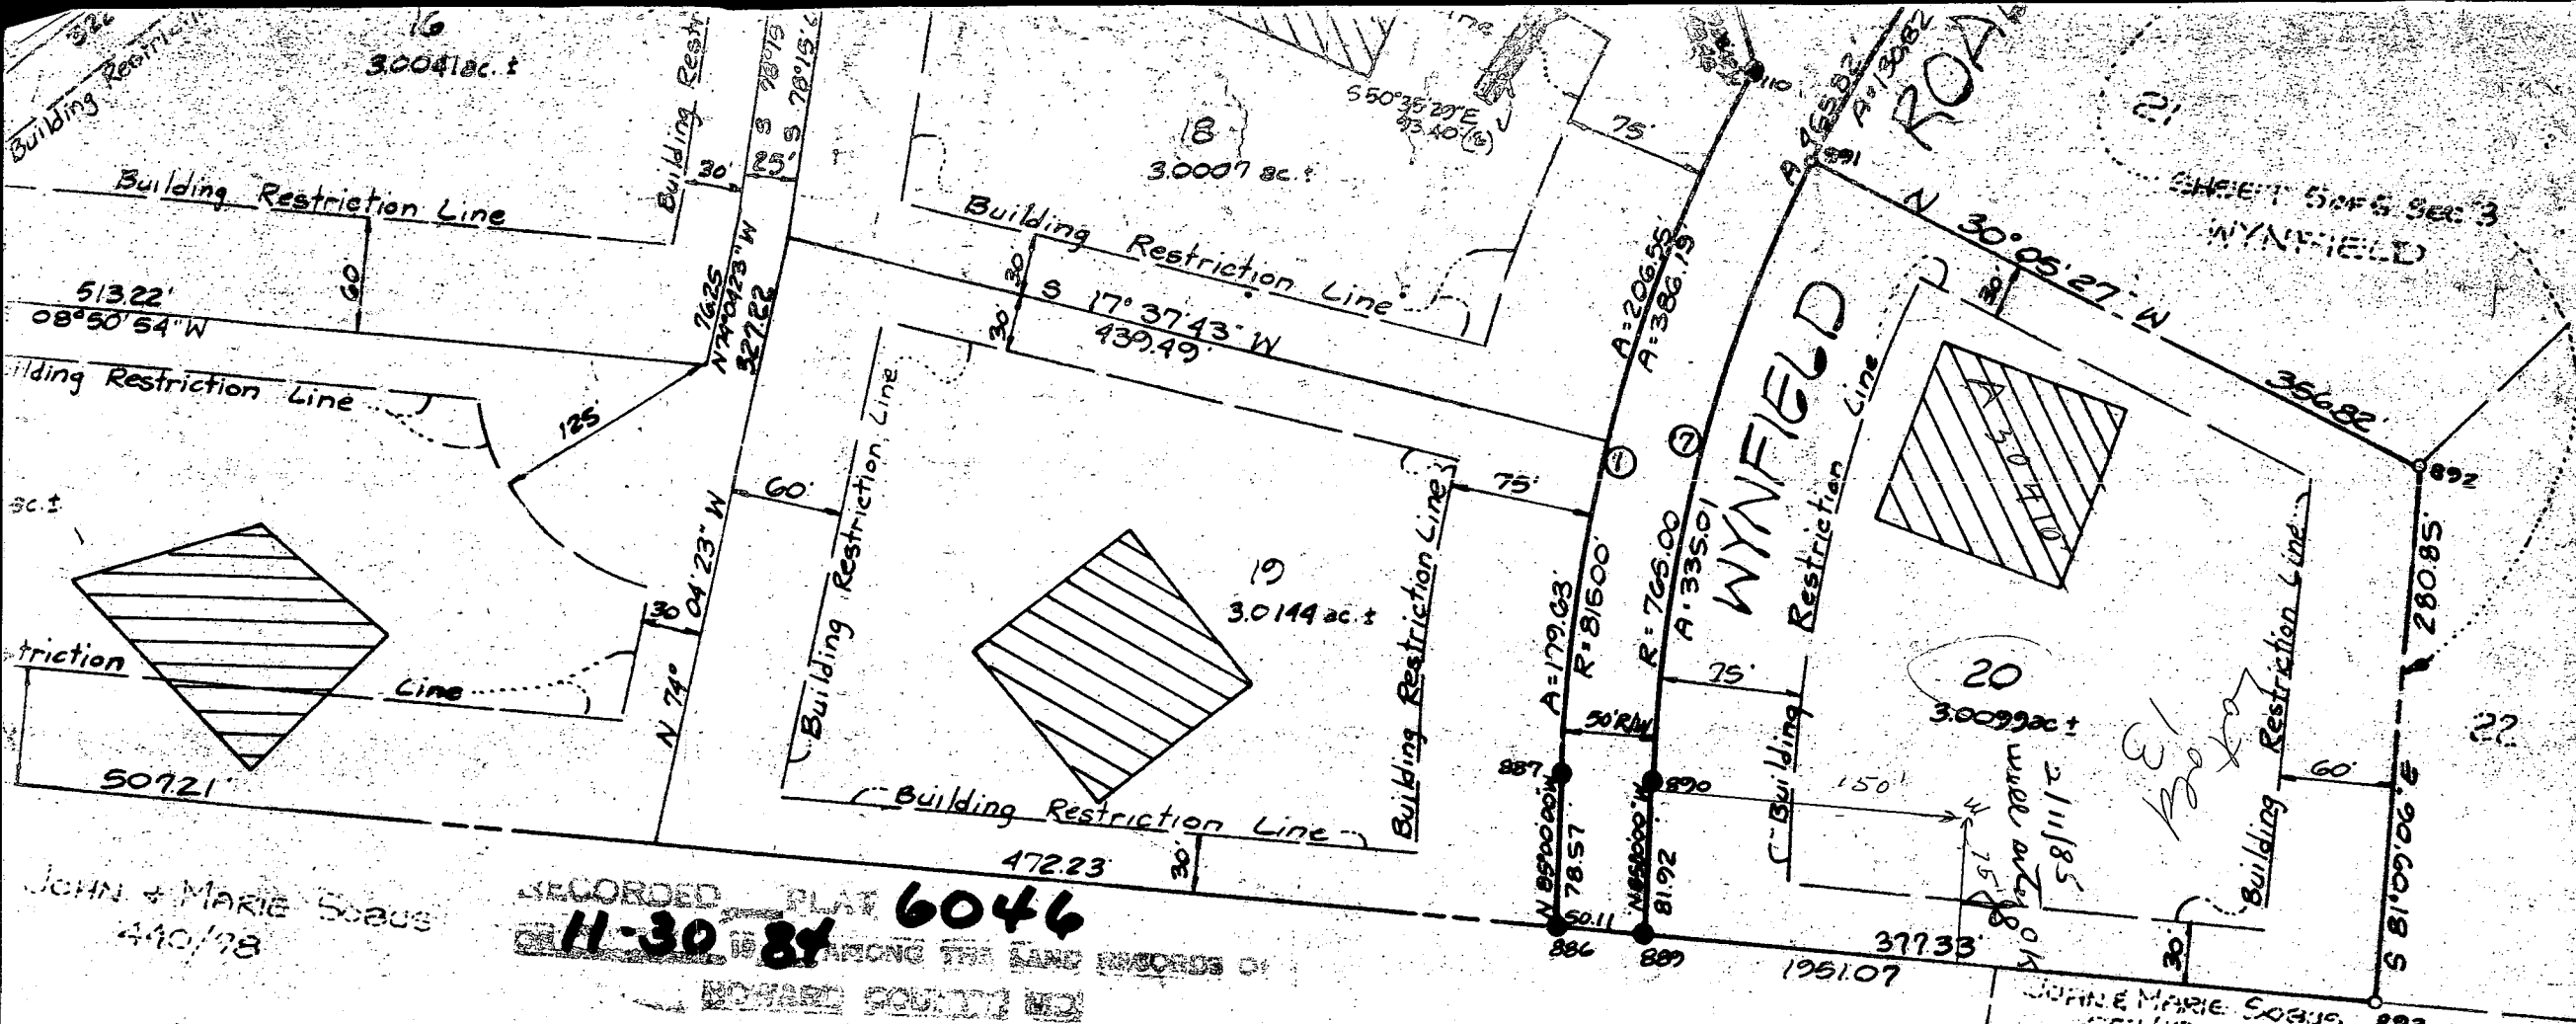

DEDICATION FOR INDIVIDUALS

WE, BALLANGER CREEK ASSOCIATES, A MARYLAND LIMITED PARTNERSHIP, BY KENNETH H. ROBERTS & THOMAS C. MUNZ, GENERAL PARTNERS, OWNERS OF THE PROPERTY SHOWN AND DESCRIBED HEREON, HEREBY ADOPT THIS PLAN OF SUBDIVISION, & IN CONSIDERATION OF THE APPROVAL OF THIS FINAL PLAT BY THE OFFICE OF PLANNING AND ZONING, ESTABLISH THE MINIMUM BUILDING RESTRICTIONS, & GRANT UNTO HOWARD COUNTY, MARYLAND ITS SUCCESSORS AND ASSIGNS: (1) THE RIGHT TO LAY, CONSTRUCT, & MAINTAIN SEWERS, DRAINS, WATER PIPES & OTHER MUNICIPAL UTILITIES & SERVICES, IN & UNDER ALL ROADS AND STREETS RIGHTS-OF-WAY & THE SPECIFIC EASEMENT AREAS SHOWING HEREON; (2) THE RIGHT TO REQUIRE DEDICATION FOR PUBLIC USE THE BEDS OF THE STREETS AND/OR ROADS, FLOOD PLAINS AND OPEN SPACES WHERE APPLICABLE, AND FOR GOOD AND OTHER VALUABLE CONSIDERATION, HEREBY GRANT THE RIGHT AND OPTION TO HOWARD COUNTY TO ACQUIRE THE FEASIBLE TITLE TO THE BEDS OF THE STREETS AND/OR ROADS, FLOOD PLAINS, STORM DRAINAGE FACILITIES, & OPEN SPACE, WHERE APPLICABLE; (3) THE RIGHT TO REQUIRE DEDICATION OF WATERWAYS AND DRAINAGE EASEMENTS FOR THE SPECIFIC PURPOSE OF THEIR CONSTRUCTION, REPAIR & MAINTENANCE; (4) THAT NO BUILDING OR SIMILAR STRUCTURE

RECORDED ON 11 AS PLAT No. 6046
AMONG THE LAND RECORDS OF HOWARD COUNTY, MARYLAND


FINAL PLAT WYNFIELD

SECTION THREE, LOTS 1 THRU 26
(INCLUDES A RESUBDIVISION OF LOT 8, SEC. 2, PLAT #5458)

SHEET 4 OF 5
3RD ELECTION DISTRICT
HOWARD COUNTY, MARYLAND
JANUARY 25, 1984 SCALE 1"=100'
TAX MAP IS PART OF PARCEL 88
S No. 80-10 P. No. 81-23

CRETE MONUMENT
PIPES SET
FICATE
PLAT SHOWN
DIVISION OF PART
MAY 29, 1981
RDS OF HOWARD
ONVEYED BY
AN UNTO
IT ALL
E. J. B. P. C.

WYNFIELD RD.

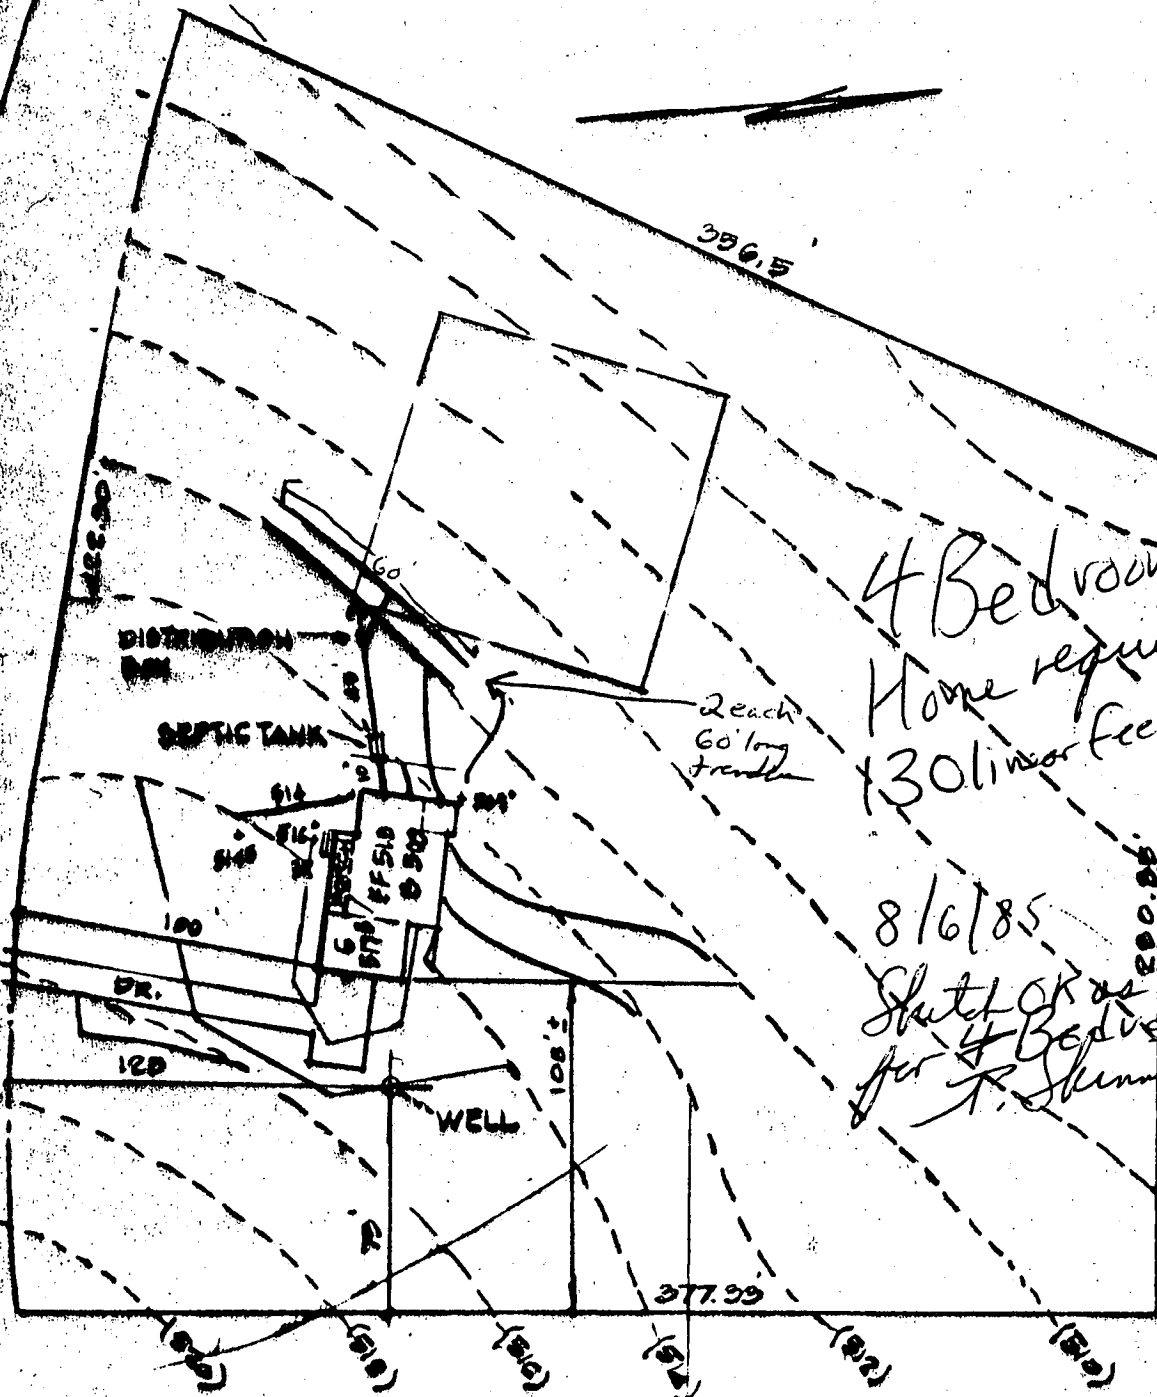

4 Bed room (500)
Home requires
130 linear feet of trench

8/6/85

Sketch OK as revised
for 4 Bed room home
for R. Shinn (300)

WELL DATA
EX. GR 515°
FIN. GR 514°

SEPTIC SYSTEM DATA

INV. OF SEWER FROM HOUSE = 512.70

SEPTIC TANK
EX. GR. 512.0
FIN. GR. 512.0
INV. IN 510.6
INV. OUT 510.6
DISTRIBUTION BOX
EX. GR 510.4
FIN. GR 510.4
INV. IN 506.70
INV. OUT 506.60

USE 2 TRENCHES 60" W.D. 10' APART 5' STARS BELOW INLET.


TRENCH - MAX DEPTH 9'
EX. GR 510.00
FIN. GR 510.00
INV. IN 506.70
INV. OUT 506.60

PLOT PLAN
LOT 20

WYNFIELD RD.
WYNFIELD SEC. 3
3RD. DIST. HO. CO. MO
JULY 28, 1987 SCALE 1" = 20'

280.85

581-09-06 E

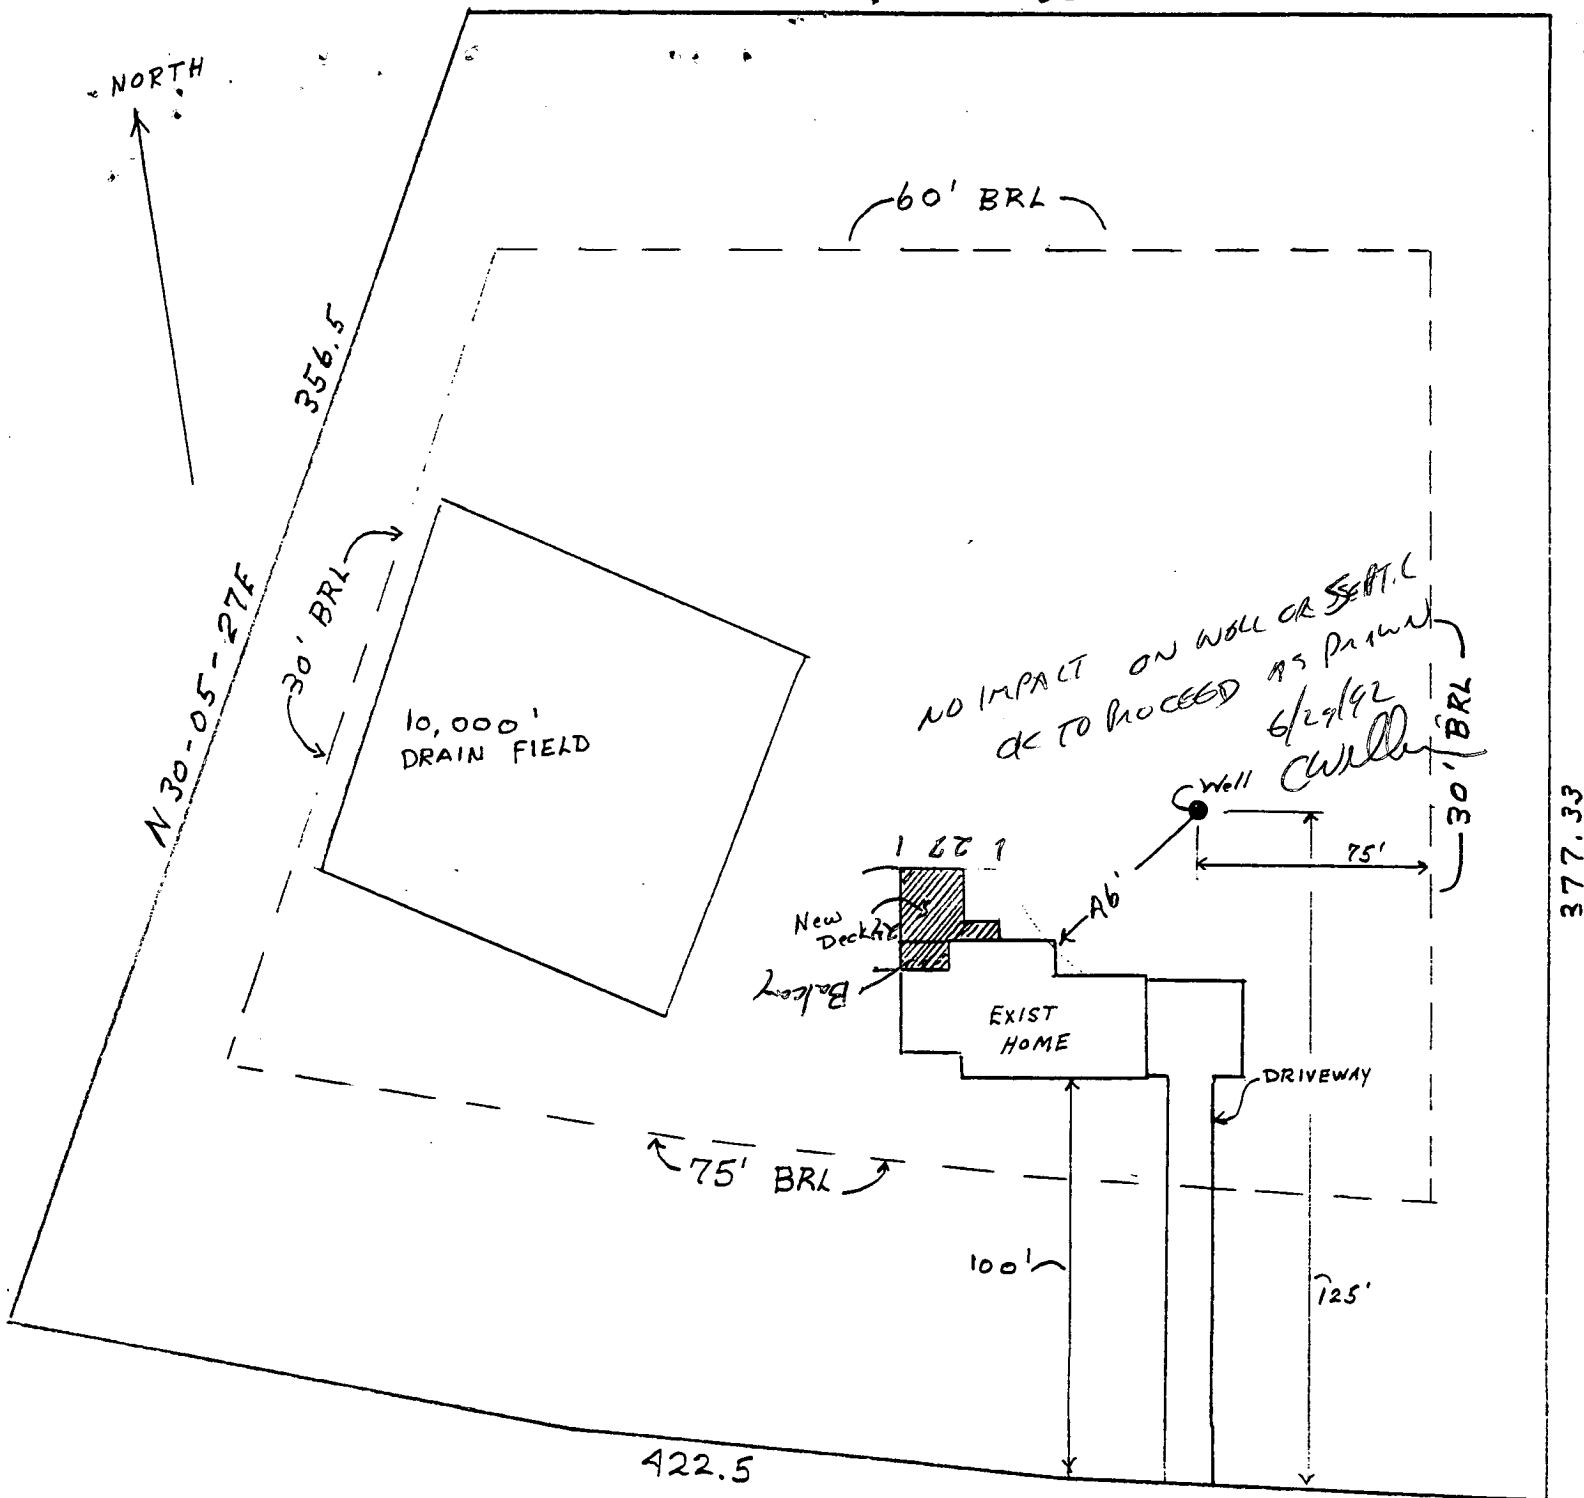

377.33

2781 WYNFIELD ROAD

LOT 20 SECTION 3

SITE PLAN

1" = 50'