

Record Detail * (This section is required.)

Permit Type	Permit Number	Opened Date
Building/Residential/Misc/Tanks	B26000946	03/30/2026

Description of Work

SFD/ INSTALL (1) 250-gallon horizontal ABOVE GROUND ProPANE TANK, trench 3/4 poly gas supply line to power the 26KW Generac Generator

[check spelling](#)

Address * (This section is required.)

Search Reset Clear Get Parcel & Owner

Street #	Street Name	Street Type	
12518	MARLOW	RD	
Unit Type	Unit #	X Coordinate	Y Coordinate
-Select-		-76.94438	39.15245
City	State	Zip Code	Primary
FULTON	MD	20759	Yes

Approved
4/2/26
RH

Parcel * (This section is required.)

Search Reset Clear Get Address & Owner

GIS ID *	Parcel	Parcel Area	Land Value	Improved Value	Exemption Value	Plan Area
836703	134	3.44	299500	911900	612400	RURAL

Legal Description

IMPSLOT 6 3.446 A[]12518 MARLOW RD[]HICKORY HILL FARMS

[check spelling](#)

Block	Lot	Census Tract	Council Dist	Inspection Dist	Supervisor Dist	Map #	DAP Zone
	6	605102	4				
Plan Area	State Tax Id	Subdivision Name					
	1405407060						
Section	Area	Tax Map					
		40					
Grid	Zoning District	ADC Map					
40-24	RR-DEO	5051-J6					
SDP No.	Final Plan No.	WP File No.					
Record Plat No.	WS Contract No.	FDP No.	Primary				
7519			Yes				
Owner Occupied	Year Built	Historic District					
<input type="radio"/> Yes <input type="radio"/> No	1988	<input type="radio"/> Yes <input checked="" type="radio"/> No					
Historic District Registry No.	Stat Area	Flood Plain					
	5-15A	<input type="radio"/> Yes <input checked="" type="radio"/> No					
Building No							

Owner * (This section is required.)

Search Reset Clear

Name *

LAU SL

Address Line 1

12518 Marlow Road

Address Line 2

Address Line 3

Mail City

Fulton

Mail State

MD

Mail Zip Code

20759

Phone

410-207-9152

Primary

Yes

E-mail

Cell Number Fax Number

Professionals (This section is not required.)

License # * Business Name
 License Type * First Name Middle Name Last Name
 Primary Address Line 1
 Address Line 2
 City State ZIP Code
 Phone 1 Phone 2 Fax
 E-mail

Applicant (This section is not required.)

Search As Owner As Lic. Prof As Contact

Type * First Name MI Last Name
 Relationship Full Name
 Primary Organization Name
 Street Address
 Address Line 2
 City State Zip Code
 Phone Cell Fax
 E-mail *

Addtl Info

Est Construction Cost * Housing Units * Number of Buildings * Public Owned
 Construction Type

TANK INFORMATION

RESIDENTIAL TANK INFORMATION


Capital Project-No Fee * Yes No Capital Project Number (Text) Fee Exempt * Yes No Roadside Tree Project Permit * Yes No Roadside Tree Permit # (Text)
 Existing Use * Number of Tanks Installed * (Number) Number of Tanks Removed * (Number)
 Water Supply Sewage Disposal Expiration Date Relocate Existing Tank * (Number)

Related Records

Showing 1-2 of 2

Permit Number	Record Type Alias	Status	Number	Street Name	Opened Date	Description
B26000946	Residential Tank Permit	Review In Process	12518	MARLOW	03/30/2026	SFD/ INSTALL (1) 250-gallon horizontal ABOVE GF
P26001177	Residential Plumbing Addition Alteration Permit	Incomplete	12518	MARLOW	03/30/2026	SFD/We are installing a 250-gallon horizontal LP tai

Propane Tank
 Sq. Ft. is
 11.10 sq. ft.

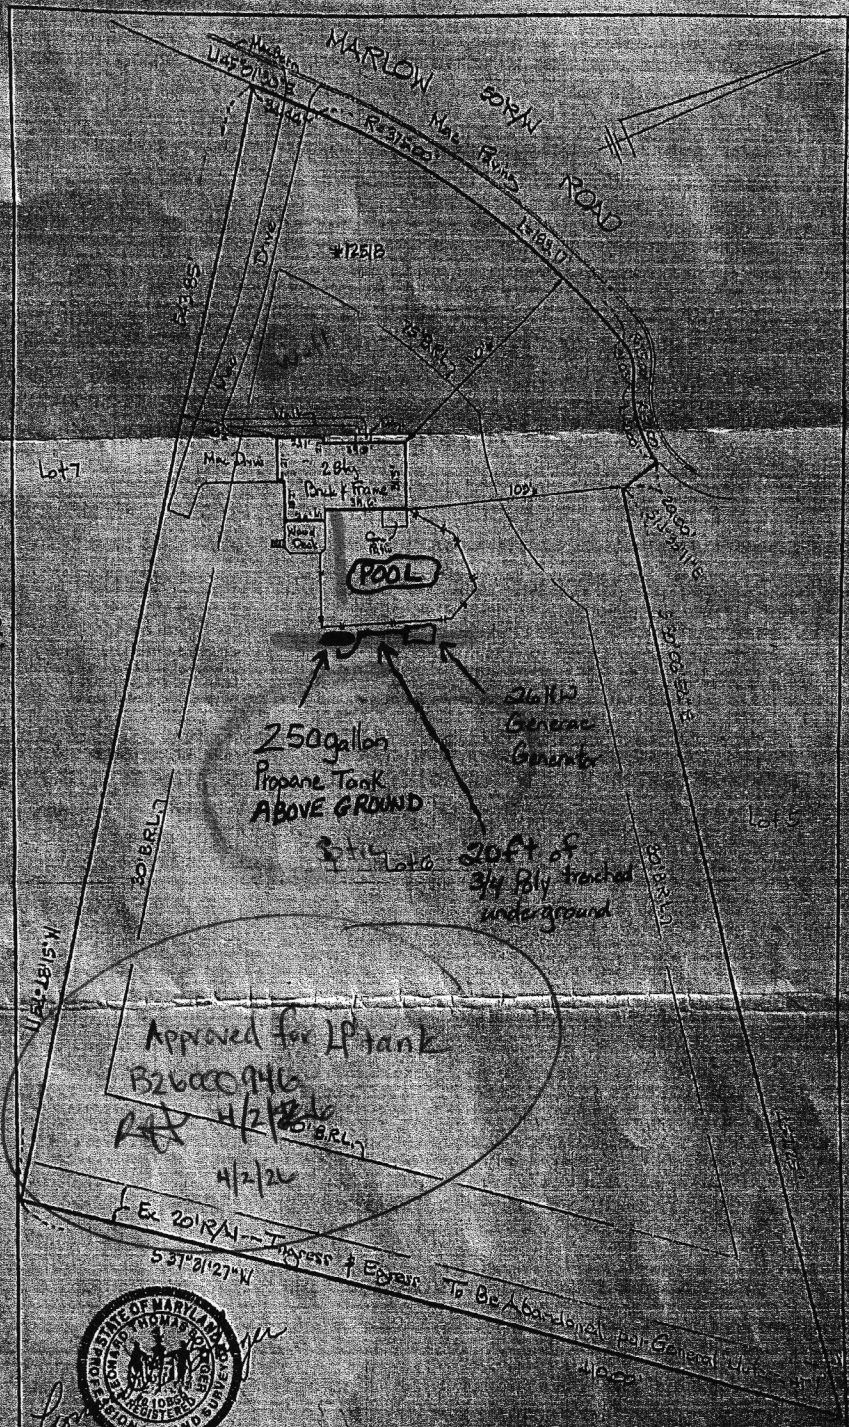

Approved for LP tank
 B26000946
 4/2/20
 4/2/20



THE LOT SHOWN HEREON IS IN FLOOD
 ZONE PER FEMA FLOOD
 INSURANCE RATE MAP PANEL 22234C-2037B
 THIS IS TO CERTIFY THAT THE IMPROVEMENTS INDICATED
 HEREON ARE LOCATED AS SHOWN. THIS IS NOT A PROPERTY
 LINE SURVEY AND SHOULD NOT BE USED AS SUCH.

H HICKS ENGINEERING CO., INC. CIVIL ENGINEERS / SURVEYORS / PLANNERS 200 EAST JORRA ROAD - SUITE 402 TOWSON, MARYLAND 21286 TELEPHONE: (410) 294-0000	LOCATION CERTIFICATION #12518 MARLOW ROAD, LOT 8 FOR LOT #12518 WOODSIDE HILL FARM HOWARD COUNTY, MD. PER PLAN #12518
	DATE: 4/2/20 SCALE: 1/8" = 1'-0" FILE:

