

Name: Brian Rosenberg
Street Address: 13626 Fox Stream Way
City, State, Zip: West Friendship, MD, 21794
Date: 12/13/24

Amendment, Permit # B24000196

*Approved 7/12
2/13/2025*

Ms. Debbie Whalen
Division of Plan Review
Department of Inspections, Licenses and Permits
Howard County Government
3430 Court House Drive
Ellicott City, MD 21043

Dear Ms. Whalen:

I am requesting to amend Permit # B24000196 at
13626 FOX STREAM WAY to
SFD/ INSTALL NEW 18'x42' (756 SF) INGROUND CONCRETE SWIMMING POOL, 3'-3" to 8'
DEEP, 26 SF SPA, AUTOMATIC SAFETY COVER AS BARRIER

Enclosed:


- Fee: \$50
- Plot Plans
- Sets of Construction Drawings
- Other: George Martin Auto Cover Approval Email

If there is anything we can do to assist you, please let me know.

Sincerely,



Name: Brian Rosenberg
Title: Homeowner
Phone: 443-710-7626
Email: brosenberg@r-plaw.com

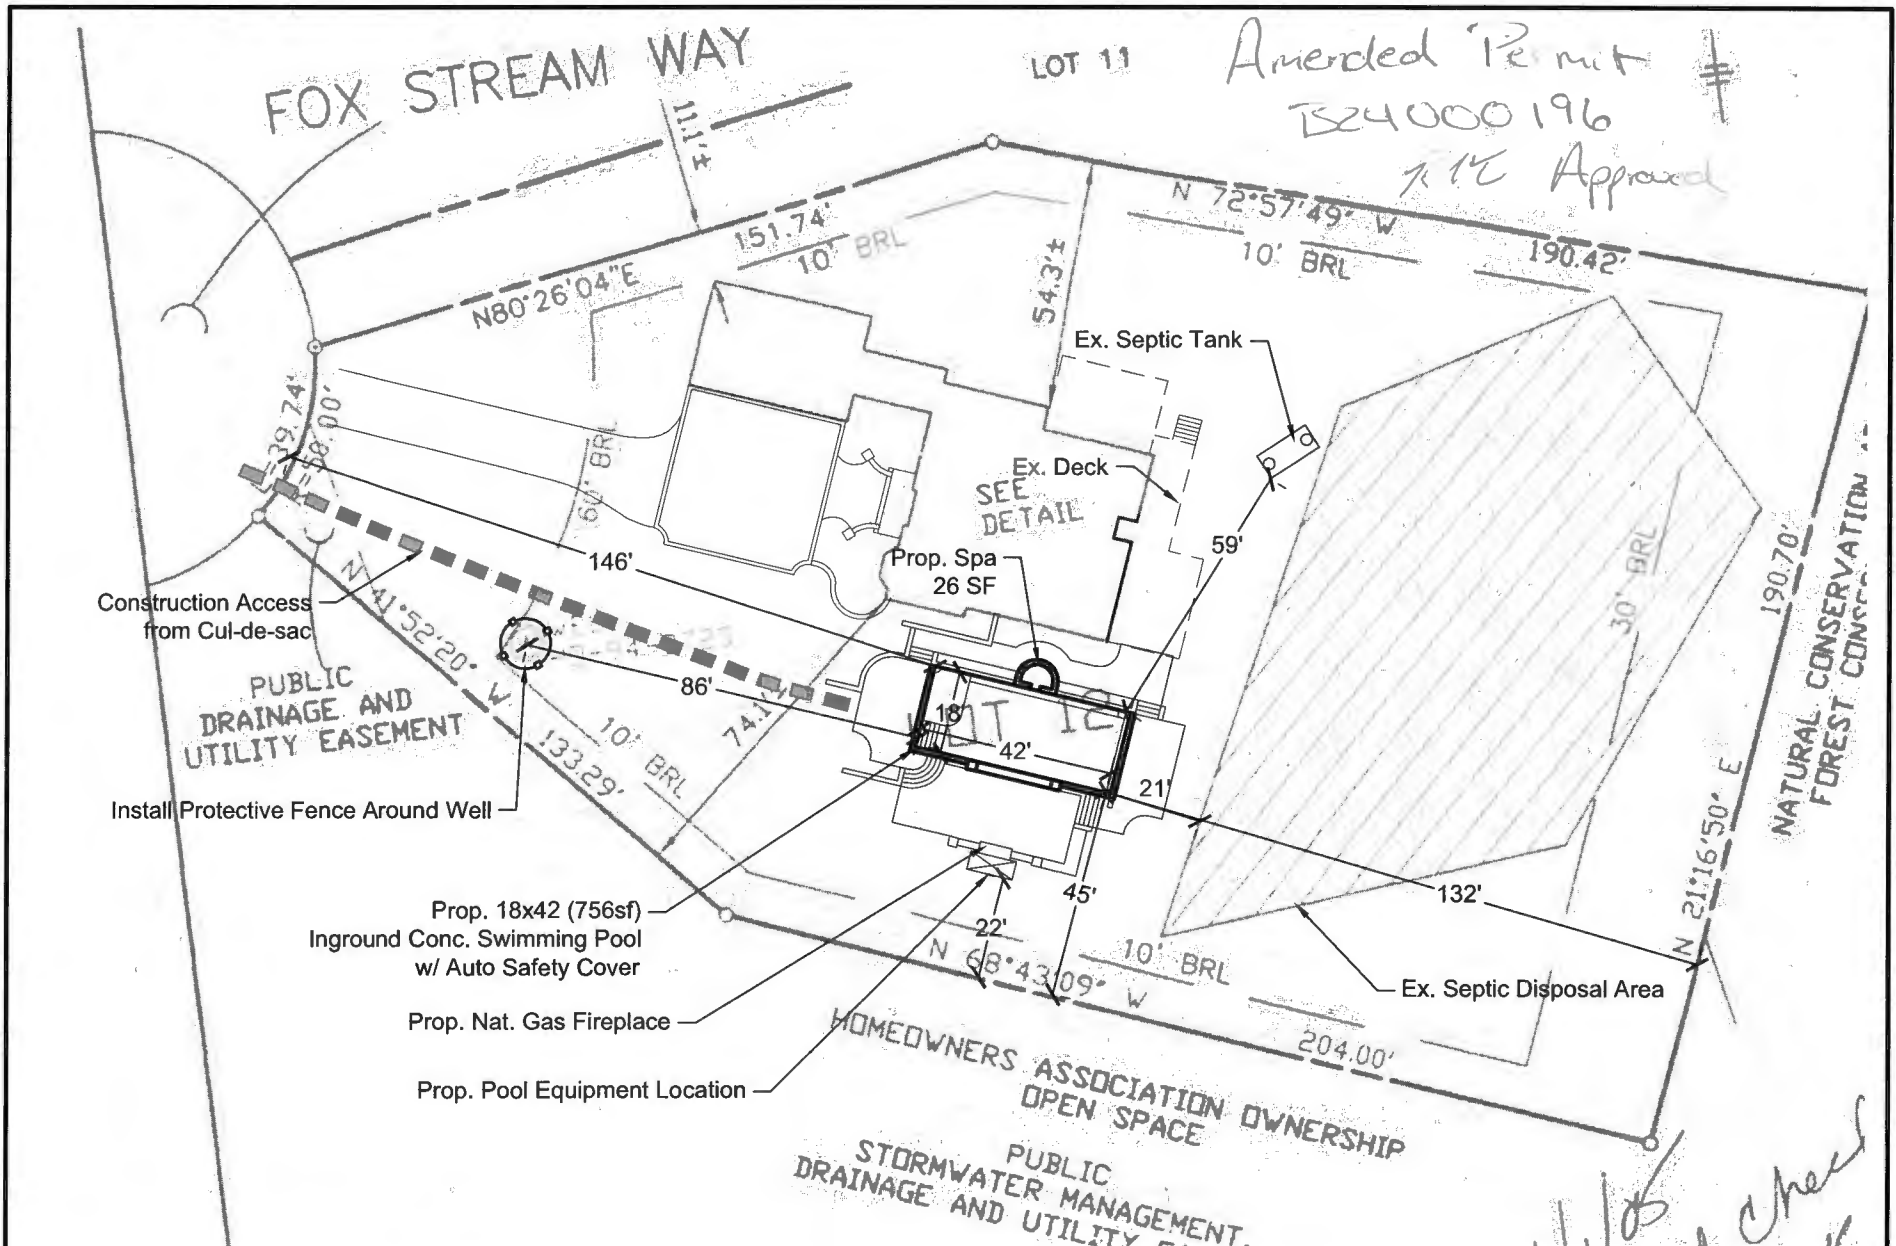

**THE ROSENBERG RESIDENCE
POOL LOCATION PLAN**

13626 FOX STREAM WAY

1" = 40'-0"

OCTOBER 23, 2024

PROPERTY INFORMATION:

PLAT: 16865

LOT: 12

TAX MAP: 15 GRID: 19 PARCEL: 167

DESCRIPTION: FOX MEADOW

RHINE

LANDSCAPING • CONSTRUCTION • POOLS

MHIC # 121739

PO Box 1825, Sykesville, MD 410-442-2445
www.rhinelandscaping.com • www.rhinepools.com