

Record Detail * (This section is required.)

Permit Type	Permit Number	Opened Date
Building/Residential/Misc/Deck	B25000986	03/18/2025
Description of Work		
SFD/CONSTRUCT 48.5'x22.6' OPEN DECK WITH STEPS		

Approved 3/26/2025
R/E

Online BP.
gg 3/24/25

[check spelling](#)

Address * (This section is required.)

Search Reset Clear Get Parcel & Owner

Street #	Street Name	Street Type	
4276	BUCKSKIN WOOD	DR	
Unit Type	Unit #	X Coordinate	Y Coordinate
-Select-		-76.97591	39.25539
City	State	Zip Code	Primary
ELLCOTT CITY	MD	21042	Yes

Parcel * (This section is required.)

Search Reset Clear Get Address & Owner

GIS ID *	Parcel	Parcel Area	Land Value	Improved Value	Exemption Value	Plan Area
891001	77	1	380000	860400	0	RURAL
Legal Description						
LOT 30 1.007 A []4276 BUCKSKIN WOOD DR []BUCKSKIN RIDGE						

[check spelling](#)

Block	Lot	Census Tract	Council Dist	Inspection Dist	Supervisor Dist	Map #	DAP Zone
	30	605101	5				
Plan Area	State Tax Id		Subdivision Name				
	1405436842						
Section	Area		Tax Map				
			22				
Grid	Zoning District		ADC Map				
22-21	RR-DEO		4813-D10				
SDP No.	Final Plan No.		WP File No.				
	F-01-191						
Record Plat No.	WS Contract No.		FDP No.	Primary			
15522				Yes			
Owner Occupied	Year Built		Historic District				
<input type="radio"/> Yes <input type="radio"/> No	2006		<input type="radio"/> Yes <input checked="" type="radio"/> No				
Historic District Registry No.	Stat Area		Flood Plain				
	5-02A		<input type="radio"/> Yes <input checked="" type="radio"/> No				
Building No							

Owner * (This section is required.)

Search Reset Clear

Name *
PANDY

Address Line 1
4276 BUCKSKIN WOOD DR


Address Line 2

Address Line 3



Submit

Cancel

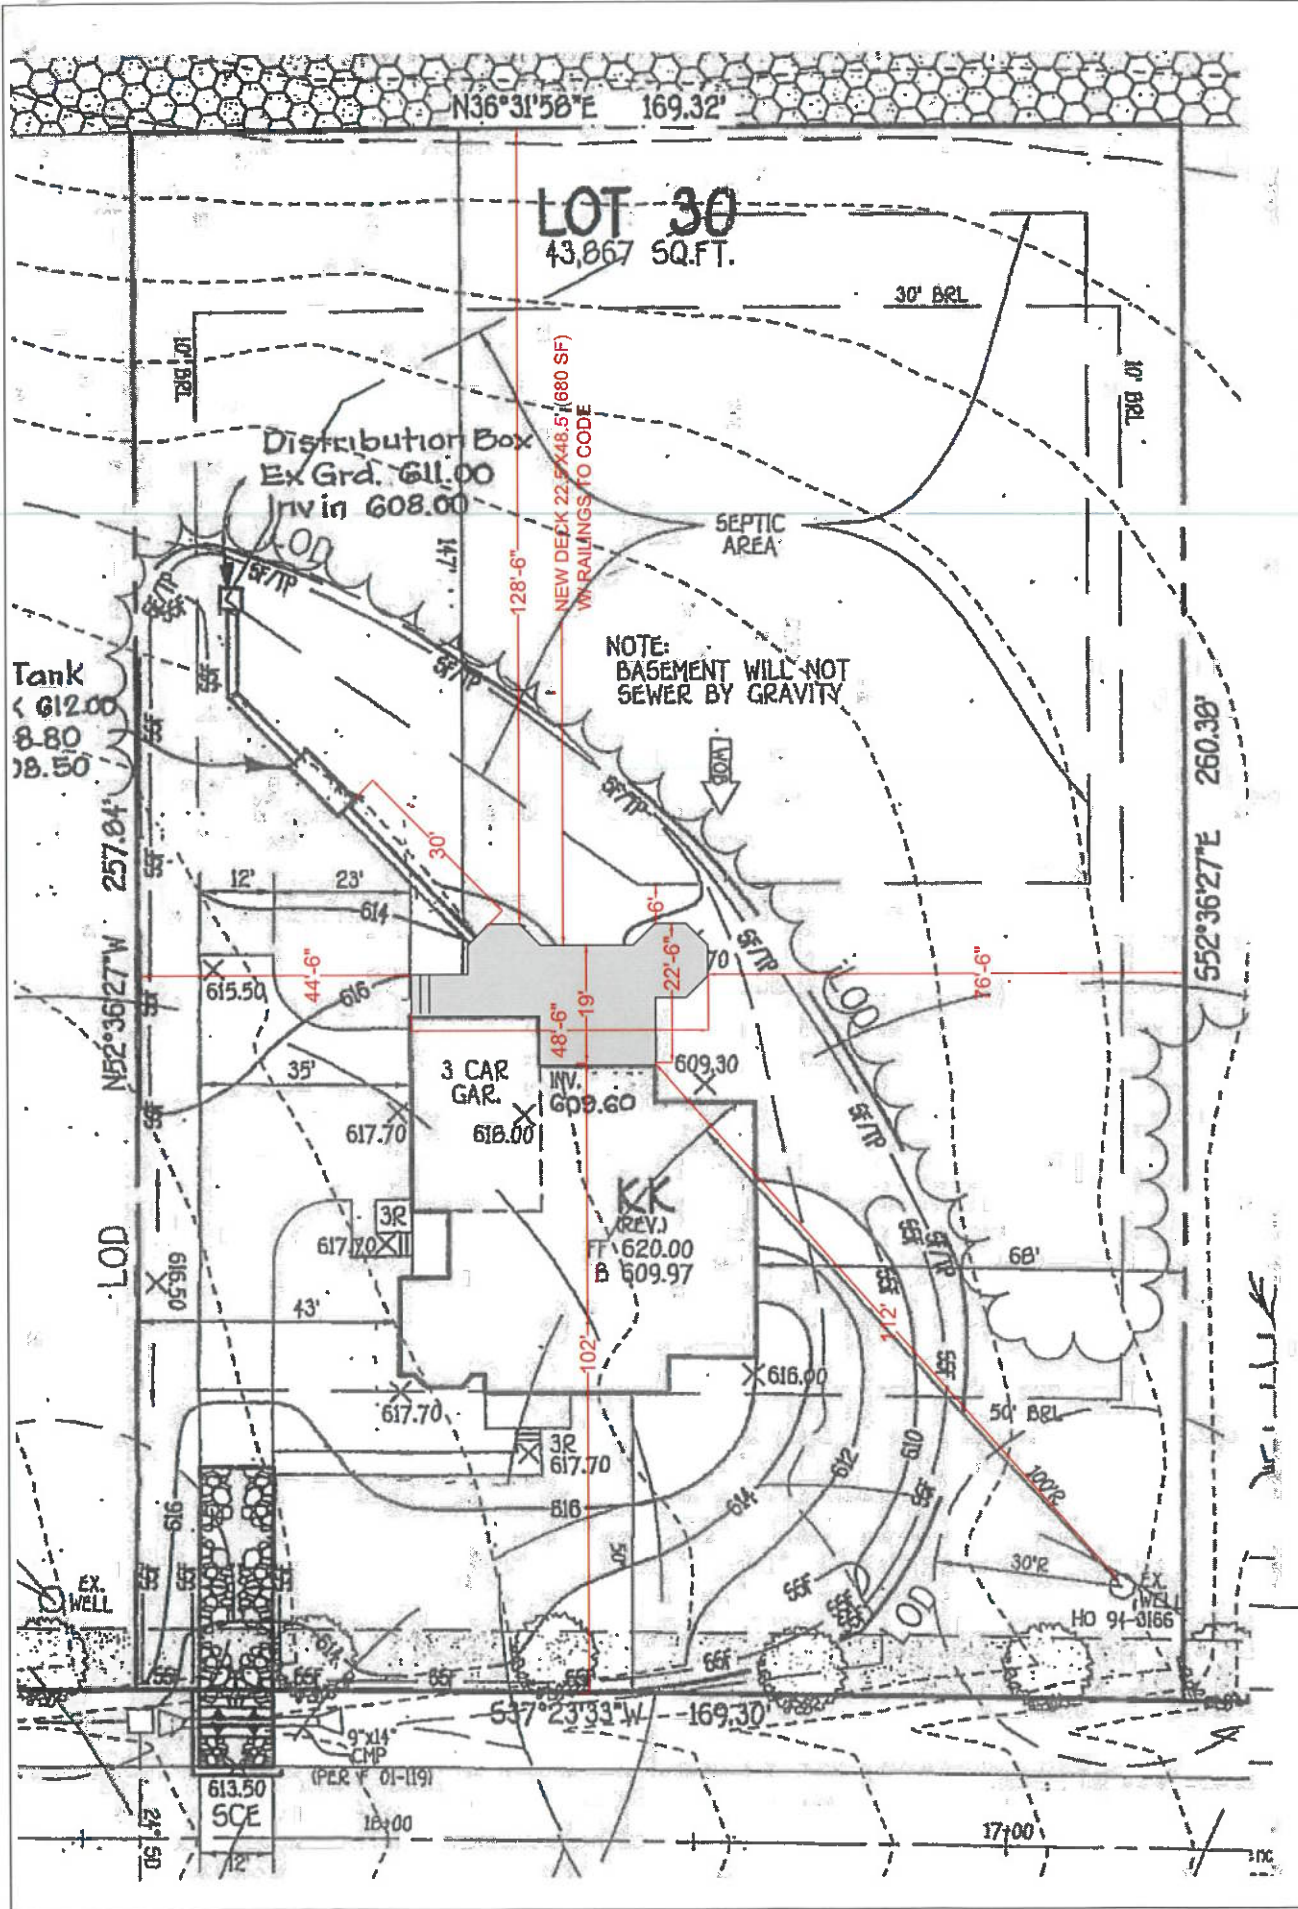

SCALE: 1"=30'-0"

Approved 3/26/2025 RJK
1325000986

SANJIV PANDYA
4276 Buckskin Wood Drive
Ellicott City, MD 21042