

Record Detail * (This section is required.)

Permit Type

Building/Residential/Misc/Shed

Permit Number

B25001248

Opened Date

04/02/2025

Description of Work

SFD/ CONSTRUCT 20' X 16' STORAGE SHED

Approved RMC
4/14/2025Online BP.
g8 4/14/25[check spelling](#)

Address * (This section is required.)

Search Reset Clear Get Parcel & Owner

Street #	Street Name	Street Type	
4866	TEN OAKS	RD	
Unit Type	Unit #	X Coordinate	Y Coordinate
-Select-		-76.98587	39.23743
City	State	Zip Code	Primary
DAYTON	MD	21036	Yes

Parcel * (This section is required.)

Search Reset Clear Get Address & Owner

GIS ID *	Parcel	Parcel Area	Land Value	Improved Value	Exemption Value	Plan Area
883766	171	5.27	274500	572000	291300	RURAL
Legal Description						
5.2755 A []4866 TEN OAKS RD []4866 TEN OAKS RD						

[check spelling](#)

Block	Lot	Census Tract	Council Dist	Inspection Dist	Supervisor Dist	Map #	DAP Zone
		605101	5				
Plan Area	State Tax Id		Subdivision Name				
	1405352274						
Section	Area		Tax Map				
			28				
Grid	Zoning District		ADC Map				
28-8	RR-DEO		4933-C3				
SDP No.	Final Plan No.		WP File No.				
Record Plat No.	WS Contract No.		FDP No.	Primary			
				Yes			
Owner Occupied	Year Built		Historic District				
☐ Yes ☐ No	1973		☐ Yes ☒ No				
Historic District Registry No.	Stat Area		Flood Plain				
	5-04A		☐ Yes ☒ No				
Building No							

Owner * (This section is required.)

Search Reset Clear

Name *

MALON

Address Line 1

4866 Ten Oaks Road

Address Line 2

Address Line 3

Mail City
DAYTON
Mail State
MD
Mail Zip Code
21036
Phone
240-687-6326
Primary
Yes
E-mail
RMALONEY@MALONEYAIRE.COM
Cell Number
Fax Number

Professionals (This section is not required.)

License # *
0
License Type *
Property Owner
Primary
Yes
Business Name
OWNER TO ACT AS CONTRACTOR
First Name
Middle Name
Last Name
RUSSELL
MALONEY
Address Line 1
Address Line 2
City
State
ZIP Code
Phone 1
Phone 2
Fax
E-mail

Applicant (This section is not required.)

Search As Owner As Lic. Prof As Contact

Type *
Applicant
Relationship
Applicant
Primary
Yes
First Name
MI
Last Name
Russell
Maloney
Full Name
Russell Maloney
Organization Name
Street Address
4866 Ten Oaks Road
Address Line 2
City
Dayton
State
MD
Zip Code
21036
Phone
240-687-6326
Cell
240-687-6326
Fax
E-mail *
rmaloney@maloneyaire.com

Addtl Info

Est Construction Cost *
8000
Housing Units *
0
Number of Buildings *
0
Public Owned
No
Construction Type
649 - All Other Buildings and Structures

MISC PERMIT INFO


MISCELLANEOUS PERMIT INFORMATION

Capital Project-No Fee *
☐ Yes ☒ No
Capital Project Number
Fee Exempt *
☐ Yes ☒ No
Roadside Tree Project Permit *
☐ Yes ☒ No
Roadside Tree Project Permit #
Existing Use *
Other - See Description of Work
Water
Private
Sewage
Private
Expiration Date
10/6/2025

Submit


Cancel

Approved
 1325001248
 R/T 4/14/2025

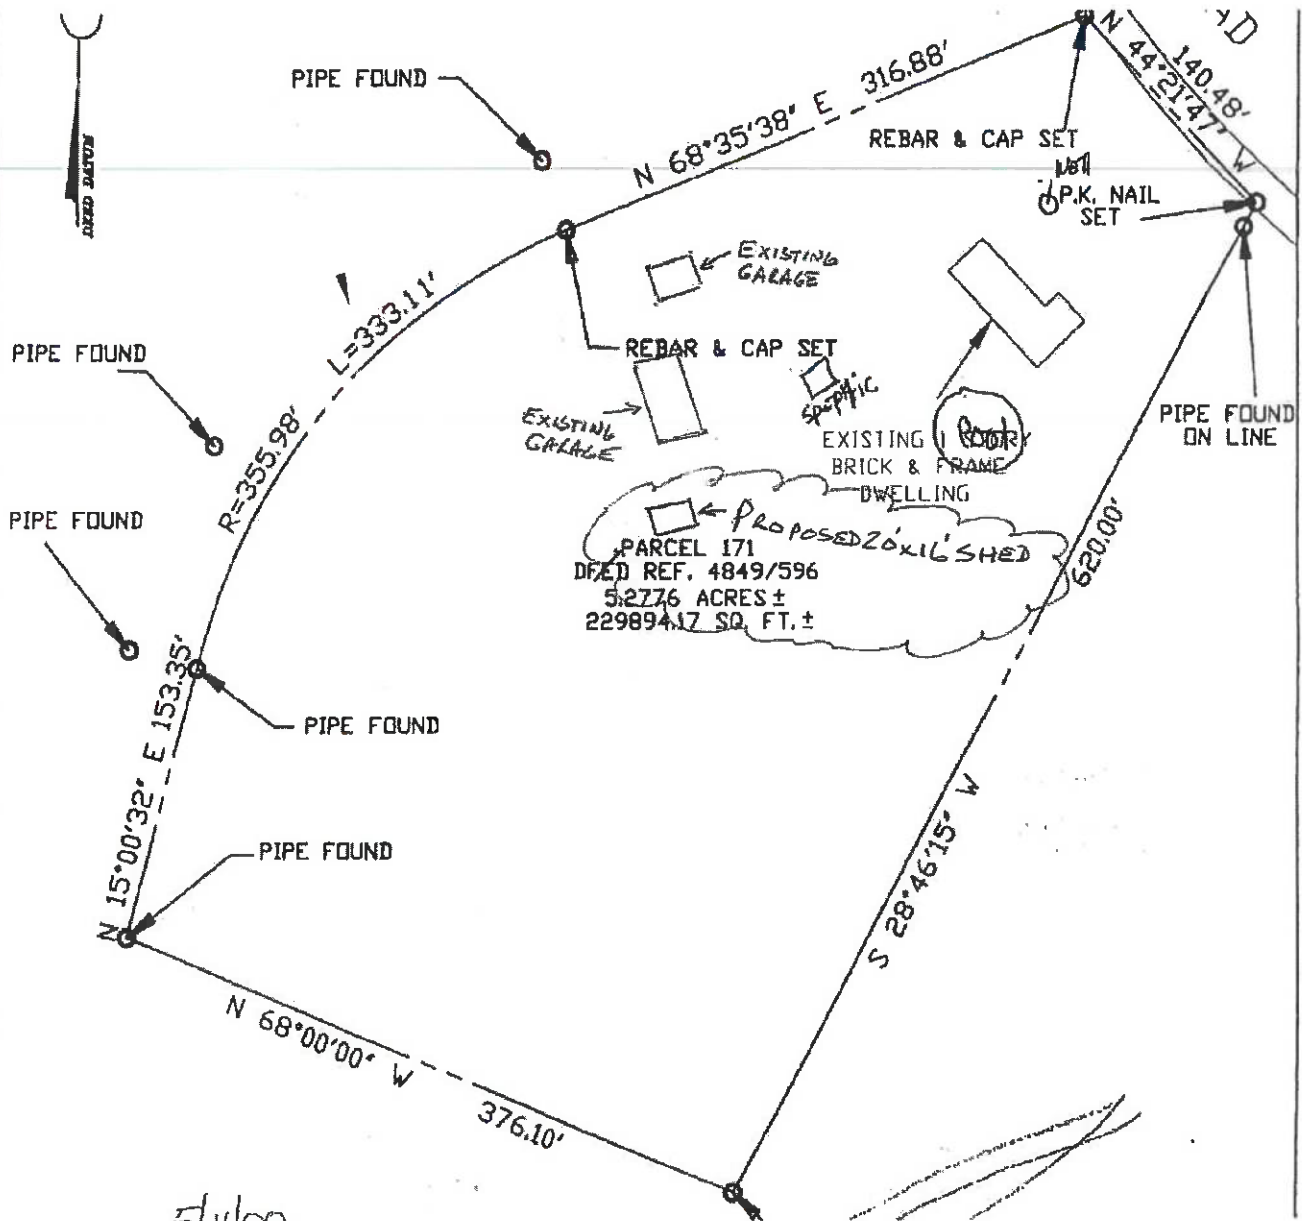

MALONEY RESIDENCE
 PROPOSED SHED
 4866 TEN OAKS RD
 DAYTON, MD 21036

3-28-25

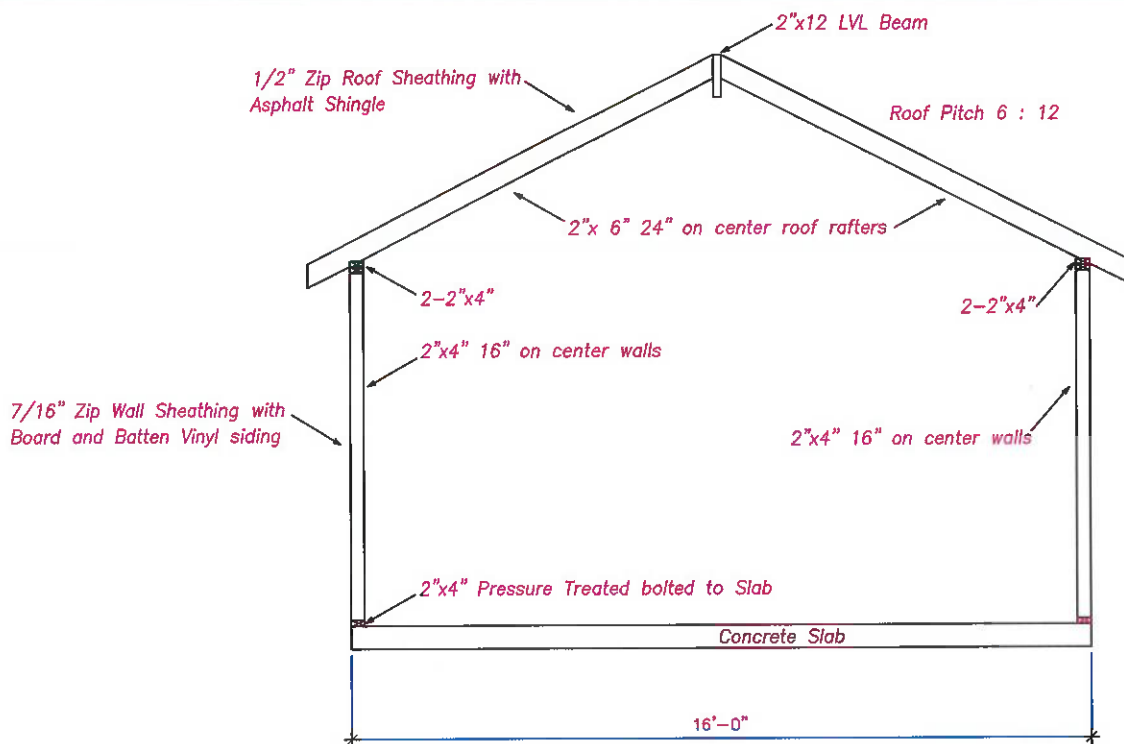

$$1/4" = 1'-0"$$

Maloney Residence Proposed Shed
4866 Ten Oaks Road, Dayton, MD 21036

Sheet 2 of 2
RCM 4-8-25