

Approved 4/14/2025
R12

Record Detail * (This section is required.)

Permit Type	Permit Number	Opened Date
Building/Residential/Misc/Pool Spa	B25000945	03/14/2025
Description of Work		
SFD/ Construct 16x40 swimming pool with concrete patio and fence to code**SUBJECT TO FIELD INSPECTION**		

Online BP.
3/18/25

[check spelling](#)

Address * (This section is required.)

Search Reset Clear Get Parcel & Owner

Street #	Street Name	Street Type
3661	FOLLY QUARTER	RD
Unit Type	Unit #	X Coordinate
--Select--		-76.91378
		Y Coordinate
		39.27047
City	State	Zip Code
ELLCOTT CITY	MD	21042
	Primary	
	Yes	

Parcel * (This section is required.)

Search Reset Clear Get Address & Owner

GIS ID *	Parcel	Parcel Area	Land Value	Improved Value	Exemption Value	Plan Area
895689	28	1.89	230100	926500	696400	RURAL
Legal Description						
IMPS1.89 A[]3661 FOLLY QUARTER RD[]						

[check spelling](#)

Block	Lot	Census Tract	Council Dist	Inspection Dist	Supervisor Dist	Map #	DAP Zone
		603000	5				
Plan Area	State Tax Id	Subdivision Name					
	1403295338						
Section	Area	Tax Map					
		23					
Grid	Zoning District	ADC Map					
23-9	RC-DEO	4814-D7					
SDP No.	Final Plan No.	WP File No.					
Record Plat No.	WS Contract No.	FDP No.	Primary				
			Yes				
Owner Occupied	Year Built	Historic District					
<input type="radio"/> Yes <input type="radio"/> No	2021	<input type="radio"/> Yes <input checked="" type="radio"/> No					
Historic District Registry No.	Stat Area	Flood Plain					
	3-09A	<input type="radio"/> Yes <input checked="" type="radio"/> No					
Building No							

Owner * (This section is required.)

Search Reset Clear

Name *
KEBEC

Address Line 1
3661 FOLLY QUARTER RD

Address Line 2

Address Line 3


Mail City
ELLCOTT CITY

Mail State
MD

Mail Zip Code
21042

Approved
 1325000745
 4/14/2025
 RJE

FOLLY QUARTER ROAD
 EX. RW VARIES

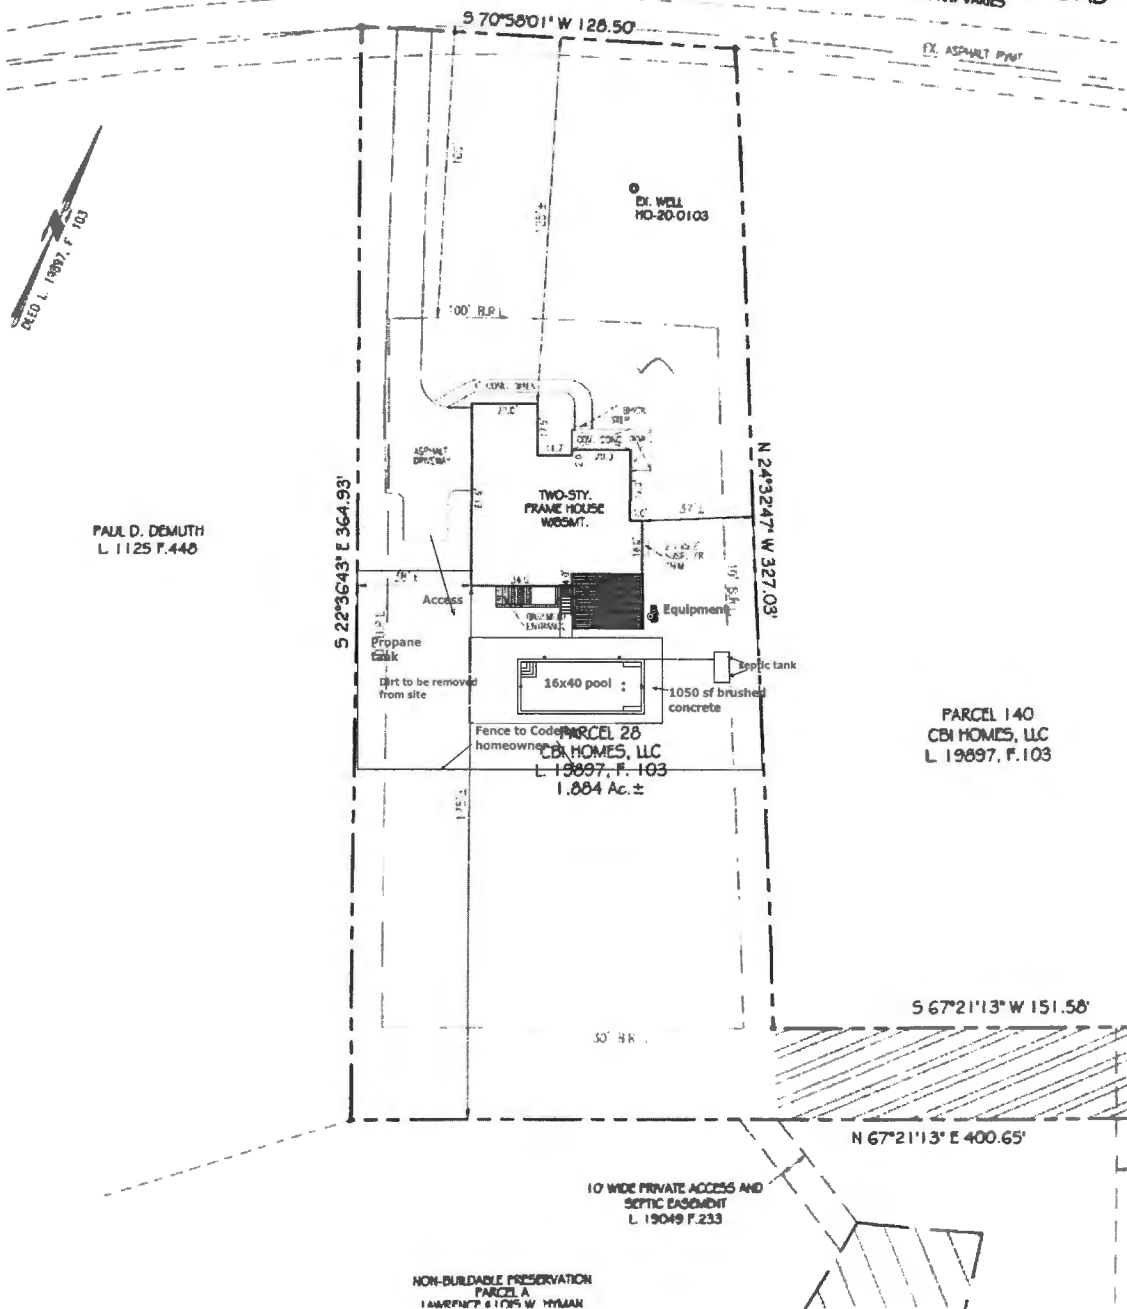

PAUL D. DEMUTH
 L. 1125 P. 448

PARCEL 28
 CBI HOMES, LLC
 L. 19897, P. 103
 1.884 Ac. ±


PARCEL 140
 CBI HOMES, LLC
 L. 19897, P. 103

NON-BUILDABLE PRESERVATION
 PARCELA
 1.9049 P. 233



10' WIDE PRIVATE ACCESS AND
 SEPTIC EASEMENT
 L. 19049 P. 233

Folly Quarter Road

AC = 348'
EC = 386'
AD = 272'
BD = 309'

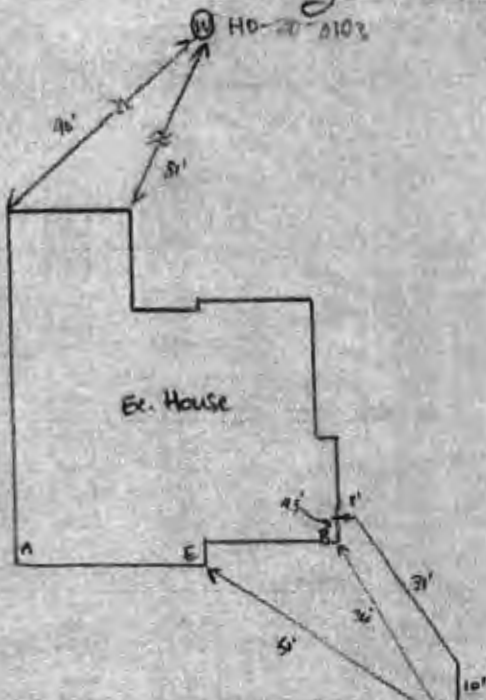

pool Approx 25 feet from Septic Tank

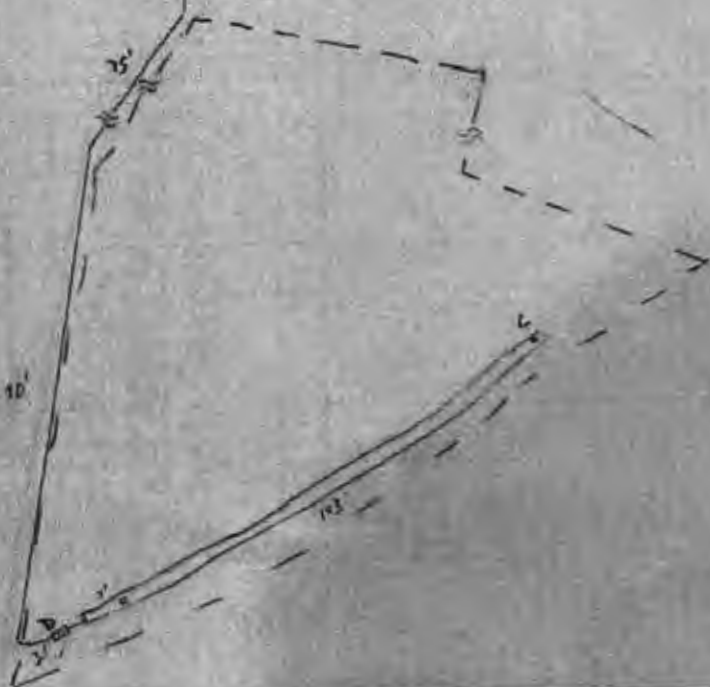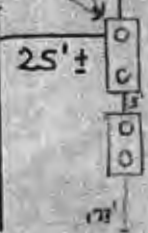

NOT TO SCALE (1" = 30')