

Record Detail * (This section is required.)

Permit Type Building/Residential/Misc/Tanks
 Description of Work SFD/INSTALL 500 UNDERGROUND PROPANE TANK W/45 FT GAS LINE CONNECT TO STUB OUT
 Permit Number B26001314
 Opened Date 04/27/2026

4/28/26 - si required to measure setbacks → w/s file @ HO doesn't match proposed plan and neighboring well needs to be verified for proper setback. (HK)

[check spelling](#)

Address * (This section is required.)

Search Reset Clear Get Parcel & Owner

Street # 16487 Street Name A E MULLINIX Street Type RD
 Unit Type --Select-- Unit # X Coordinate -77.08375 Y Coordinate 39.31683
 City WOODBINE State MD Zip Code 21797 Primary Yes

4/30/26 - site insp. no answer @ the door - could not find the well.

Parcel * (This section is required.)

Search Reset Clear Get Address & Owner

GIS ID *	Parcel	Parcel Area	Land Value	Improved Value	Exemption Value	Plan Area
910180	339	1.26	298800	610100	311300	RURAL

Legal Description IMPS1.266 AR[]16487 A E MULLINIX RD[]WOODBINE

5/5/26 - VM's from HO's Suburban Propane

5/6/26 - spoke to HO will meet onsite on 5/7/26

[check spelling](#)

Block	Lot	Census Tract	Council Dist	Inspection Dist	Supervisor Dist	Map #	DAP Zone
		605601	5				

Plan Area	State Tax Id	Subdivision Name
	1404327985	

Section	Area	Tax Map
		7

Grid	Zoning District	ADC Map
7-23	RC-DEO	4691-G10

SDP No.	Final Plan No.	WP File No.

Record Plat No.	WS Contract No.	FDP No.	Primary
			Yes

Owner Occupied	Year Built	Historic District
<input type="radio"/> Yes <input type="radio"/> No	1972	<input type="radio"/> Yes <input checked="" type="radio"/> No

Historic District Registry No.	Stat Area	Flood Plain
	4-07	<input type="radio"/> Yes <input checked="" type="radio"/> No

Building No

HO: David Lafferty 410-917-0174
 Suburban - Maria 240-855-1827

5/7/26 - met HO - onsite LP tank will be about 20' off the house → there will be plenty of room to drill a replacement well if needed down in the future. (HK)

Approved 5/7/26
 AH

Owner * (This section is required.)


Search Reset Clear

Name LAFFE
 Address Line 1 16487 A E MULLINIX RD
 Address Line 2
 Address Line 3

LEGEND

- CHAINING P' CONTOURS
- EXISTING 10' CONTOURS
- EXISTING 10' ELEVATION
- SOIL LINES AND TYPES
- DOMESTIC FIELD PUMP
- DOMESTIC WELLS PUMP
- DOMESTIC PROPOSED PUMP
- DOMESTIC 1500 G.P.H. ALTITUDE WELL SITE

SOILS LEGEND		
SOIL	NAME	CLASS
Gp	Gravelly loam, 3 to 8 percent slopes	B

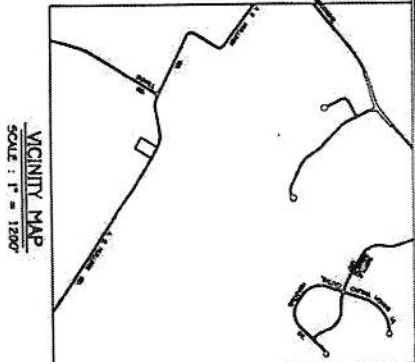

TANK LOCATION 10 FT LEFT Property line
 TANK TO RIGHT PROPERTY LINE 175 FT
 TANK TO REAR PROPERTY LINE OVER 190 FT
 TANK TO REAR PROPERTY LINE 100 FT
 TANK TO well / SEPTIC OVER 80 FT

Approved for LP tank
 B2600 1314
 5/1/26

future replacement
 well site

on-site
 well - no tank

PERC APPLICATION PLAT
 16487 A. E. MULLINIX ROAD


GENERAL NOTES:

1. [X] The area designated a private sewage area as required by the Howard County Department of the Environment for individual sewage disposal. The lot is located north of the proposed 10' contour line. The lot is located north of the proposed 10' contour line. The lot is located north of the proposed 10' contour line.
2. The lot is shown in compliance with the Howard County Department of the Environment.
3. All wells and septic systems within 100' of the property boundaries shall be installed in accordance with the Howard County Health Department.
4. All house sites shown comply with Howard County Health Department.
5. Resolutions shown in front of a field survey by PERC, COLLINS & CARTER, INC. done on or about May, 2020.
6. Recovery outline shown on a field survey by PERC, COLLINS & CARTER, INC. done on or about May, 2020.
7. All owners to a private sewage disposal area shall require a recovery well.
8. All owners to a private sewage disposal area shall require a recovery well.
9. All owners to a private sewage disposal area shall require a recovery well.
10. The existing septic system fields and the new area to be utilized for the well shall have to be abandoned and moved else where on the property.

PERC, COLLINS & CARTER, INC.
 11117 84th St, Suite 100
 Columbia, MD 21046

TAX MAP #9 ZONING: PARCEL: 339
 4TH ELECTION DISTRICT HOWARD COUNTY, MARYLAND
 SCALE: 1" = 30' DATE: MAY 11, 2020

Underground Domestic Tanks

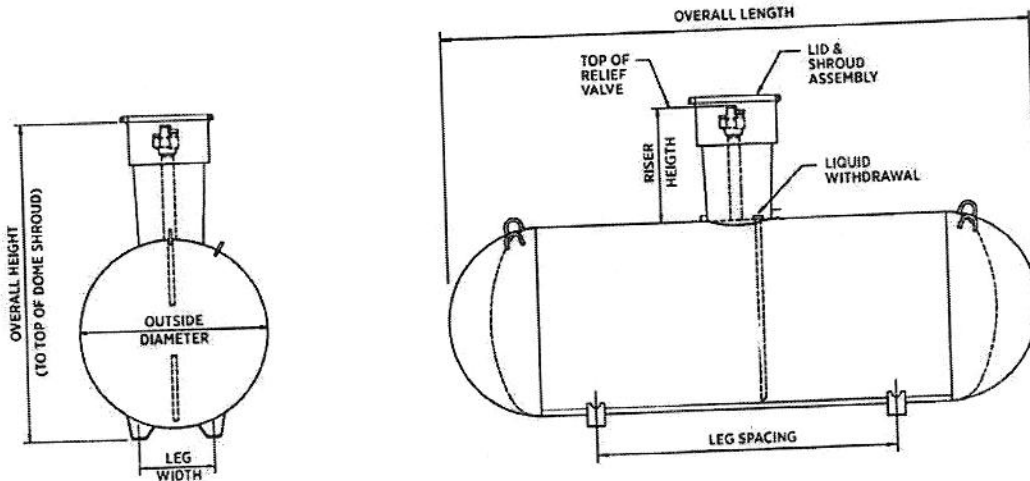

GENERAL SPECIFICATIONS

Conforms to the latest edition of the ASME, Section VIII, Division 1. Complies with NFPA 58.
 Container pressure rated at 250 psig from -20° F. to 125° F. All tanks may be evacuated to a full (14.7 psi) vacuum.

Vessel Finish: Coated with TGIC red powder.

Applicable federal, state, or local regulations may contain specific requirements for protective coatings and cathodic protection. The purchaser and installer are responsible for compliance with all federal, state, local and NFPA Industry regulations. Cathodic protection is required and coating must be continuous and uninterrupted and must comply with local, state or national code.

UNDERGROUND VESSEL DIMENSIONAL INFORMATION

Water Capacity	Outside Diameter	Head Type	Overall Length	Overall Height		Leg Width	Leg Spacing	Weight	Quality	
				Riser Height 14"	Riser Height 28"				Full Load	Per Stack
120 wg. 454.2L	24" 609.6 mm	Ellip	5' - 5 7/8" 1,673.2 mm	3' - 4 5/8" 1,031.9 mm	4' - 6 3/4" 1,390.7 mm	10 1/8" 257.2 mm	3' - 0" 914.4 mm	268 lbs. 121.6 kg.	72	9
250 wg. 946.3 L	31.5" 800.1 mm	Hemi	7' - 2 1/2" 2,197.1 mm	4' - 0 5/8" 1,235.1 mm	5' - 2 1/16" 1,576.4 mm	12 3/4" 323.9 mm	3' - 6" 1,066.8 mm	490 lbs. 222.3 kg.	42	7
320 wg. 1,211.2 L	31.5" 800.1 mm	Hemi	8' - 11 3/4" 2,736.9 mm	4' - 0 5/8" 1,235.1 mm	5' - 2 1/16" 1,576.4 mm	12 3/4" 323.9 mm	4' - 0 1/4" 1,225.6 mm	610 lbs. 276.7 kg.	35	7
500 wg. 1,892.5 L	37.42" 950.5 mm	Hemi	9' - 10" 2,997.2 mm	4' - 6 1/2" 1,384.3 mm	5' - 8 1/8" 1,730.4 mm	15" 381.0 mm	5' - 0" 1,524.0 mm	921 lbs. 417.7 kg.	25	5
1000 wg. 3,785.0 L	40.96" 1,040.4 mm	Hemi	15' - 10 7/8" 4,848.2 mm	4' - 9 1/2" 1,460.5 mm	6' - 0" 1,828.8 mm	16 1/4" 412.8 mm	9' - 0" 2,743.2 mm	1,760 lbs. 798.3 kg.	15	5
1465 wg. 5,545.0 L	46.77" 1,188 mm	Ellip	17' - 6 7/8" 5,356.2 mm	5' - 3 7/8" 1,722.4 mm	6' - 5" 1,955.3 mm	21" 533.4 mm	10' - 0" 3,084 mm	2,830 lbs. 1,283.7 kg.	9	3
2000 wg. 7,570.0 L	46.77" 1,188 mm	Ellip	23' - 9" 7,239 mm	5' - 3 7/8" 1,722.4 mm	6' - 5" 1,955.3 mm	21" 533.4 mm	14' - 0" 4,267.2 mm	3,685 lbs. 1,671.5 kg.	6	3

Rev: January 8, 2019

All vessels dimensions are approximate.



For more information
888.558.8265

Mail City
WOODBINE
Mail State
MD
Mail Zip Code
21797
Phone
410-917-0175
Primary
Yes
E-mail

Cell Number Fax Number

Professionals (This section is not required.)

License # * Business Name
20100078263 SUBURBAN PROPANE
License Type * First Name Middle Name Last Name
Propane Gs BRENT STUBBS
Primary Address Line 1
Yes 31 DERWOOD CIRCLE
Address Line 2

City State ZIP Code
ROCKVILLE MD 20850-0000
Phone 1 Phone 2 Fax
3012510606 3012510608
E-mail
BSTUBBS@SUBURBANPROPANE.COM

Applicant (This section is not required.)

Search As Owner As Lic. Prof As Contact

Type * First Name MI Last Name
Applicant MARIA STAMOULIS
Relationship Full Name
Applicant MARIA STAMOULIS
Primary Organization Name
Yes SUBURBAN PROPANE
Street Address
31 DERWOOD CIRCLE
Address Line 2

City State Zip Code
ROCKVILLE MD 20850
Phone Cell Fax
301-251-0606
E-mail *
MSTAMOULIS@SUBURBANPROPANE.COM

Addtl Info

Est Construction Cost * Housing Units * Number of Buildings * Public Owned
5866 0 0 No
Construction Type
329 - Structures Other Than Buildings (Retaining Walls/Tents)

TANK INFORMATION

RESIDENTIAL TANK INFORMATION

Capital Project-No Fee * Capital Project Number Fee Exempt * Roadside Tree Project Permit * Roadside Tree Permit #
 Yes No (Text) Yes No Yes No (Text)
Existing Use * Number of Tanks Installed * Number of Tanks Removed *
SFD 1 (Number) 0 (Number)

