

Record Detail * (This section is required.)

Approved
RTE
5/29/2026

Permit Type	Permit Number	Opened Date
Building/Residential/Misc/Deck	B26001500	05/07/2026
Description of Work		
SFD/ CONSTRUCT 17'2 X 20' OPEN DECK W/ STEPS**SUBJECT TO FIELD INSPECTION**		
check spelling		

Address * (This section is required.)

Search Reset Clear Get Parcel & Owner

Street #	Street Name	Street Type
1070	DRIVER	RD
Unit Type	Unit #	X Coordinate
--Select--		-76.89372
		Y Coordinate
		39.34302
City	State	Zip Code
MARRIOTTSVILLE	MD	21104
		Primary
		Yes

Parcel * (This section is required.)

Search Reset Clear Get Address & Owner

GIS ID *	Parcel	Parcel Area	Land Value	Improved Value	Exemption Value	Plan Area
831443	300	3.06	291600	729600	438000	RURAL
Legal Description						
IMPSLOT 8 3.063A[]1070 DRIVER RD[]LAUKENMANN PROP						
check spelling						

Block	Lot	Census Tract	Council Dist	Inspection Dist	Supervisor Dist	Map #	DAP Zone
	8	603000	5				
Plan Area	State Tax Id	Subdivision Name					
	1403307832						
Section	Area	Tax Map					
		10					
Grid	Zoning District	ADC Map					
10-5	RC-DEO	4694-G6					
SDP No.	Final Plan No.	WP File No.					
Record Plat No.	WS Contract No.	FDP No.	Primary				
			Yes				
Owner Occupied	Year Built	Historic District					
<input type="radio"/> Yes <input type="radio"/> No	1996	<input type="radio"/> Yes <input checked="" type="radio"/> No					
Historic District Registry No.	Stat Area	Flood Plain					
	3-02A	<input type="radio"/> Yes <input checked="" type="radio"/> No					
Building No							

Owner * (This section is required.)

Search Reset Clear

Name *
CASE

Address Line 1
1070 DRIVER RD

Address Line 2

Address Line 3

Mail City

MARRIOTTSVILLE

Mail State

MD

Mail Zip Code

21104

Phone

410-302-1087

Primary

Yes

E-mail

Cell Number

Fax Number

Professionals (This section is not required.)

License # *

08050126323

Business Name

PORTA CONSTRUCTION INC

License Type *

MHIC Co

First Name

STEPHANIE

Middle Name

Last Name

PORTA

Primary

Yes

Address Line 1

10382 BALTIMORE NATIONAL PIKE

Address Line 2

City

ELLCOTT CITY

State

MD

ZIP Code

21042-0000

Phone 1

4104654103

Phone 2

Fax

4104655360

E-mail

SPORTA@VERIZON.NET

Applicant (This section is not required.)

Search

As Owner

As Lic. Prof

As Contact

Type *

Applicant

First Name

STEPHANIE

MI

Last Name

PORTA

Relationship

Applicant

Full Name

Primary

Yes

Organization Name

PORTA CONSTRUCTION INC

Street Address

10382 BALTIMORE NATIONAL PIKE

Address Line 2

City

ELLCOTT CITY

State

MD

Zip Code

21042-0000

Phone

4104654103

Cell

Fax

4104655360

E-mail *

SPORTA@VERIZON.NET

Addtl Info

Est Construction Cost *

18000

Housing Units *

0

Number of Buildings * Public Owned

0

No

Construction Type

434 - Additions, Alterations and Conversions - Residential

MISC PERMIT INFO

MISCELLANEOUS PERMIT INFORMATION

Capital Project-No Fee *

Yes No

Capital Project Number

(Text)

Fee Exempt *

Yes No

Fee Exempt Group

--Select--

Roadside Tree Project Permit *

Yes No

Roadside Tree Project Permit #

Existing Use *

(Text) SFD



Water

Private

Sewage

Private


Expiration Date

11/25/2026



Submit

Cancel

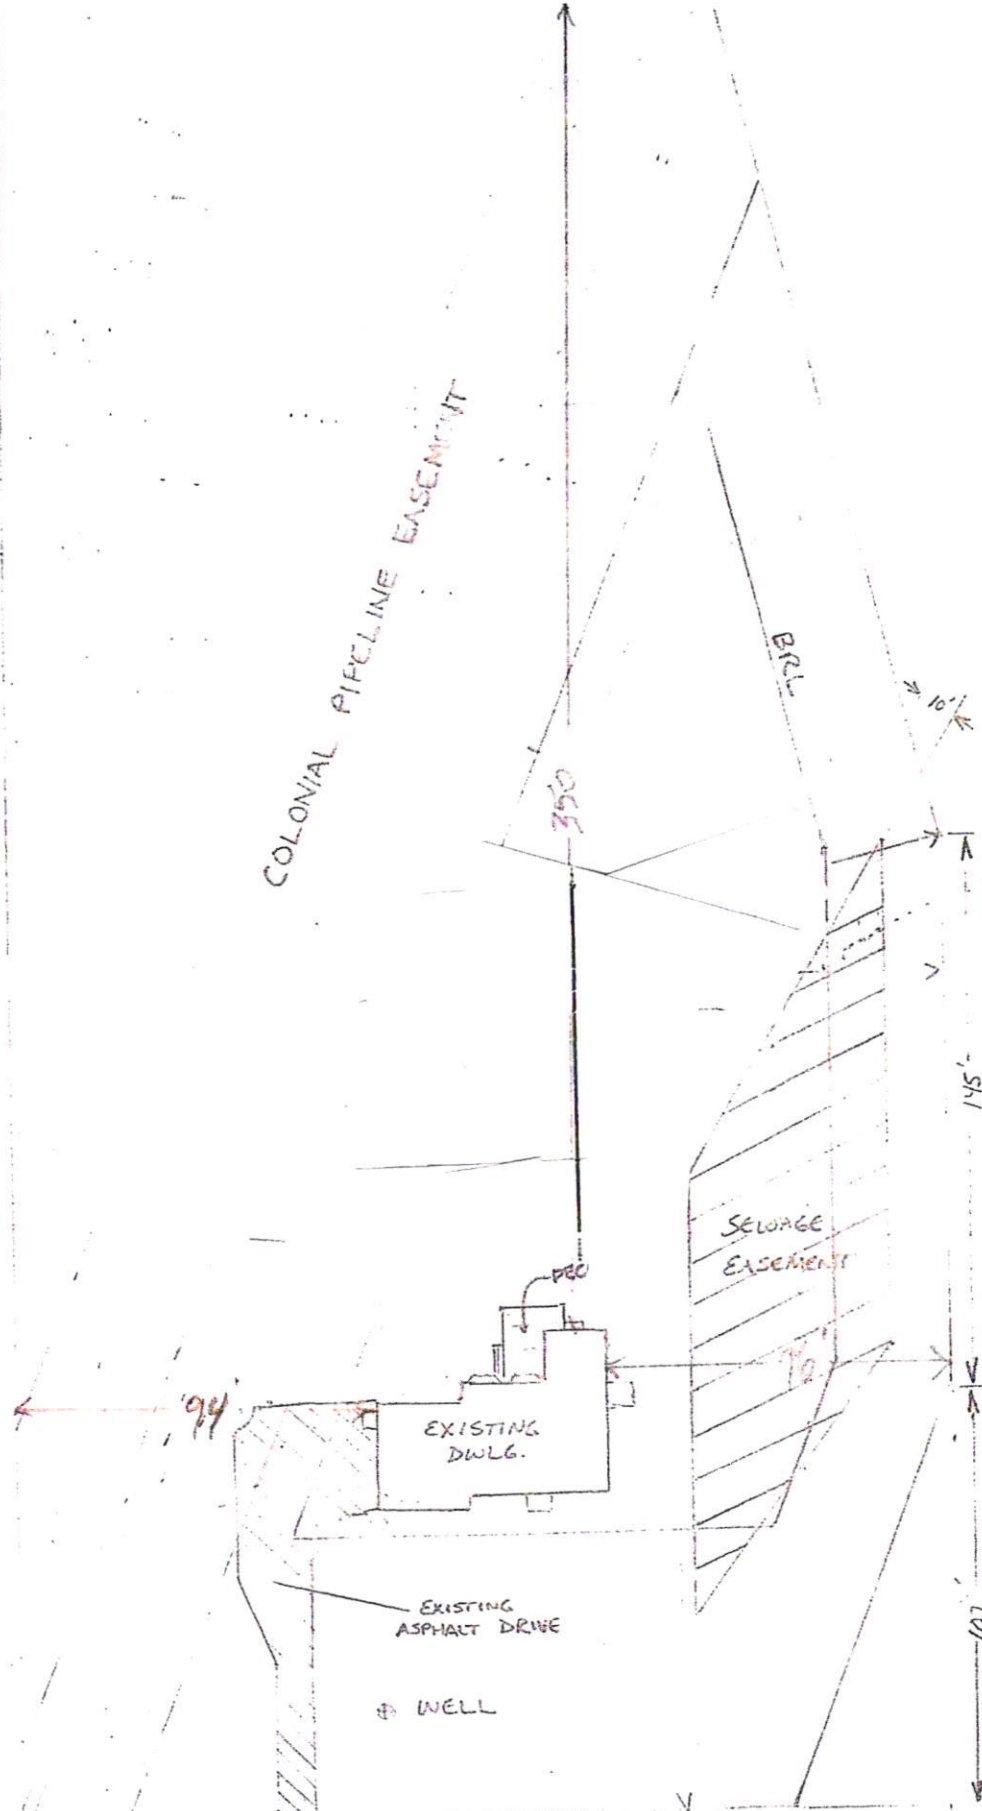

1070 DRIVER R
LOT 8 LAURENNA
PROPERTY
SCALE: 1" = 50'

DRIVER ROAD