

05-379997

Approved 11 Aug 78

8/2/78 P.C.O.

c. B. W.

GLK

PERMIT

P 27679

A 24730

SEWAGE DISPOSAL SYSTEM

MARYLAND STATE DEPARTMENT OF HEALTH*

HOWARD COUNTY

INDEXED

ELLICOTT CITY

DISTRICT fifth

DATE 3/17/78

7/20/78
8/2/78
8/4/78
8/11/78

Joseph Saunderson

IS PERMITTED TO INSTALL X ALTER

ADDRESS 3717 Dellabrook Street, Olney, Md. 20832

PHONE

SUBDIVISION Allnutt Farm Estates

13413 Good Times Court

ROAD Allnutt Lane

LOT 18, Sec. 1

PROPERTY OWNER Joseph Saunderson

ADDRESS same as above

SPECIFICATIONS 4 bedrooms

13410

SEPTIC TANK CAPACITY 1250 GALLONS

DRAIN FIELD DEPTH FEET, BOTTOM AREA SQ. FT.

DEEP TRENCH DEPTH FEET, BOTTOM AREA SQ. FT.

SEEPAGE PITS ABSORBENT SIDE-WALL AREA 120 SQ. FT. per bedroom

INLET PIPE 3 FT. BELOW ORIGINAL GRADE. MAXIMUM DEPTH 10 FT. BELOW ORIGINAL GRADE

EFFECTIVE DEPTH AT FT. BELOW ORIGINAL GRADE.

LOCATE DISPOSAL AREA 20 FT. FROM lot 19 ~~XXXXXXXXXX~~ 67 FT. FROM ~~XXXXXXXXXX~~

~~XXXXXXXXXX~~ Good Times Court.

BLDG. PERMIT SIGNED AND RETURNED 4/24/78

Serial # 57207
1 story addition
Cane per BPO
01/22/96

TRENCH-to be 20 ft. long with the inlet at 3 ft. and maximum depth 10 ft. Run trench on contour from dry well towards corner of 159 lot line and 265 lot line. (left front corner as seen from Allnutt Lane)

PLANS APPROVED BY David J. O'Neill

DATE 9/28/77

COVER NO WORK UNTIL INSPECTED AND APPROVED.

NEITHER THE HOWARD COUNTY COUNCIL NOR THE HEALTH DEPARTMENT IS RESPONSIBLE FOR THE SUCCESSFUL OPERATION OF ANY SYSTEM.

NOTE: IF TRENCH IS USED CALL FOR INSPECTION BEFORE PLACING GRAVEL IN TRENCH.

NOTE: NO DRY WELL SHALL EXCEED 15 FOOT IN DIAMETER.

NOTE: ALL PIPE FROM HOUSE TO DISPOSAL AREA MUST BE CAST IRON.

PERMIT VOID AFTER THREE YEARS.

NOTE: INSTALL STAND PIPE ON SEPTIC TANK AND DRY WELL. STAND PIPES MUST BE 8 INCHES IN DIAMETER. CAST IRON, CONCRETE OR TERRA

COTTA ACCEPTED

*INSTALLER IS RESPONSIBLE FOR OBTAINING FINAL APPROVAL ON THIS PERMIT.


BLDG. PERMIT SIGNED AND RETURNED 3/21/78

Serial # 35102

A 24730

14.6
 y 3.14
 584
 146
 438
 45.844
 45.84 ≈ 46

46
 x 7
 322

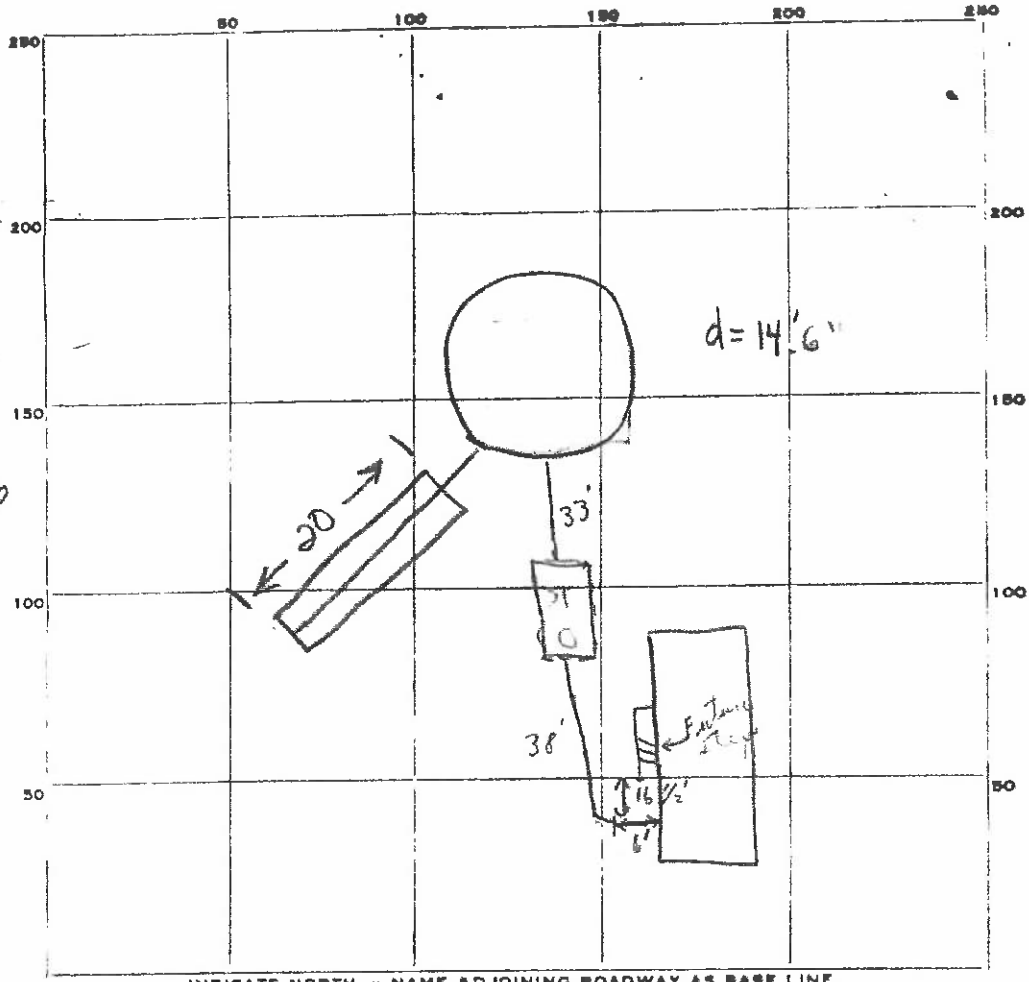

Good
 Trench

INDICATE NORTH. - NAME ADJOINING ROADWAY AS BASE LINE.

PERMIT CARD new 8/4 (Alvott Dr) stop all work
 SEPTIC TANK, LEVEL CLEANOUTS ST/DW CAST IRON

DISTRIBUTION BOX, LEVEL Na

TILE FIELD, DEPTH 9 1/2 FT. TRENCH WIDTH 2 FT.

GRAVEL DEPTH 7 FT. TOTAL LENGTH 20 FT. ±140

NUMBER OF TRENCHES 1 TOTAL BOTTOM AREA 1/2 SW ±140

d=14.6" CIRCUMF. SEEPAGE PITS, INSIDE DIAMETER 46 FT. DEPTH BELOW INLET 7' ± FT. ±322


ABSORBENT AREA ±462 SQ. FT.

REMARKS 20 July 78 - OK to add gravel to trench. CALL for final (GLK) Be sure to make tank at least 10ft from house (GLK) August 2, 1978 - Partial need house connection
 (2) Granit Paper used in trench not approved - stop all work
 (3) also by well cap not water tight. 4 Aug. 78 - See attached (GLK)

DATE SYSTEM APPROVED 11 Aug 78 INSPECTOR G. Keller

6-125

Plan

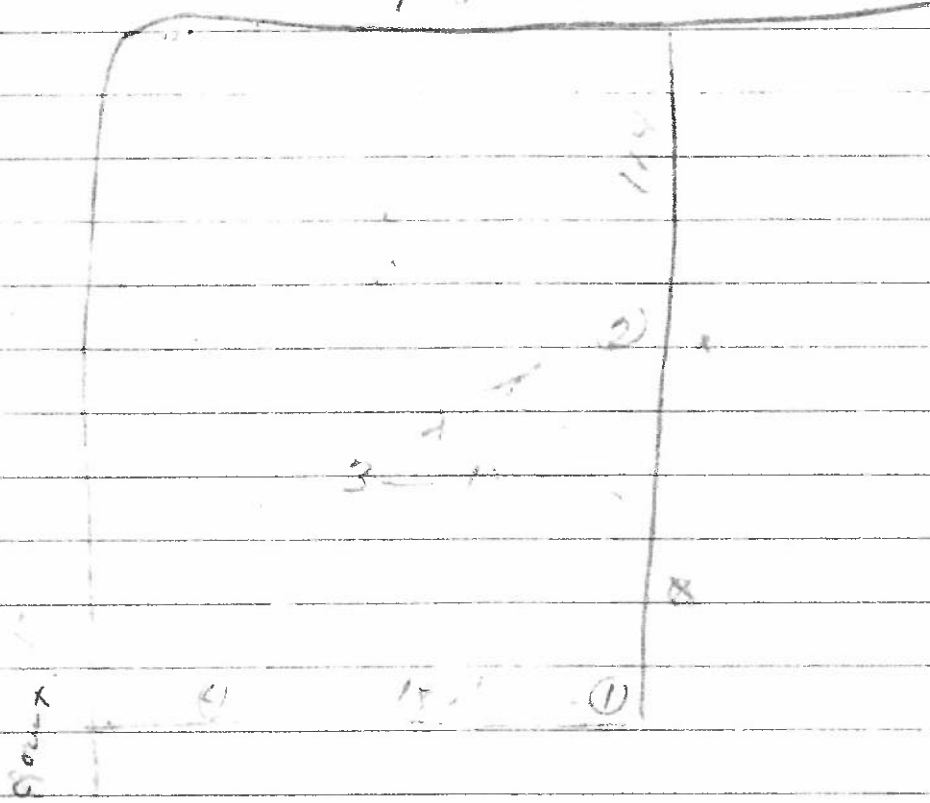

1 2 3

2 5-13' view good sand

2.2 5.5

1

1 5.5

2

1

$\frac{30'}{4}$ 7/8" Ball

C 1 **9317** SEQUENCE NO. (WRA USE ONLY)

1 2 3 (SEQ. NO.) 6
 (THIS NUMBER IS TO BE PUNCHED IN COLUMNS 3-6 OF ALL CARDS)

STATE OF MARYLAND
WATER RESOURCES ADMINISTRATION
 TAWES STATE OFFICE-BLDG., ANNAPOLIS, MD. 21401
WELL COMPLETION REPORT

THIS REPORT MUST BE SUBMITTED WITHIN 30 DAYS AFTER WELL COMPLETION

FILE IN THIS FORM COMPLETELY

COUNTY NUMBER W-26-428

DATE RECEIVED (WRA USE ONLY) _____

DATE WELL COMPLETED August 1977

DEPTH OF WELL 205 (TO NEAREST FOOT)

PERMIT NO. FROM "PERMIT TO DRILL WELL" HO-73-2230

DRILLERS IDENTIFICATION NO. 223

OWNER SAUNDER SON Joseph FIRST NAME

STREET OR RFD 3217 DELLACROCK CT. POST OFFICE OLNEY MD.

WELL LOG

STATE THE KIND OF FORMATIONS PENETRATED, THEIR COLOR, DEPTH, THICKNESS AND IF WATER BEARING

DESCRIPTION (USE ADDITIONAL SHEETS IF NECESSARY)	FEET		CHECK IF WATER BEARING
	FROM	TO	
Top Soil	0	2	
Sandy	2	28	
Br. Stone	28	45	
Black	45	70	
Sandstone	70	75	✓
Black	75	205	

GROUTING RECORD

WELL HAS BEEN GROUTED (CIRCLE APPROPRIATE BOX) YES NO

TYPE OF GROUTING MATERIAL (CIRCLE BOX): CEMENT BENTONITE CLAY

NO. OF BAGS 10 NO. OF POUNDS 1000

GALLONS OF WATER 60

DEPTH OF GROUT SEAL (TO NEAREST FOOT): FROM 0 FT. TO 38 FT.

CASING RECORD

CASING TYPES: INSERT APPROPRIATE CODE BELOW: STEEL CONCRETE PLASTIC OTHER

MAIN CASING TYPE: ST 6 NOMINAL DIAMETER TOP (MAIN) CASING (NEAREST INCH) TOTAL DEPTH OF MAIN CASING (NEAREST FOOT) 40

C 3

1 2 3 (SEQ. NO.) 6

PUMPING TEST

HOURS PUMPED (TO NEAREST HOUR) 2

PUMPING RATE (GALLONS PER MINUTE TO NEAREST GALLON) 15

METHOD USED TO MEASURE PUMPING RATE Bucket

WATER LEVEL: (DISTANCE FROM LAND SURFACE)

BEFORE PUMPING 30 (NEAREST FOOT)

WHEN PUMPING 205 (NEAREST FOOT)

TYPE OF PUMP USED (CIRCLE APPROPRIATE BOX) (FOR PUMPING TEST)

AIR PISTON TURBINE

CENTRIFUGAL ROTARY OTHER (DESCRIBE BELOW)

JET SUBMERSIBLE

OTHER CASING (IF USED)

EACH SCREENING	DIAMETER (INCH)		DEPTH (FEET)	
	FROM	TO	FROM	TO

SCREEN RECORD

SCREEN TYPE OR OPEN HOLE: INSERT APPROPRIATE CODE BELOW: STEEL BRASS OR BRONZE OPEN HOLE PLASTIC OTHER

PUMP INSTALLED

TYPE OF PUMP (WRITE APPROPRIATE LETTER IN BOX - SEE ABOVE: A, C, J, P, R, S, T, O)

DRILLER WILL INSTALL PUMP (CIRCLE APPROPRIATE BOX) YES NO

CAPACITY:

GALLONS PER MINUTE (TO NEAREST GALLON) 31 38

PUMP HORSE POWER 37 41

PUMP COLUMN LENGTH (NEAREST FOOT) 43 47

CASING HEIGHT (CIRCLE APPROPRIATE BOX AND ENTER CASING HEIGHT)

ABOVE } LAND SURFACE (NEAREST FOOT)

BELOW } 2

CIRCLE APPROPRIATE BOXES

A WELL WAS ABANDONED AND SEALED WHEN THIS WELL WAS COMPLETED

E ELECTRIC LOG OBTAINED

P TEST WELL CONVERTED TO PRODUCTION WELL

I HEREBY CERTIFY THAT I HAVE COMPLIED WITH ALL CONDITIONS STATED ON THE ABOVE-CAPTIONED "PERMIT TO DRILL WELL", AND THAT INFORMATION CONTAINED IN THIS REPORT IS TRUE, ACCURATE, AND COMPLETE TO THE BEST OF MY KNOWLEDGE, INFORMATION AND BELIEF.

DRILLERS NAME Ralph Wayne

(PLEASE PRINT) _____

SIGNATURE _____

C 2

1 2 3 (SEQ. NO.) 6

DEPTH (NEAREST WHOLE FOOT)

FROM 38 TO 205

EACH SCREENING

1	8	9	11	15	17	21
2						
3	23	24	26	30	32	36
	38	39	41	45	47	51

SLOT SIZE 1. _____ 2. _____ 3. _____

DIAMETER OF SCREEN 56 (NEAREST INCH) FROM _____ TO _____

GRAVEL PACK _____

IF WELL DRILLED WAS A FLOWING WELL CIRCLE BOX F

WRA USE ONLY (NOT TO BE FILLED IN BY DRILLER) (E.R.O.S.)

T W Q

70 72 74 75 76

TELESCOPE CASING LOG INDICATOR OTHER DATA AVAILABLE

LOCATION OF WELL ON LOT

SHOW PERMANENT STRUCTURE SUCH AS BUILDINGS, SEPTIC TANKS, AND/OR OTHER LAND MARKS AND INDICATE NOT LESS THAN TWO DISTANCES (MEASUREMENTS TO WELL).



DEVELOPMENT
CONSULTANTS
GROUP

17904 GEORGIA AVE. SUITE 102
OLNEY, MD 20932 (301) 924-4570

HOUSE LOCATION PLAT

LOT 18 BLOCK

ALLNUTT FARMS ESTATES

Section 1

COUNTY OF Howard PLAT BK. PLAT NO 3725

GOOD TIMES COURT
50' R/W

ALLNUTT LANE
60' R/W

N 73° 00' 00" E 159.54'


528° 00' 45" E
35.36'

Well

R=425' A=146.00'

503° 10' 00" W
18.25'

DRIVE

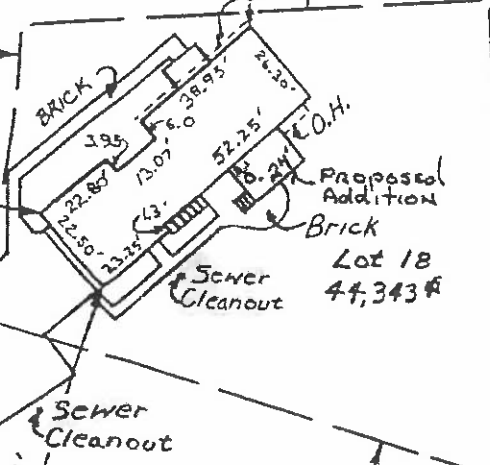

Proposed Addition
Brick
Lot 18
44,343 sq ft

S17° 00' 00" E 265.54'

Lot 17

586° 50' 00" E 231.06'
Lot 19

Handwritten notes:
OK 4/24/25
757207
OK
① of Andrew
② of per C.O.
OK



NOTE: Existence of property corners not guaranteed by this plat.

NOT IN FLOOD PLAIN

SURVEYOR'S CERTIFICATION

I hereby certify that the property delineated hereon is in accordance with the Plat of Subdivision and/or deed of record, that the improvements were located by accepted field practices and include permanent visible structures and encroachments, if any. This Plat is not for determining property lines, but prepared for exclusive use of present owners of property and also those who purchase, mortgage, or guarantee the title thereto, within six months from date hereof, and as to them I warrant the accuracy of this Plat.
No title report furnished.

Jefferson D. Lawrence
Professional Land Surveyor No. 5216

Job No.	100-40
Case No.	
Scale:	1" = 50'
DATES	
Well Ck:	
Final Loc:	6-15-83
	11-19-86